


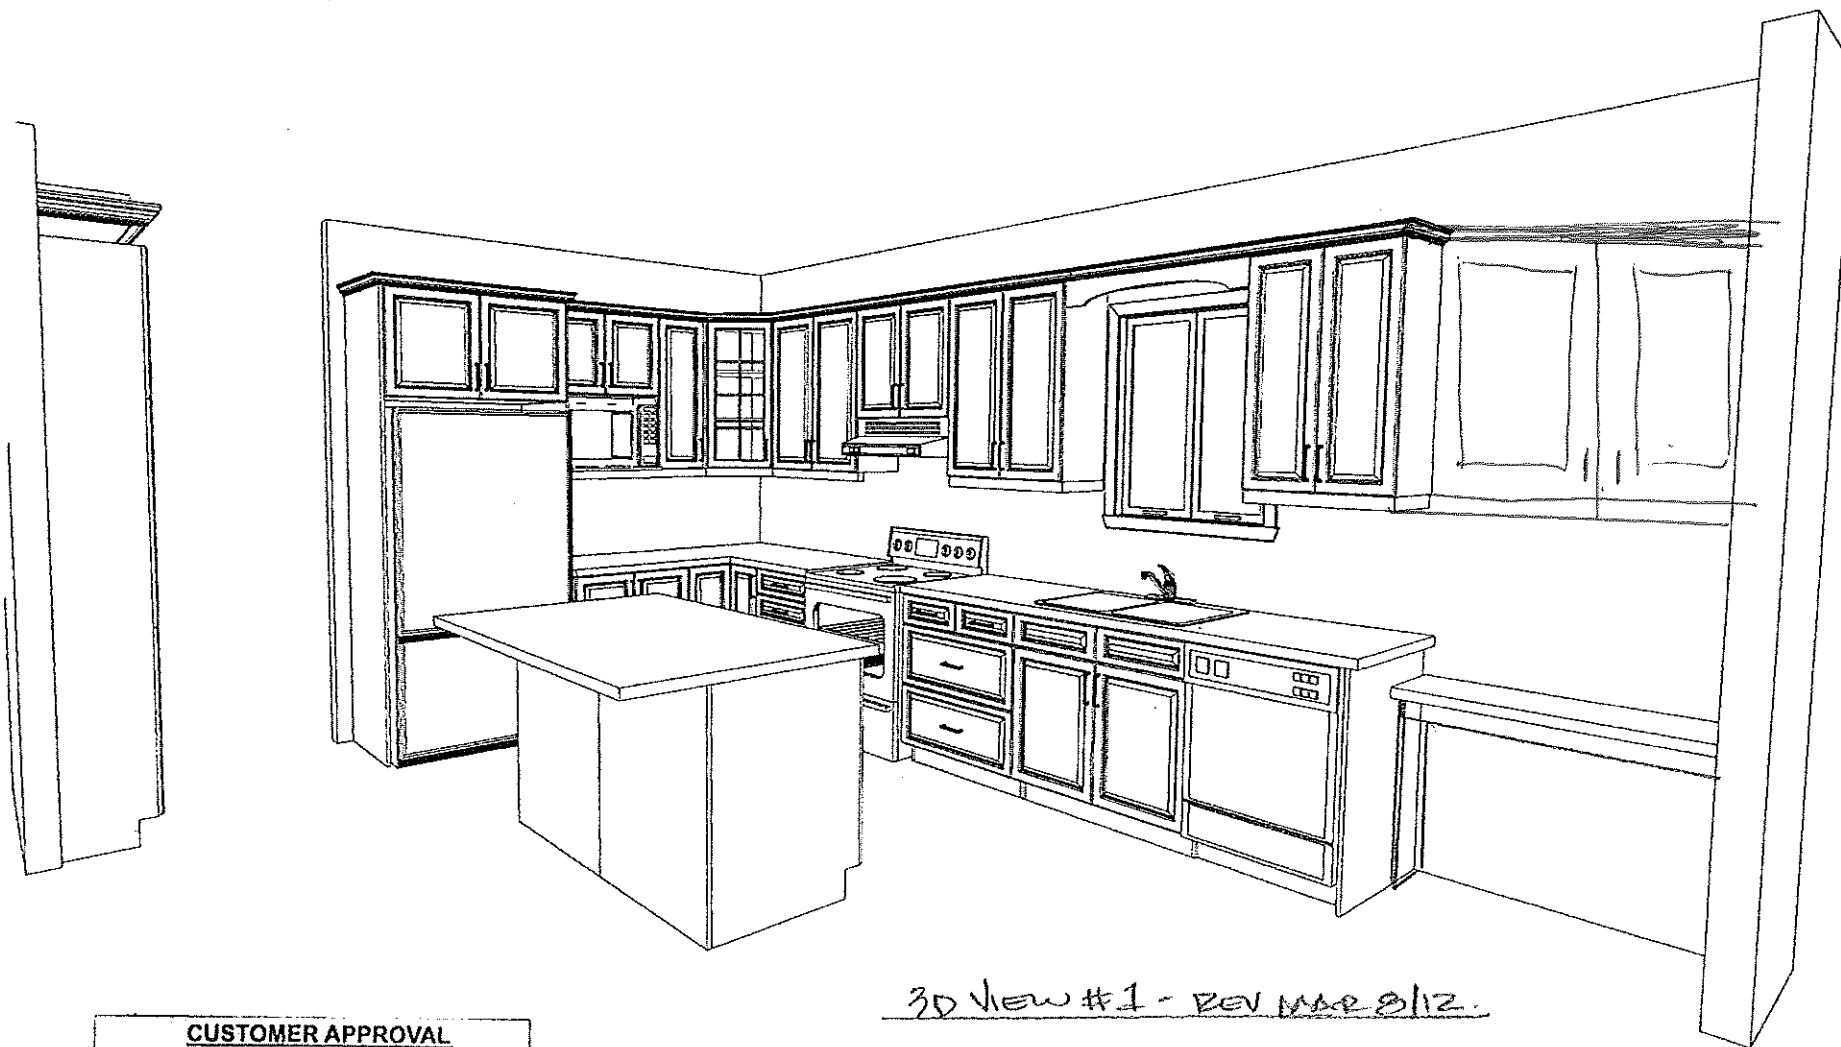

3D View #1 - REV MAR 8/12.

CUSTOMER APPROVAL

I have reviewed these drawings and understand the details of the layout and the Cartier Kitchens specifications.

Signature

[Handwritten Signature]

Date

31 March 2012.

Note: This drawing is an artistic interpretation of the general appearance of the design. It is not meant to be an exact rendition.



Designed: 2/26/2012
Printed: 3/8/2012




DESIGNED BY: LORI DISAVERIO,

DCR - 81 SM 5 - KITCHEN 2 -

All

Drawing #: 1

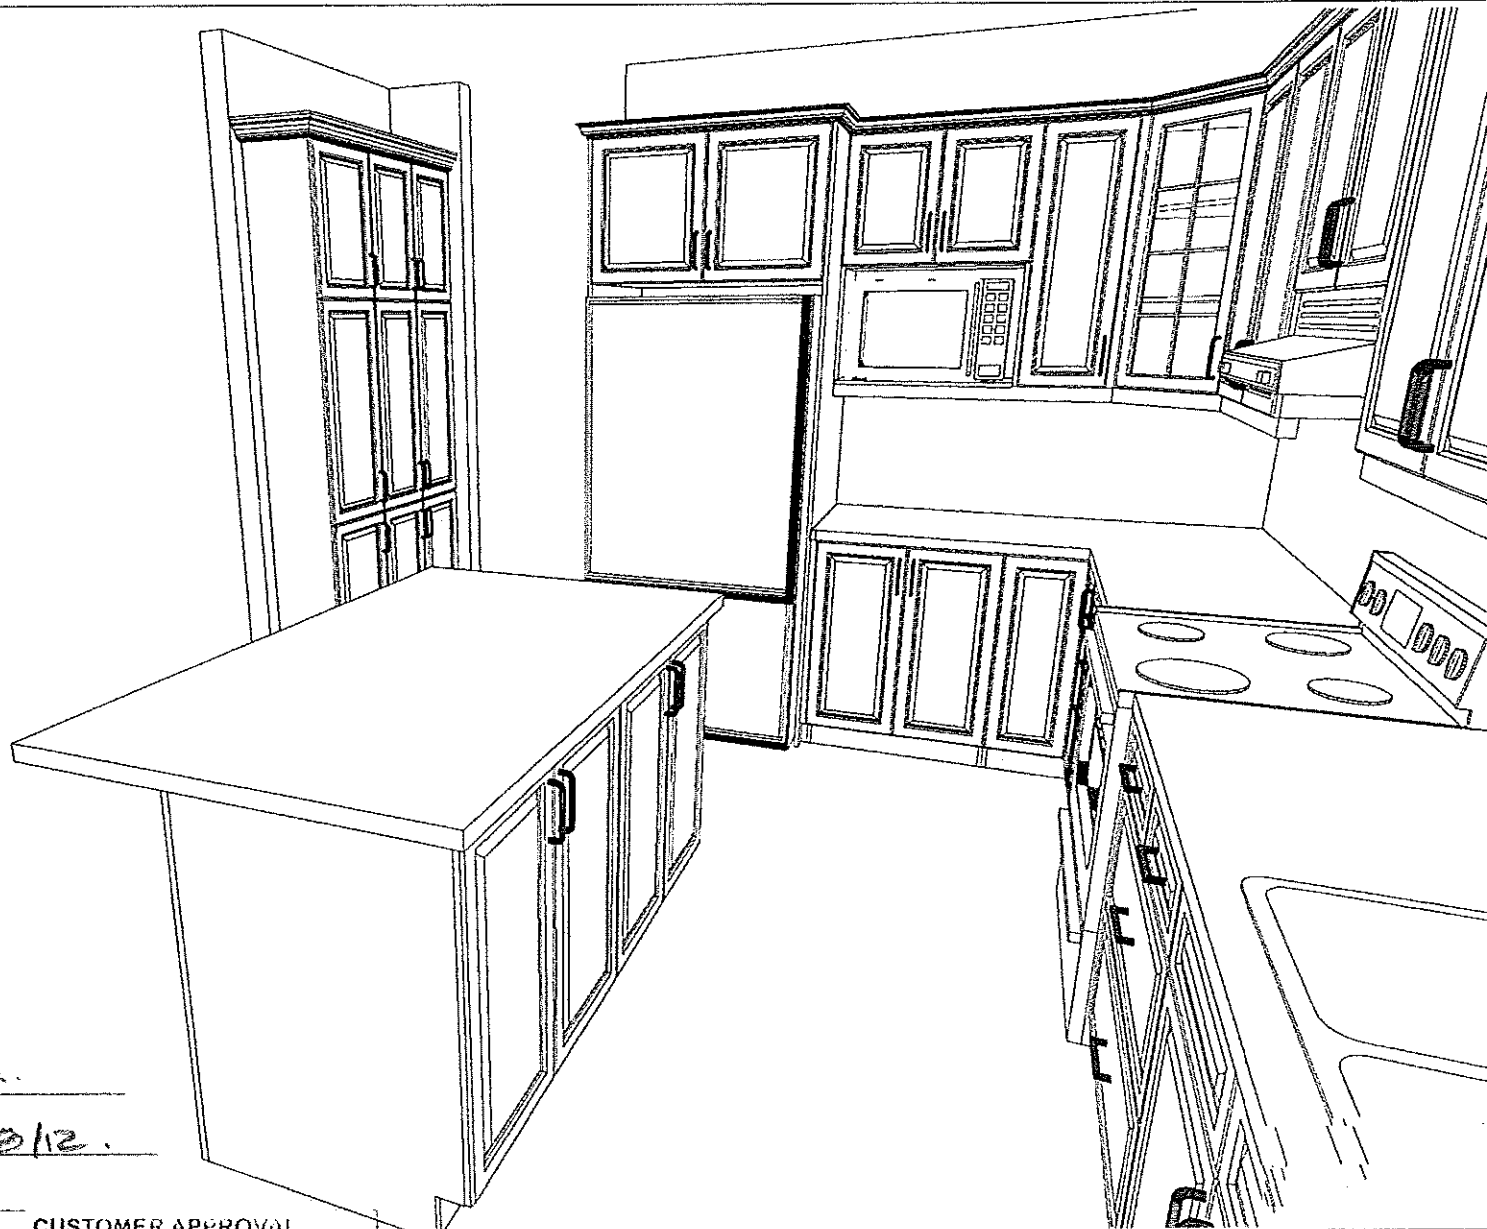

3D View #2.

Rev. MAR. 8/12.

CUSTOMER APPROVAL

I have reviewed these drawings and understand the details of the layout and the Cartier Kitchens specifications.

Signature

Date

[Signature]
31 March 2012

Note: This drawing is an artistic interpretation of the general appearance of the design. It is not meant to be an exact rendition.

DESIGNED BY: LORI DISAVERIO.
DCR - 81 SM 5 - KITCHEN 2 -



Designed: 2/26/2012
Printed: 3/8/2012

All

Drawing #: 1



FRIDGE WALL ELEVATION

REV. MAR. 8, 2012.

CUSTOMER APPROVAL

I have reviewed these drawings and understand the details of the layout and the Cartier Kitchens specifications.

Signature: [Signature]

Date: 31 March 2012

Note: This drawing is an artistic interpretation of the general appearance of the design. It is not meant to be an exact rendition.


DESIGNED BY: LORI DISAVERIO.
DCR - 81 SM 5 - KITCHEN 2 -



Designed: 2/26/2012
Printed: 3/8/2012

All

Drawing #: 1

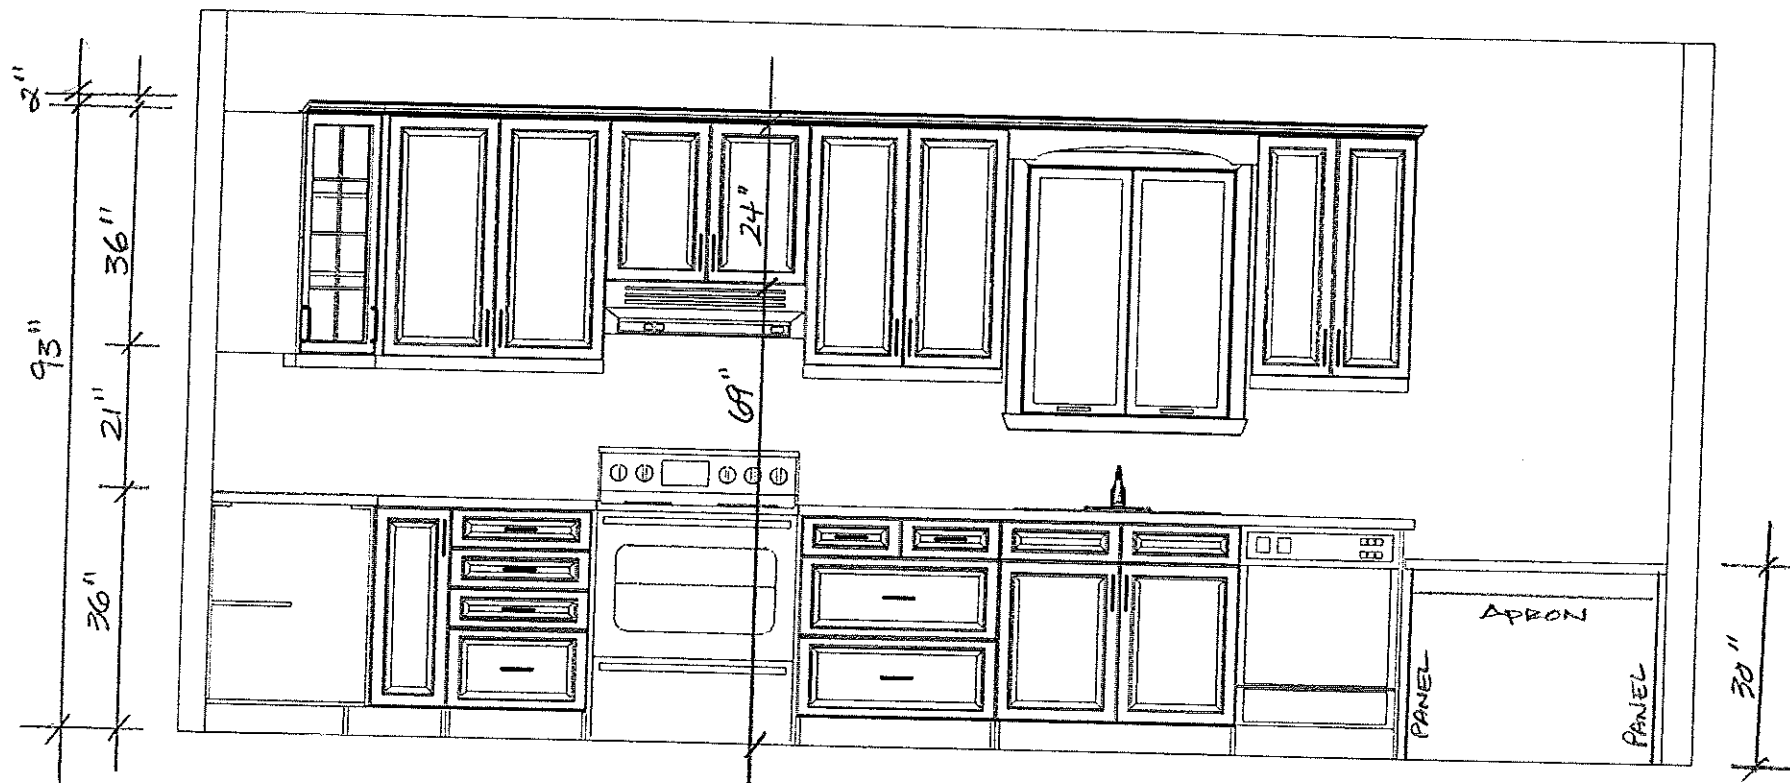

STOVE/SINK WALL ELEVATION - REV. MAR 8/12.

CUSTOMER APPROVAL

I have reviewed these drawings and understand the details of the layout and the Cartier Kitchens specifications.

Signature

Date 31 March 2012

Note: This drawing is an artistic interpretation of the general appearance of the design. It is not meant to be an exact rendition.

DESIGNED BY: LORI DISAVERIO,
DCR - 81 SM 5 - KITCHEN 2 -



Designed: 2/26/2012
Printed: 3/8/2012

All

Drawing #: 1

DCR PHOENIX HOMES

STRANDHERD MEADOWS 5

LOT #81

MODEL: C10 - ROSEMERE (LEFT)

KITCHEN ~ REV. MAR. 3/12.

MOUNTING HT: 93"

LINE - 3
DOOR STYLE -
SPECIES -
COLOUR -

HARDWARE

KICK: 3-PCS.

STANDARD WHITE INTERIOR

METAL DRAWER BOX

1 - PC. 90 DEG. CORNER MOULD.

2-PCS. T-MOULD

1 - PC. 135 DEG. CORNER MOULD.


2 - PCS FILLER - 6" x 96"

CUSTOMER APPROVAL

I have reviewed these drawings and understand the details of the layout and the Cardier Kitchens specifications.

Sigurdur

Date

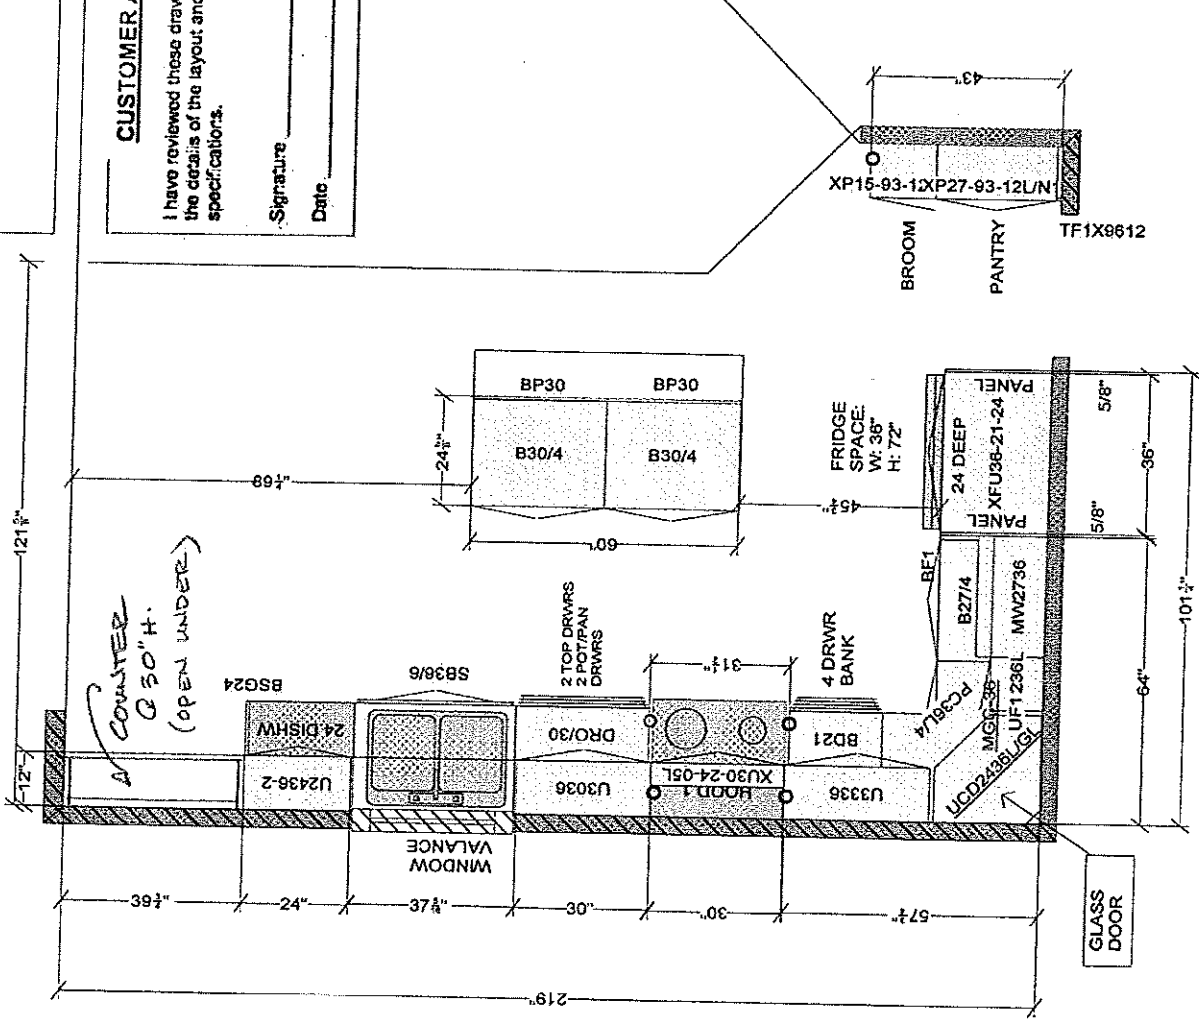

All dimensions size designations given are subject to verification on job site and adjustment to fit job conditions.

CARTIER KITCHENS OTTAWA

DCR - 81 SM 5 - KITCHEN 2 - March 8 - 12



KODAK



This is an original design and must not be released or copied unless applicable fee has been paid or job order placed.

DRAWN BY: LD
CARTIER KITCHENS OTTAWA

Designed: 3/8/2012
Printed: 3/8/2012

Drawing #: 1	No Scale.
--------------	-----------

Drawing #: 1	No Scale.
--------------	-----------