


LOT 143 SATOWALS.

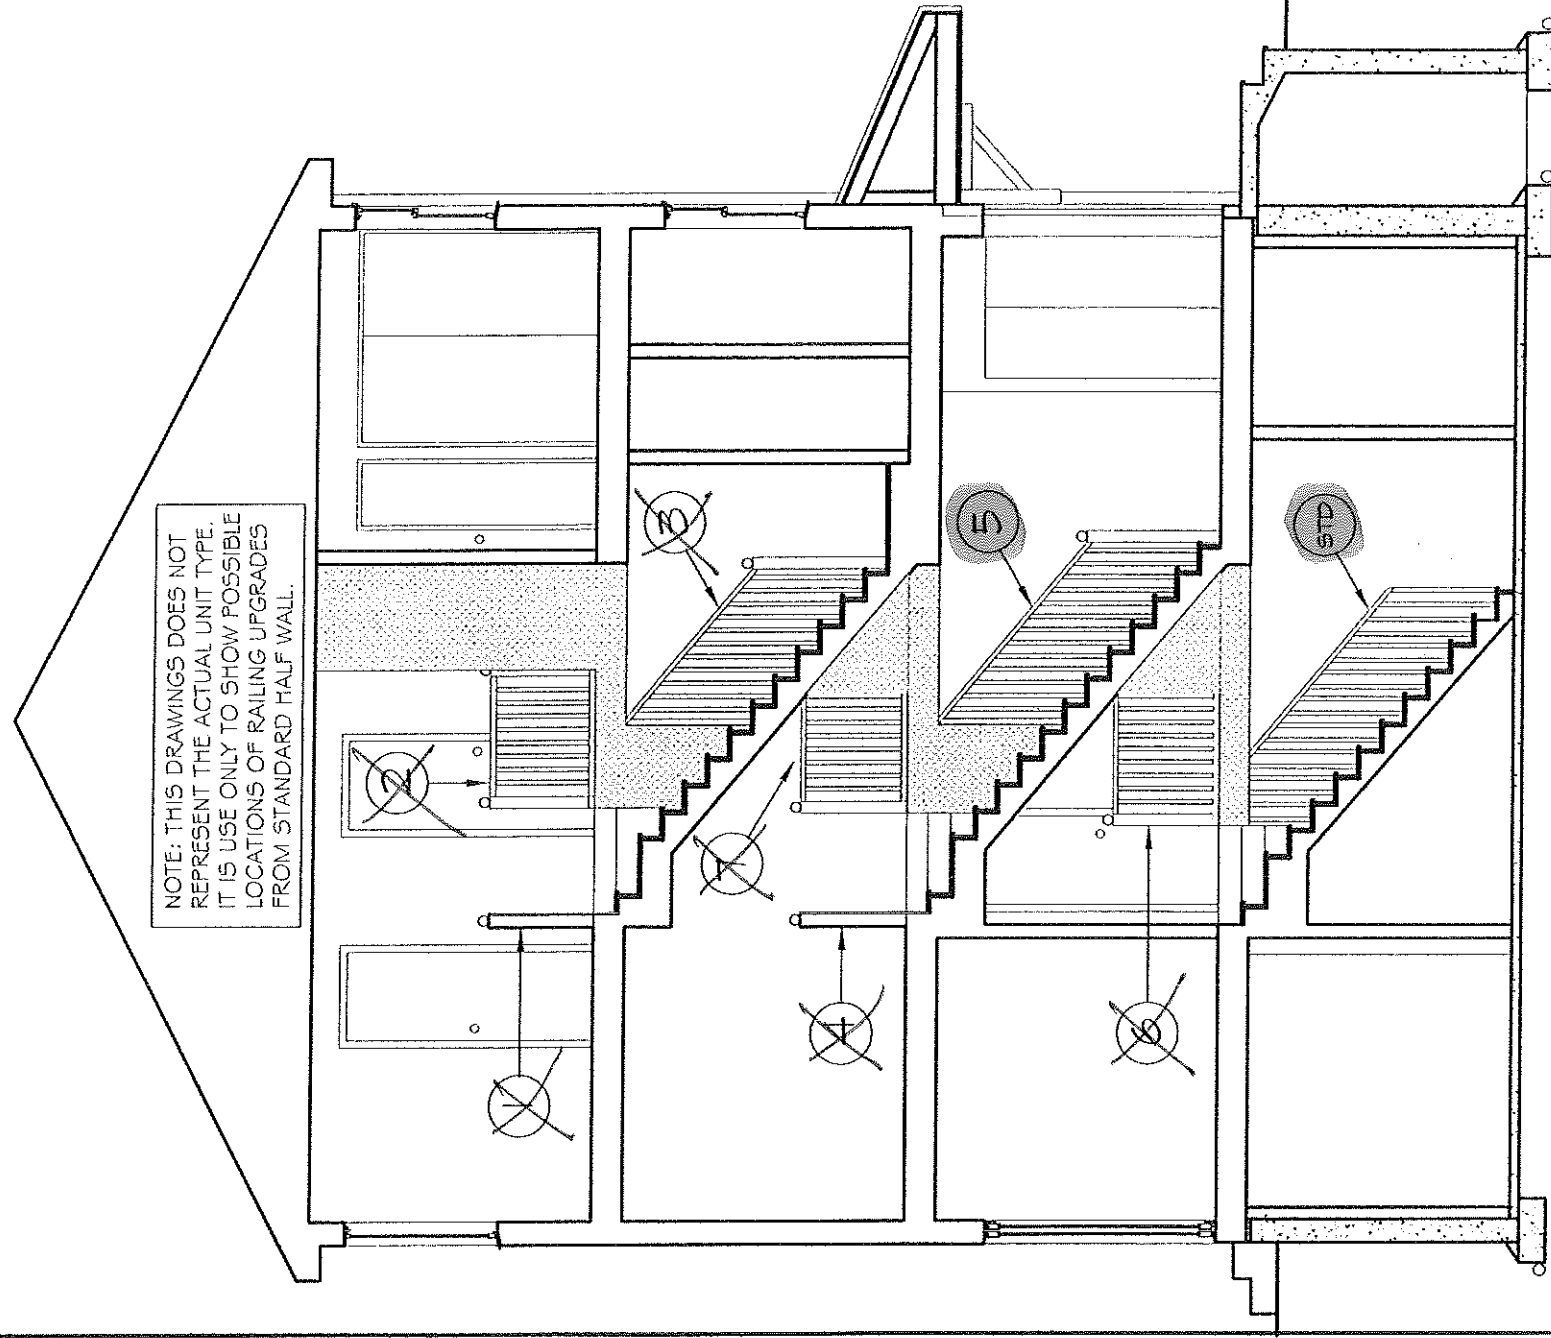

1 SECTION - TYPE 'A'

