

DCR PHOENIX HOMES

SHADOW RIDGE SEMIS

LOT #13L

MODEL SB4 - INDUS

CUSTOMER APPROVAL

I have reviewed these drawings and understand the details of the layout and the Cartier Kitchens specifications.


Signature _____

Date _____

KITCHEN / VANITIES


MOUNTING HT - 96" + 3" CROWN + 1 "FILLER TO BULKHEAD = 100"

(CUSTOM BULKHEAD BY BUILDER)

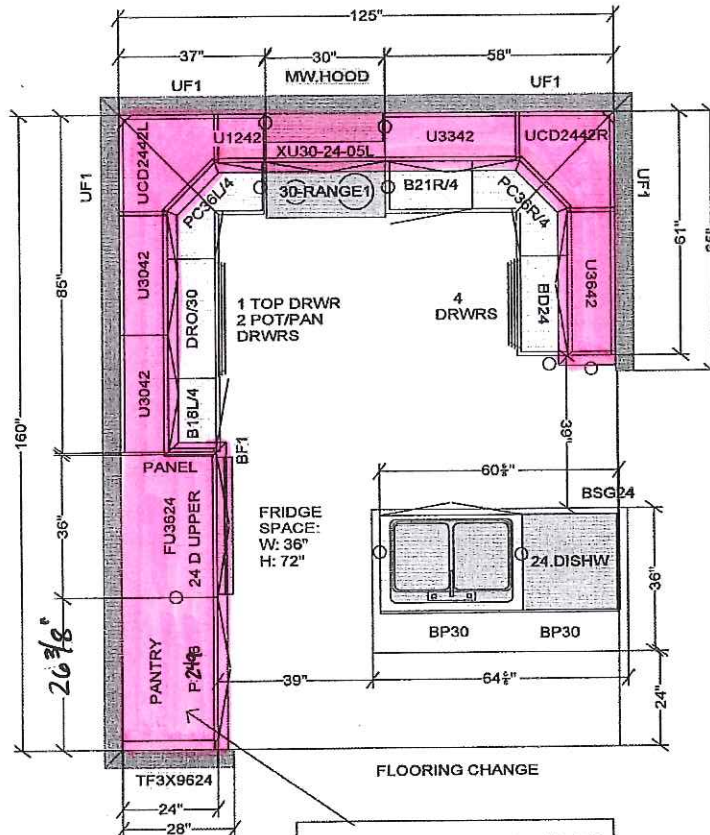


BULKHEAD

INCREASE LENGTH OF
KITCHEN
ADD 24" PANTRY

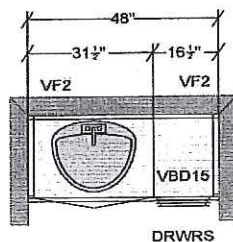

MAIN BATH VANITY

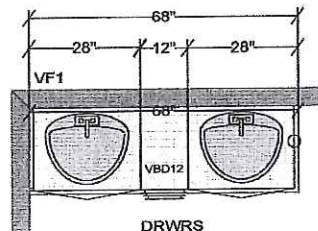

ENSUITE VANITY

All dimensions size designations given are subject to verification on job site and adjustment to fit job conditions.

CARTIER KITCHENS OTTAWA



2020 TECHNOLOGIES

This is an original design and must not be released or copied unless applicable fee has been paid or job order placed.

DRAWN BY: LORI DISAVERIO, B.I.D.
CARTIER KITCHENS OTTAWA

Designed: 5/26/2013
Printed: 5/26/2013