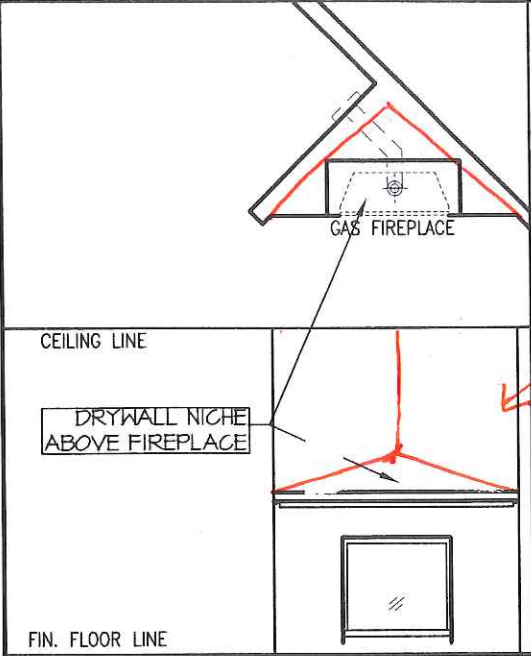
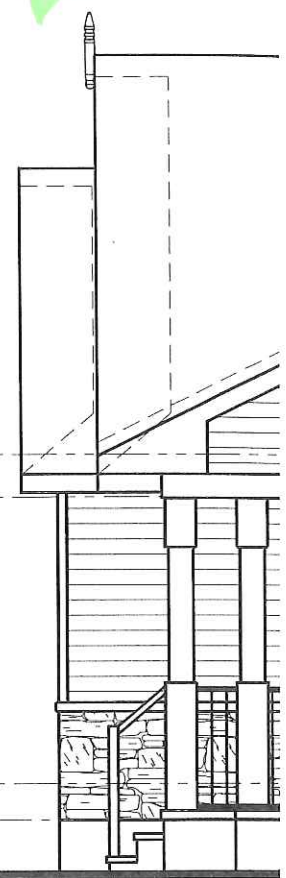
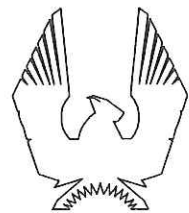


LOT 33R.
DRYWALL NICHE
ABOVE FIREPLACE

 CEILING LINE FIN. FLOOR LINE DRYWALL NICHE ABOVE FIREPLACE GAS FIREPLACE FULL NICHE INTO CORNER		
NICHE INTERIOR ELEV. (FP @ GREAT RM.)		
RIGHT SIDE (FOR OPT. S)		
 PHOENIX HOMES	SB-4 INDUS 20 SITE: SHADOW RI LOT NUMBER: CIVIC ADDRESS: 6619 CALWOOD AVE.	