


DCR PHOENIX HOMES

SHADOW RIDGE TOWNS


MODEL SB6 - ORION

KITCHEN / VANITIES

MOUNTING HT - 90"

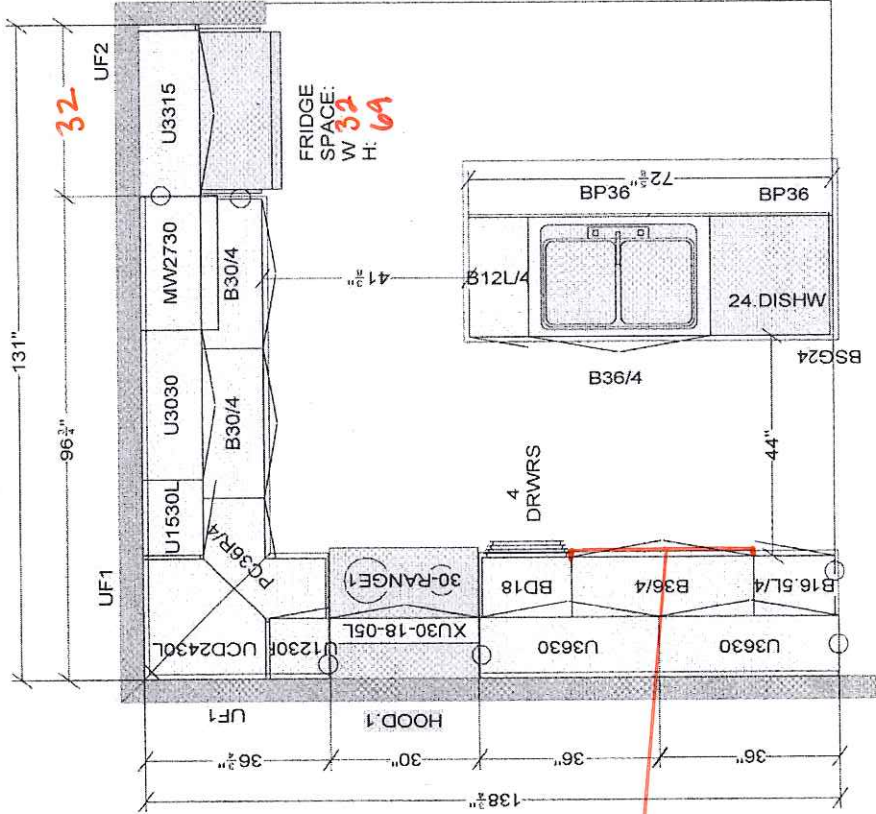



Pot + Pan Drawer

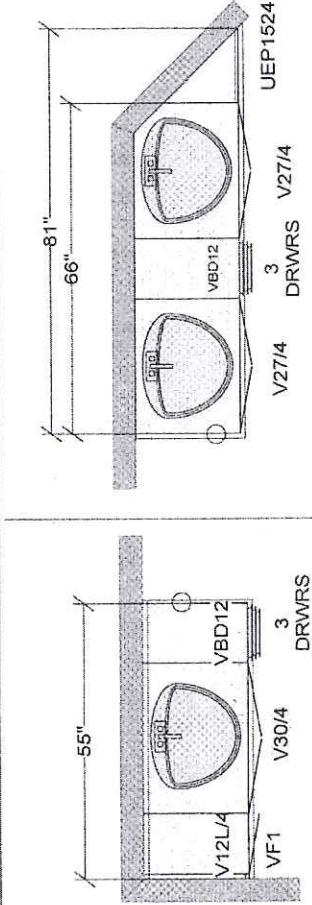

MAIN BATH

 ENSUITE

All dimensions - size designations given are subject to verification on job site and adjustment to fit job conditions.	 	This is an original design and must not be released or copied unless applicable fee has been paid or job order placed.	Designed: 1/18/2013 Printed: 1/18/2013	
CARTIER KITCHENS OTTAWA		DRAWN BY: LD CARTIER KITCHENS OTTAWA		
DCR - Shadow Ridge Towns - SB6 - ORION		All	Drawing #: 1	No Scale.

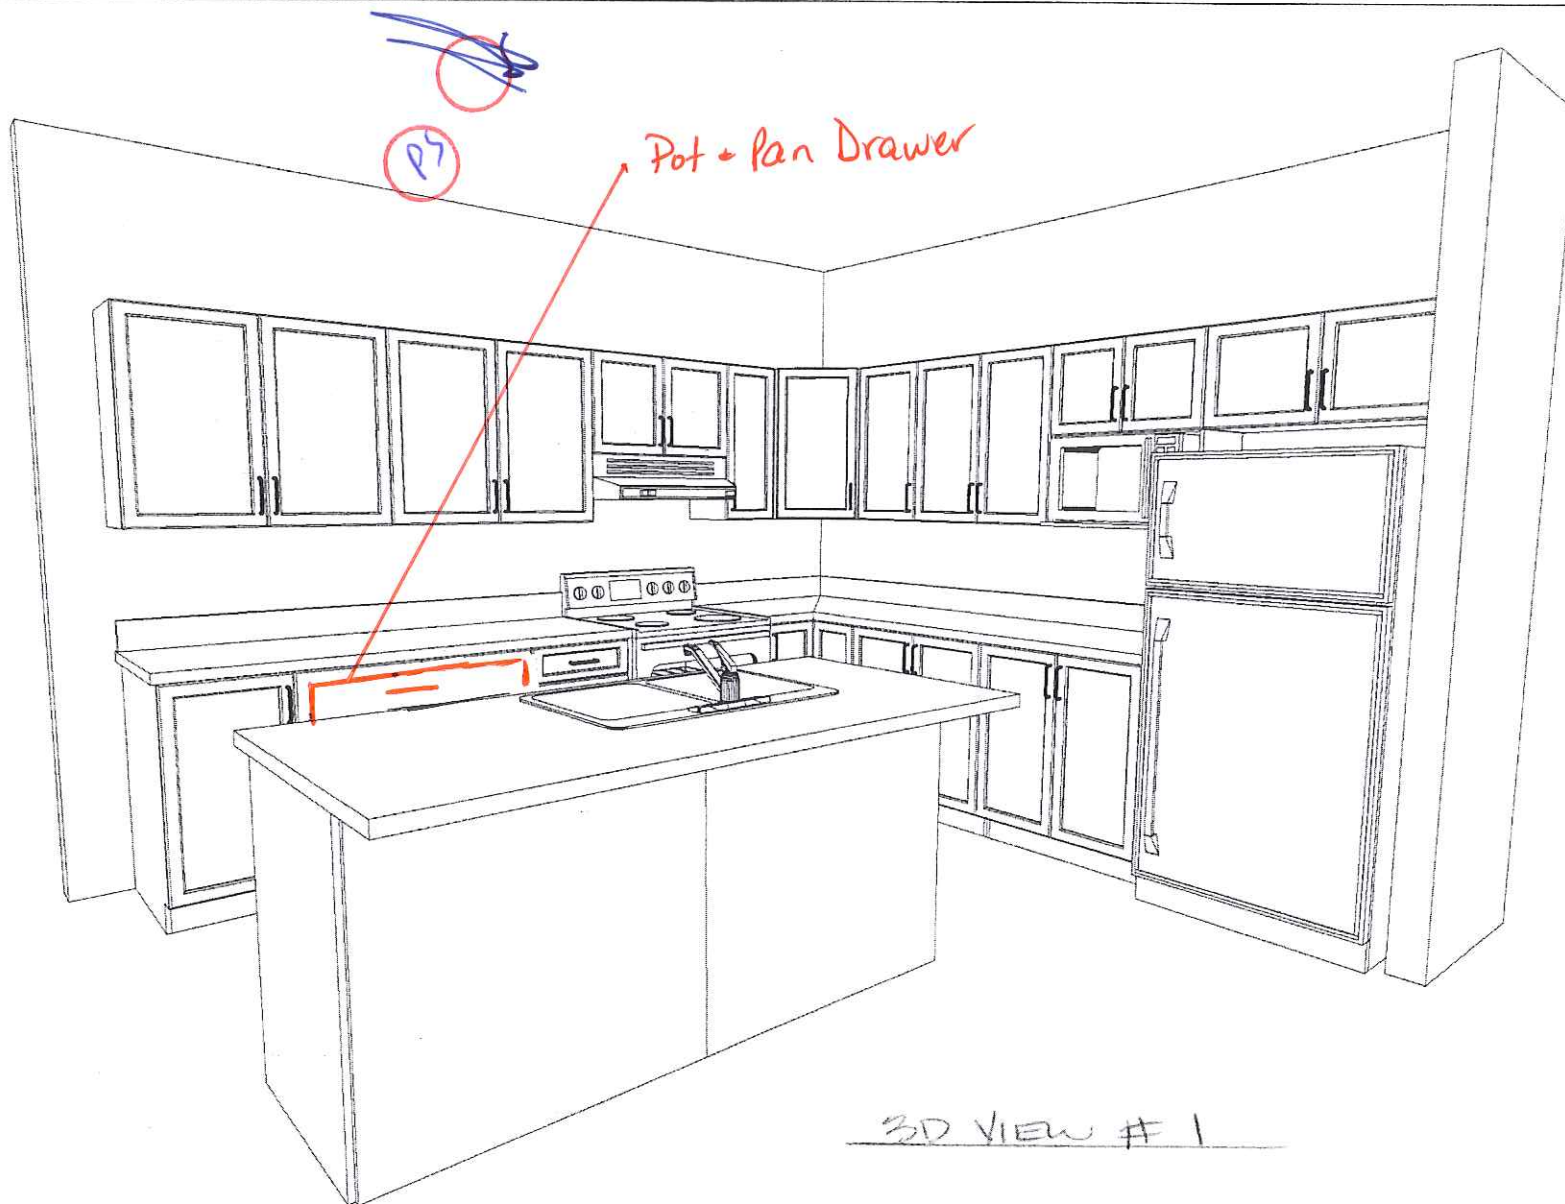

Note: This drawing is an artistic interpretation of the general appearance of the design. It is not meant to be an exact rendition.



Designed: 1/18/2013
Printed: 3/17/2013




DESIGNED BY: LORI DISAVERIO.

DCR - Shadow Ridge *Semi* - SB6 - ORION

All

Drawing #: 1

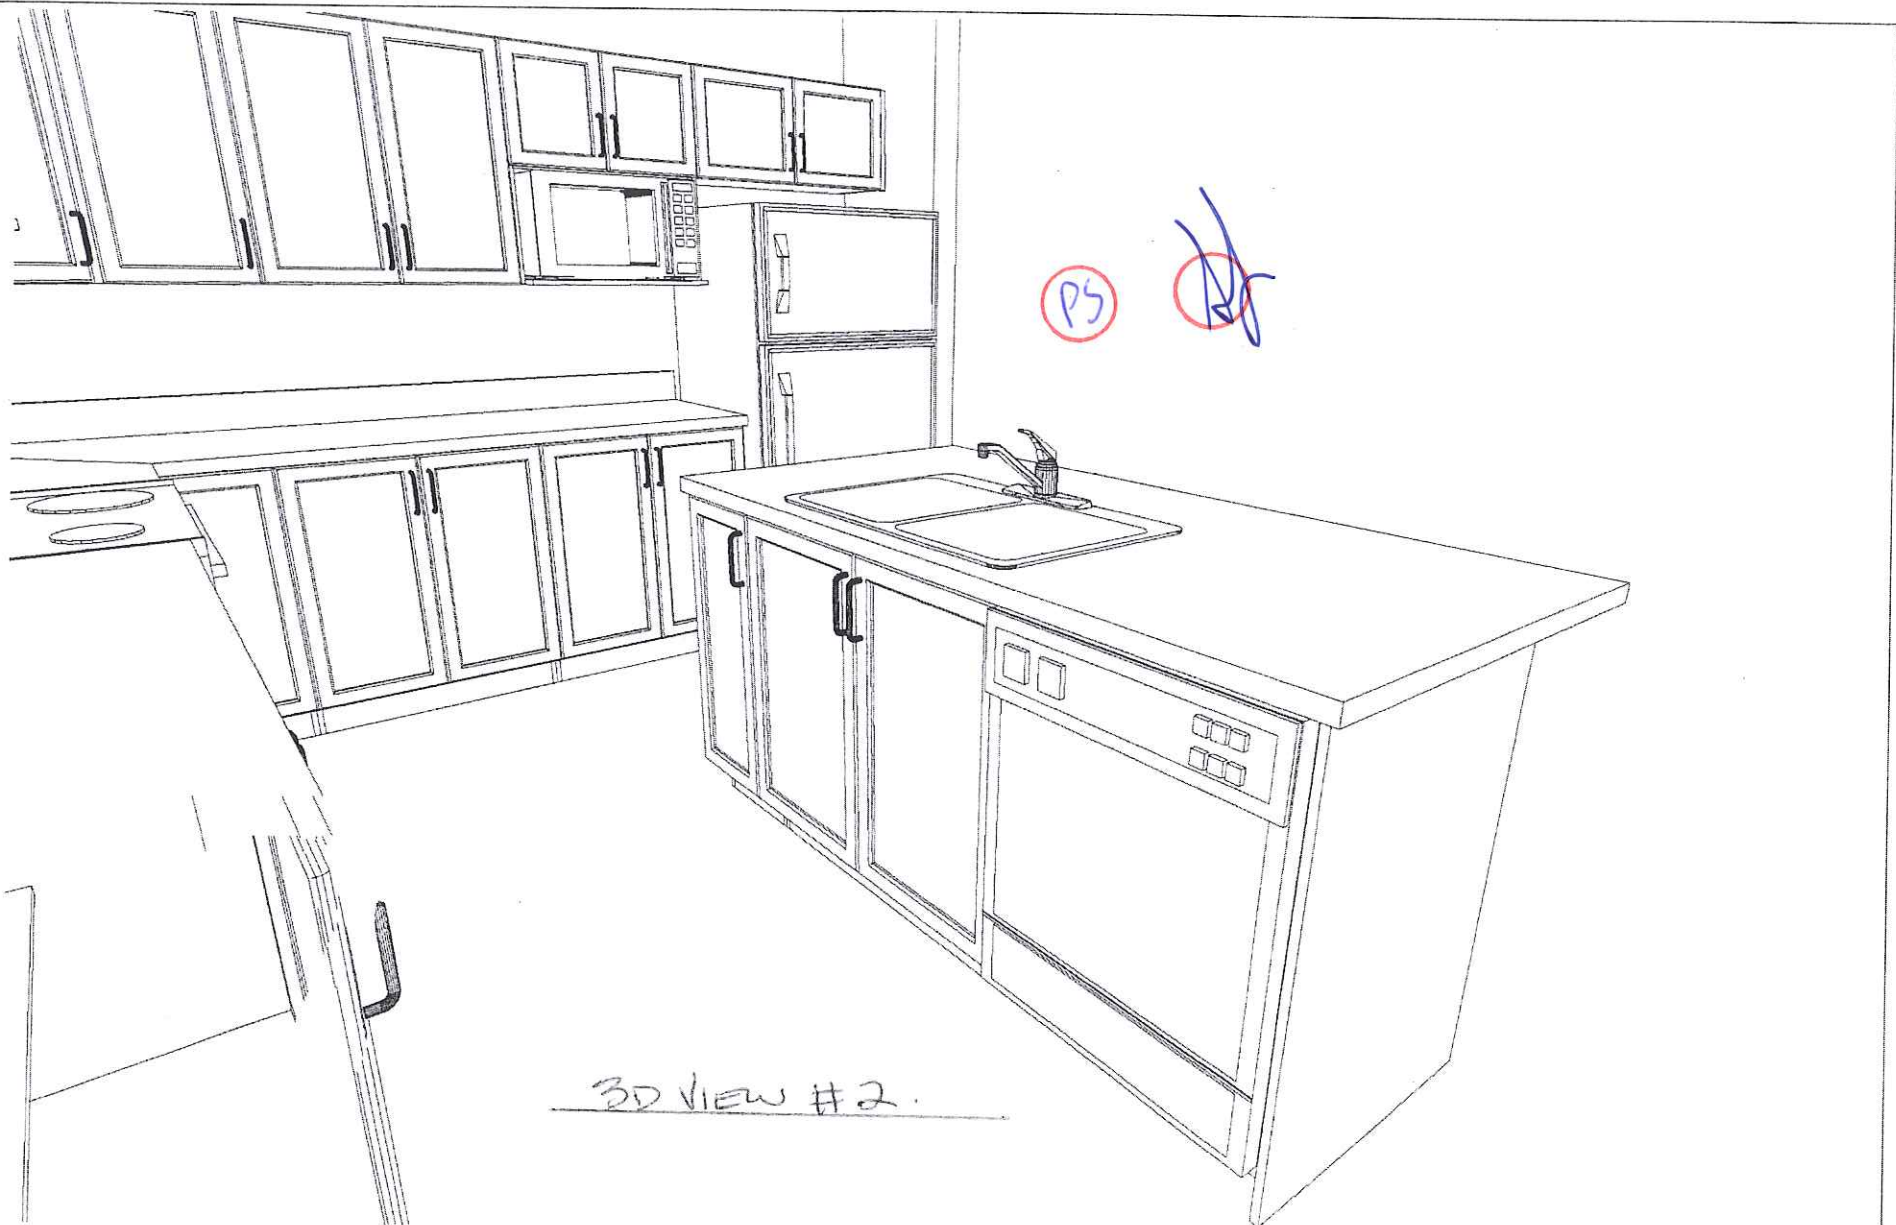

3D VIEW #2.

Note: This drawing is an artistic interpretation of the general appearance of the design. It is not meant to be an exact rendition.


DESIGNED BY: LORI DISAVERIO.
DCR - Shadow Ridge *Semi* - SB6 - ORION



Designed: 1/18/2013
Printed: 3/17/2013

All

Drawing #: 1

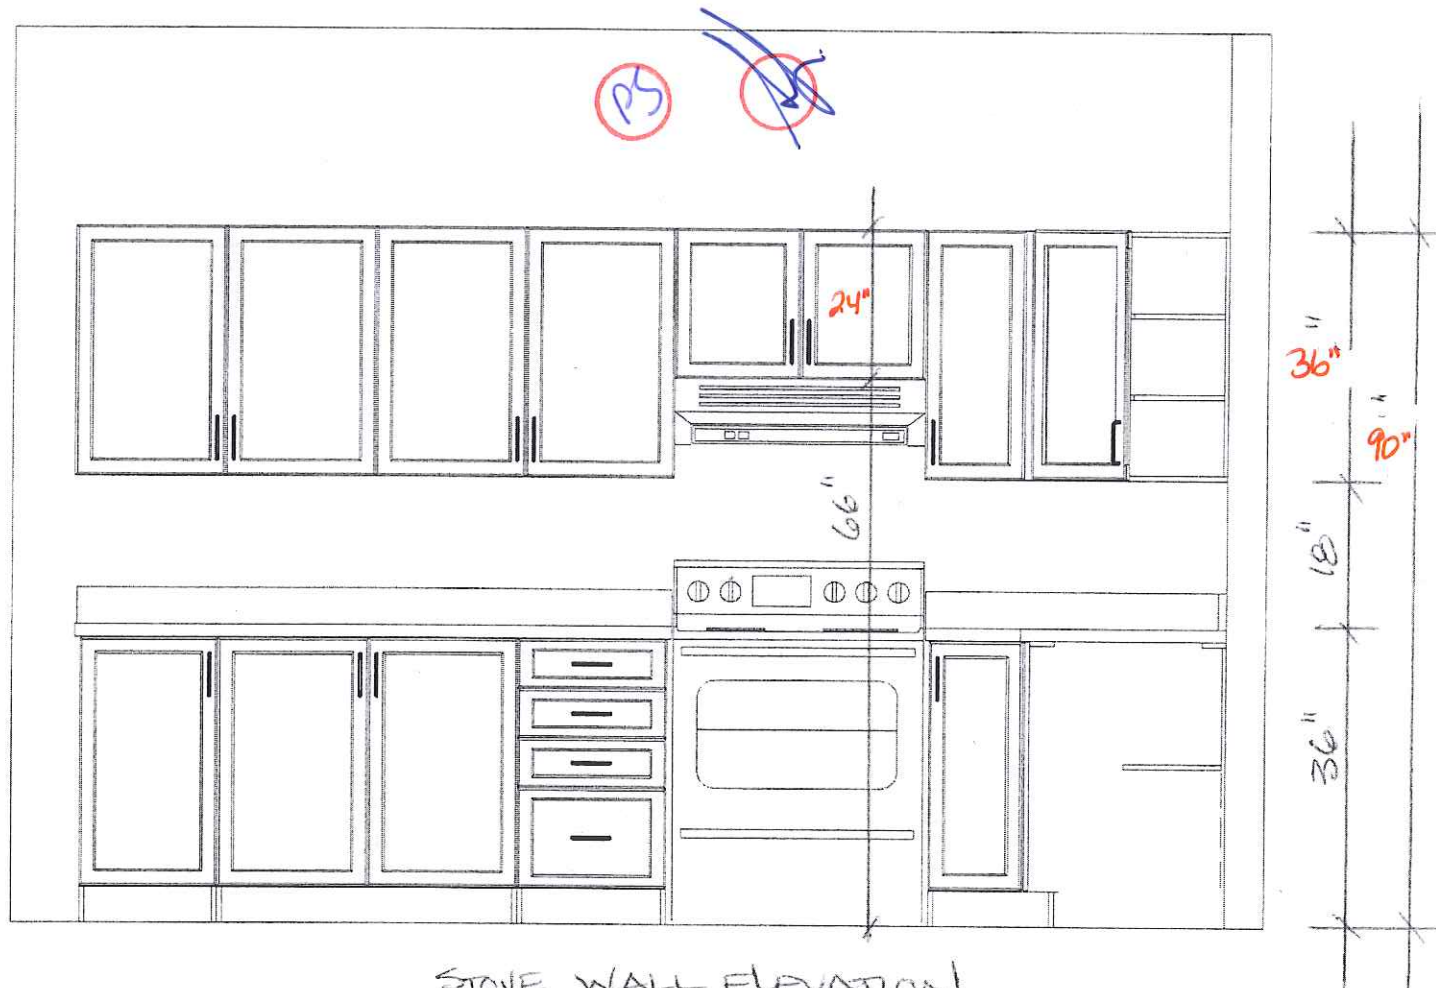

STOVE WALL ELEVATION

Note: This drawing is an artistic interpretation of the general appearance of the design. It is not meant to be an exact rendition.




Designed: 1/18/2013
Printed: 3/17/2013



DESIGNED BY: LORI DISAVERIO,
DCR - Shadow Ridge *semi* - SB6 - ORION


All

Drawing #: 1

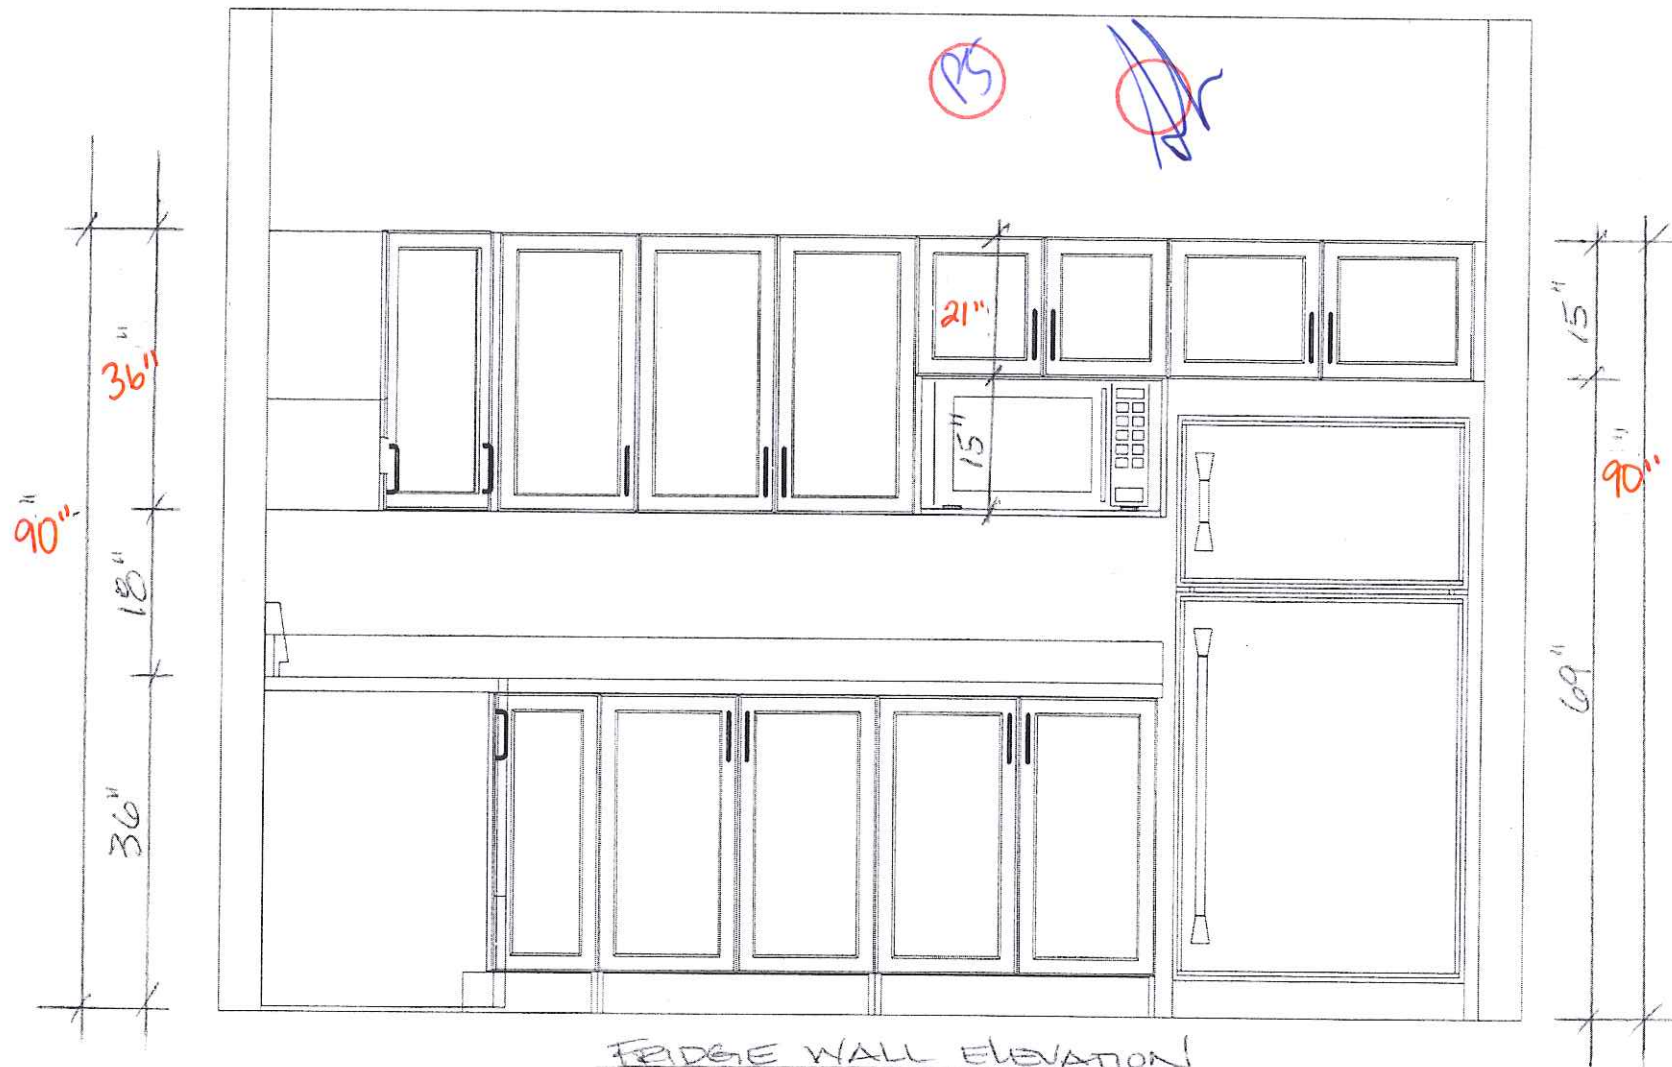

FRIDGE WALL ELEVATION

Note: This drawing is an artistic interpretation of the general appearance of the design. It is not meant to be an exact rendition.

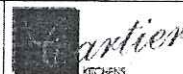


Designed: 1/18/2013
Printed: 3/17/2013

DESIGNED BY: LORI DISAVERIO.

DCR - Shadow Ridge Semi. - SB6 - ORION

All

Drawing #: 1

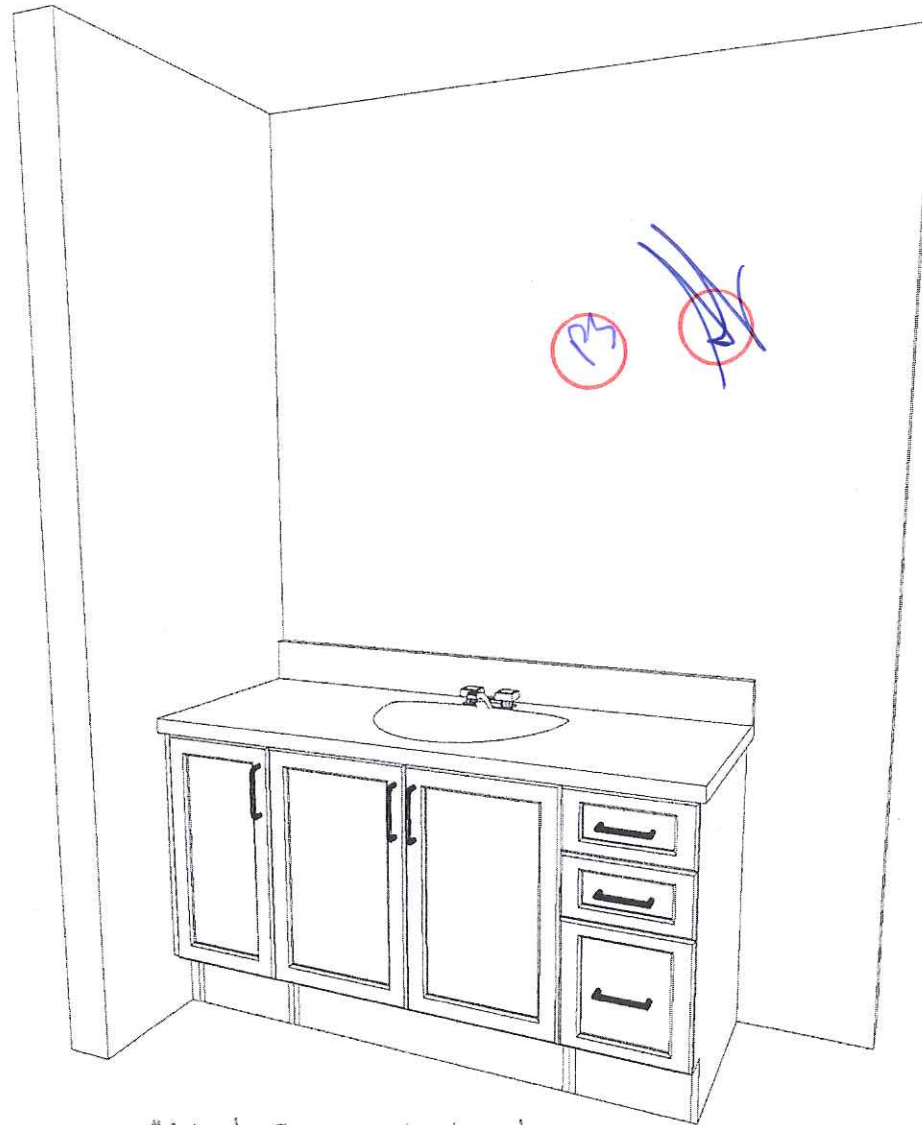

MAIN BATH VANITY.

Note: This drawing is an artistic interpretation of the general appearance of the design. It is not meant to be an exact rendition.




Designed: 1/18/2013
Printed: 3/17/2013

DESIGNED BY: LORI DISAVERIO.

DCR - Shadow Ridge Semi - SB6 - ORION

All

Drawing #: 1

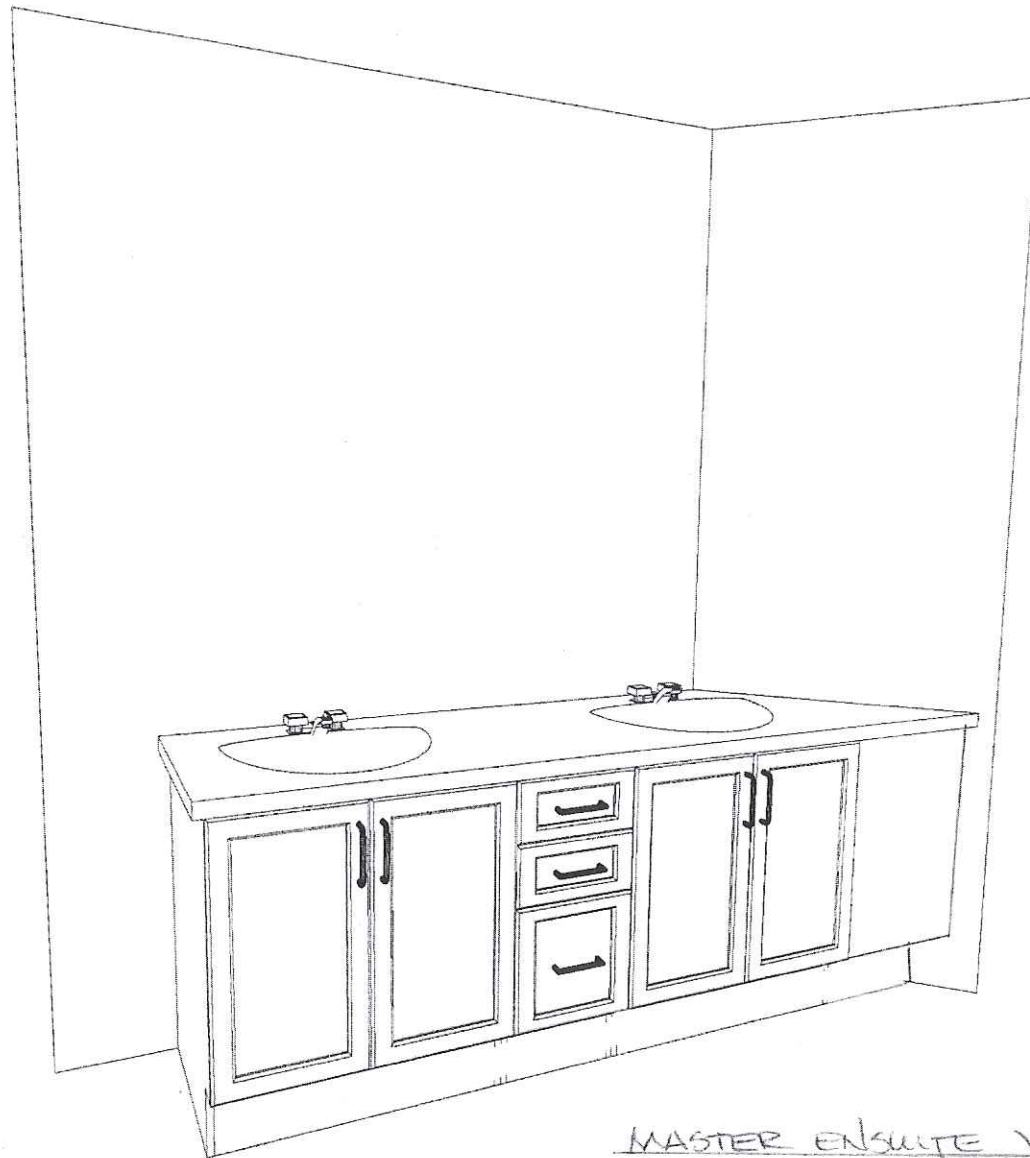

DS

RV

MASTER ENSUITE VANITY

Note: This drawing is an artistic interpretation of the general appearance of the design. It is not meant to be an exact rendition.



Designed: 1/18/2013
Printed: 3/17/2013

DESIGNED BY: LORI DISAVERIO.

DCR - Shadow Ridge Semi - SB6 - ORION

All

Drawing #: 1