


Drawing #: 1	No Scale
--------------	----------

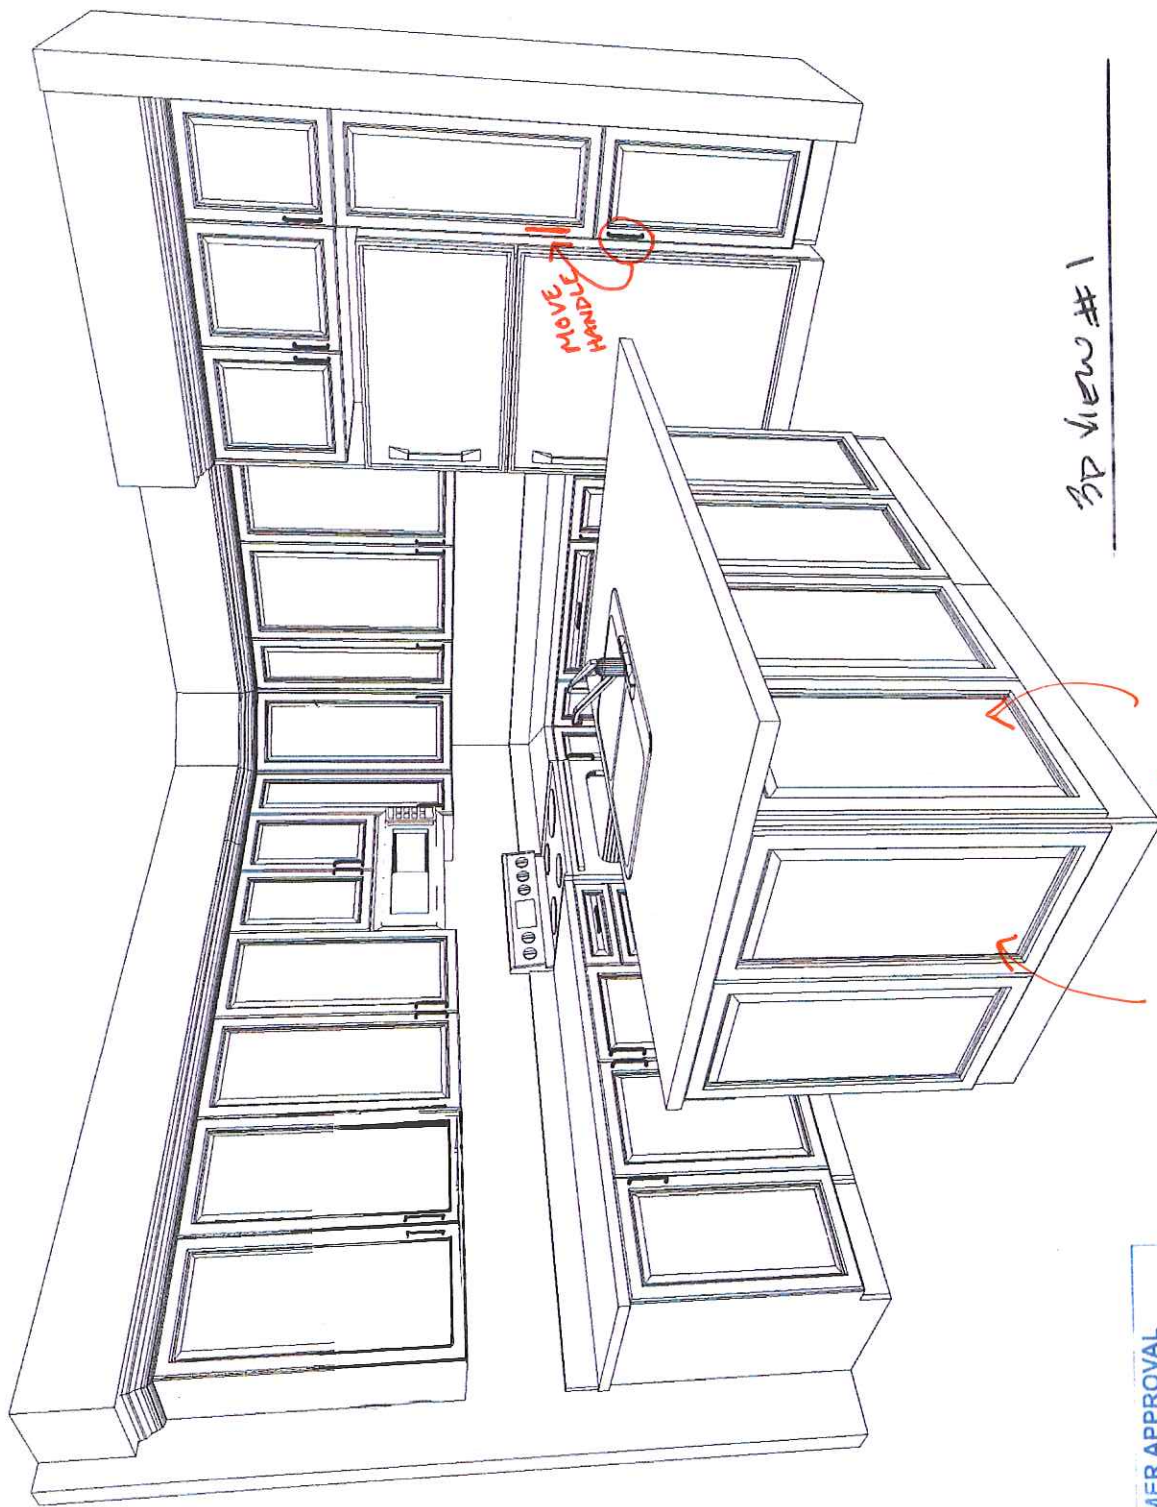

3D VIEW #1

CUSTOMER APPROVAL

I have reviewed these drawings and understand the details of the layout and the Cartier Kitchens specifications.

Signature [Signature]

Date Sep. 14/13

Note: This drawing is an artistic interpretation of the general appearance of the design. It is not meant to be an exact rendition.



2020
TECHNOLOGIES


Designed: 4/5/2013
Printed: 4/5/2013

DESIGNED BY: LORI DISAVERIO.

DCR - Shadow Ridge Semis - SB6 - ORION -

All

Drawing #: 1

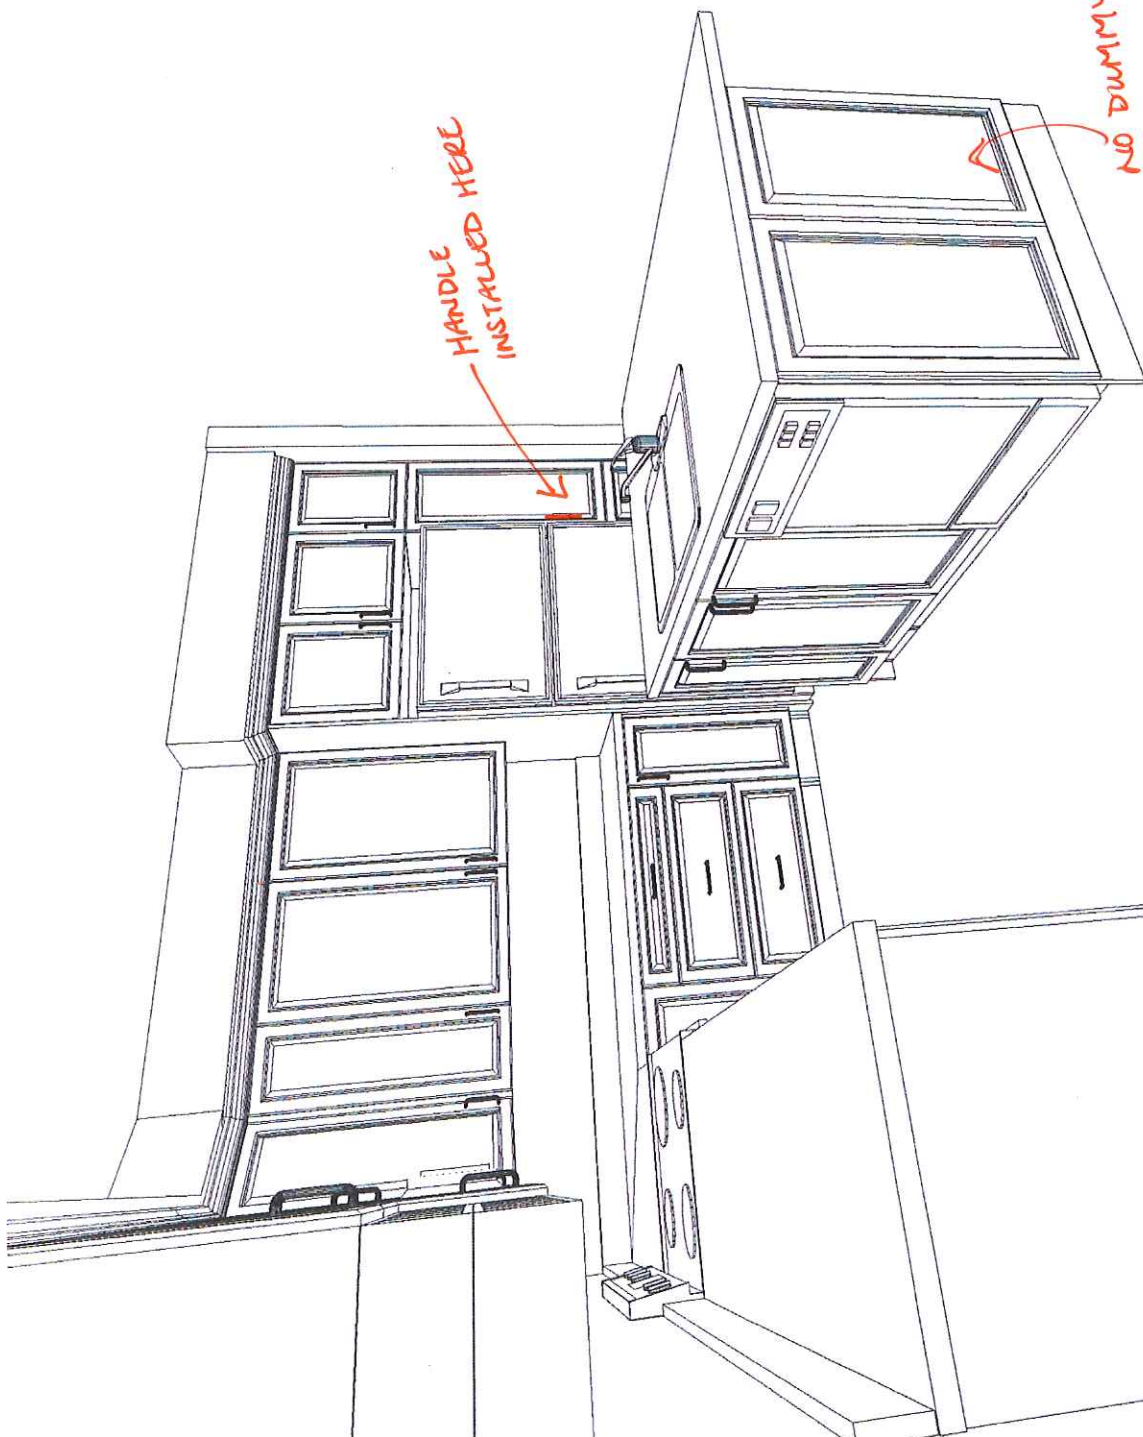

3D View # 2

CUSTOMER APPROVAL

I have reviewed these drawings and understand the details of the layout and the Kitchen's specifications.

Signature: WD GMR

Date: Sep. 14/13

Designed: 4/5/2013
Printed: 4/5/2013





Note: This drawing is an artistic interpretation of the general appearance of the design. It is not meant to be an exact rendition.

DESIGNED BY: LORI DISAVERIO.

DCR - Shadow Ridge Semis - SB6 - ORION -

All

Drawing #: 1

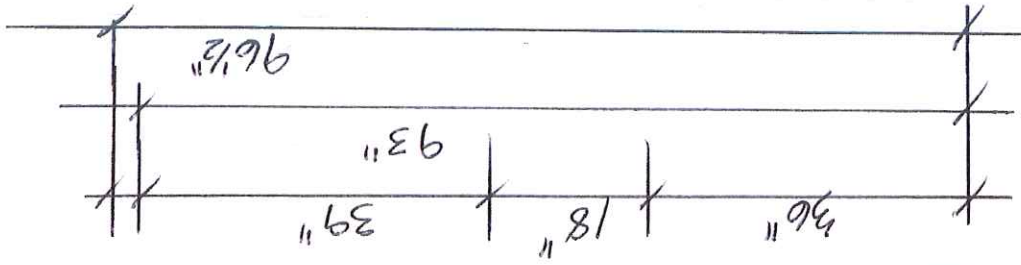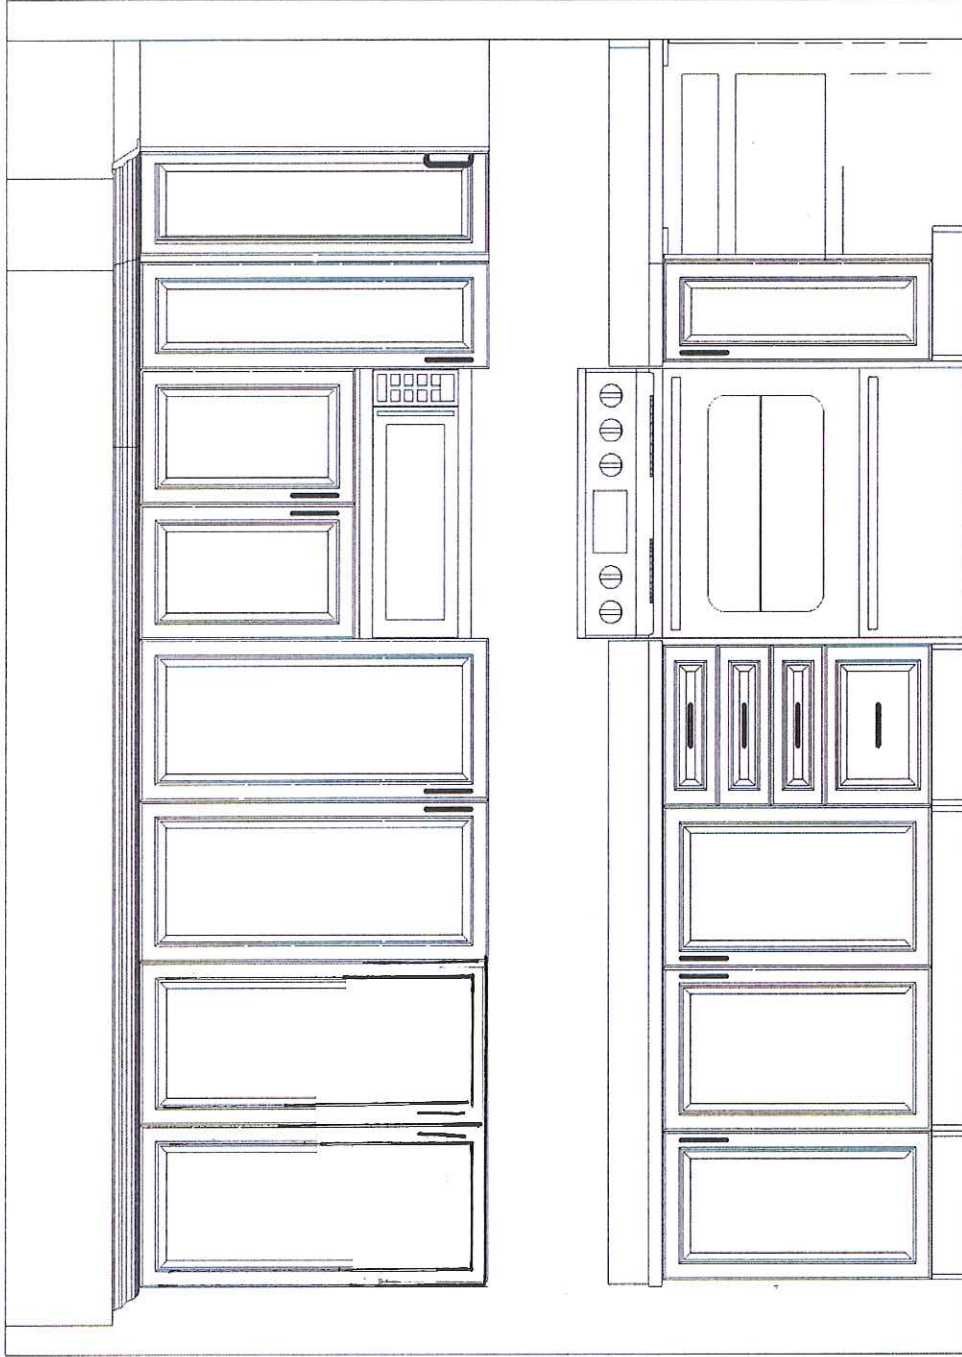

stove wall elevation

CUSTOMER APPROVAL

I have reviewed these drawings and understand the details of the layout and the Carrier Kitchen's specifications.

Signature WD Date Sep. 14/13

Note: This drawing is an artistic interpretation of the general appearance of the design. It is not meant to be an exact rendition.




Designed: 4/5/2013
Printed: 4/5/2013

DESIGNED BY: LORI DISAVERIO.


DCR - Shadow Ridge Semis - SB6 - ORION -

All

Drawing #: 1

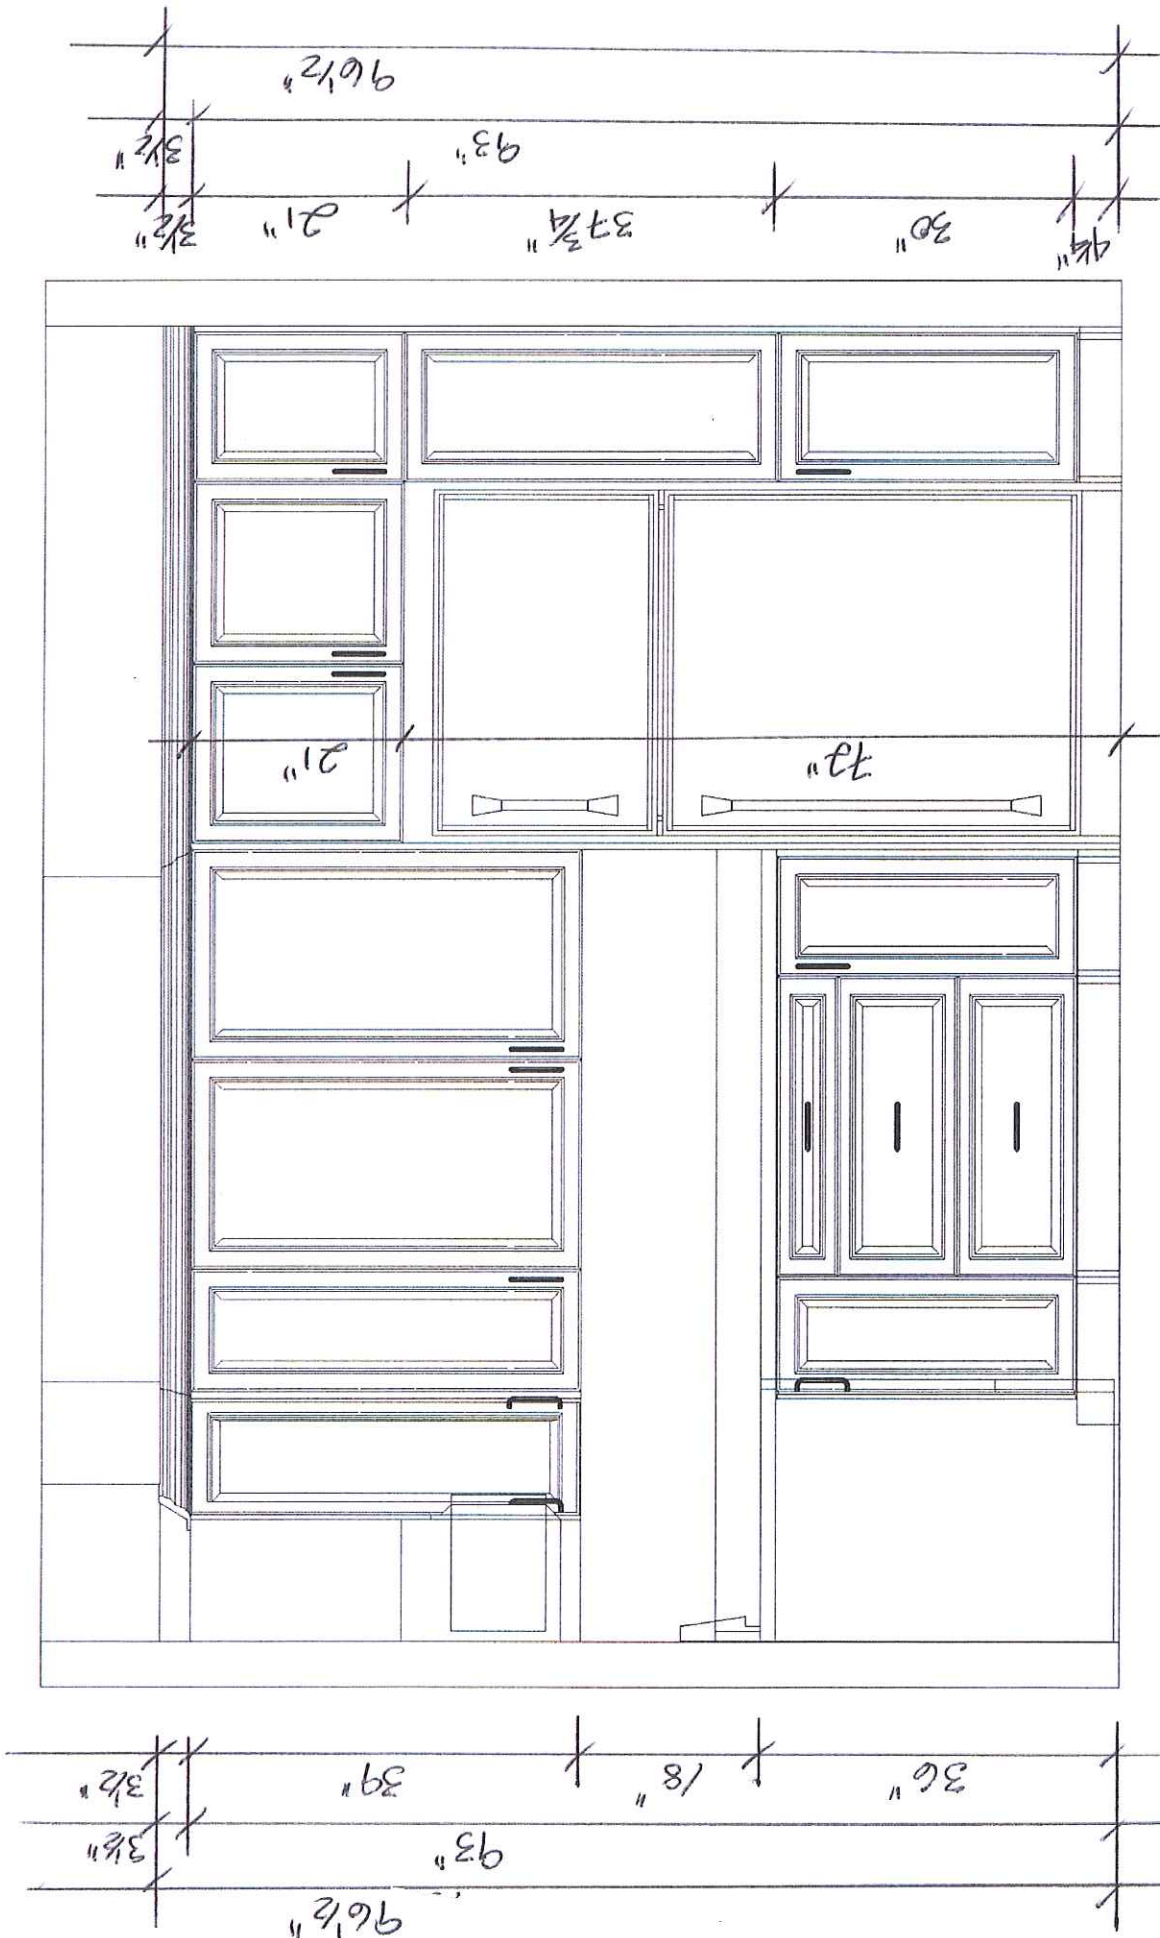

Designed: 4/5/2013
Printed: 4/5/2013

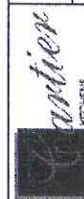

Note: This drawing is an artistic interpretation of the general appearance of the design. It is not meant to be an exact rendition.

DESIGNED BY: LORI DISAVERIO.

DCR - Shadow Ridge Semis - SB6 - ORION -

All

Drawing #: 1

CUSTOMER APPROVAL


I have reviewed these drawings and understand the details of the layout and the Cabinet-Kitchens specifications.

2D JMR

Signature

Date

Sep. 14/13

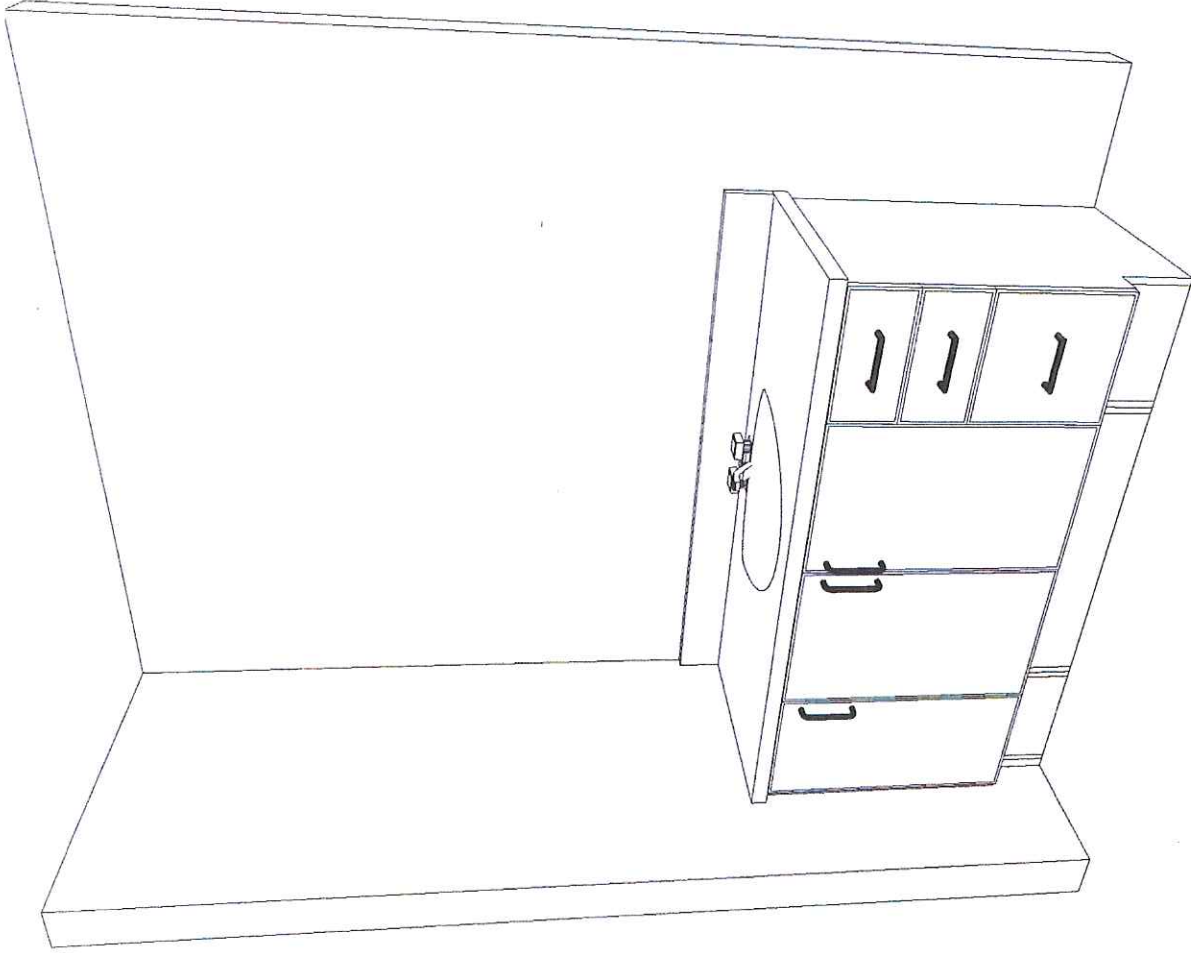

MAN BATH VANITY

CUSTOMER APPROVAL

I have reviewed these drawings and understand the details of the layout and the Contractor's specifications.

WD  CMR 

Signature _____

Date Sep. 14/13

Note: This drawing is an artistic interpretation of the general appearance of the design. It is not meant to be an exact rendition.

DESIGNED BY: LORI DISAVERIO.


DCR - Shadow Ridge Semis - SB6 - ORION -



Designed: 4/5/2013
Printed: 4/5/2013

All

Drawing #: 1

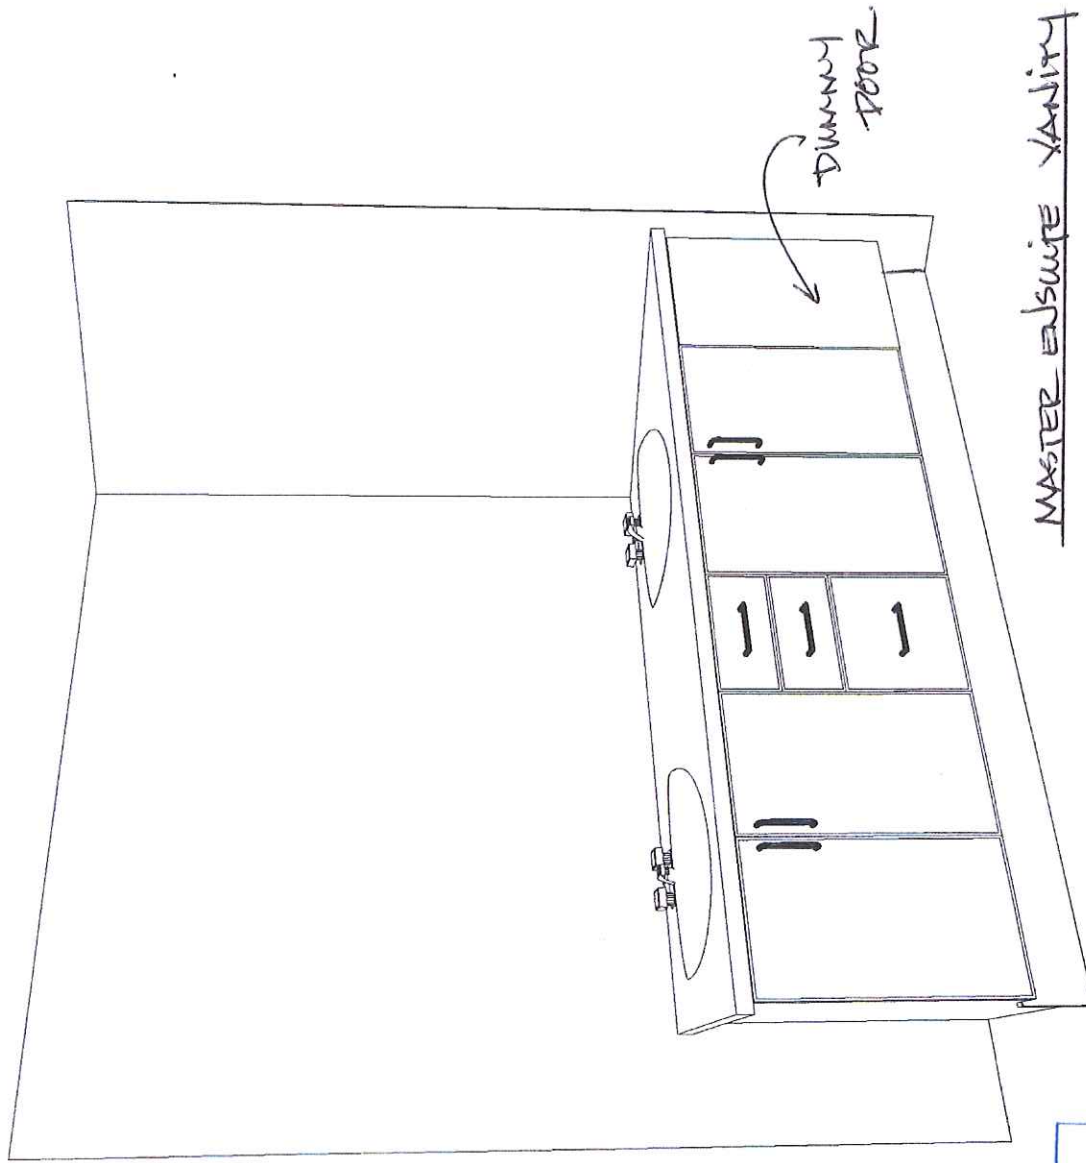

MASTER ensuite vanity

CUSTOMER APPROVAL


I have reviewed these drawings and understand the details of the layout and the Carter-Kitchens specifications.

NO  GMR

Signature

Date Sep. 14/13

Note: This drawing is an artistic interpretation of the general appearance of the design. It is not meant to be an exact rendition.

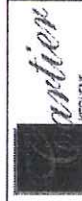

2020
TECHNOLOGIES

Designed: 4/5/2013
Printed: 4/5/2013

DESIGNED BY: LORI DISAVERIO.

DCR - Shadow Ridge Semis - SB6 - ORION

All

Drawing #: 1