



DCR PHOENIX HOMES

SHADOW RIDGE TOWNS


MODEL SB4 - INDUS

KITCHEN / VANITIES

MOUNTING HT - 84"

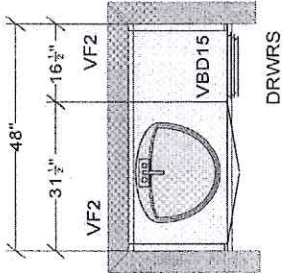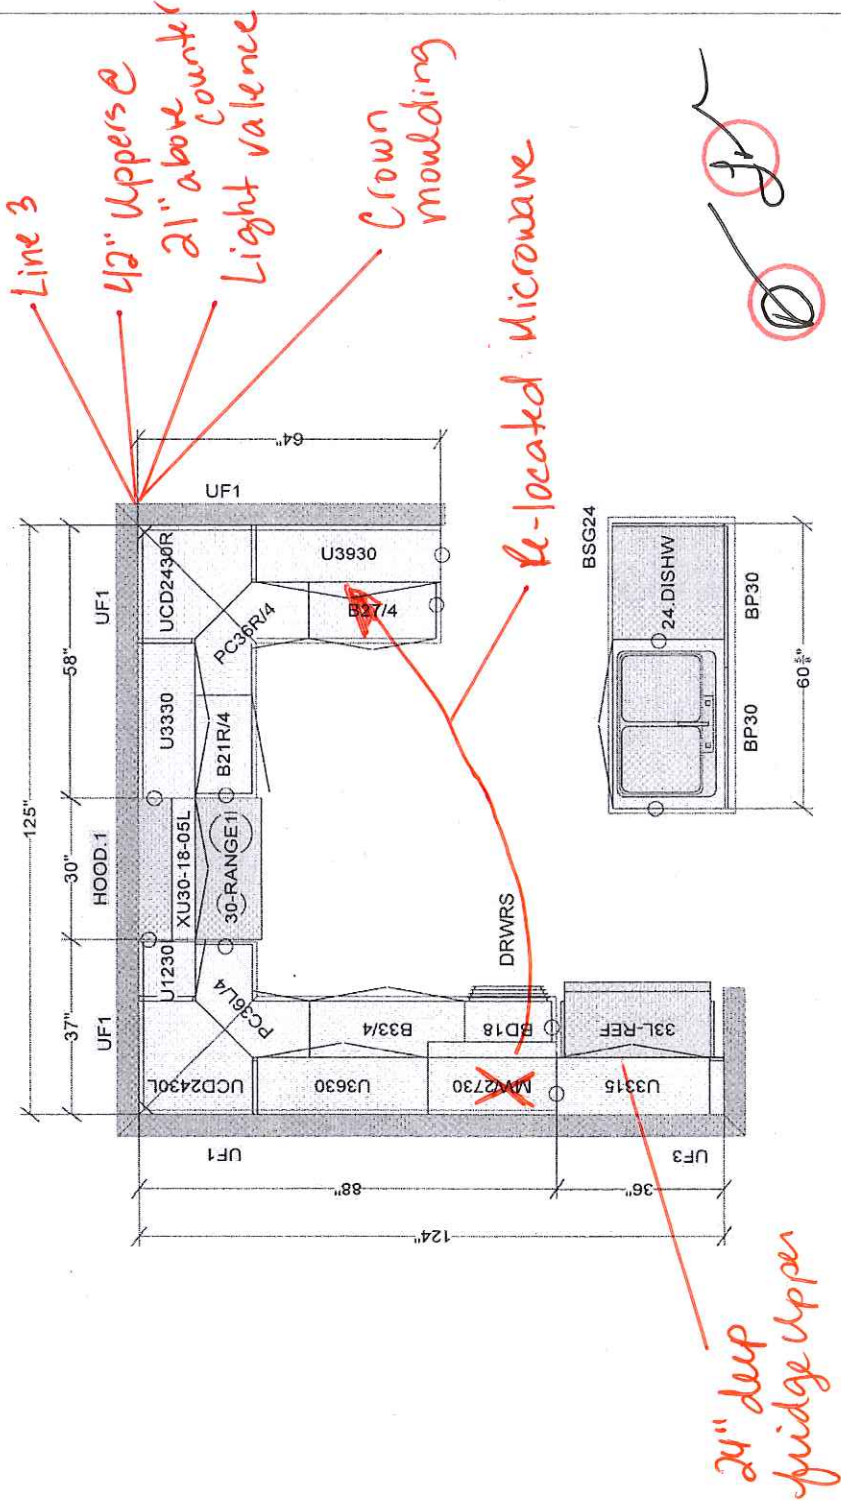

MAIN BATH VANITY

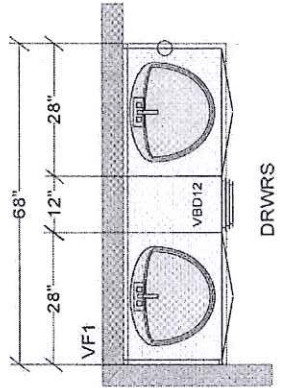

ENSUITE VANITY

All dimensions, size designations given are subject to verification on job site and adjustment to fit job conditions.	 	This is an original design and must not be released or copied unless applicable fee has been paid or job order placed.	Designed: 1/18/2013 Printed: 1/18/2013		
			DRAWN BY: LD CARTIER KITCHENS OTTAWA		
			DCR - Shadow Ridge Towns - SB4 - INDUS		
CARTIER KITCHENS OTTAWA			All	Drawing #: 1	No Scale.

Lot 36 R Shadow Ridge Semis
 Mary Marie / Rodney Dupras