
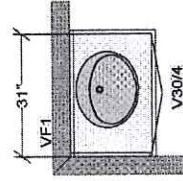


SHADOW RIDGE 2
LOT #58
MODEL - TUSCANA (S-6)



I have reviewed these drawings and understand the details of the layout and the Carter-Kitchens specifications. *[Signature]*

Date: March 27, 2013

MOUNTING HT: 90"/96"

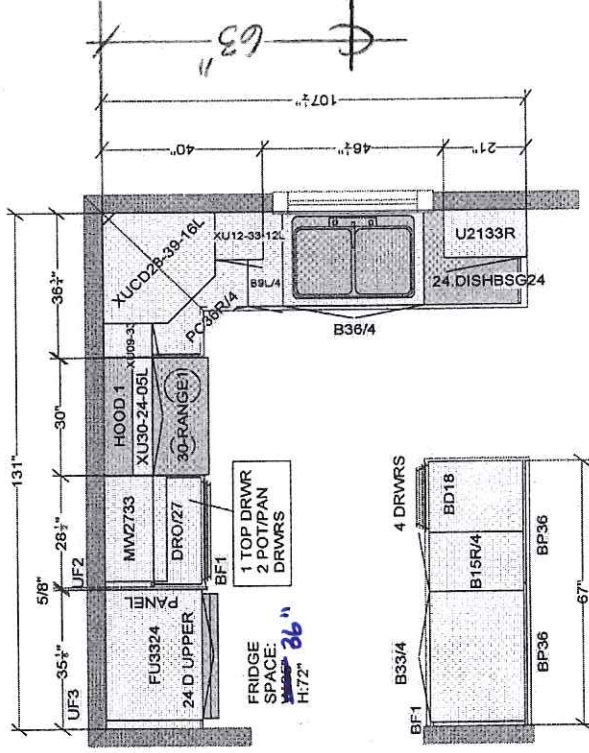


MAIN BATH

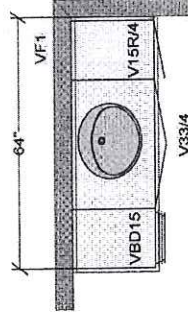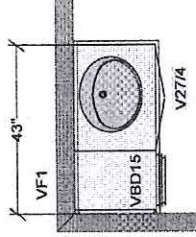

MASTER ENSUITE

All dimensions size designations given are subject to verification on job site and adjustment to fit job conditions.		This is an original design and must not be released or copied unless applicable fee has been paid or job order placed.	Designed: 10/10/2012 Printed: 11/11/2012
CARTIER KITCHENS OTTAWA		DRAWN BY: LD CARTIER KITCHENS OTTAWA	
DCR lot 58		All	Drawing #: 1 No Scale.

99 1/2"
 96"
 39"
 33"
 36"
 21"

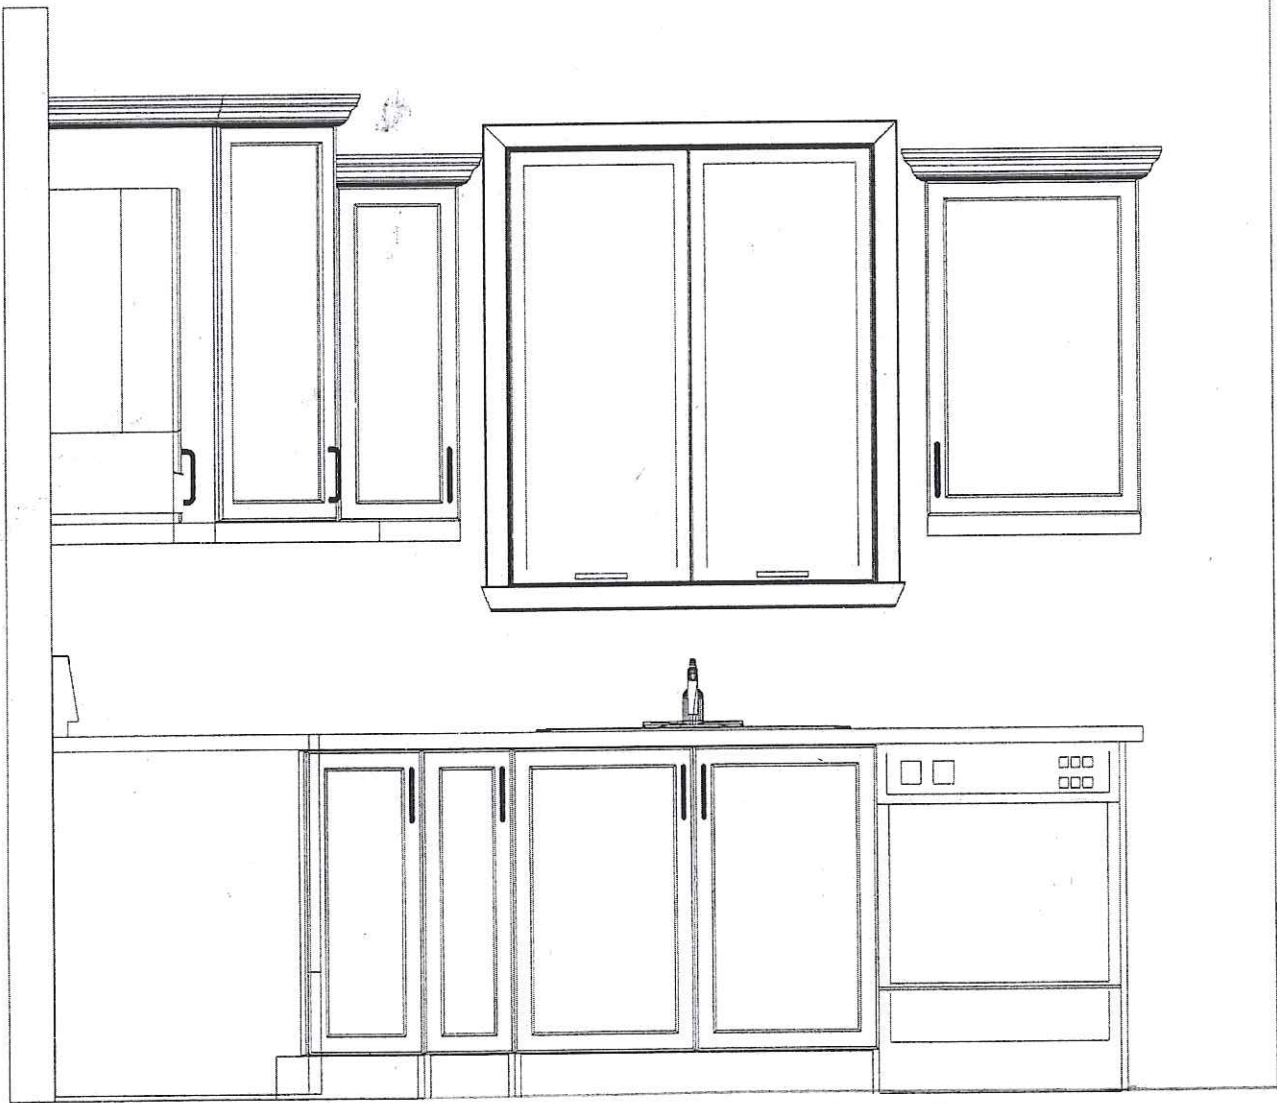

36"
 21"
 33"
 90"
 93 1/2"
 3 1/2"
 1 1/2"

SINK WALL ELEVATION

CUSTOMER APPROVAL

I have reviewed these drawings and understand the details of the layout and the Cartier Kitchens specifications.

Signature: *[Signature]*
 Date: *Mar. 27/13*

Paul Hana


Note: This drawing is an artistic interpretation of the general appearance of the design. It is not meant to be an exact rendition.

DESIGNED BY: LORI DISAVERIO,
 DCR lot 58



Designed: 10/10/2012
 Printed: 11/11/2012

Drawing #: 1

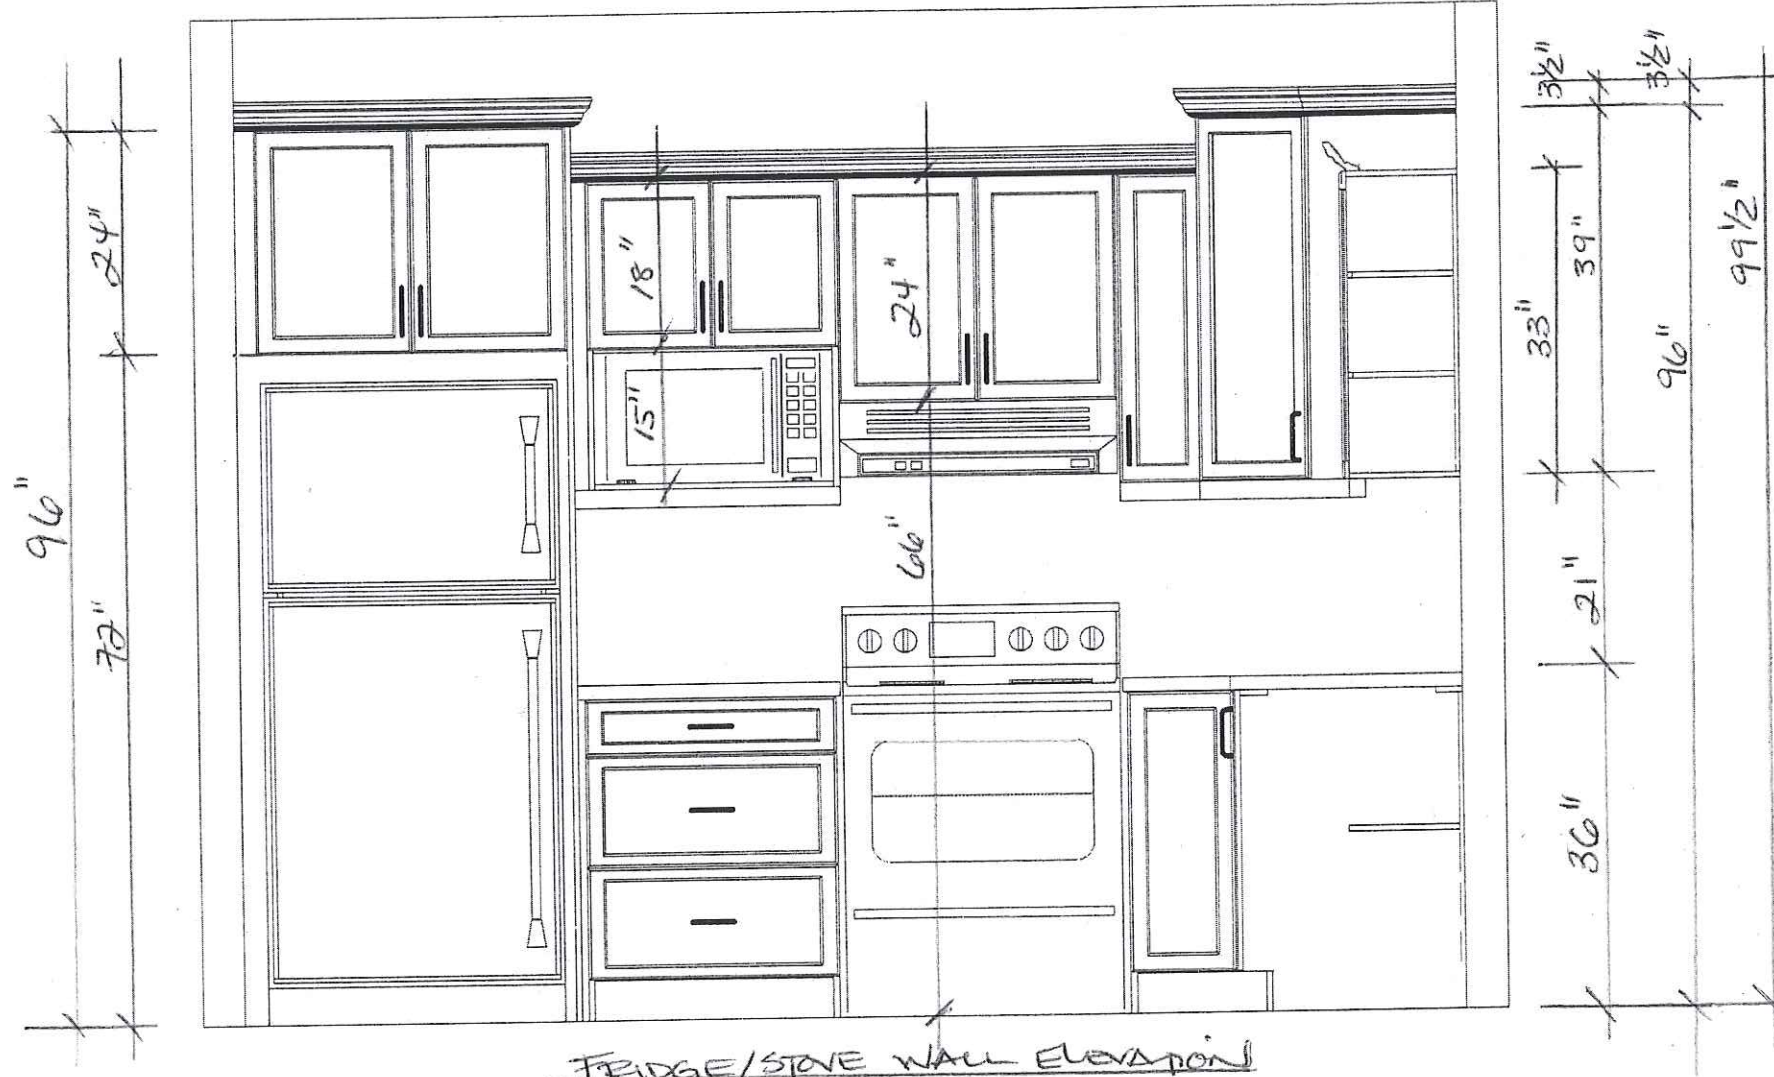

FRIDGE/STOVE WALL ELEVATION

CUSTOMER APPROVAL

I have reviewed these drawings and understand the details of the layout and the Cartier Kitchens specifications.

Signature: *[Signature]*
 Date: *Mar. 27/13*

Note: This drawing is an artistic interpretation of the general appearance of the design. It is not meant to be an exact rendition.

DESIGNED BY: LORI DISAVERIO,
 DCR lot 58



Designed: 10/10/2012
 Printed: 11/11/2012

All Drawing #: 1



3D View #1

CUSTOMER APPROVAL

I have reviewed these drawings and understand the details of the layout and the Cartier Kitchens specifications.

Signature

Date

Paul Warner
 Mar. 27/13.

Note: This drawing is an artistic interpretation of the general appearance of the design. It is not meant to be an exact rendition.



DESIGNED BY: LORI DISAVERIO,
 DCR lot 58

Designed: 10/10/2012
 Printed: 11/11/2012

All

Drawing #: 1