

DCR PHOENIX HOMES

SHADOW RIDGE 2


MODEL - GREGORIAN (S1)

LOT # 59

KITCHEN - REVISED NOV 6, 2012

OPTION 3 - SINK UNDER WINDOW - FLUSH ISLAND CAB

MOUNTING HT: 96"

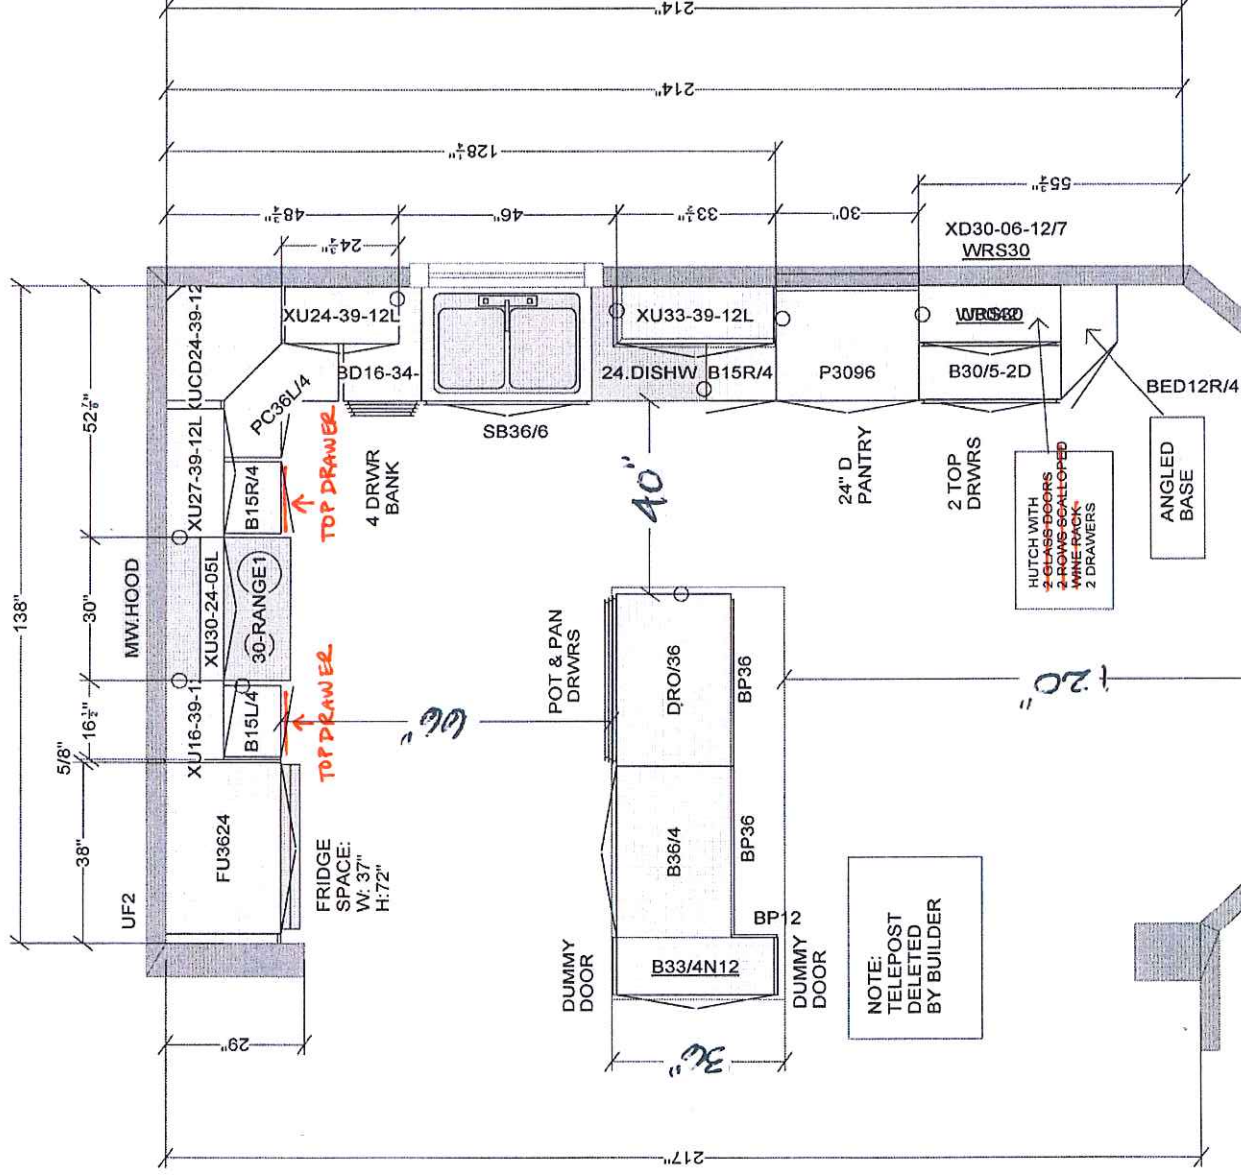

NOTE:
TELEPOST
DELETED
BY BUILDER

All dimensions size designations given are subject to verification on job site and adjustment to fit job conditions.



This is an original design and must not be released or copied unless applicable fee has been paid or job order placed.

CARTIER KITCHENS OTTAWA

DRAWN BY: LD
CARTIER KITCHENS OTTAWA

DCR - #59 SR2 - Kitchen - OPT 3 - sink at window_flush island cab

All

Drawing #:	1	No Sca
------------	---	--------

CUSTOMER APPROVAL

I have reviewed these drawings and understand the details of the layout and the Carrier Kitchens specifications.

Signature: _____

Date: May 31/13

CUSTOMER APPROVAL

I have reviewed these drawings and undersigned the details of the layout and the Carrier Kitchens specifications.

Signature: *[Signature]*

Date: *May 31/13*


Note: This drawing is an artistic interpretation of the general appearance of the design. It is not meant to be an exact rendition.

DESIGNED BY: LORI DISAVERIO.



Designed: 7/22/2012
Printed: 11/6/2012

Box #1 - Rev. Nov. 6/12

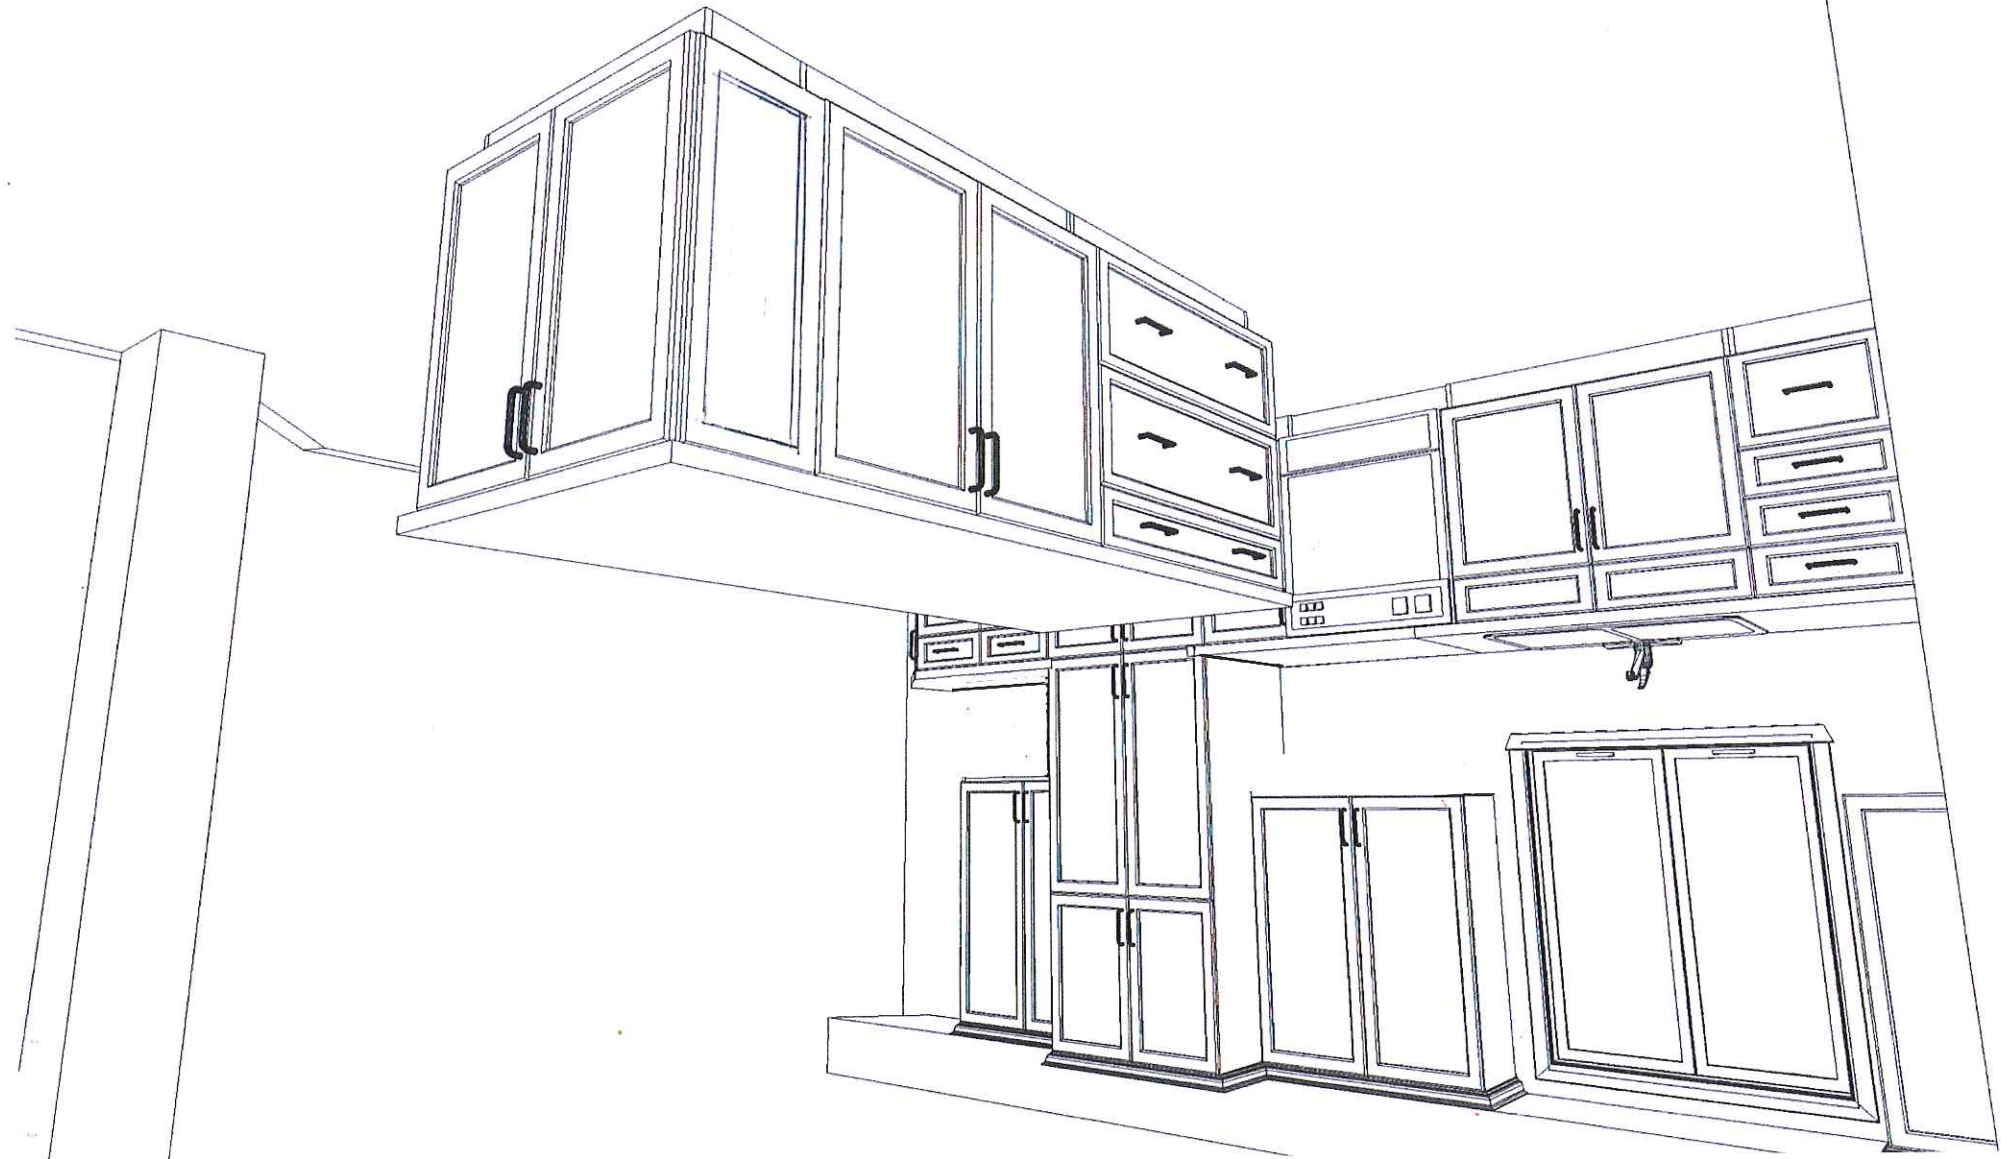


Date: May 31/13
 Signature: [Signature]
 I have reviewed these drawings and unders; and the details of the layout and the Carlier Kitchens specifications.
CUSTOMER APPROVAL

DESIGNED BY: LORI DISAVERIO.
 Note: This drawing is an artistic interpretation of the general appearance of the design. It is not meant to be an exact rendition.



Designed: 7/22/2012
 Printed: 11/6/2012

3D View #2 - Rev. Nov. 6/12

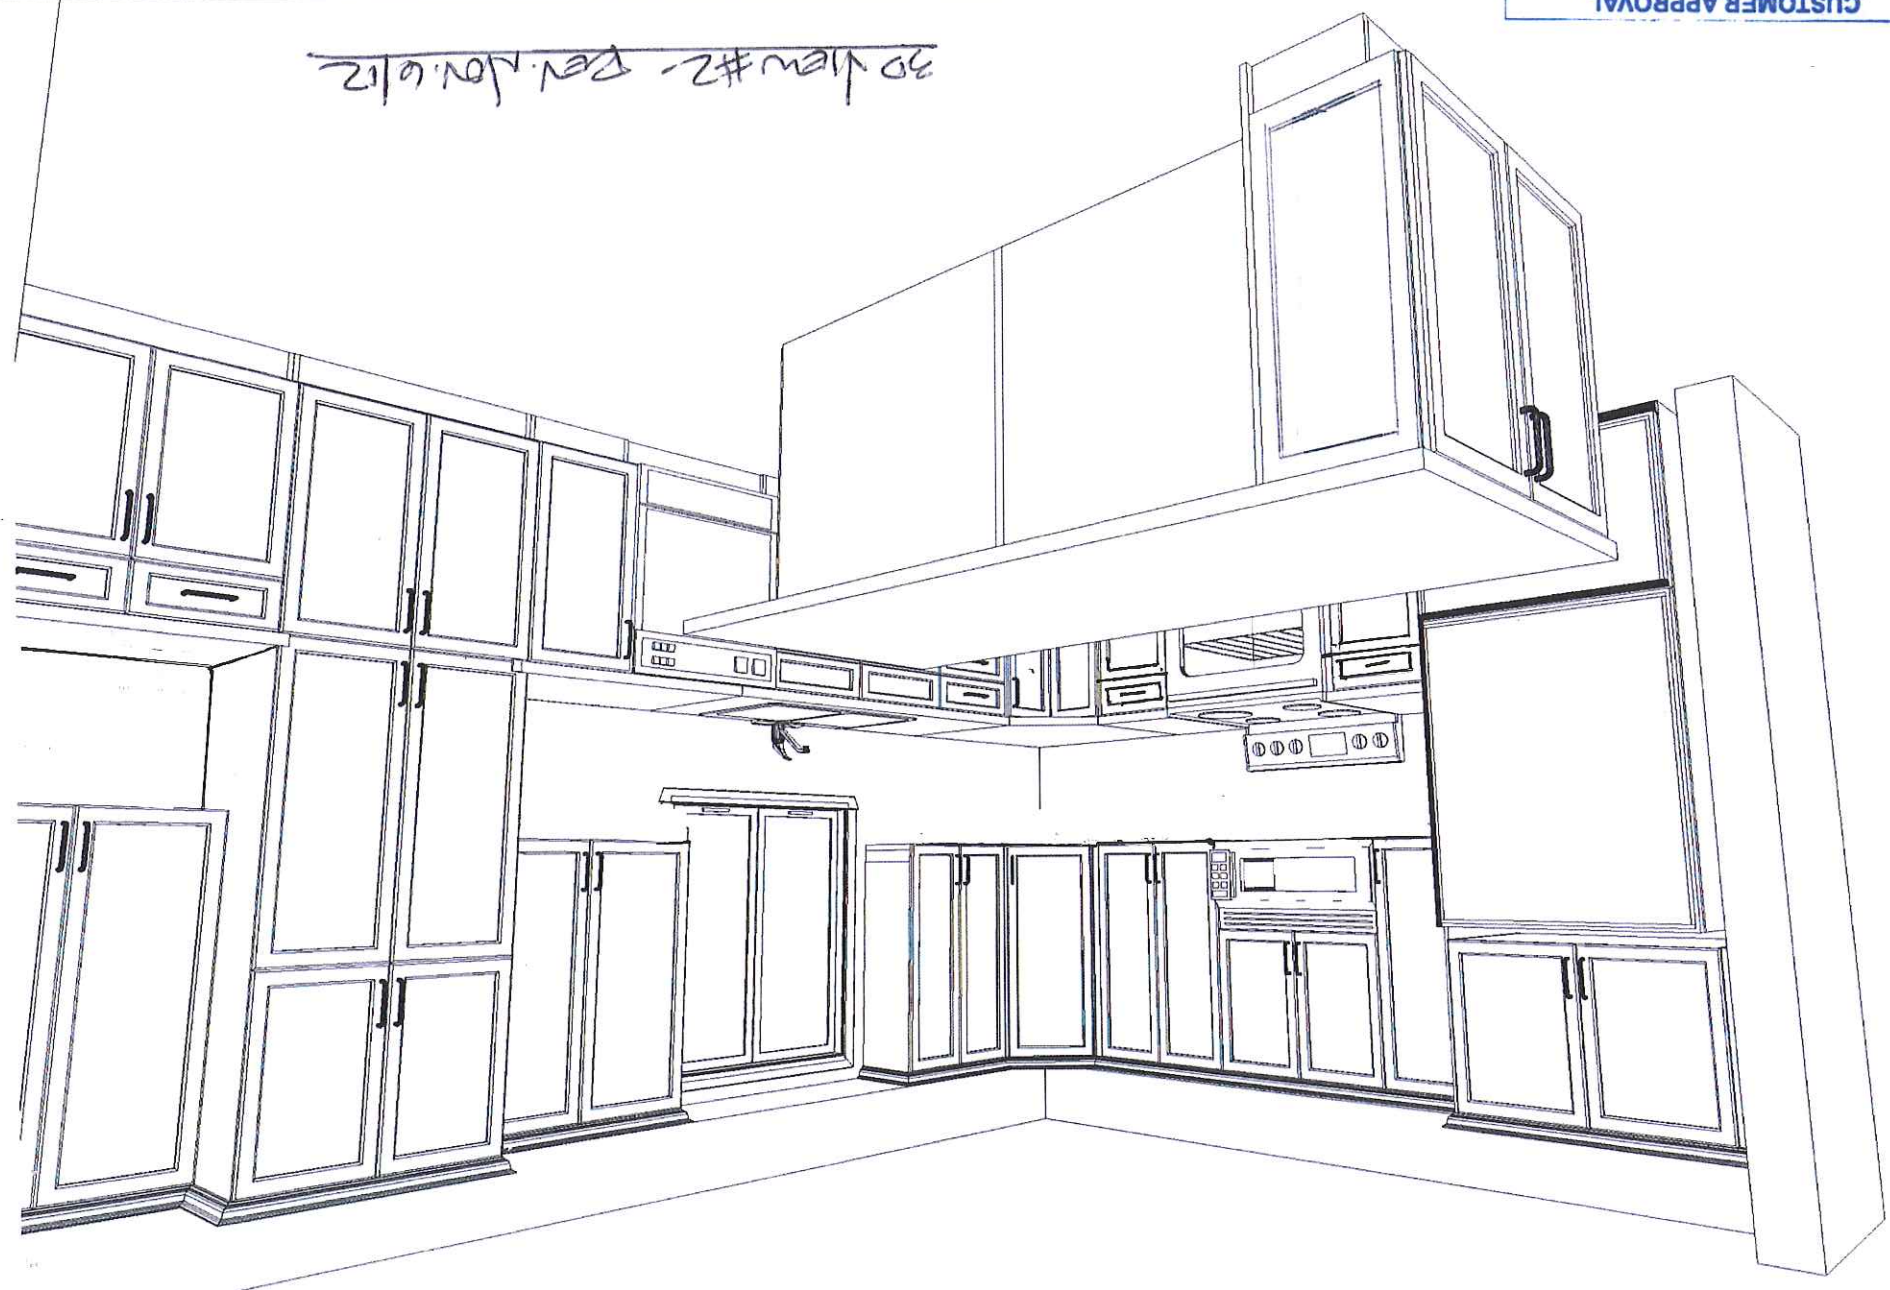

CUSTOMER APPROVAL

I have reviewed these drawings and understand the details of the layout and the Carrier Kitchens specifications.

Signature: *[Signature]*

Date: *May 31/13*

DESIGNED BY: LORI DISAVERRIO.

Note: This drawing is an artistic interpretation of the general appearance of the design. It is not meant to be an exact rendition.

2020
TECHNOLOGIES

Carrier
KITCHENS

Designed: 7/22/2012
Printed: 11/6/2012

30 View #3 - Bel. Nov 12

