


NOTE: PROVIDE SECURITY SYSTEMS
ROUGH-IN SEE SUMMARY

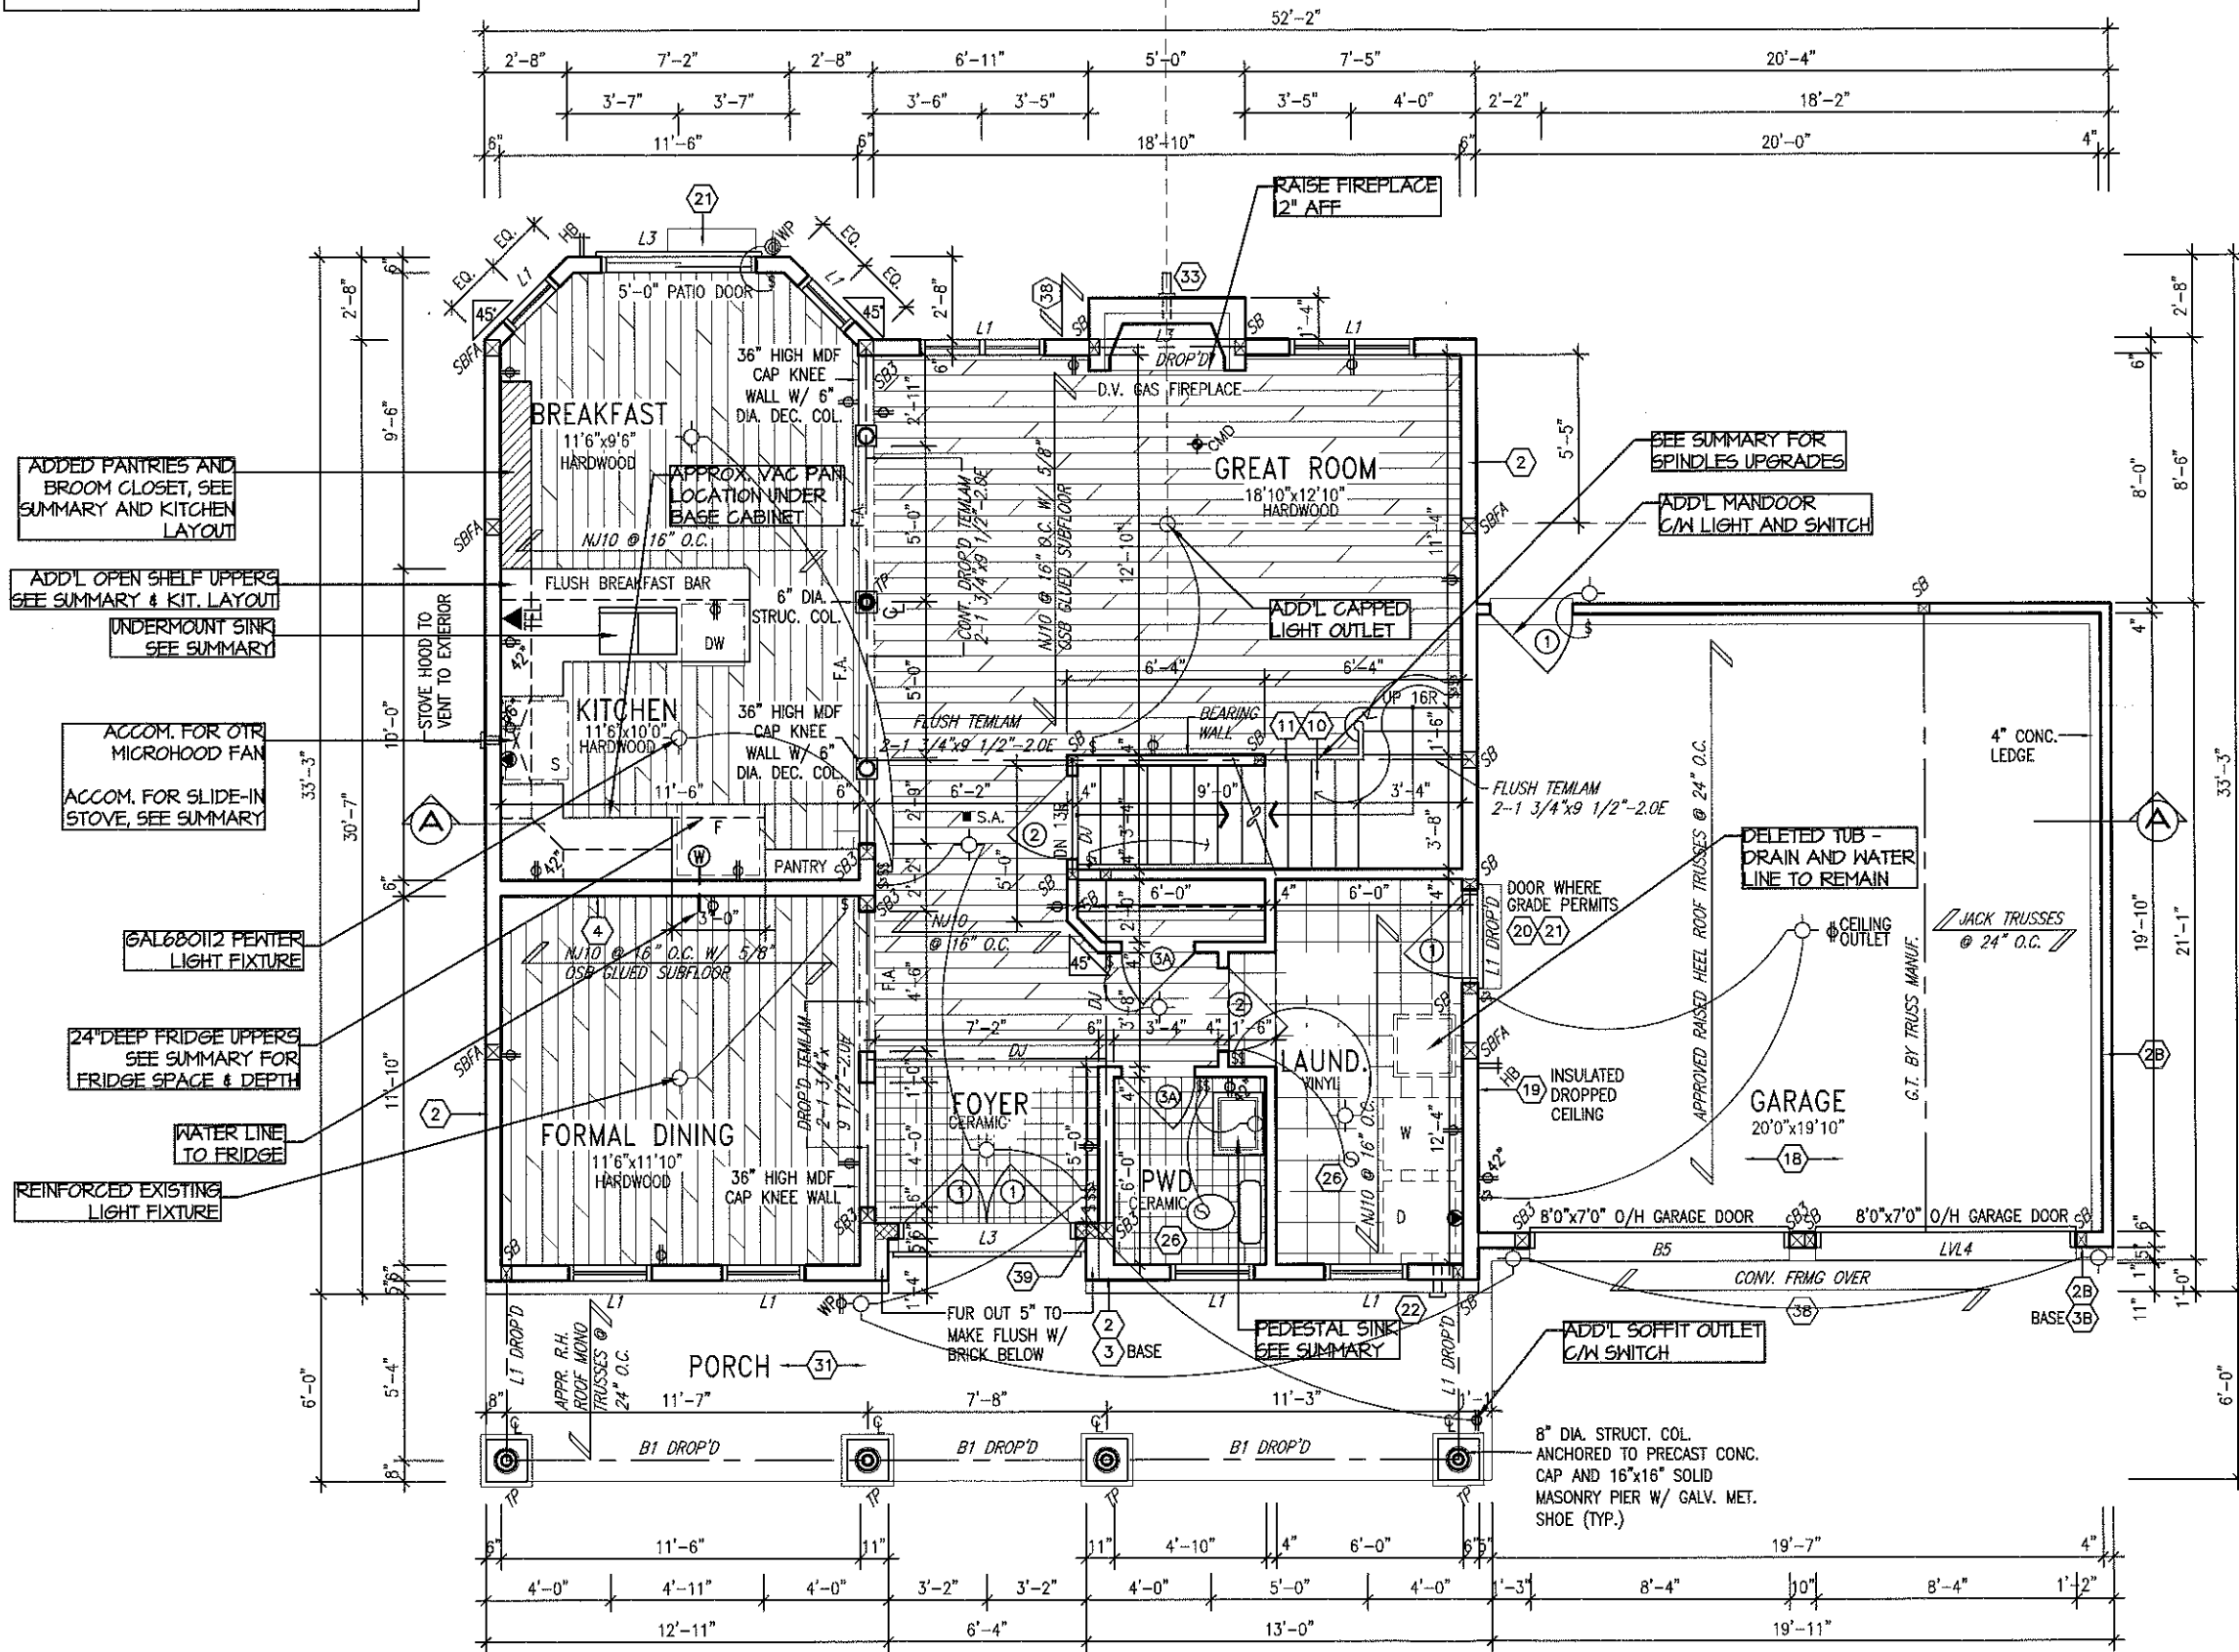

GROUND FLOOR PLAN 'A'

NOTE:
ALL LVL'S SUPPORTING FLOOR
LOADS ARE TO BE SPECIFIED BY
THE FLOOR TRUSS MANUFACTURER.

NOTE:
FLOOR FRAMING INFO REFER TO KOTT SHOP
DRAWINGS FOR ALL TRUSS-JOIST INFORMATION
AND DETAILS, UNLESS OTHERWISE NOTED.

NOTE:
ALL SBs ARE SB2 U/ NOTED

SI-A
Sht. title: GROUND FLOOR-A
CL
OF
checked by: FEB. 2007
date: 3/16 "1"
scale: sheet no.
2A
6

REV.	AS PER CONST. SUMMARY	SD	By
3	REV. AS PER CONST. SUMMARY	JUL26-13	SD
2	REV. AS PER CONST. SUMMARY	JUL24-12	SD
1	ISSUED FOR FOUNDATION ONLY	JUN22-12	SD
No. Description			
REVISIONS			

GREGORIAN-2007-A
SITE: SHADOW RIDGE2
LOT NUMBER: 62
CIVIC ADDRESS: 6531 WATERDOWN ST


Viljoen Architect Inc.
300 A Wilson Avenue
North York, Ontario
M3H 1S8
TEL: (416) 630-2255
FAX: (416) 630-4782

PHOENIX HOMES

NOTE:
ALL SBs ARE SB2 U/ NOTED

NOTE:
ROOF TRUSS INFORMATION REFER TO ROOF
TRUSS SHOP DRAWINGS FOR ALL ROOF FRAMING
INFORMATION UNLESS OTHERWISE NOTED.

NOTE: ROOF FRAMING INFORMATION
ALL LAMINATED VENEER LUMBER (LVL) BEAMS, BUILT-UP BEAMS,
GIRDER TRUSSES AND METAL HANGER CONNECTIONS SUPPORTING
ROOF FRAMING TO BE DESIGNED AND CERTIFIED BY ROOF TRUSS
MANUFACTURER. REFER TO ROOF TRUSS SHOP DRAWINGS FOR
ALL ROOF FRAMING INFORMATION UNLESS OTHERWISE NOTED ON
ARCHITECTURAL DRAWINGS.

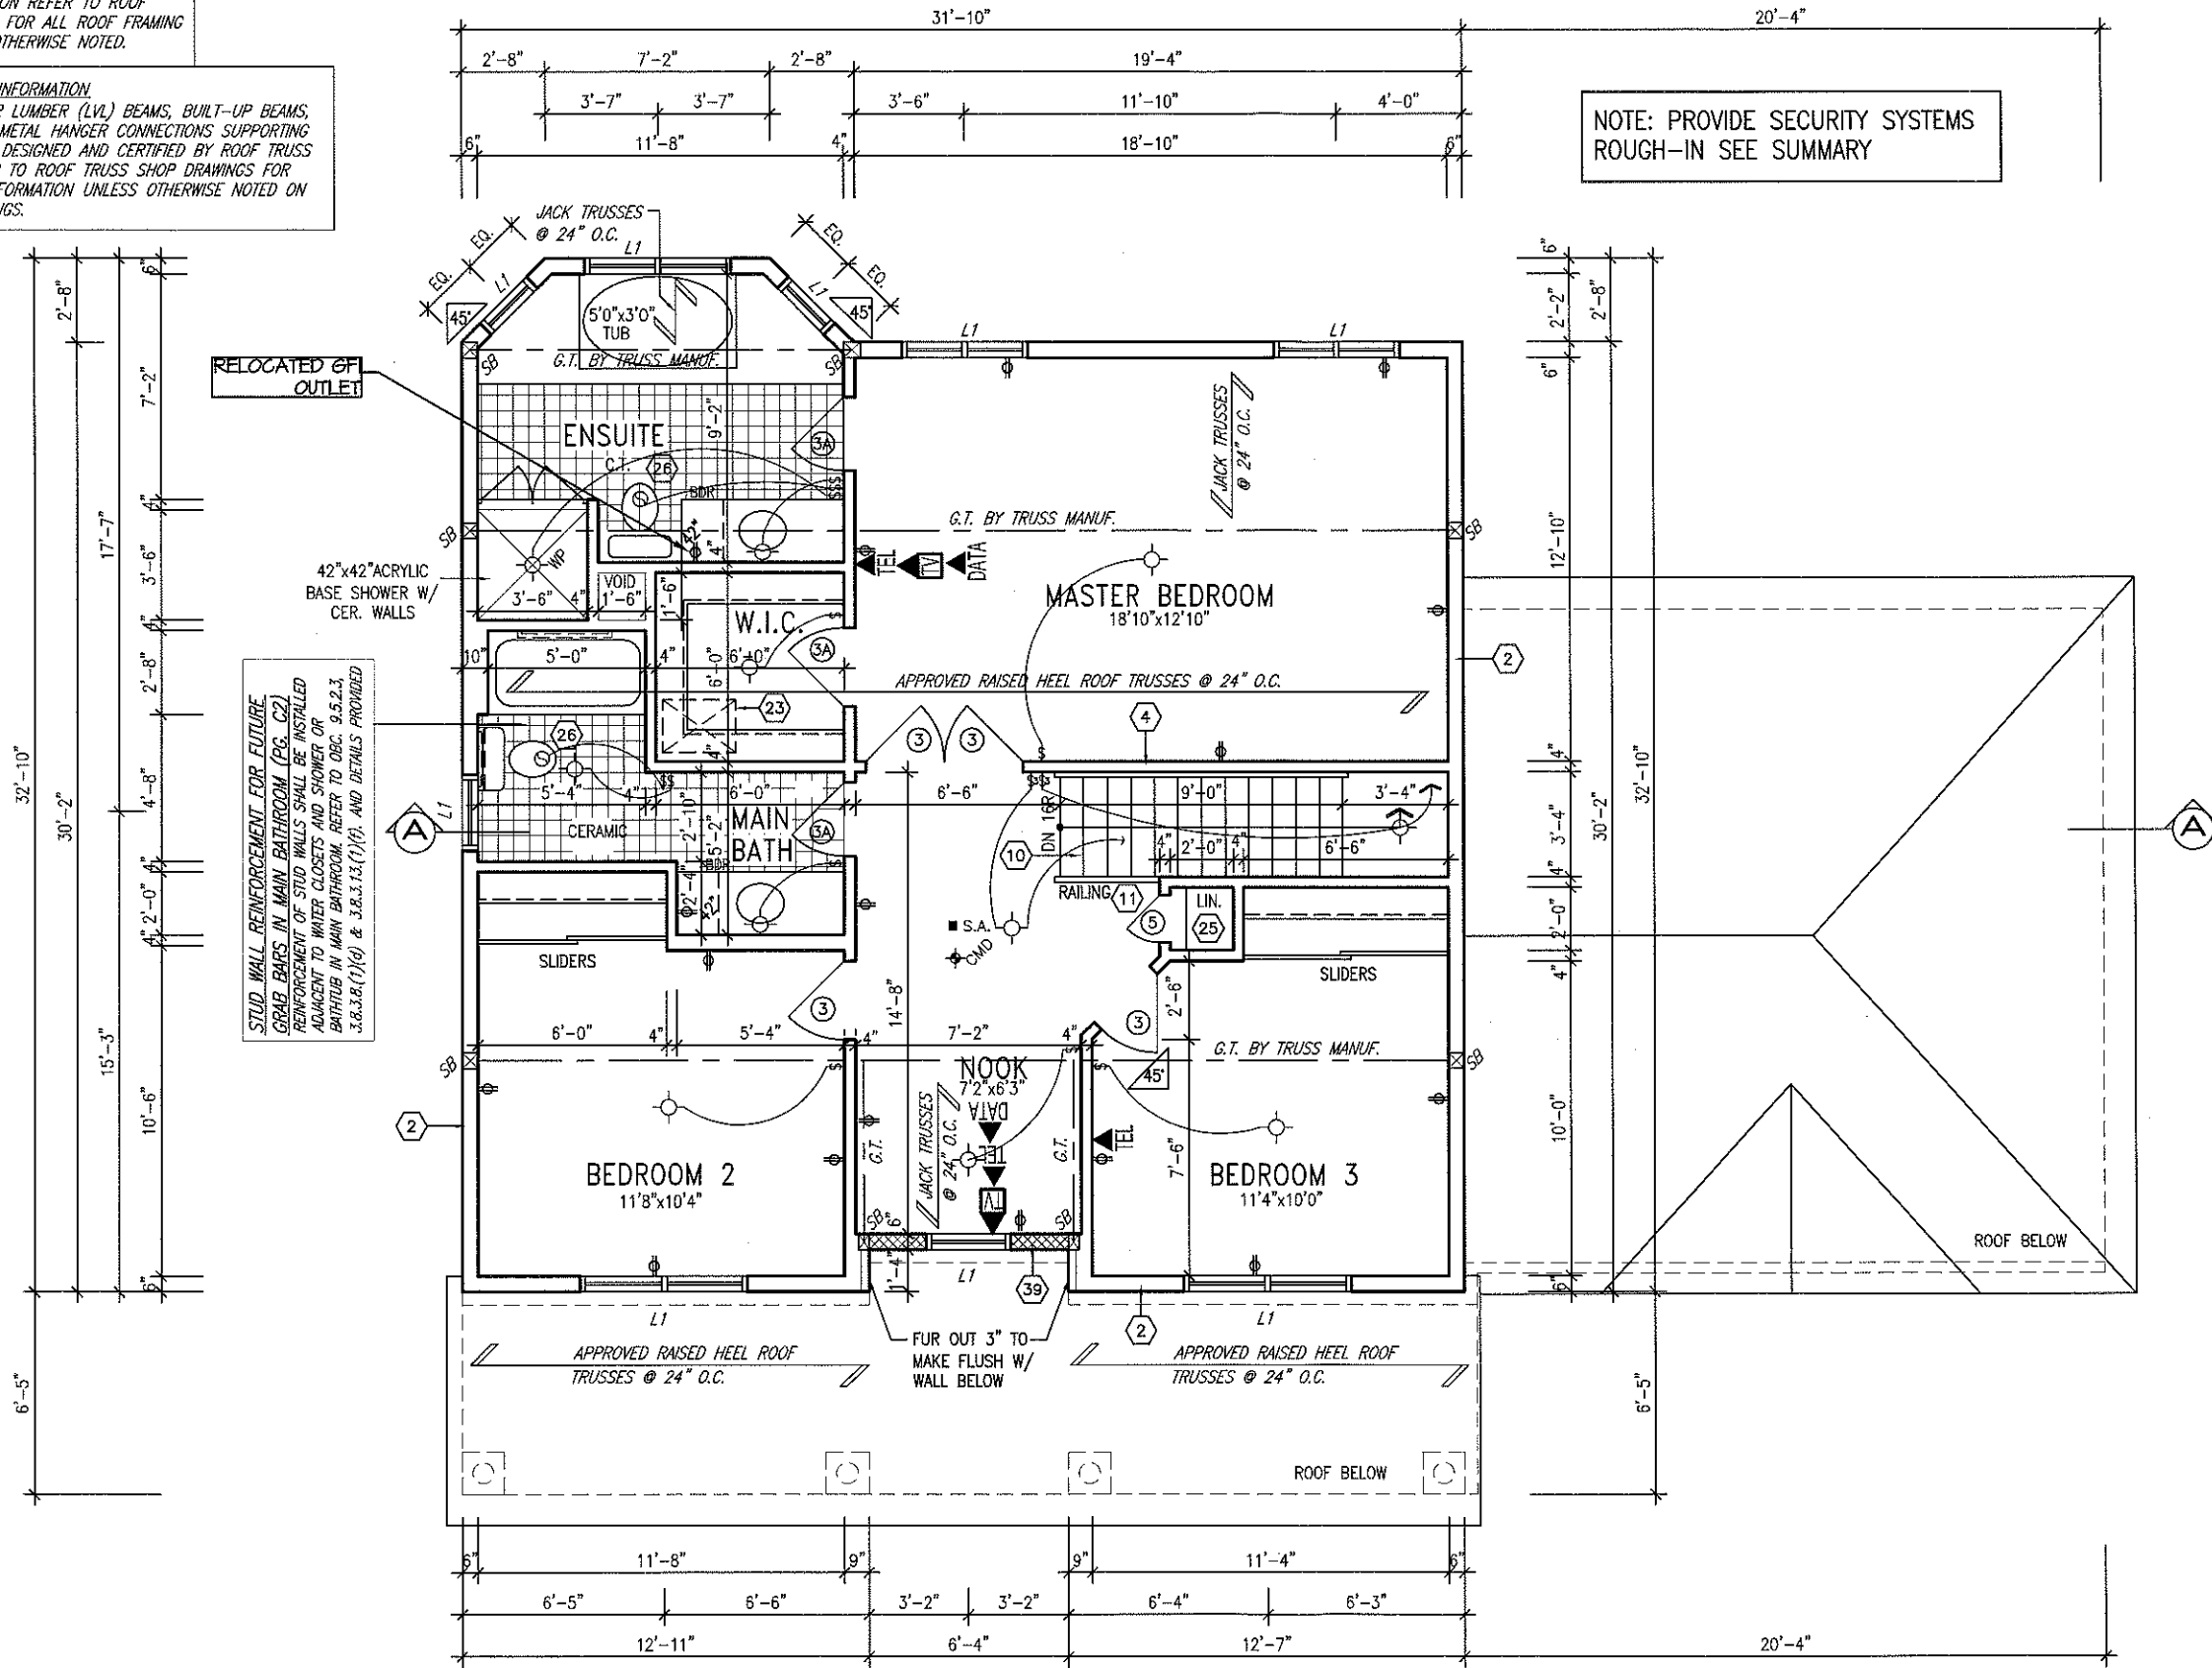

SECOND FLOOR PLAN 'A'

Footprint: SI-A

Sheet title: SECOND FLOOR-A

Drawn by: CL

Checked by: OF

Date: FEB. 2007

Scale: 3/16"=1'

Sheet no: 3A/6

3	REV. AS PER CONST. SUMMARY	JUL26-13	SD
2	REV. AS PER CONST. SUMMARY	JUL24-12	SD
1	ISSUED FOR FOUNDATION ONLY	JUNE22-12	SD

No. Description Date By

REVISIONS

GREGORIAN-2007-A

SITE: SHADOW RIDGE2


LOT NUMBER: 62

CIVIC ADDRESS: 6531 WATERDOWN ST

Viljoen Architect Inc.


300 A Wilson Avenue
North York, Ontario
M3H 1S8
TEL: (416) 630-2255
FAX: (416) 630-4782

PHOENIX HOMES

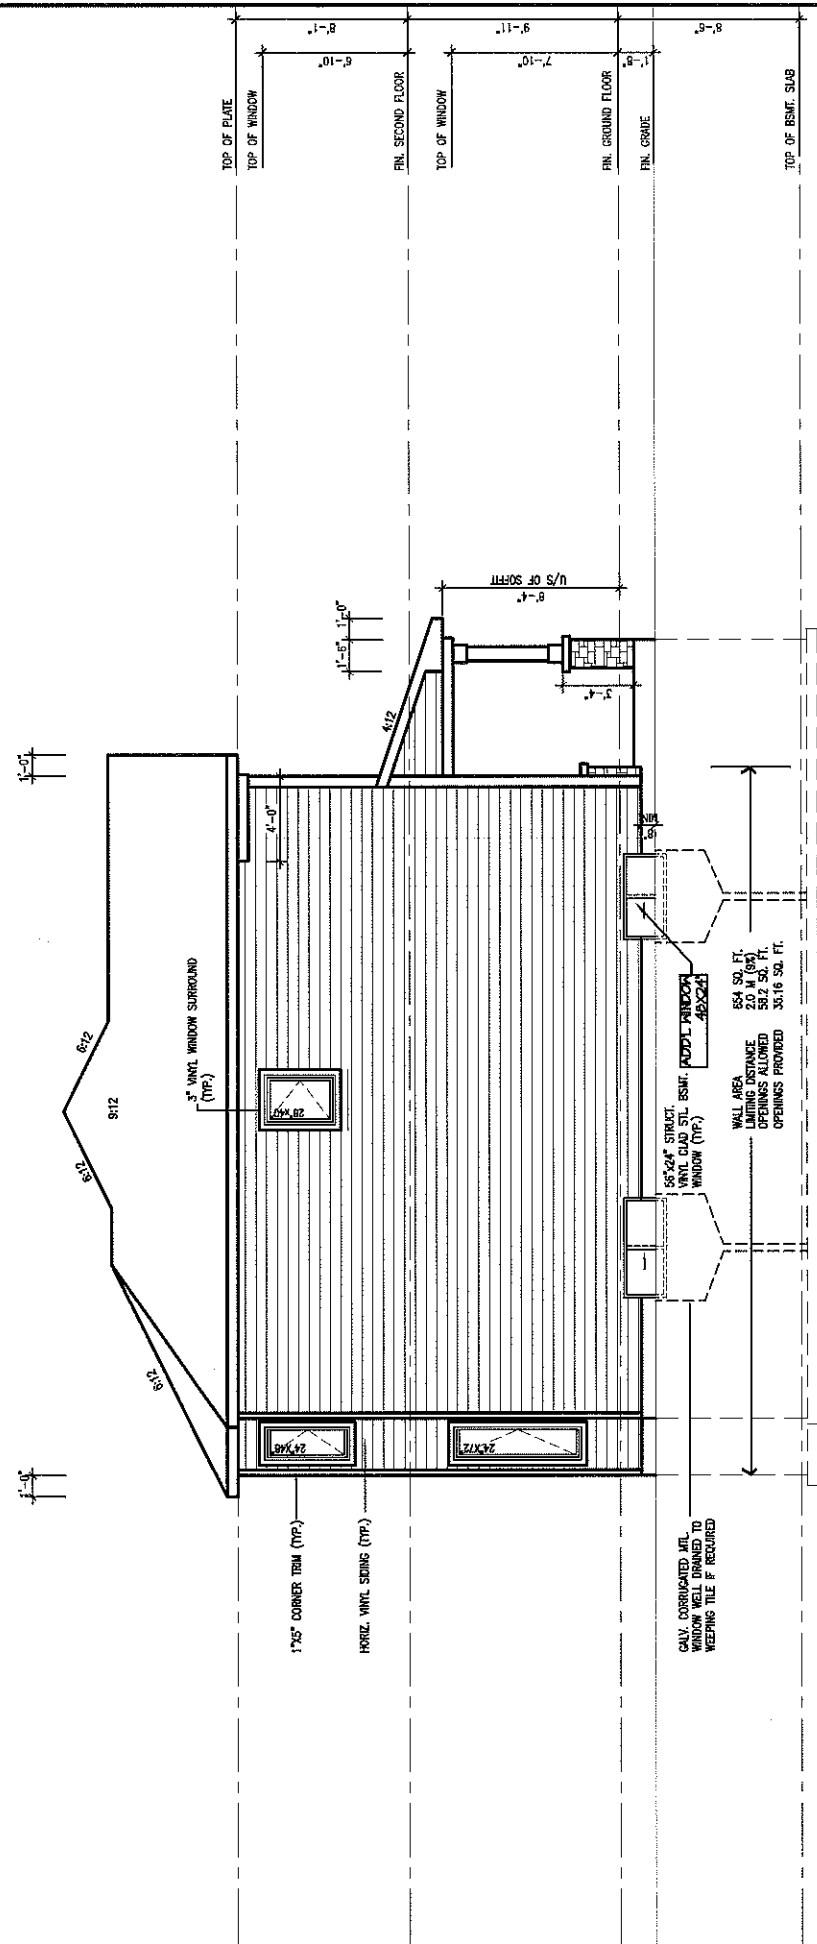


LEFT ELEVATION 'A'


NOTE:
REFER TO FRONT ELEVATION FOR TYPICAL
NOTES & INFORMATION

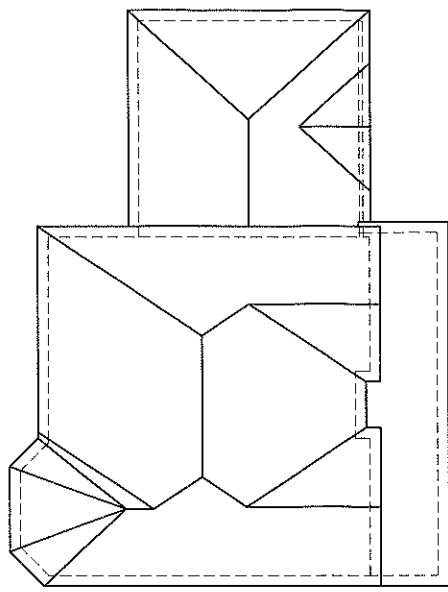

ROOF PLAN 'A'
N.T.S.

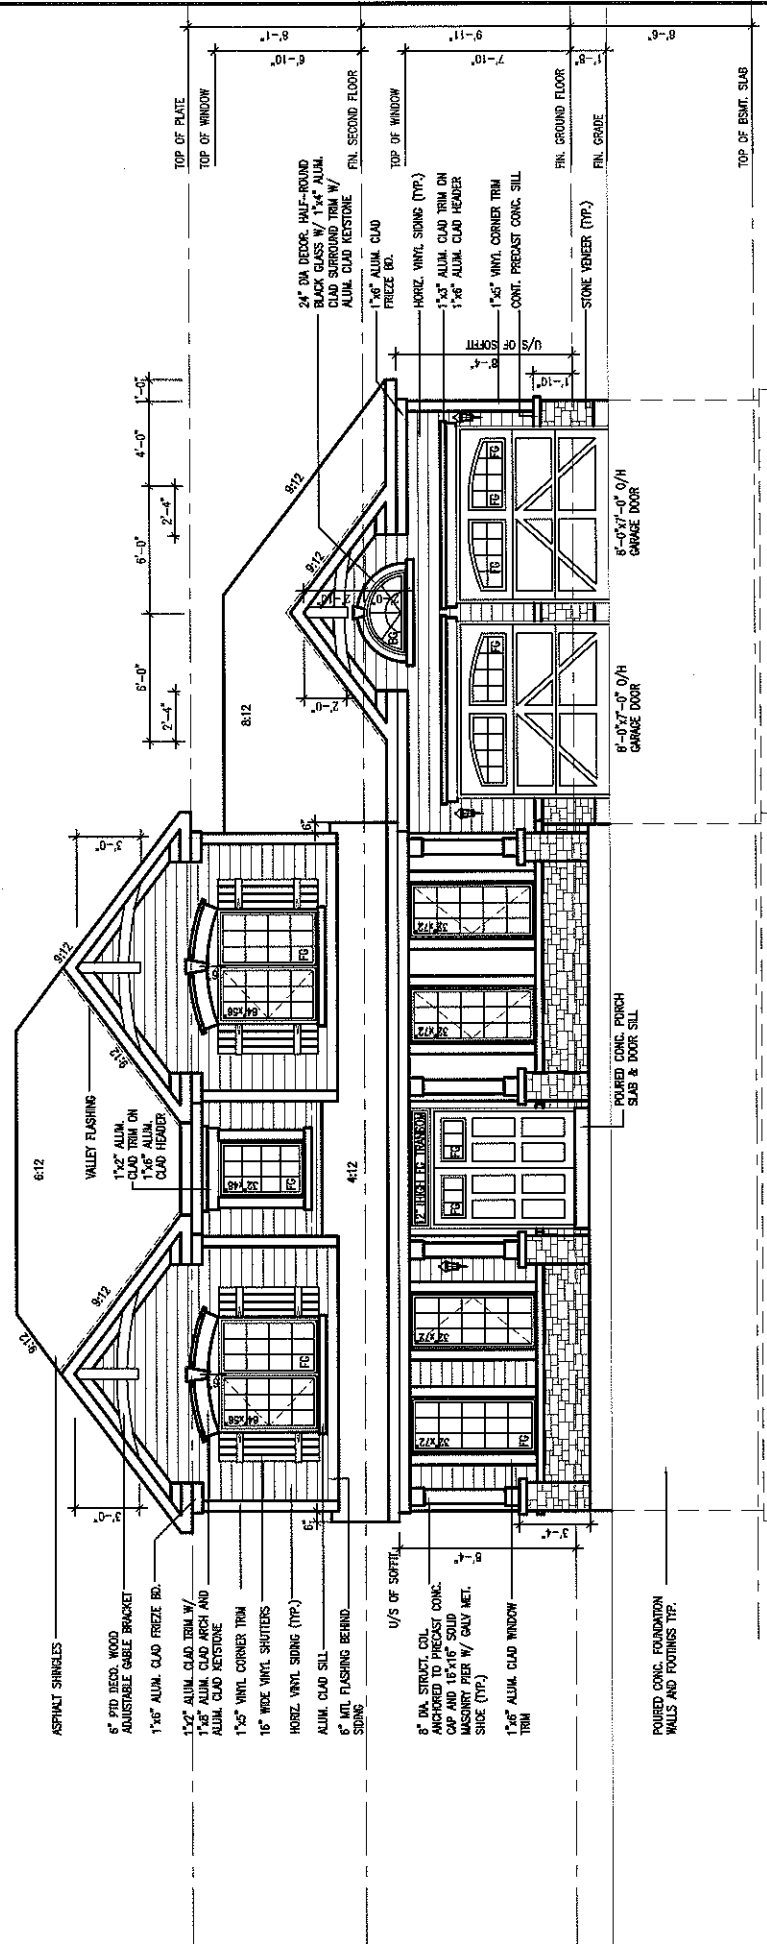

FRONT ELEVATION 'A' (SIDING W/ STONE BASE)

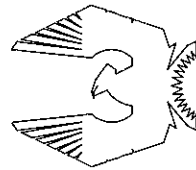

PHOENIX HOMES

**Viljoen
Architect
Inc.**

300 A. Wilson Avenue
North York, Ontario
M3H 1S8
TEL: (416) 630-2255
FAX: (416) 630-4782

GREGORIAN-2007-A


SITE: SHADOW RIDGE2

LOT NUMBER:

62


CIVIC ADDRESS:
6531 WATERDOWN ST

Footprint:	S1-A
Sheet title:	ELEVATIONS-A
Drawn by:	CL
Checked by:	OF
Date:	FEB. 2007
Scale:	1/8"=1'
Sheet no:	4A
By	SD
Date	JUL26-13
Description	3 REV. AS PER CONST. SUMMARY
Revisions	2 REV. AS PER CONST. SUMMARY
	1 ISSUED FOR FOUNDATION ONLY

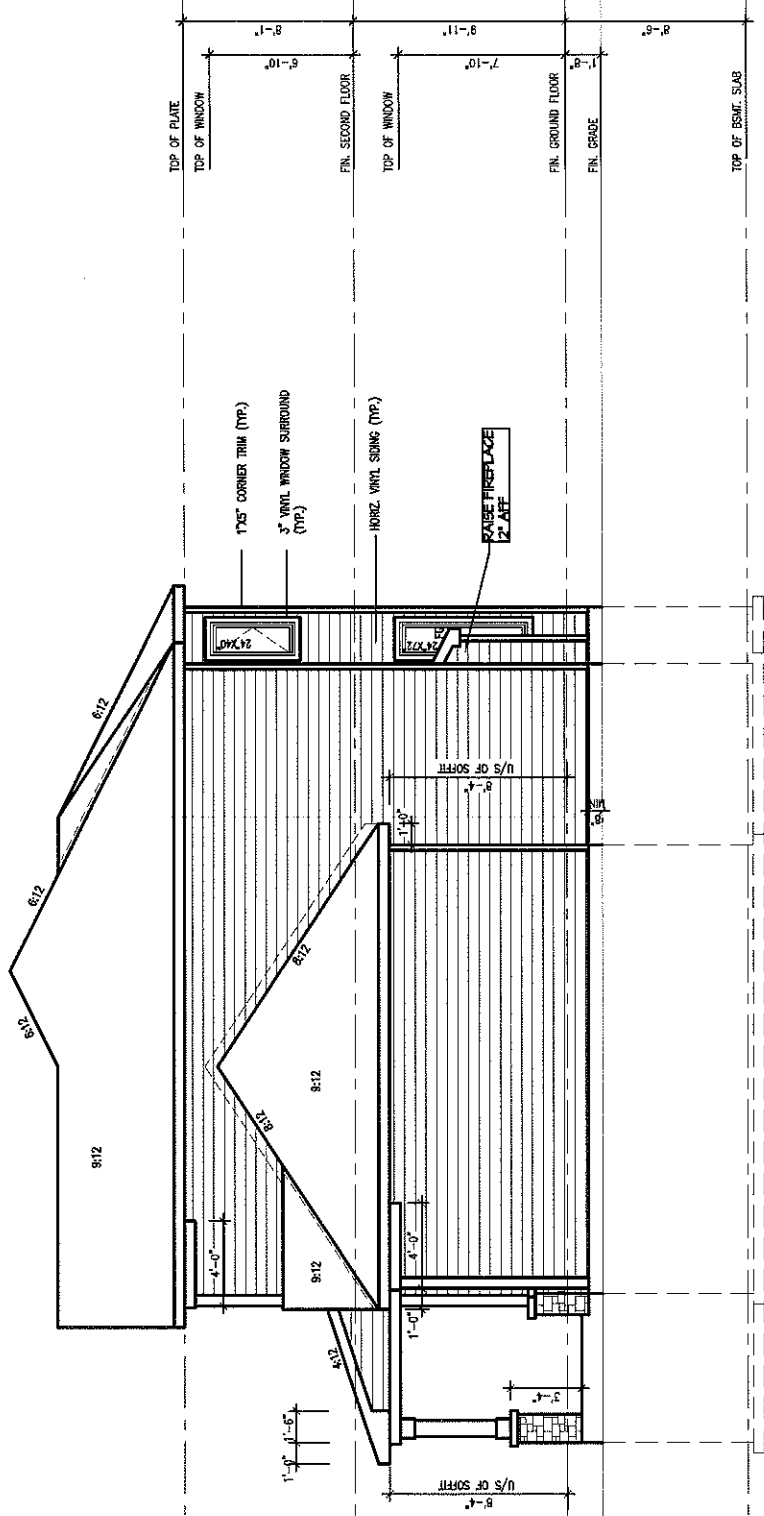


RIGHT ELEVATION 'A'

NOTE:
REFER TO FRONT ELEVATION FOR TYPICAL
NOTES & INFORMATION

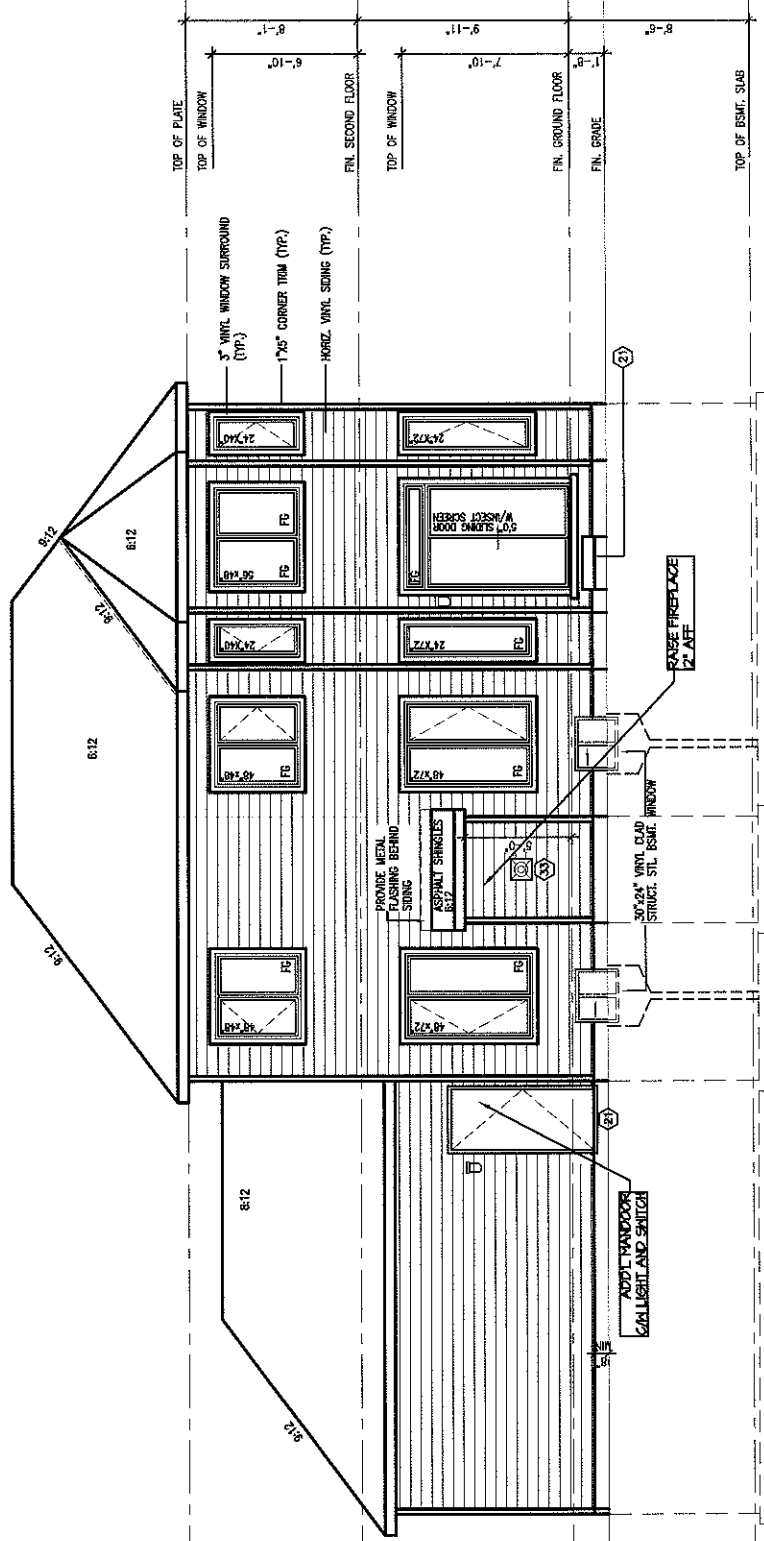

REAR ELEVATION 'A'

NOTE:
REFER TO FRONT ELEVATION FOR TYPICAL
NOTES & INFORMATION

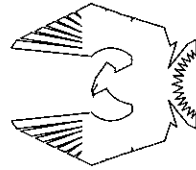

PHOENIX HOMES

**Viljoen
Architect
Inc.**

300 A. Wilson Avenue
North York, Ontario
M3H 1S8
TEL: (416) 630-2255
FAX: (416) 630-4782

GREGORIAN-2007-A

SITE: **SHADOW RIDGE2**

LOT NUMBER:

62

CIVIC ADDRESS:
6531 WATERDOWN ST

Footprint: **51-A**

SH. TITLE: ELEVATIONS-A

drawn by: CL

checked by: OF


date: FEB. 2007

scale: 1/8"=1'


sheet no:

5A
6

No.	Description	Date	By
3	REV. AS PER CONST. SUMMARY	JUL26-13	SD
2	REV. AS PER CONST. SUMMARY	JUL24-12	SD
1	ISSUED FOR FOUNDATION ONLY	JUNE22-12	SD

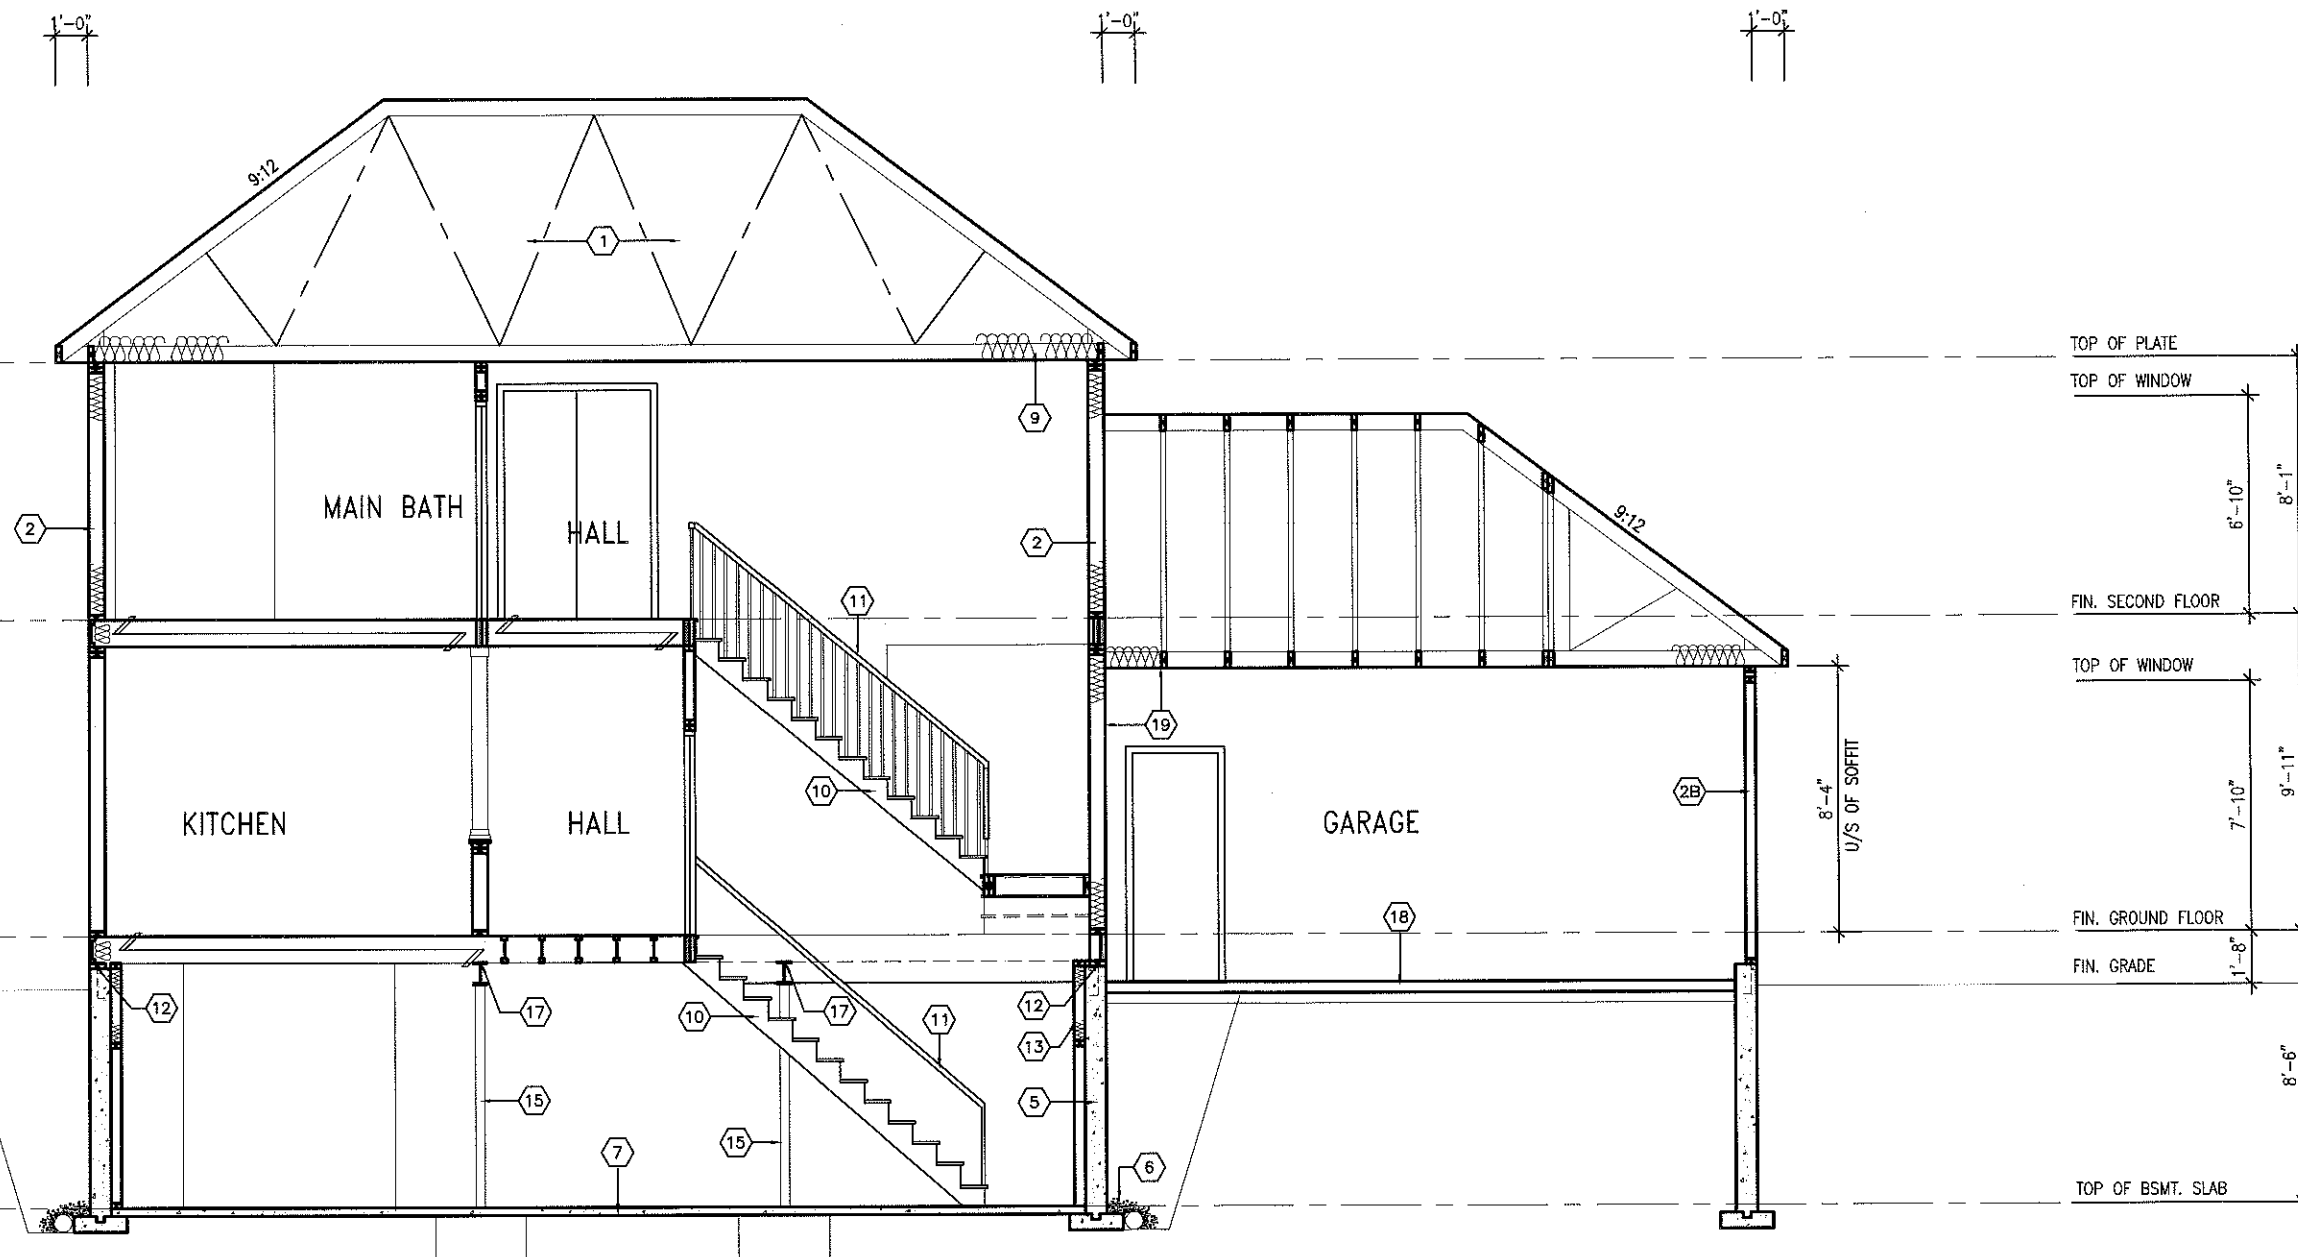

SECTION A-A

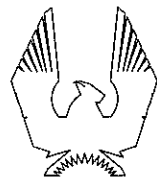

PHOENIX HOMES

**Viljoen
Architect
Inc.**

300 A. Wilson Avenue
North York, Ontario
M3H 1S8
TEL: (416) 630-2255
FAX: (416) 630-4782

GREGORIAN-2007-A

SITE: SHADOW RIDGE2

LOT NUMBER:

62

CIVIC ADDRESS:
6531 WATERDOWN ST

No.	Description	Date	By
3	REV. AS PER CONST. SUMMARY	JUL26-13	SD
2	REV. AS PER CONST. SUMMARY	JUL24-12	SD
1	ISSUED FOR FOUNDATION ONLY	JUNE22-12	SD
REVISIONS			

Footprint:	SI-A
sh. title:	SECTION
drawn by:	CL
checked by:	OF
date:	FEB. 2007
scale:	3/16"=1'
sheet no:	6