


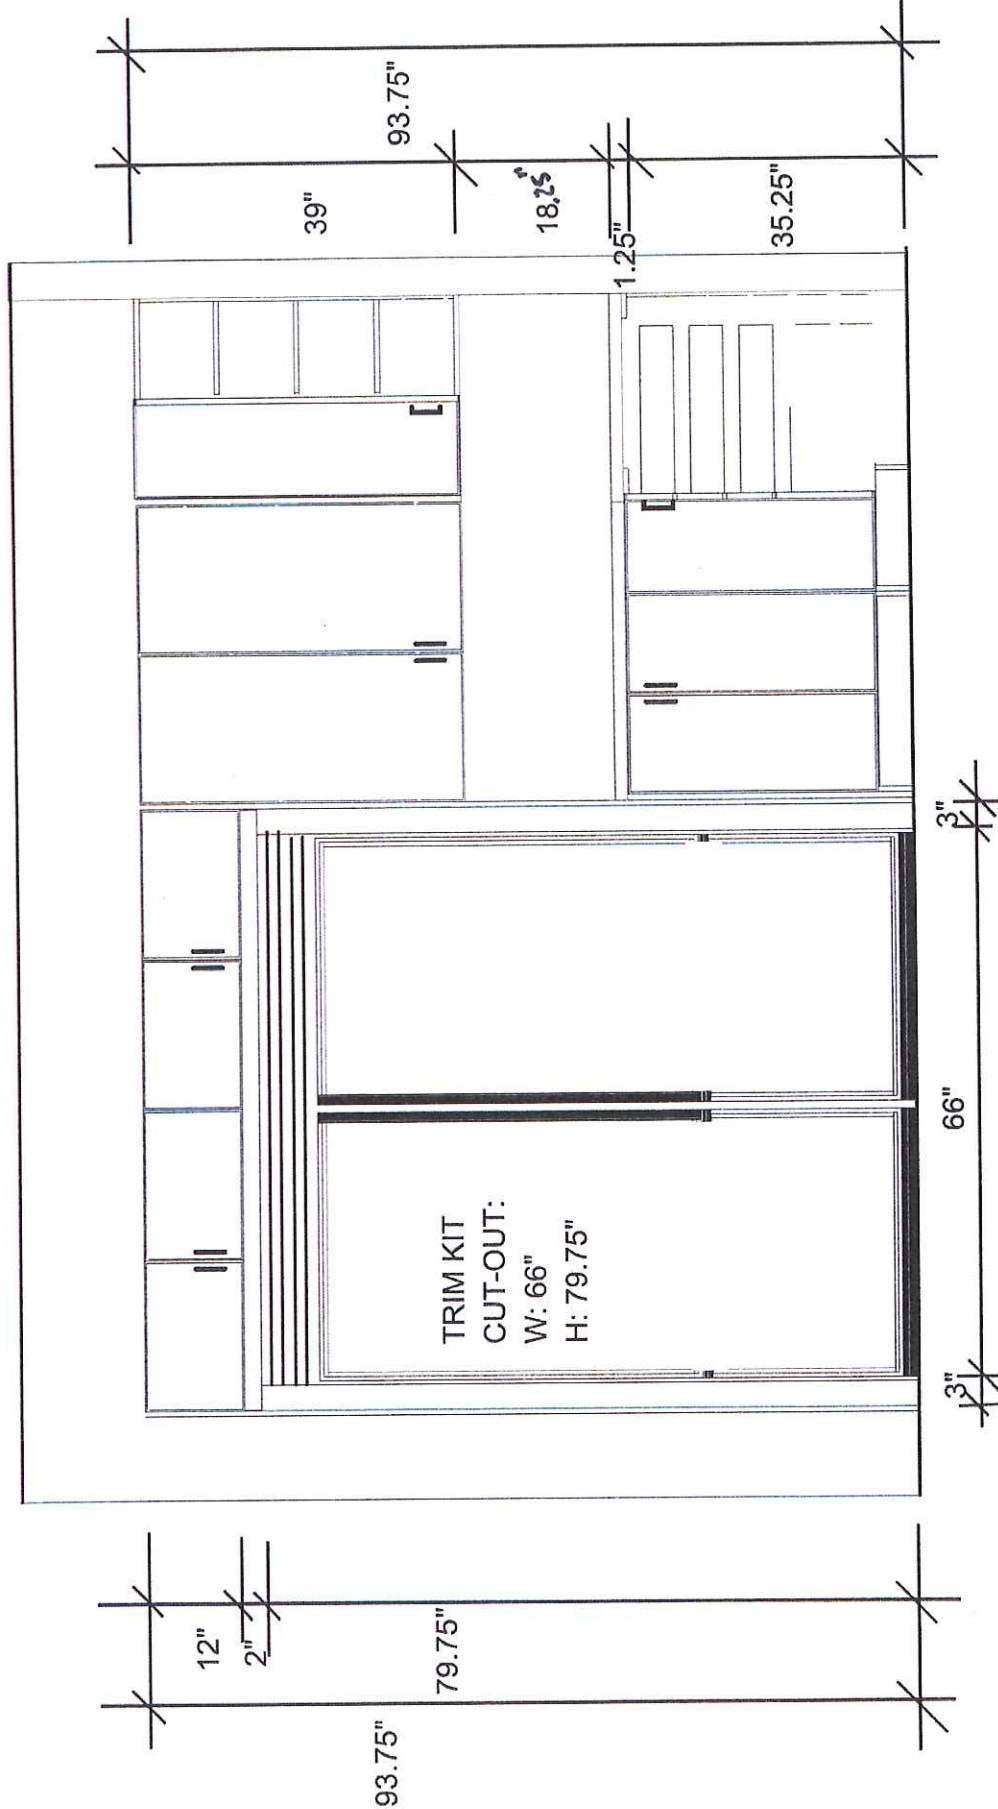

FRIDGE WALL ELEVATION

CUSTOMER APPROVAL

I have reviewed these drawings and understand the details of the layout and the Carlier Kitchens specifications.

Signature

Date

[Signature]
Sep. 3/13




Note: This drawing is an artistic interpretation of the general appearance of the design. It is not meant to be an exact rendition.

DRAWN BY: LORI DISAVERIO, B.I.D
DCR #63 SR2 - Kitchen 2 - sink opt 2

Designed: 7/8/2012
Printed: 7/3/2013

All

Drawing #: 1

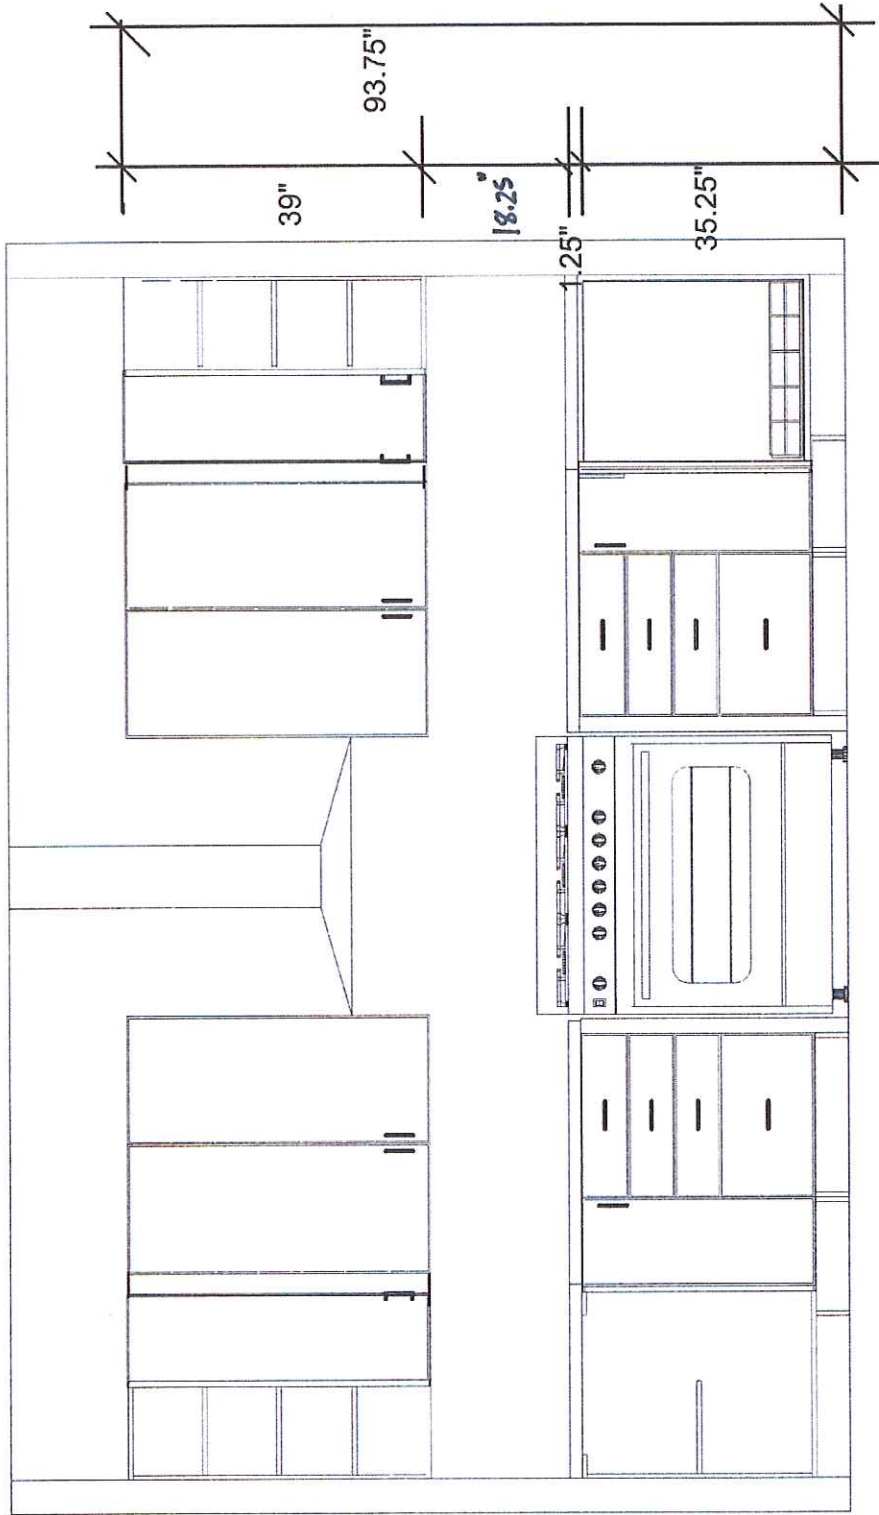

STOVE WALL ELEVATION

CUSTOMER APPROVAL

I have reviewed these drawings and understand the details of the layout and the Capler Kitchens specifications.

Signature _____


Date _____

[Signature]
Sep. 3/13

Note: This drawing is an artistic interpretation of the general appearance of the design. It is not meant to be an exact rendition.

DRAWN BY: LORI DISAVERIO, B.I.D

DCR #63 SR2 - Kitchen 2 - sink opt 2

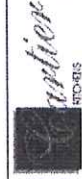


2020
TECHNOLOGIES

Designed: 7/8/2012
Printed: 7/13/2013

All

Drawing #: 1

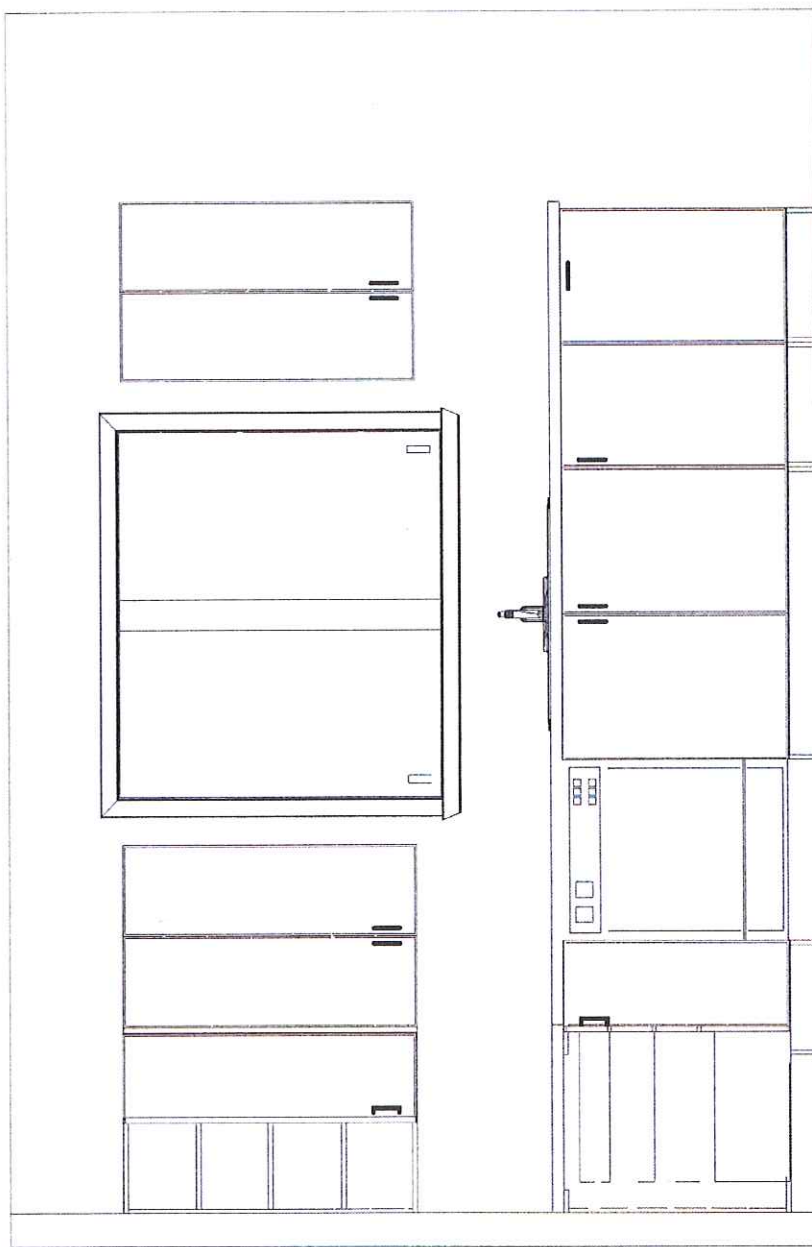

SINK WALL ELEVATION

CUSTOMER APPROVAL

I have reviewed these drawings and understand the details of the layout and the Carlier Kitchens specifications.

Signature _____

Date _____

[Signature]
Sep. 3/13

Note: This drawing is an artistic interpretation of the general appearance of the design. It is not meant to be an exact rendition.

DRAWN BY: LORI DISAVERIO, B.I.D
DCR #63 SR2 - Kitchen 2 - sink opt 2



Designed: 7/8/2012
Printed: 7/3/2013

All

Drawing #: 1