

DCR PHOENIX HOMES

SHADOW RIDGE 2

LOT #64

S1-GREGORAIN

VANITIES

REVISED : MAY 6-12

CUSTOMER APPROVAL


I have reviewed these drawings and understand the details of the layout and the Cartier Kitchens specifications.

Signature

[Signature]


Date

May 2/13

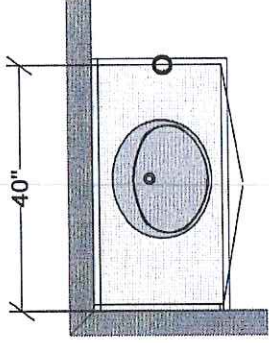


POWDER

VF1 XV39-34-21L/4

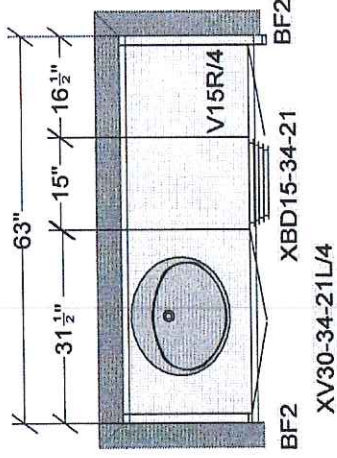

MAIN BATH

BF2 XBD15-34-21 BF2 XV30-34-21L/4

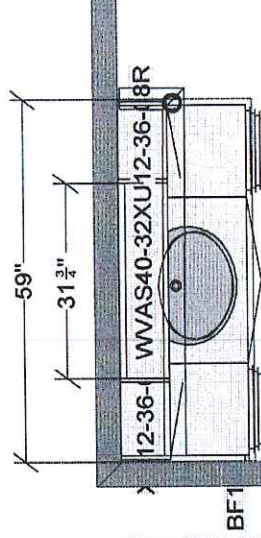

MASTER ENSUITE

UEP08-48-01
UEP08-48-01
UEP08-48-01

BF1 XBD15-34-21 XBD15-34-21 XB27-34-21L/4

REV - MAY 6/12.

All dimensions size designations given are subject to verification on job site and adjustment to fit job conditions.

CARTIER KITCHENS OTTAWA



This is an original design and must not be released or copied unless applicable fee has been paid or job order placed.

DRAWN BY: LD
CARTIER KITCHENS OTTAWA


Designed: 3/12/2012
Printed: 5/6/2012

DCR - #64 SR 2 - VANITIES

All

Drawing #: 1 No Scale.

Powder Room Vanity

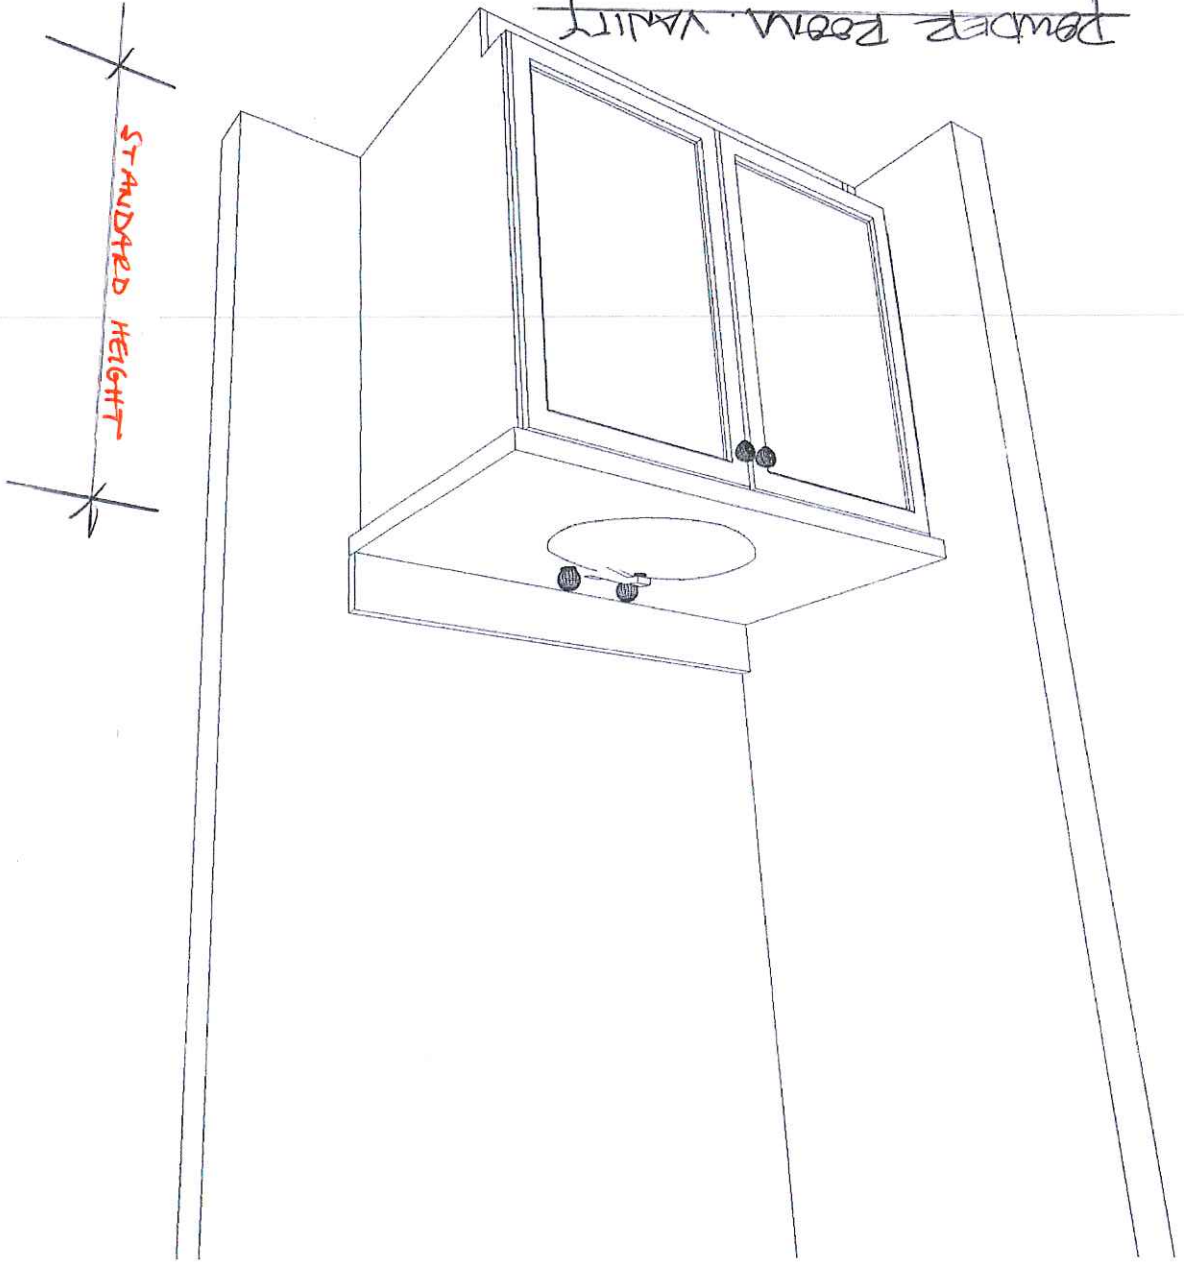

Note: This drawing is an artistic interpretation of the general appearance of the design. It is not meant to be an exact rendition.

DESIGNED BY: LORI DISAVRIO.
DCR - #64 SR 2 - VANITIES

2020
TECHNOLOGIES

Kitchen
KITCHENS

Designed: 3/12/2012
Printed: 3/12/2012
Drawing #: 1

CUSTOMER APPROVAL
I have reviewed these drawings and understand the details of the layout and the Carrier Kitchens specifications.
Signature: *[Signature]*
Date: *Mar. 2/13*

CUSTOMER APPROVAL


I have reviewed these drawings and undersand the details of the layout and the Carter Kitchens specifications.

Signature: *[Signature]*

Date: Mar. 2/13

MAID BATH VANITY

STANDARD
HEIGHT

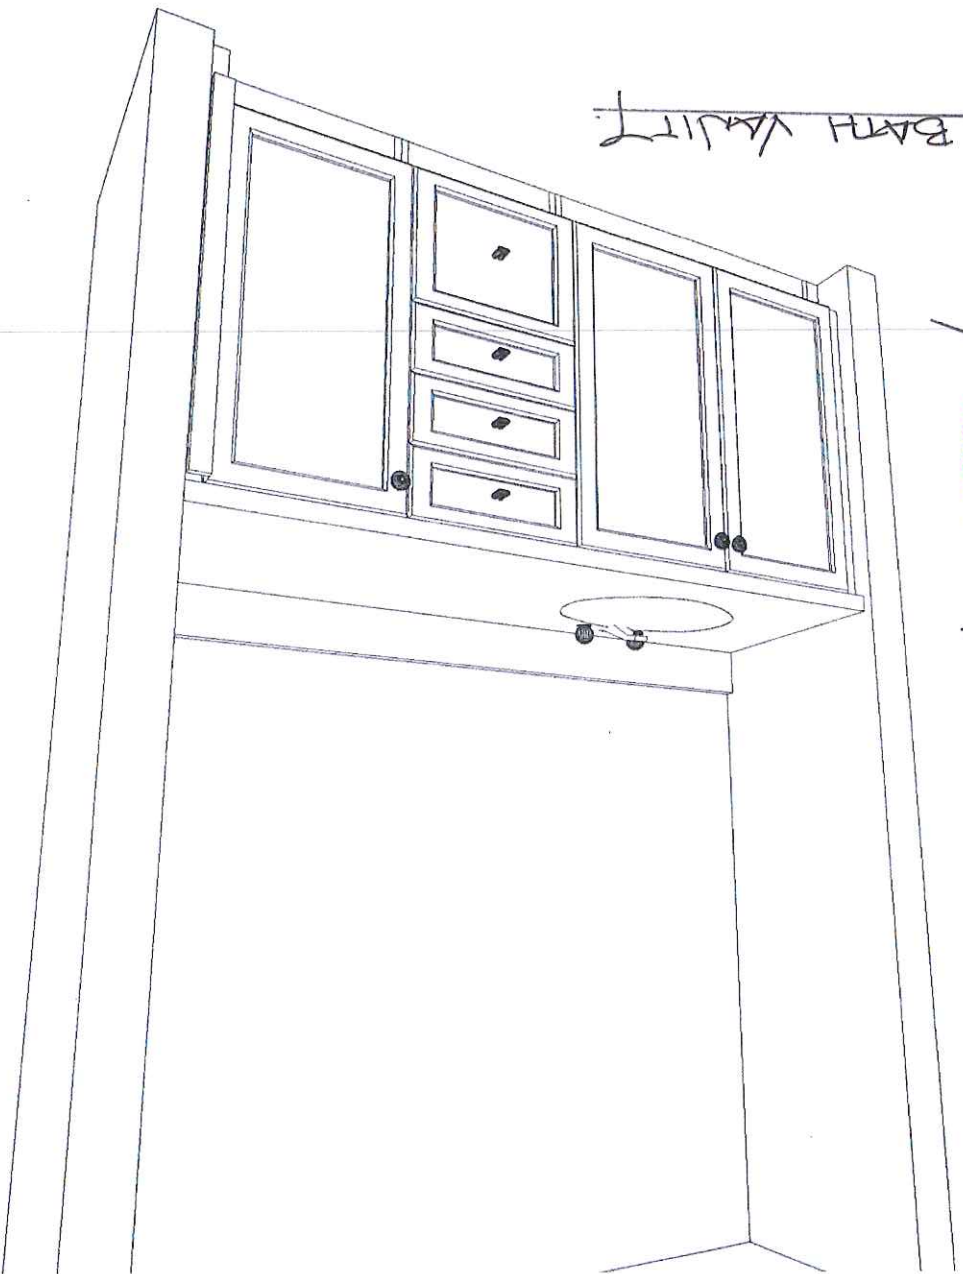

Note: This drawing is an artistic interpretation of the general appearance of the design. It is not meant to be an exact rendition.

DESIGNED BY: LORI DISAVERIO.

2020
TECHNOLOGIES

Carter
KITCHENS

All

Drawings #: 1

Designed: 3/12/2012
Printed: 3/12/2012