

DCR PHOENIX HOMES

SHADOW RIDGE 2

MODEL - GREGORIAN (S1)


LOT # 64

KITCHEN - REV. MAY 6/12

MOUNTING HT: 96"

2" CROWN MOULDING

RECESSED LIGHT VALANCE

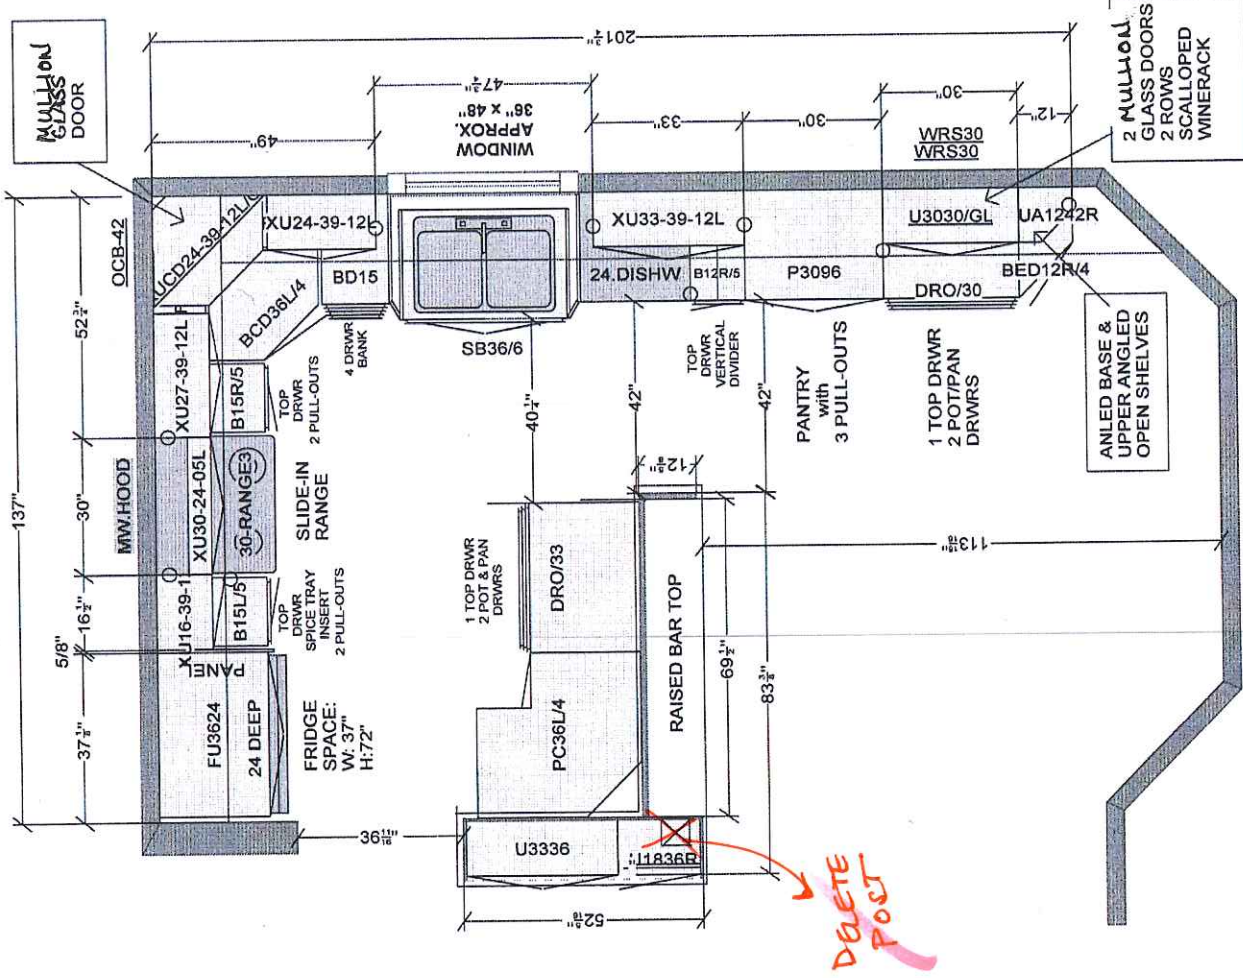

CUSTOMER APPROVAL

I have reviewed these drawings and understand the details of the layout and the Cartier Kitchens specifications.

Signature *[Signature]*

Date: May 2/13

All dimensions size designations given are subject to verification on job site and adjustment to fit job conditions.

CARTIER KITCHENS OTTAWA



This is an original design and must not be released or copied unless applicable fee has been paid or job order placed.

DRAWN BY: LD
CARTIER KITCHENS OTTAWA

Designed: 3/11/2012
Printed: 5/6/2012

DCR #64 - SR2 - Kitchen (Custom S1)

All

Drawing #: 1 No Scale.