

DCR PHOENIX HOMES

Andrea Van Ryckeghem + Derek Dumond

SHADOW RIDGE 2

LOT 35

EQUINOX (B5)

KITCHEN

LINE - TBC

DOOR STYLE - TBC

SPECIES - TBC

COLOUR - TBC

HARDWARE - TBC

2 PCS - 90 DEG. CORNER MOULD

1 PC - T MOULD

2 PCS - FILLER - 6" x 96"


STD WHITE INTERIORS

METAL DRWR BOXES

MOUNTING HT: 96"

(39"H UPPERS INSTALLED @
21" OFF COUNTER)

LIGHT VALANCE

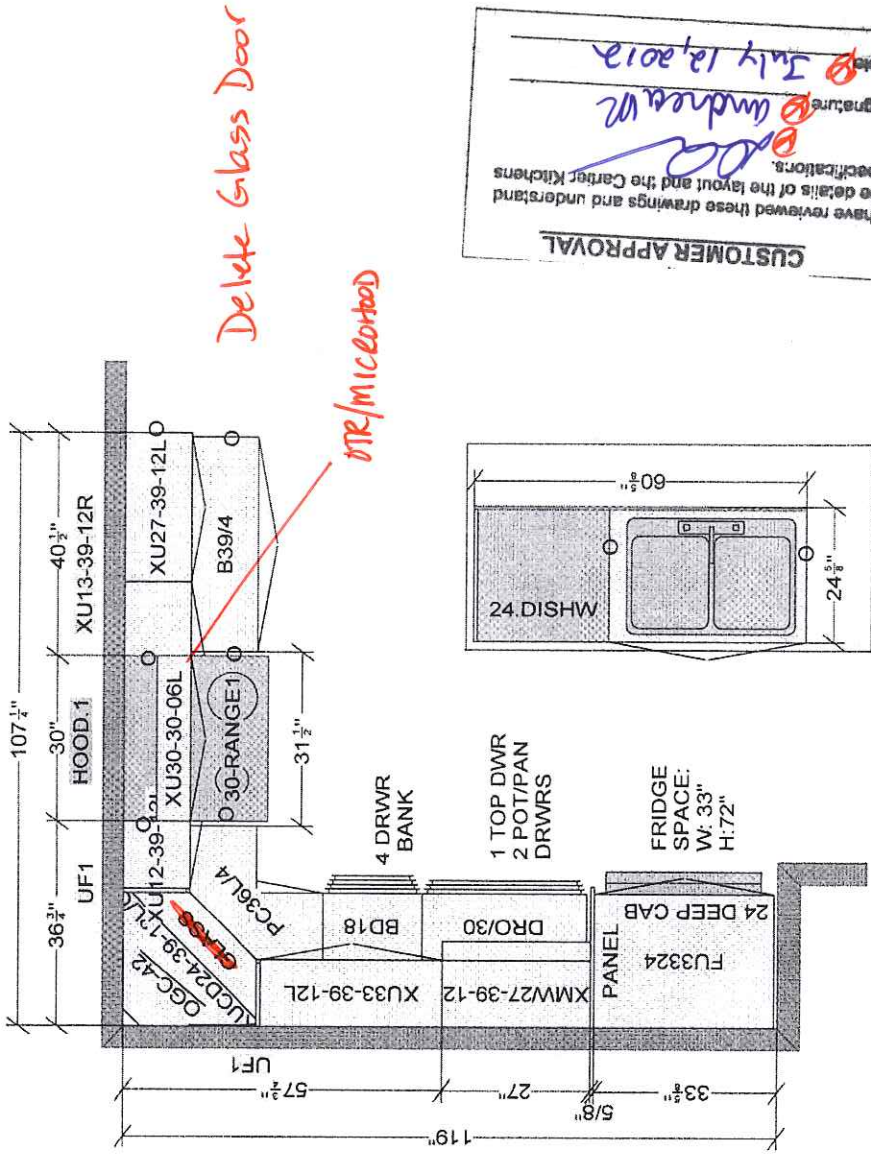

CUSTOMER APPROVAL

I have reviewed these drawings and understand the details of the layout and the Cartier Kitchens specifications.

Signature: *Andrea W*

Date: *July 12, 2012*

FLUSH
BREAKFAST BAR

All dimensions size designations given are subject to verification on job site and adjustment to fit job conditions.

CARTIER KITCHENS OTTAWA

DCR #70 SR2 - Kitchen



DRAWN BY: LD
CARTIER KITCHENS OTTAWA


This is an original design and must not be released or copied unless applicable fee has been paid or job order placed.

Designed: 6/9/2012
Printed: 6/9/2012

All

Drawing #: 1

No Scale.

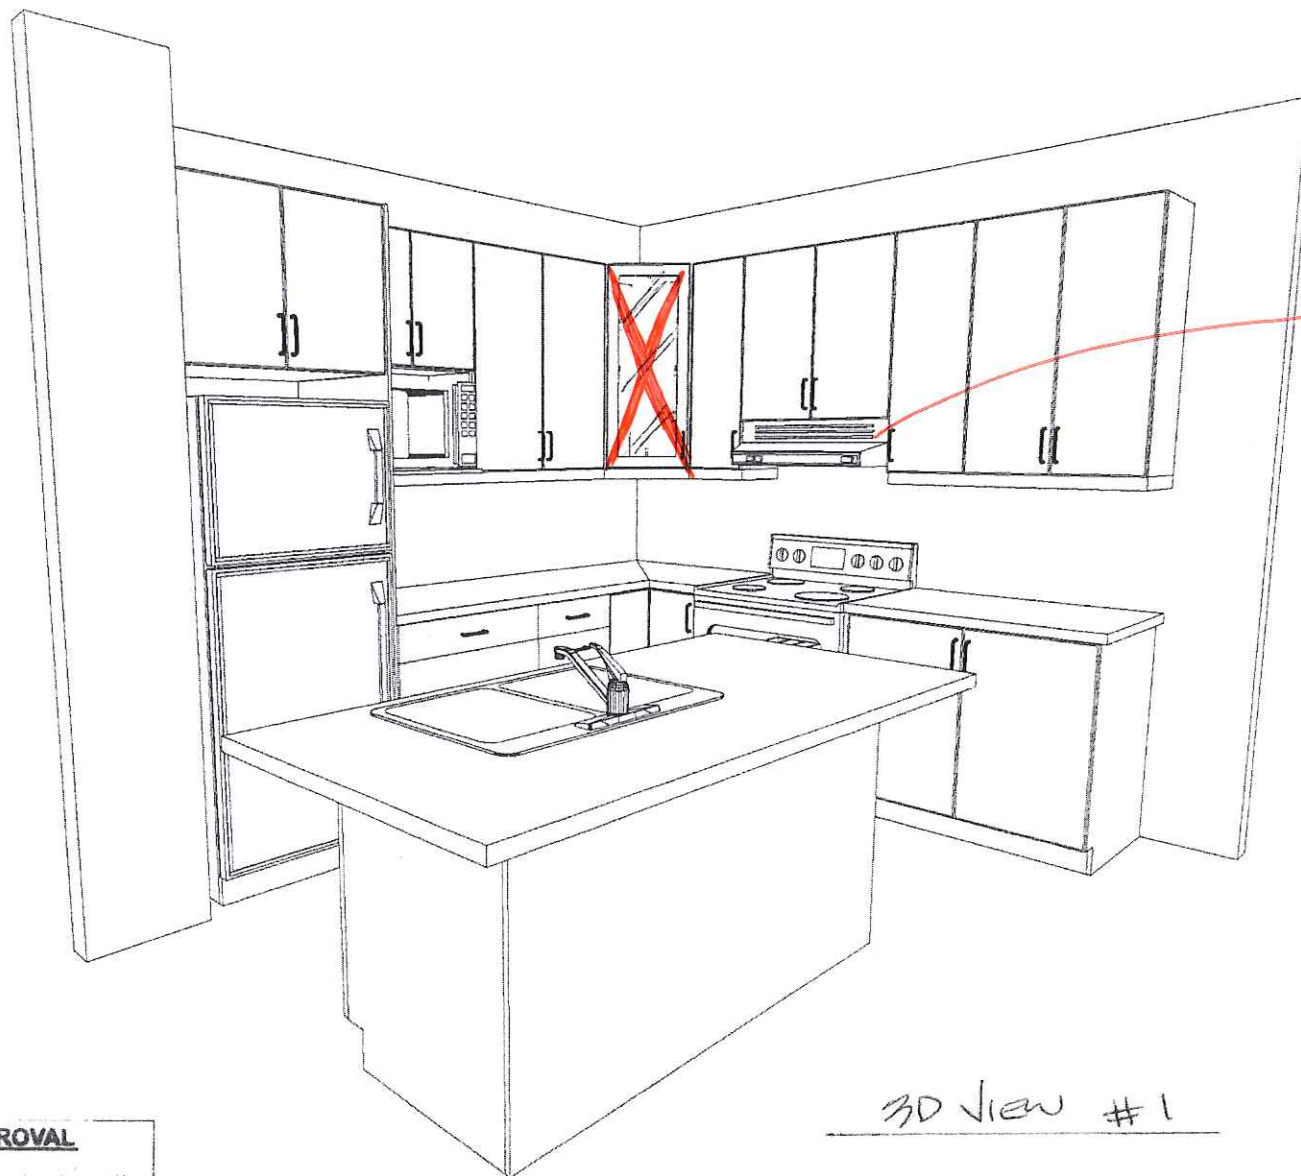

OTR/microhood fan

3D View #1


CUSTOMER APPROVAL

I have reviewed these drawings and understand the details of the layout and the Cartier Kitchens specifications.

Signature  Andrea

Date  July 12, 2012

Note: This drawing is an artistic interpretation of the general appearance of the design. It is not meant to be an exact rendition.

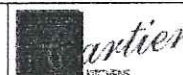


Designed: 6/9/2012
Printed: 6/9/2012

DESIGNED BY: LORI DISAVERIO,
DCR # ~~30~~ SR2 - Kitchen

All

Drawing #: 1

35

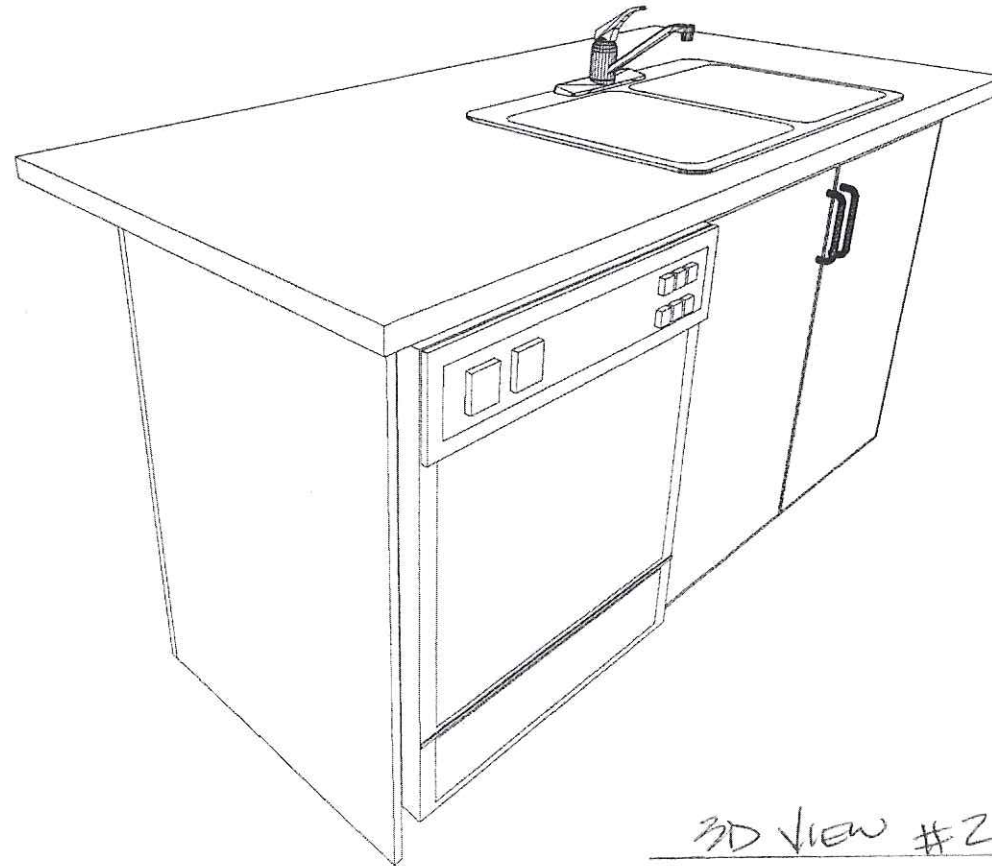

3D VIEW #2.

CUSTOMER APPROVAL

I have reviewed these drawings and understand the details of the layout and the Cartier Kitchens specifications.

Signature DA
andream
 Date July 12, 2012

Note: This drawing is an artistic interpretation of the general appearance of the design. It is not meant to be an exact rendition.




Designed: 6/9/2012
 Printed: 6/9/2012

DESIGNED BY: LORI DISAVERIO,
 DCR #79 SR2 - Kitchen

All

Drawing #: 1

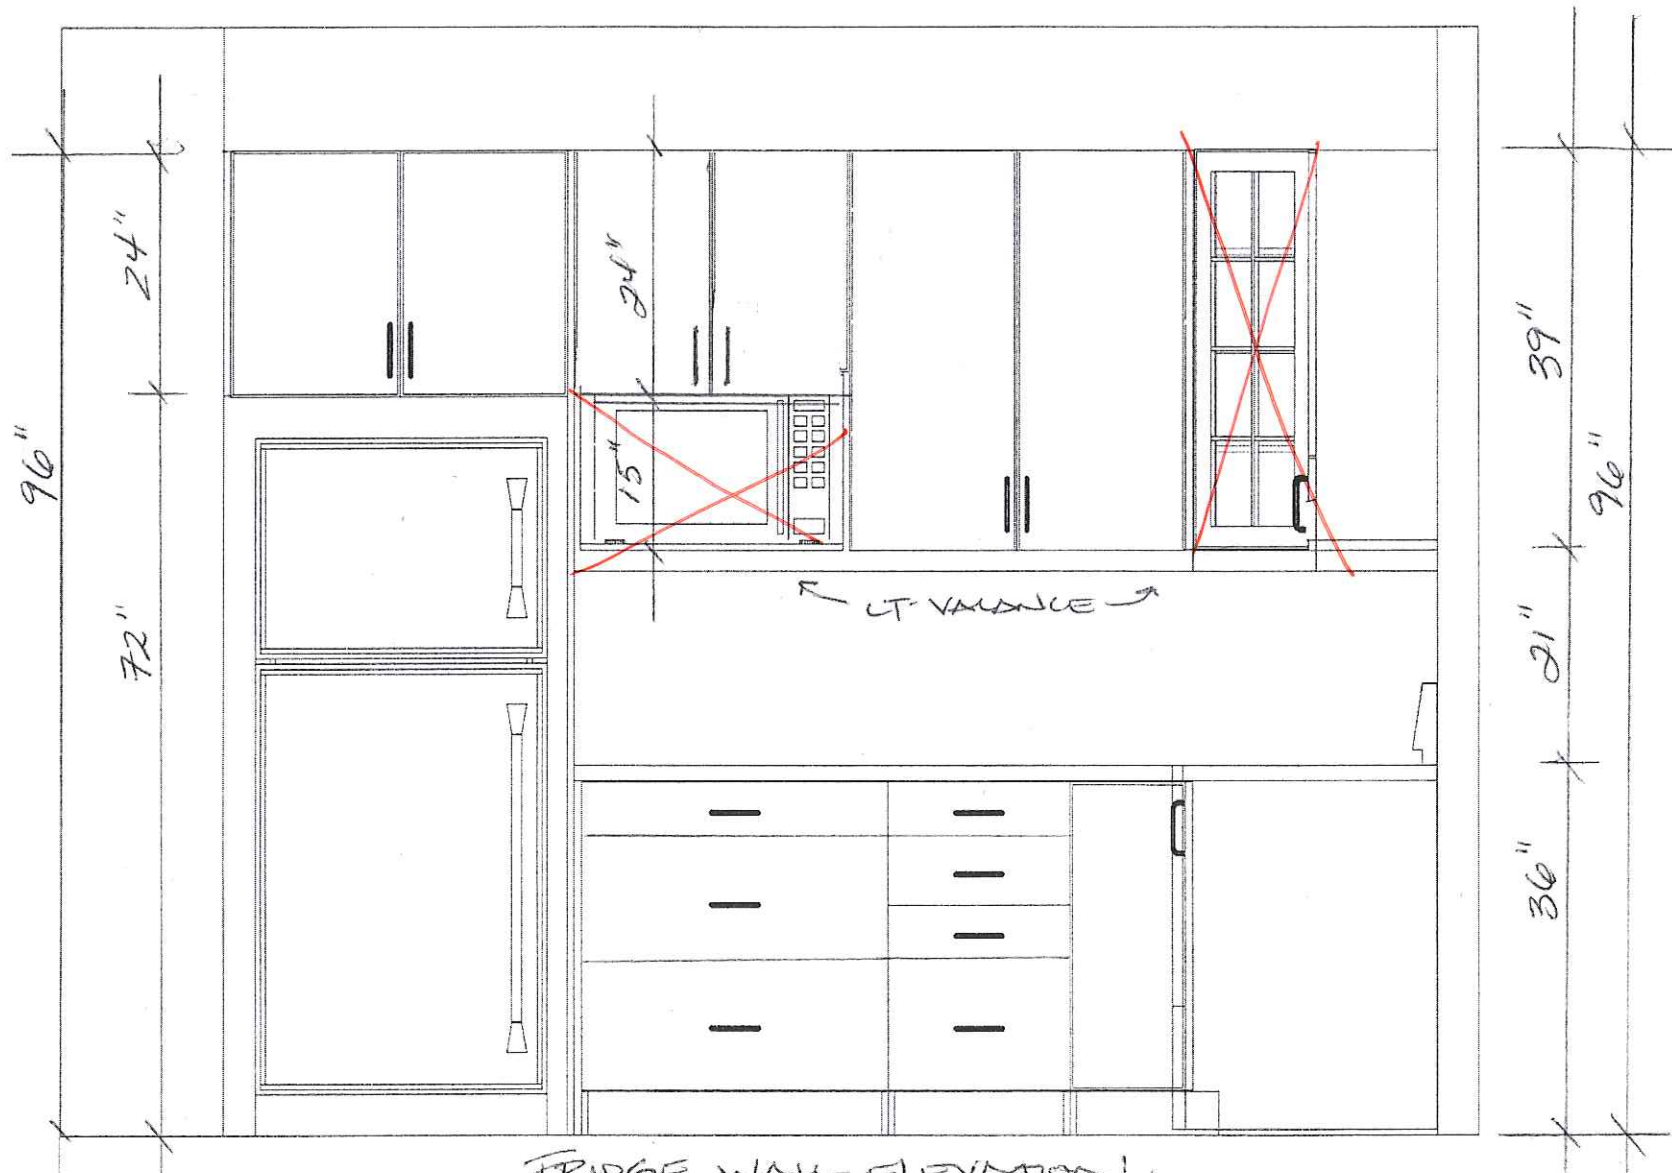

FRIDGE WALL ELEVATION.

CUSTOMER APPROVAL

I have reviewed these drawings and understand the details of the layout and the Cartier Kitchens specifications.

Signature *Andrea*

Date *July 12, 2012*

Note: This drawing is an artistic interpretation of the general appearance of the design. It is not meant to be an exact rendition.




DESIGNED BY: LORI DISAVERIO.

DCR # ~~70~~ SR2 - Kitchen

Designed: 6/9/2012
Printed: 6/9/2012

All

Drawing #: 1

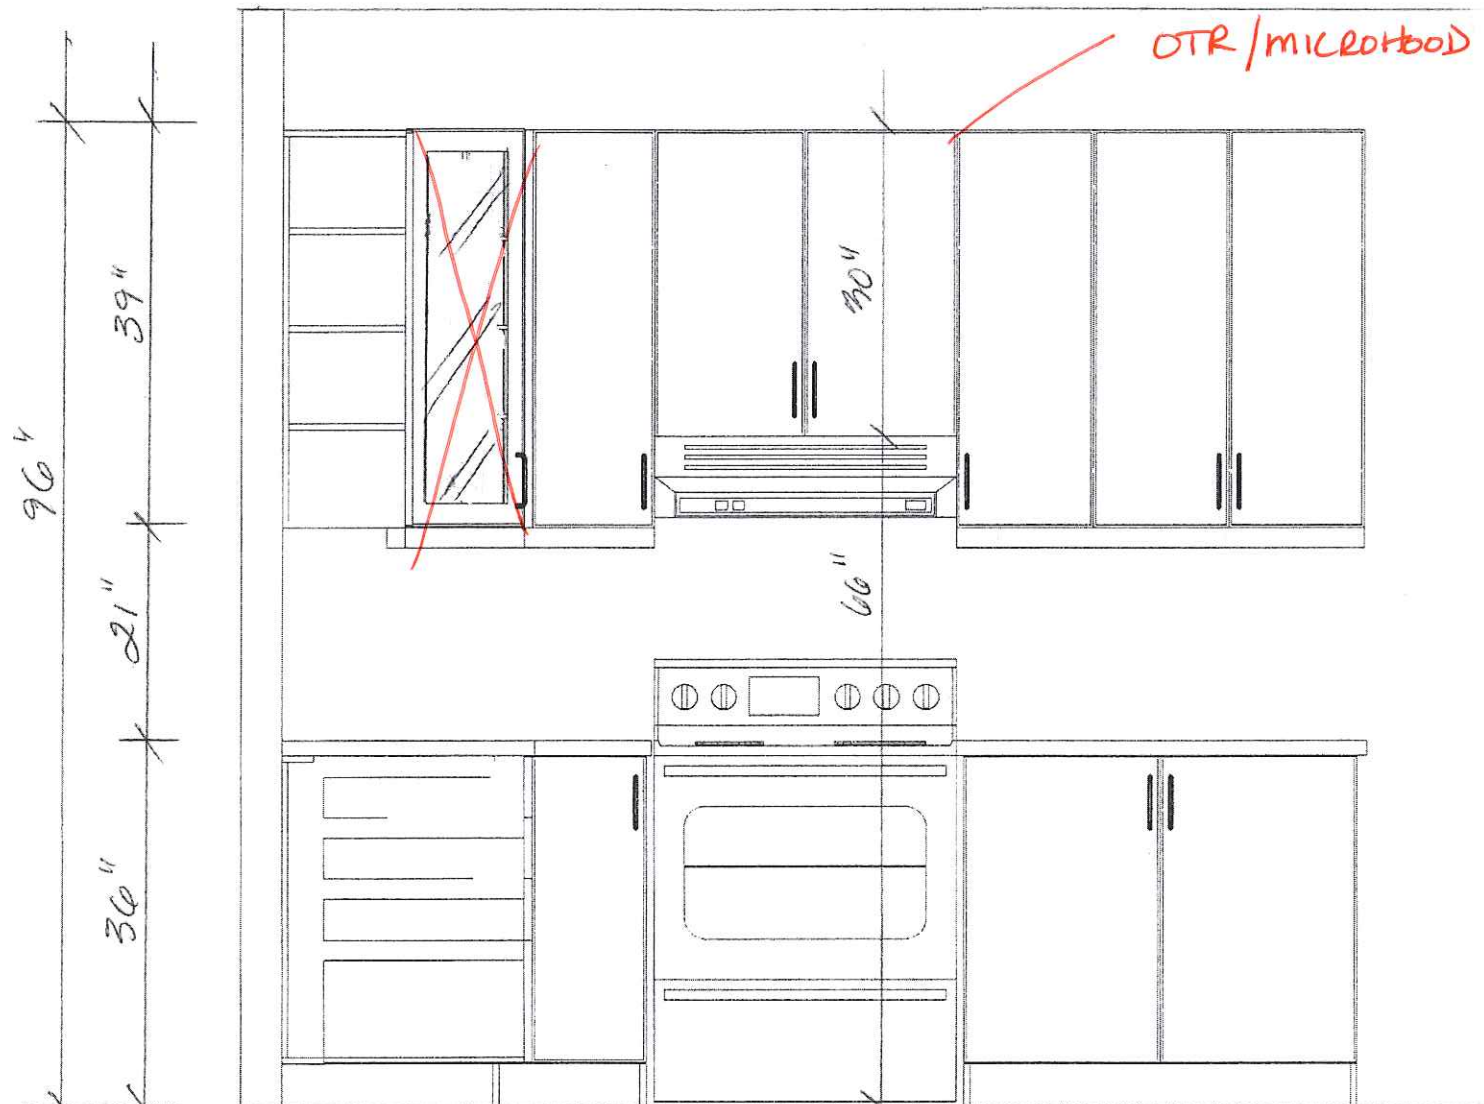

STOVE WALL ELEVATION

CUSTOMER APPROVAL

I have reviewed these drawings and understand the details of the layout and the Cartier Kitchens specifications.

Signature

Date

[Signature]
[Signature]
 July 12, 2012

Note: This drawing is an artistic interpretation of the general appearance of the design. It is not meant to be an exact rendition.

DESIGNED BY: LORI DISAVERIO,
 DCR #20 SR2 - Kitchen



Designed: 6/9/2012
 Printed: 6/9/2012

All

Drawing #: 1