

DCR PHOENIX HOMES


SHADOW RIDGE 2
LOT #69

S3 BABYLONIAN

KITCHEN

REVISED JUNE 14-14

MOUNTING HT: 96"

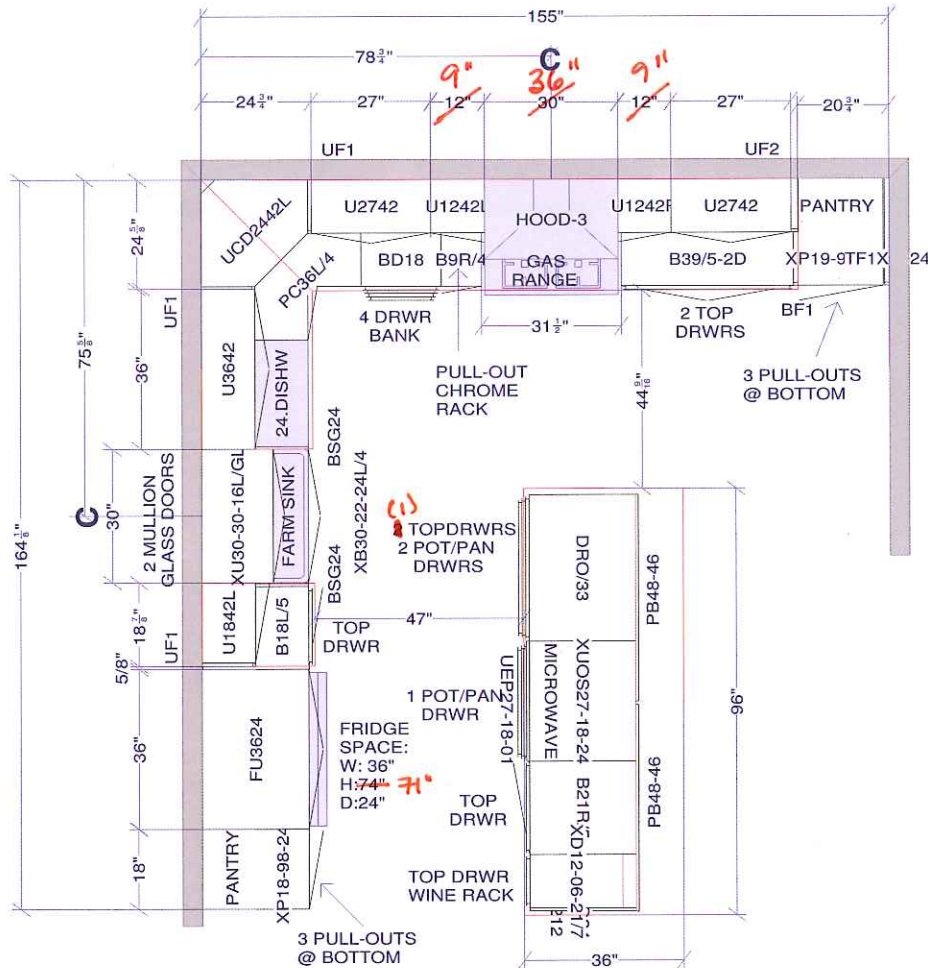

CUSTOMER APPROVAL

I have reviewed these drawings and understand the details of the layout and the Cartier Kitchens specifications.

Signature

Date

June 25 / 14

All dimensions size designations given are subject to verification on job site and adjustment to fit job conditions.


Cartier Kitchens Ottawa



This is an original design and must not be released or copied unless applicable fee has been paid or job order placed.

Drawn by: Lori Di Saverio, B.I.D.
Cartier Kitchens Ottawa

Designed: 14/06/201
Printed: 14/06/2014

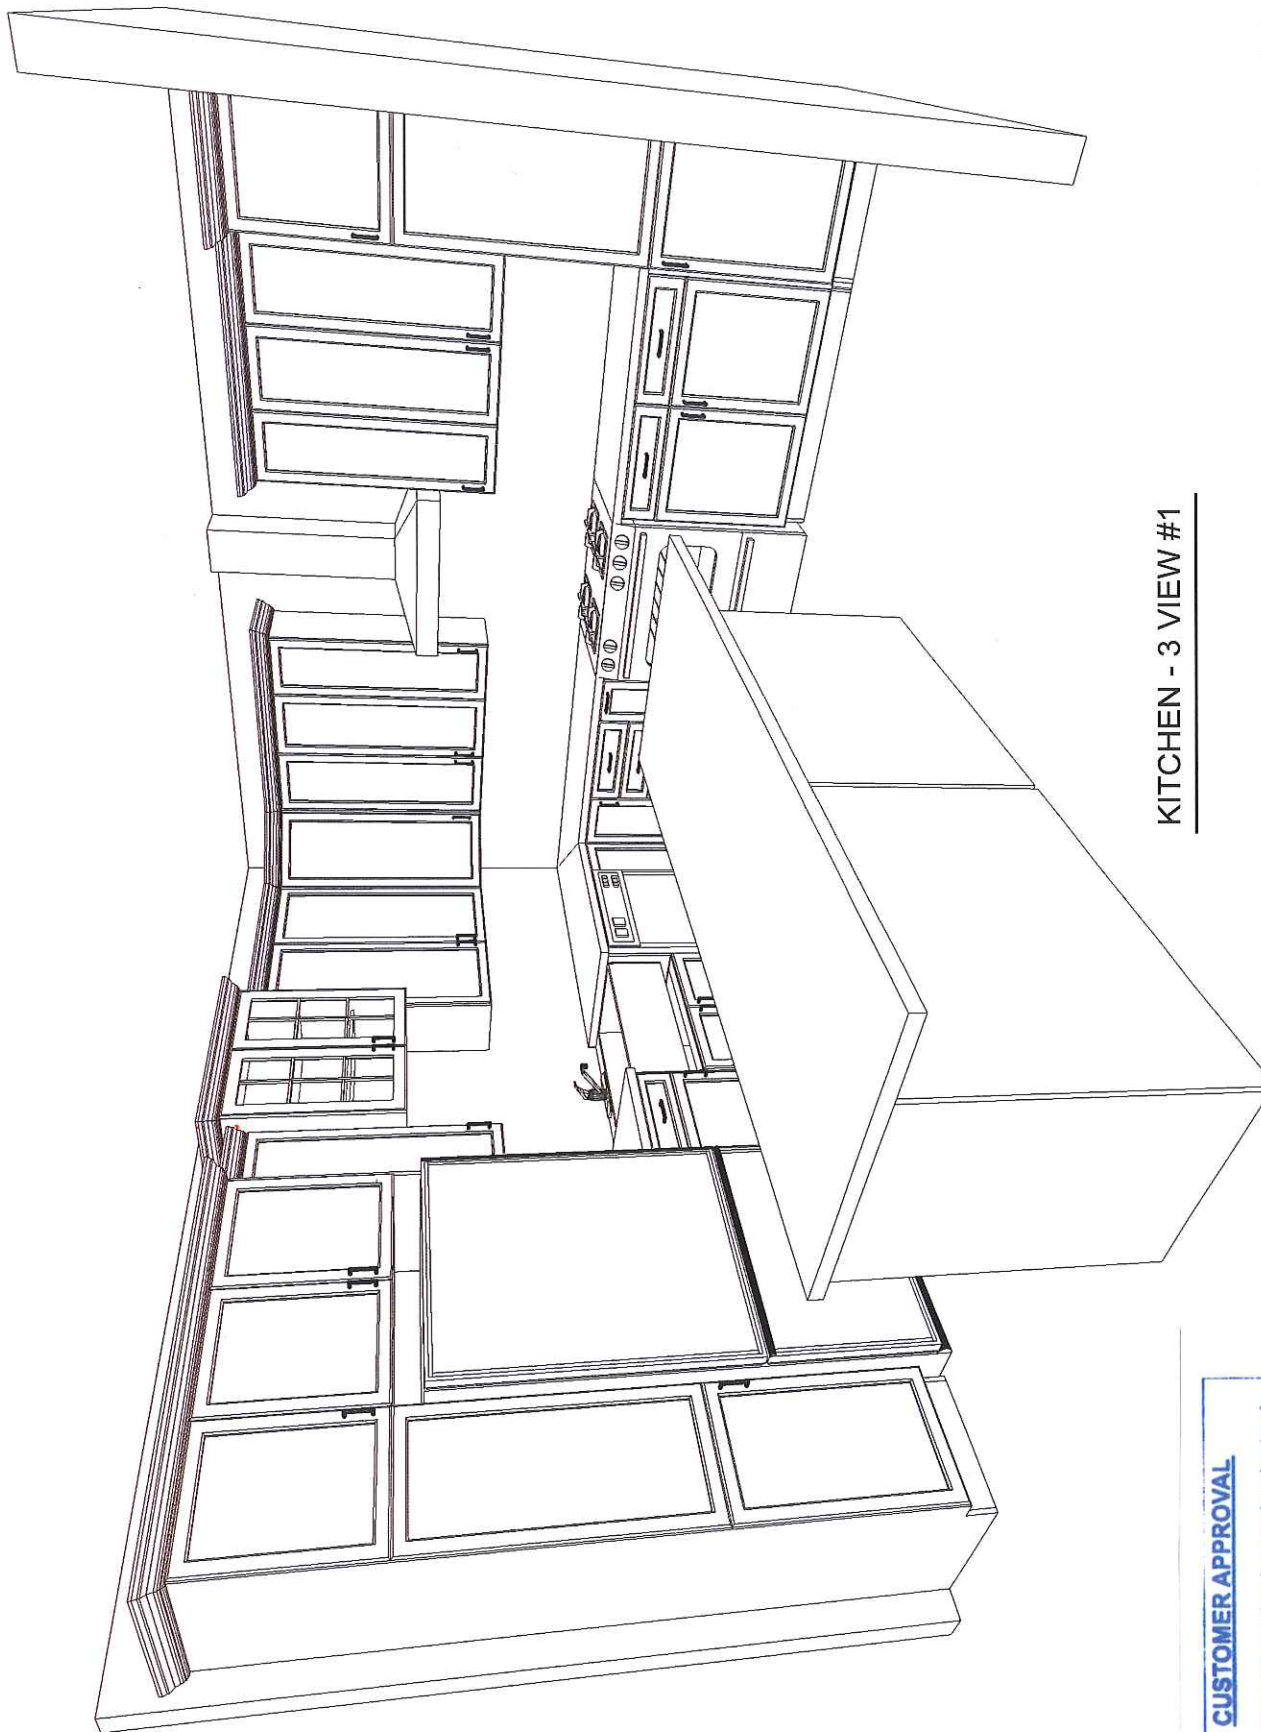

KITCHEN - 3 VIEW #1

CUSTOMER APPROVAL

I have reviewed these drawings and understand the details of the layout and the Cartier Kitchens specifications.

Signature [Signature]

Date June 25/14



Note: This drawing is an artistic interpretation of the general appearance of the design. It is not meant to be an exact rendition.


Drawn By: Lori D Saverio, B.I.D.
Cartier Kitchens Ottawa

Designed: 14/06/2014
Printed: 14/06/2014

NOB #40000 Kitchen rev. June 14 14 /CS2

A11

Revision #1

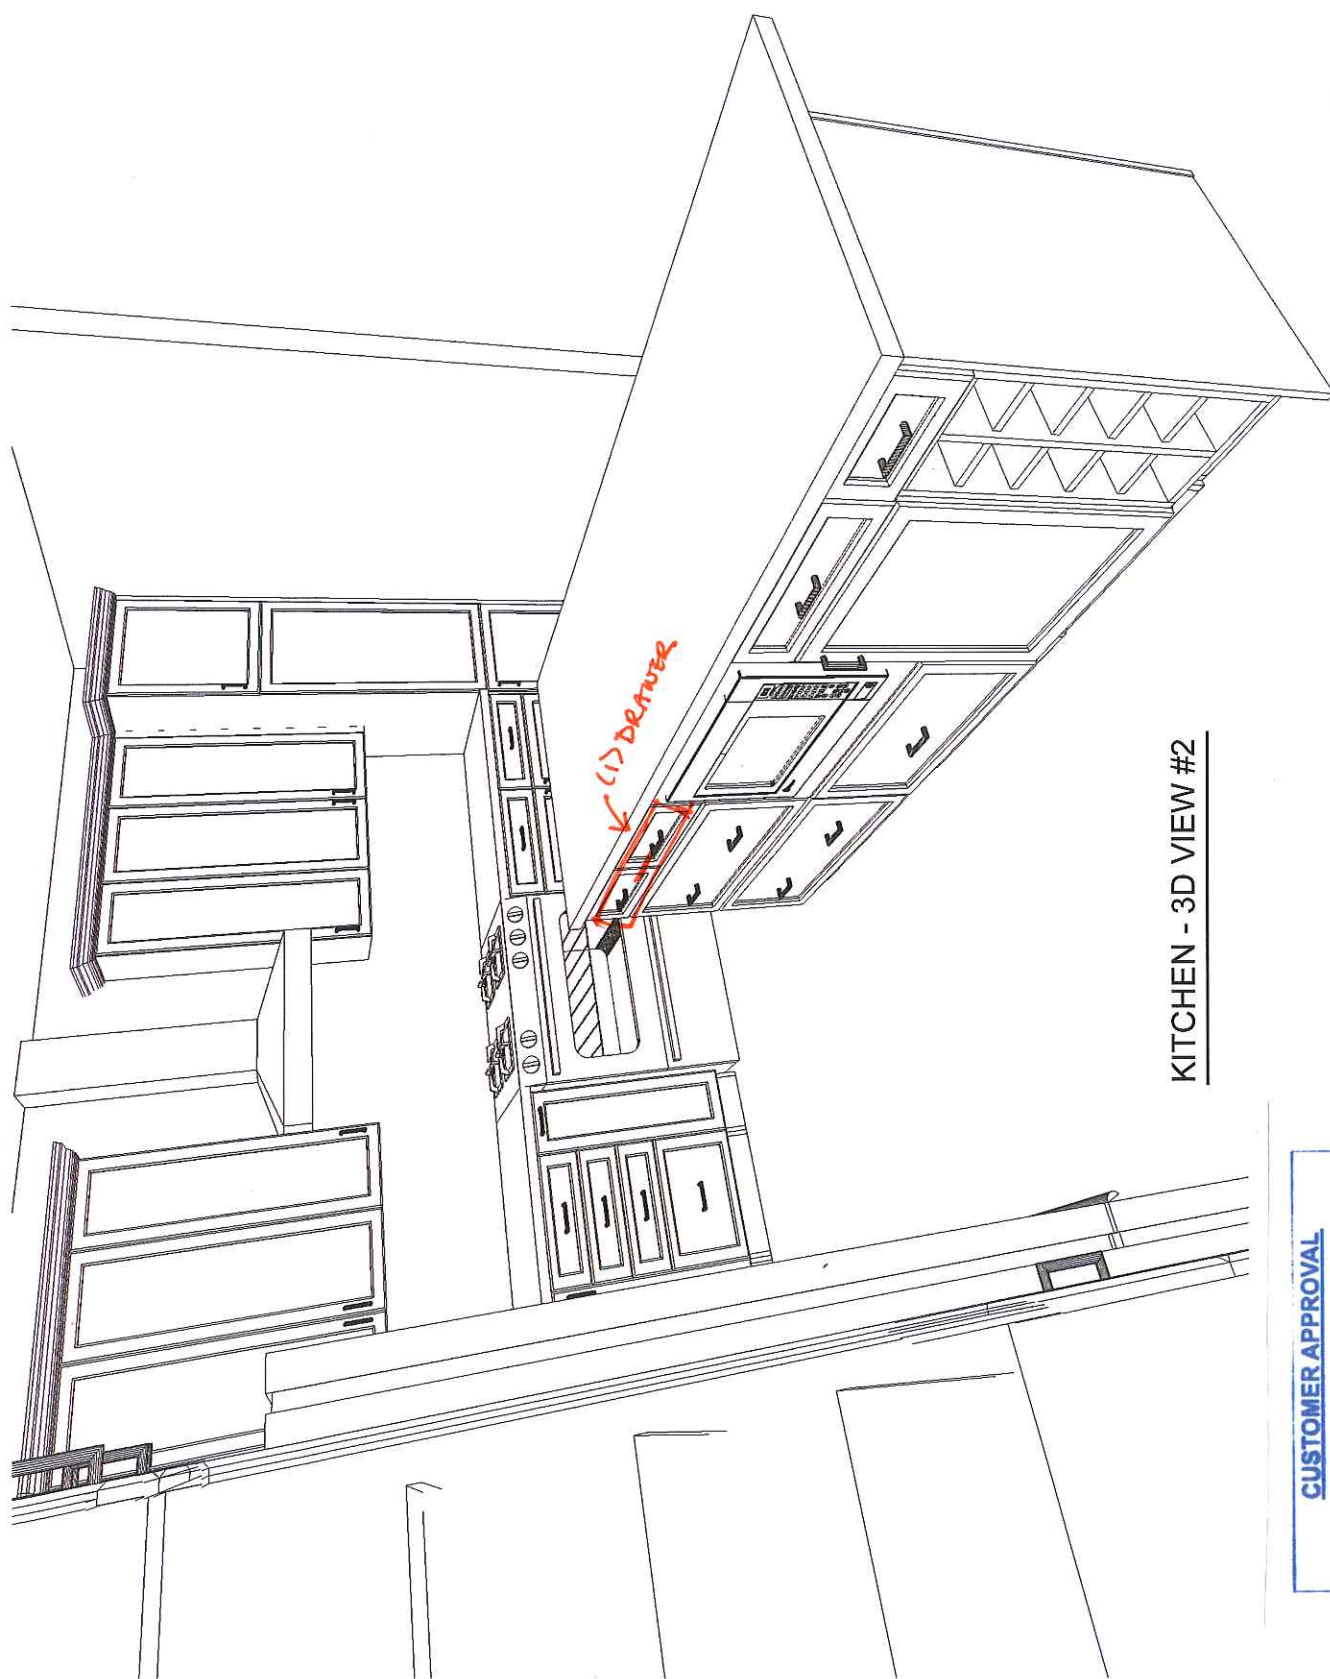

KITCHEN - 3D VIEW #2

CUSTOMER APPROVAL

I have reviewed these drawings and understand the details of the layout and the Cartier Kitchens specifications.

Signature LM AM

Date June 25/14

Note: This drawing is an artistic interpretation of the general appearance of the design. It is not meant to be an exact rendition.


Drawn By: Lori D Saverio, B.I.D.
Cartier Kitchens Ottawa
POB #40 000 Vichon Ave. Unit 14 14 / 02

Designed: 14/06/2014
Printed: 14/06/2014

2020
TECHNOLOGIES

Page # 11

Revision # 1

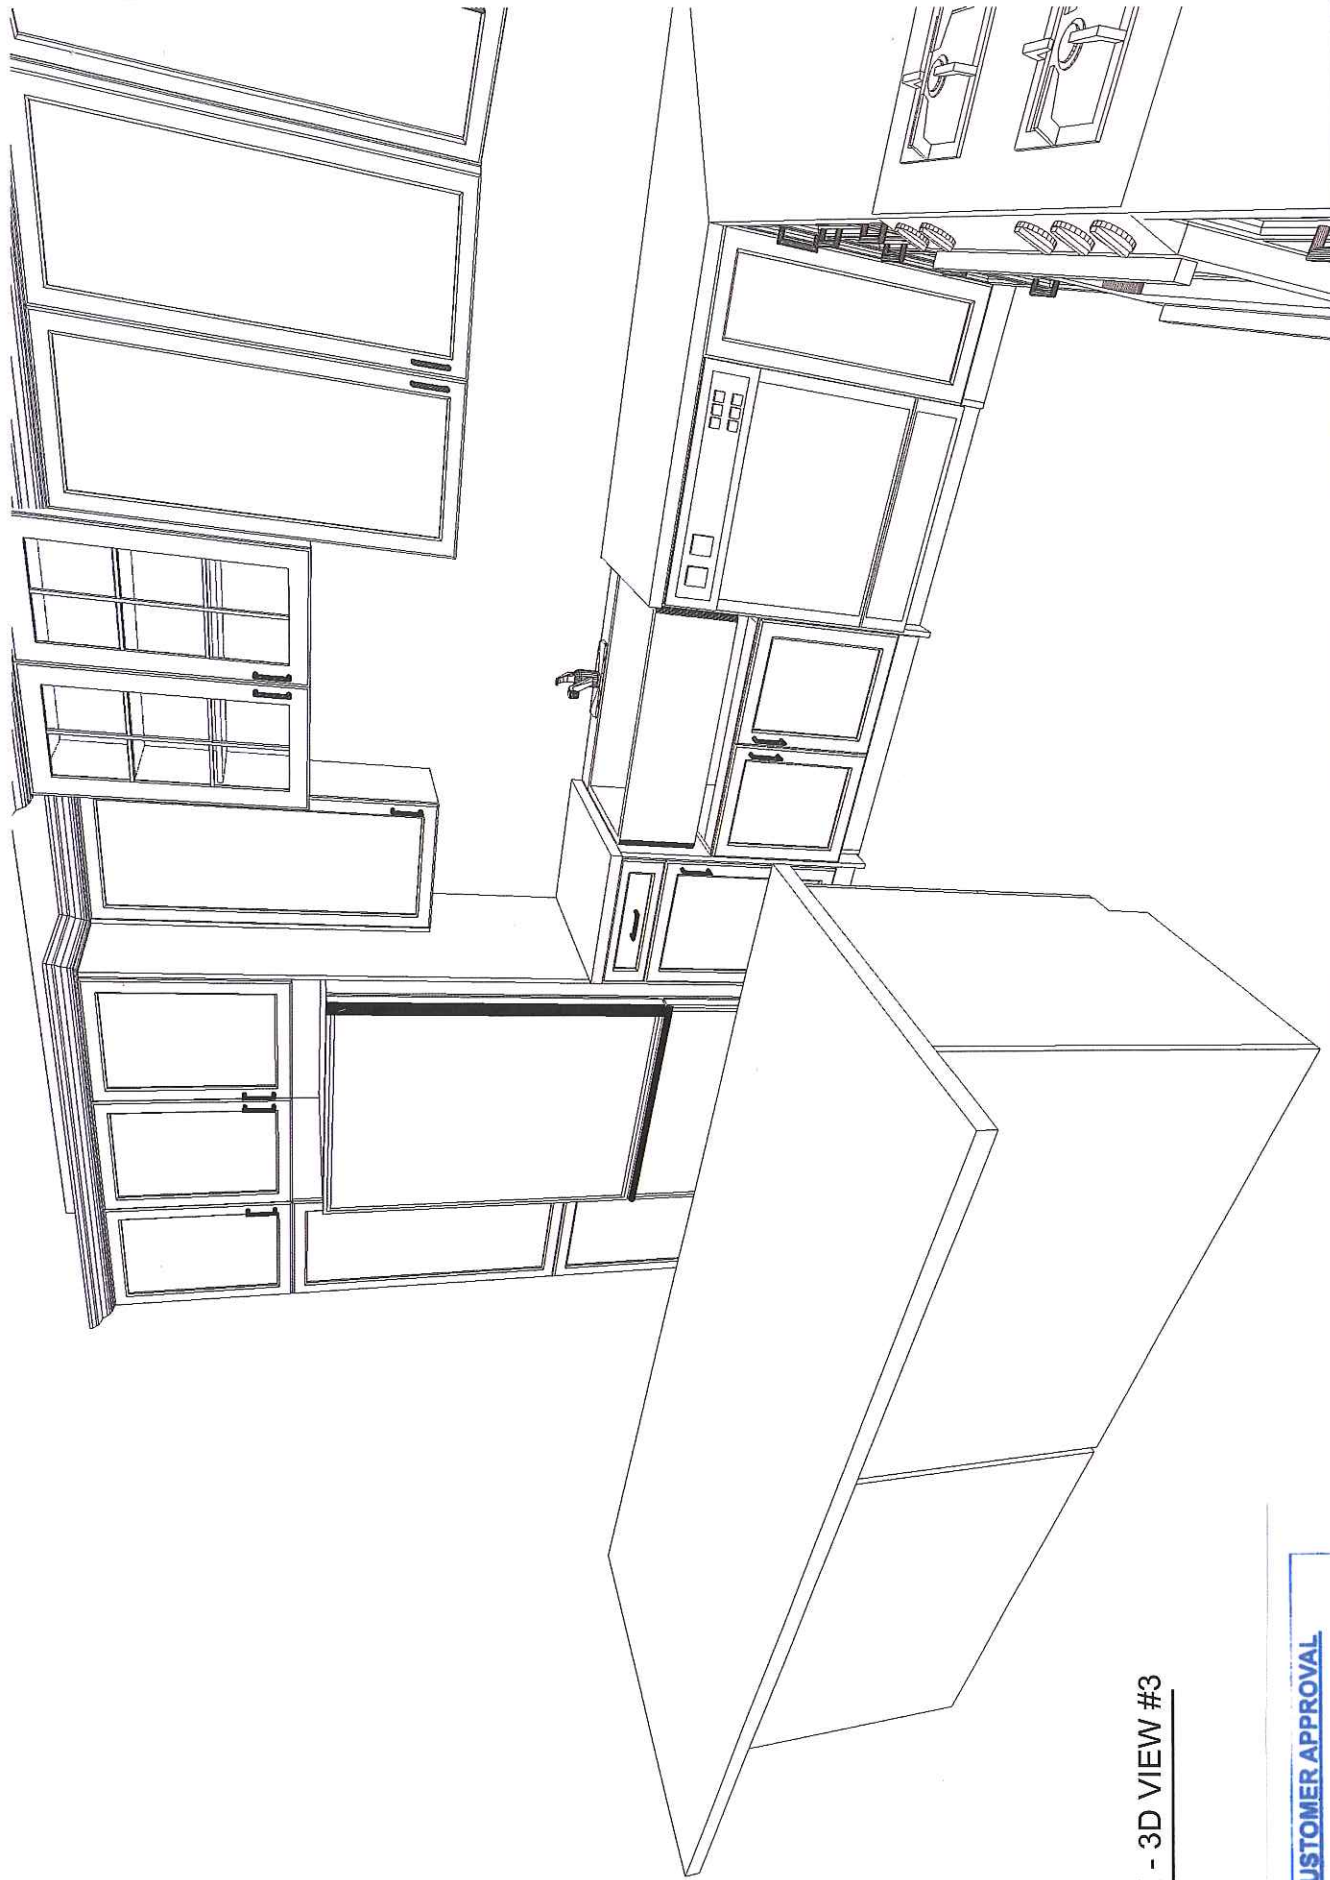

KITCHEN - 3D VIEW #3

CUSTOMER APPROVAL

I have reviewed these drawings and understand the details of the layout and the Cartier Kitchens specifications.

Signature *Am*

Date June 25/14


Note: This drawing is an artistic interpretation of the general appearance of the design. It is not meant to be an exact rendition.

Drawn By: Lori D Saverio, B.I.D.
Cartier Kitchens Ottawa
POB #40802 Kitchen



Designed: 14/06/2014
Printed: 14/06/2014

STOVE WALL ELEVATION

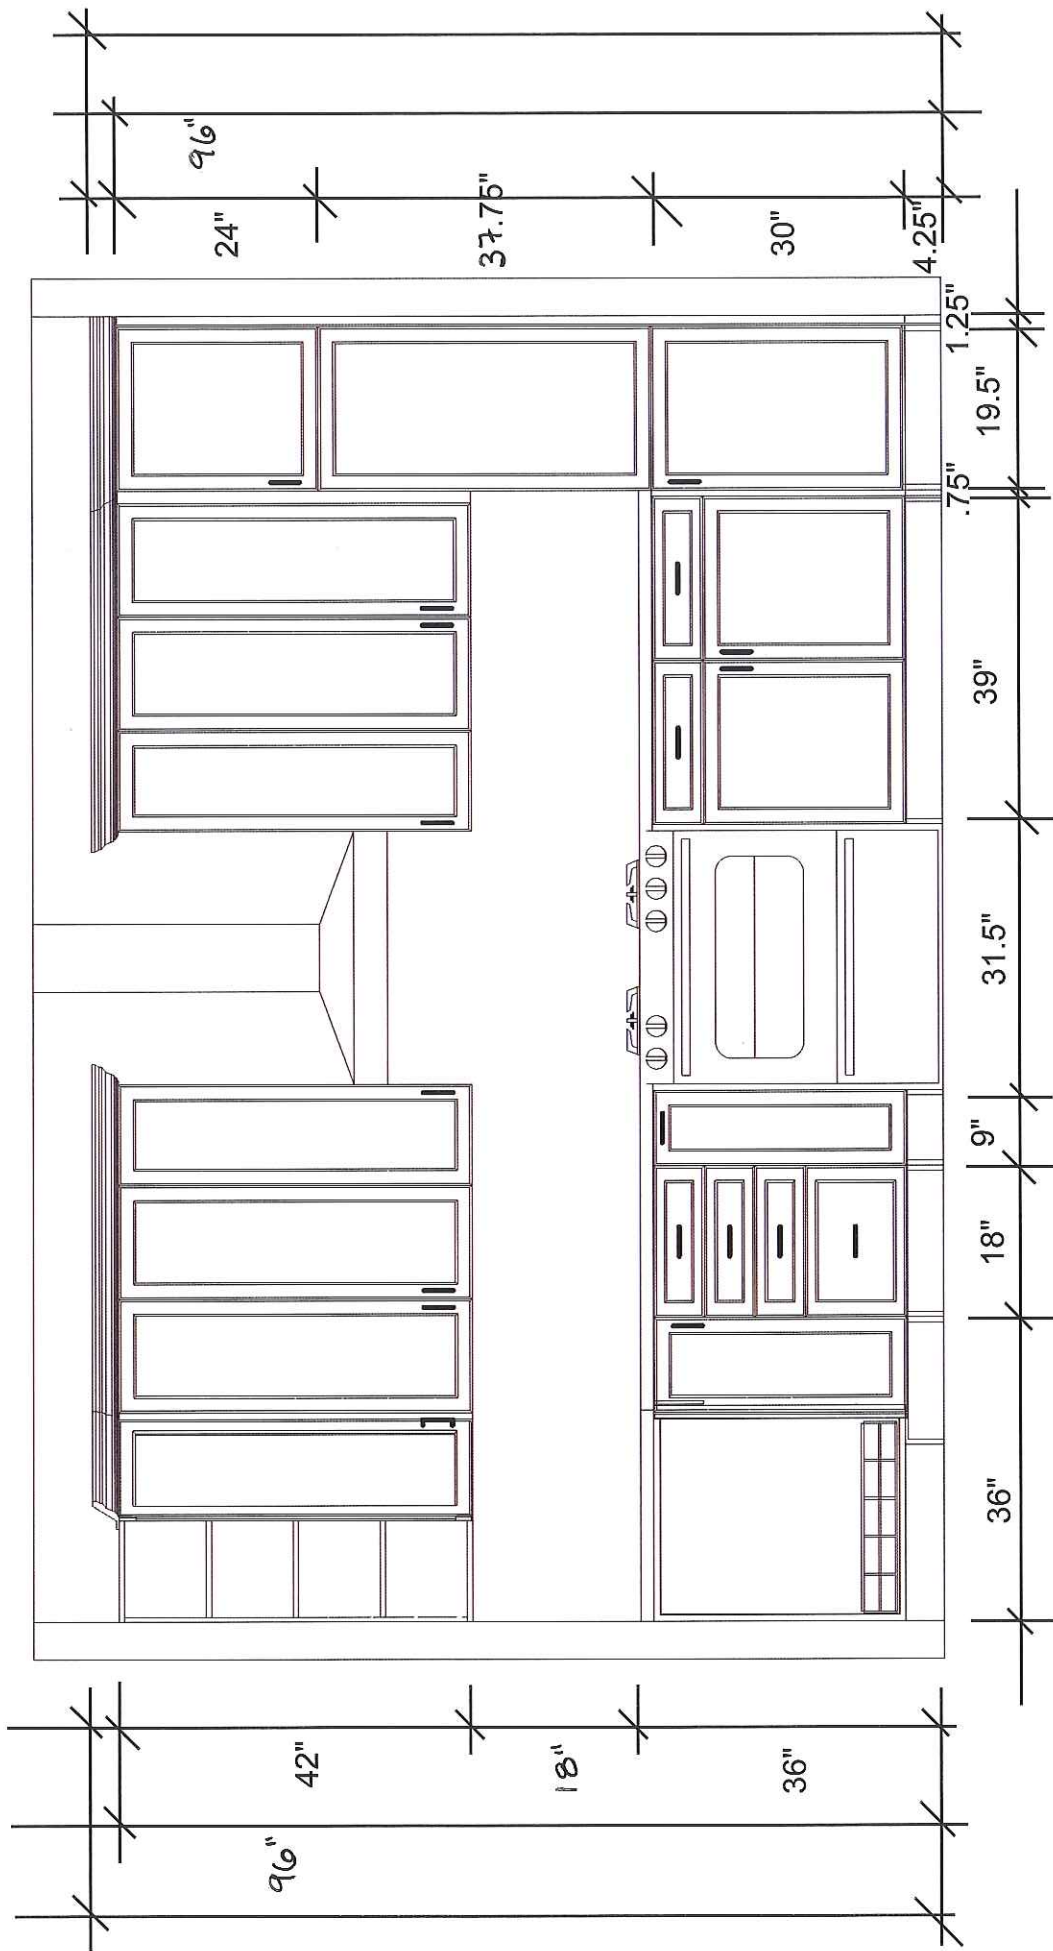

CUSTOMER APPROVAL

I have reviewed these drawings and understand the details of the layout and the Cartier Kitchens specifications.

Am Am

Signature

Date June 25/14

Note: This drawing is an artistic interpretation of the general appearance of the design. It is not meant to be an exact rendition.

Drawn By: Lori D Saverio, B.I.D.
Cartier Kitchens Ottawa

DCR #69 SR2 - Kitchen - rev June 14-14 (S3)


All

Drawing #: 1

2020
TECHNOLOGIES

Designed: 14/06/2014
Printed: 14/06/2014

FRIDGE / SINK WALL ELEVATION

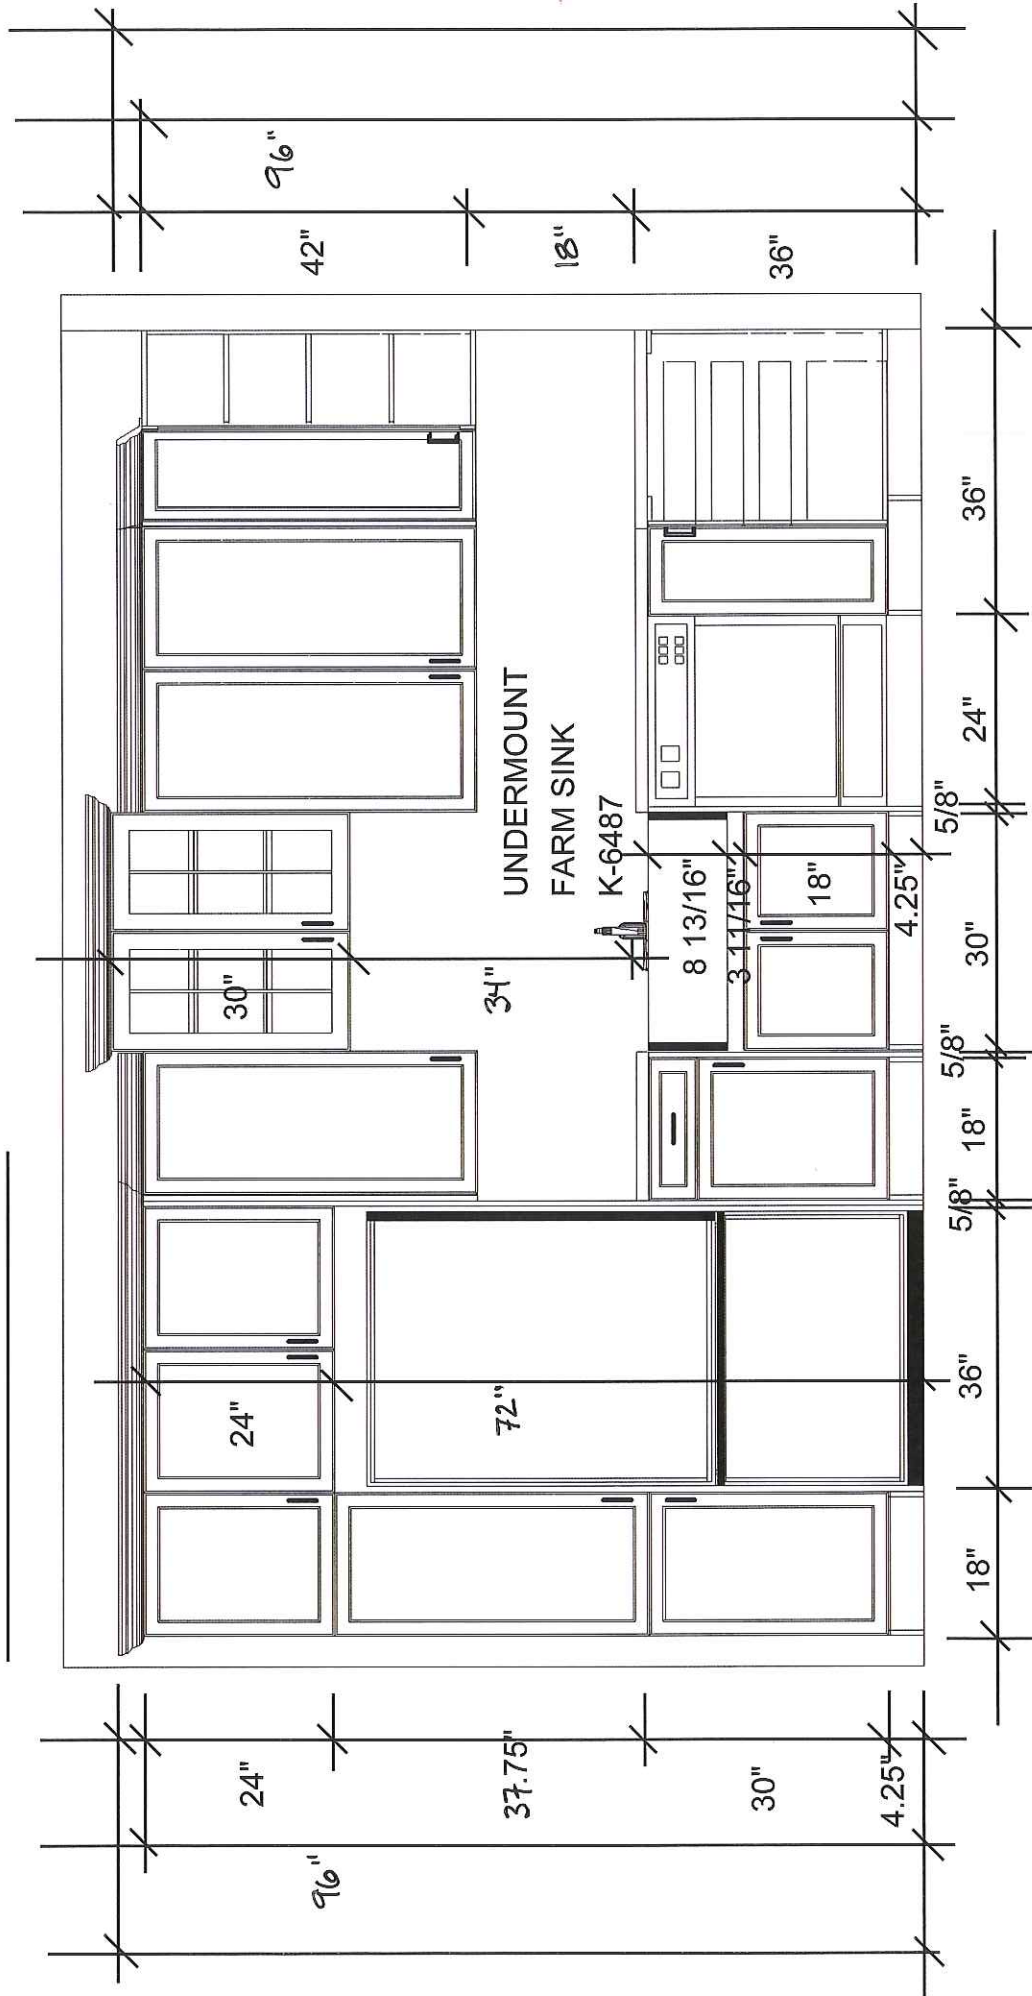

CUSTOMER APPROVAL

I have reviewed these drawings and understand the details of the layout and the Cartier Kitchens specifications.

Signature *[Signature]*

Date June 25/14

Note: This drawing is an artistic interpretation of the general appearance of the design. It is not meant to be an exact rendition.

Drawn By: Lori D Saverio, B.I.D.
Cartier Kitchens Ottawa
DOB #40 603 Kitchen



Designed: 14/06/2014
Printed: 14/06/2014