


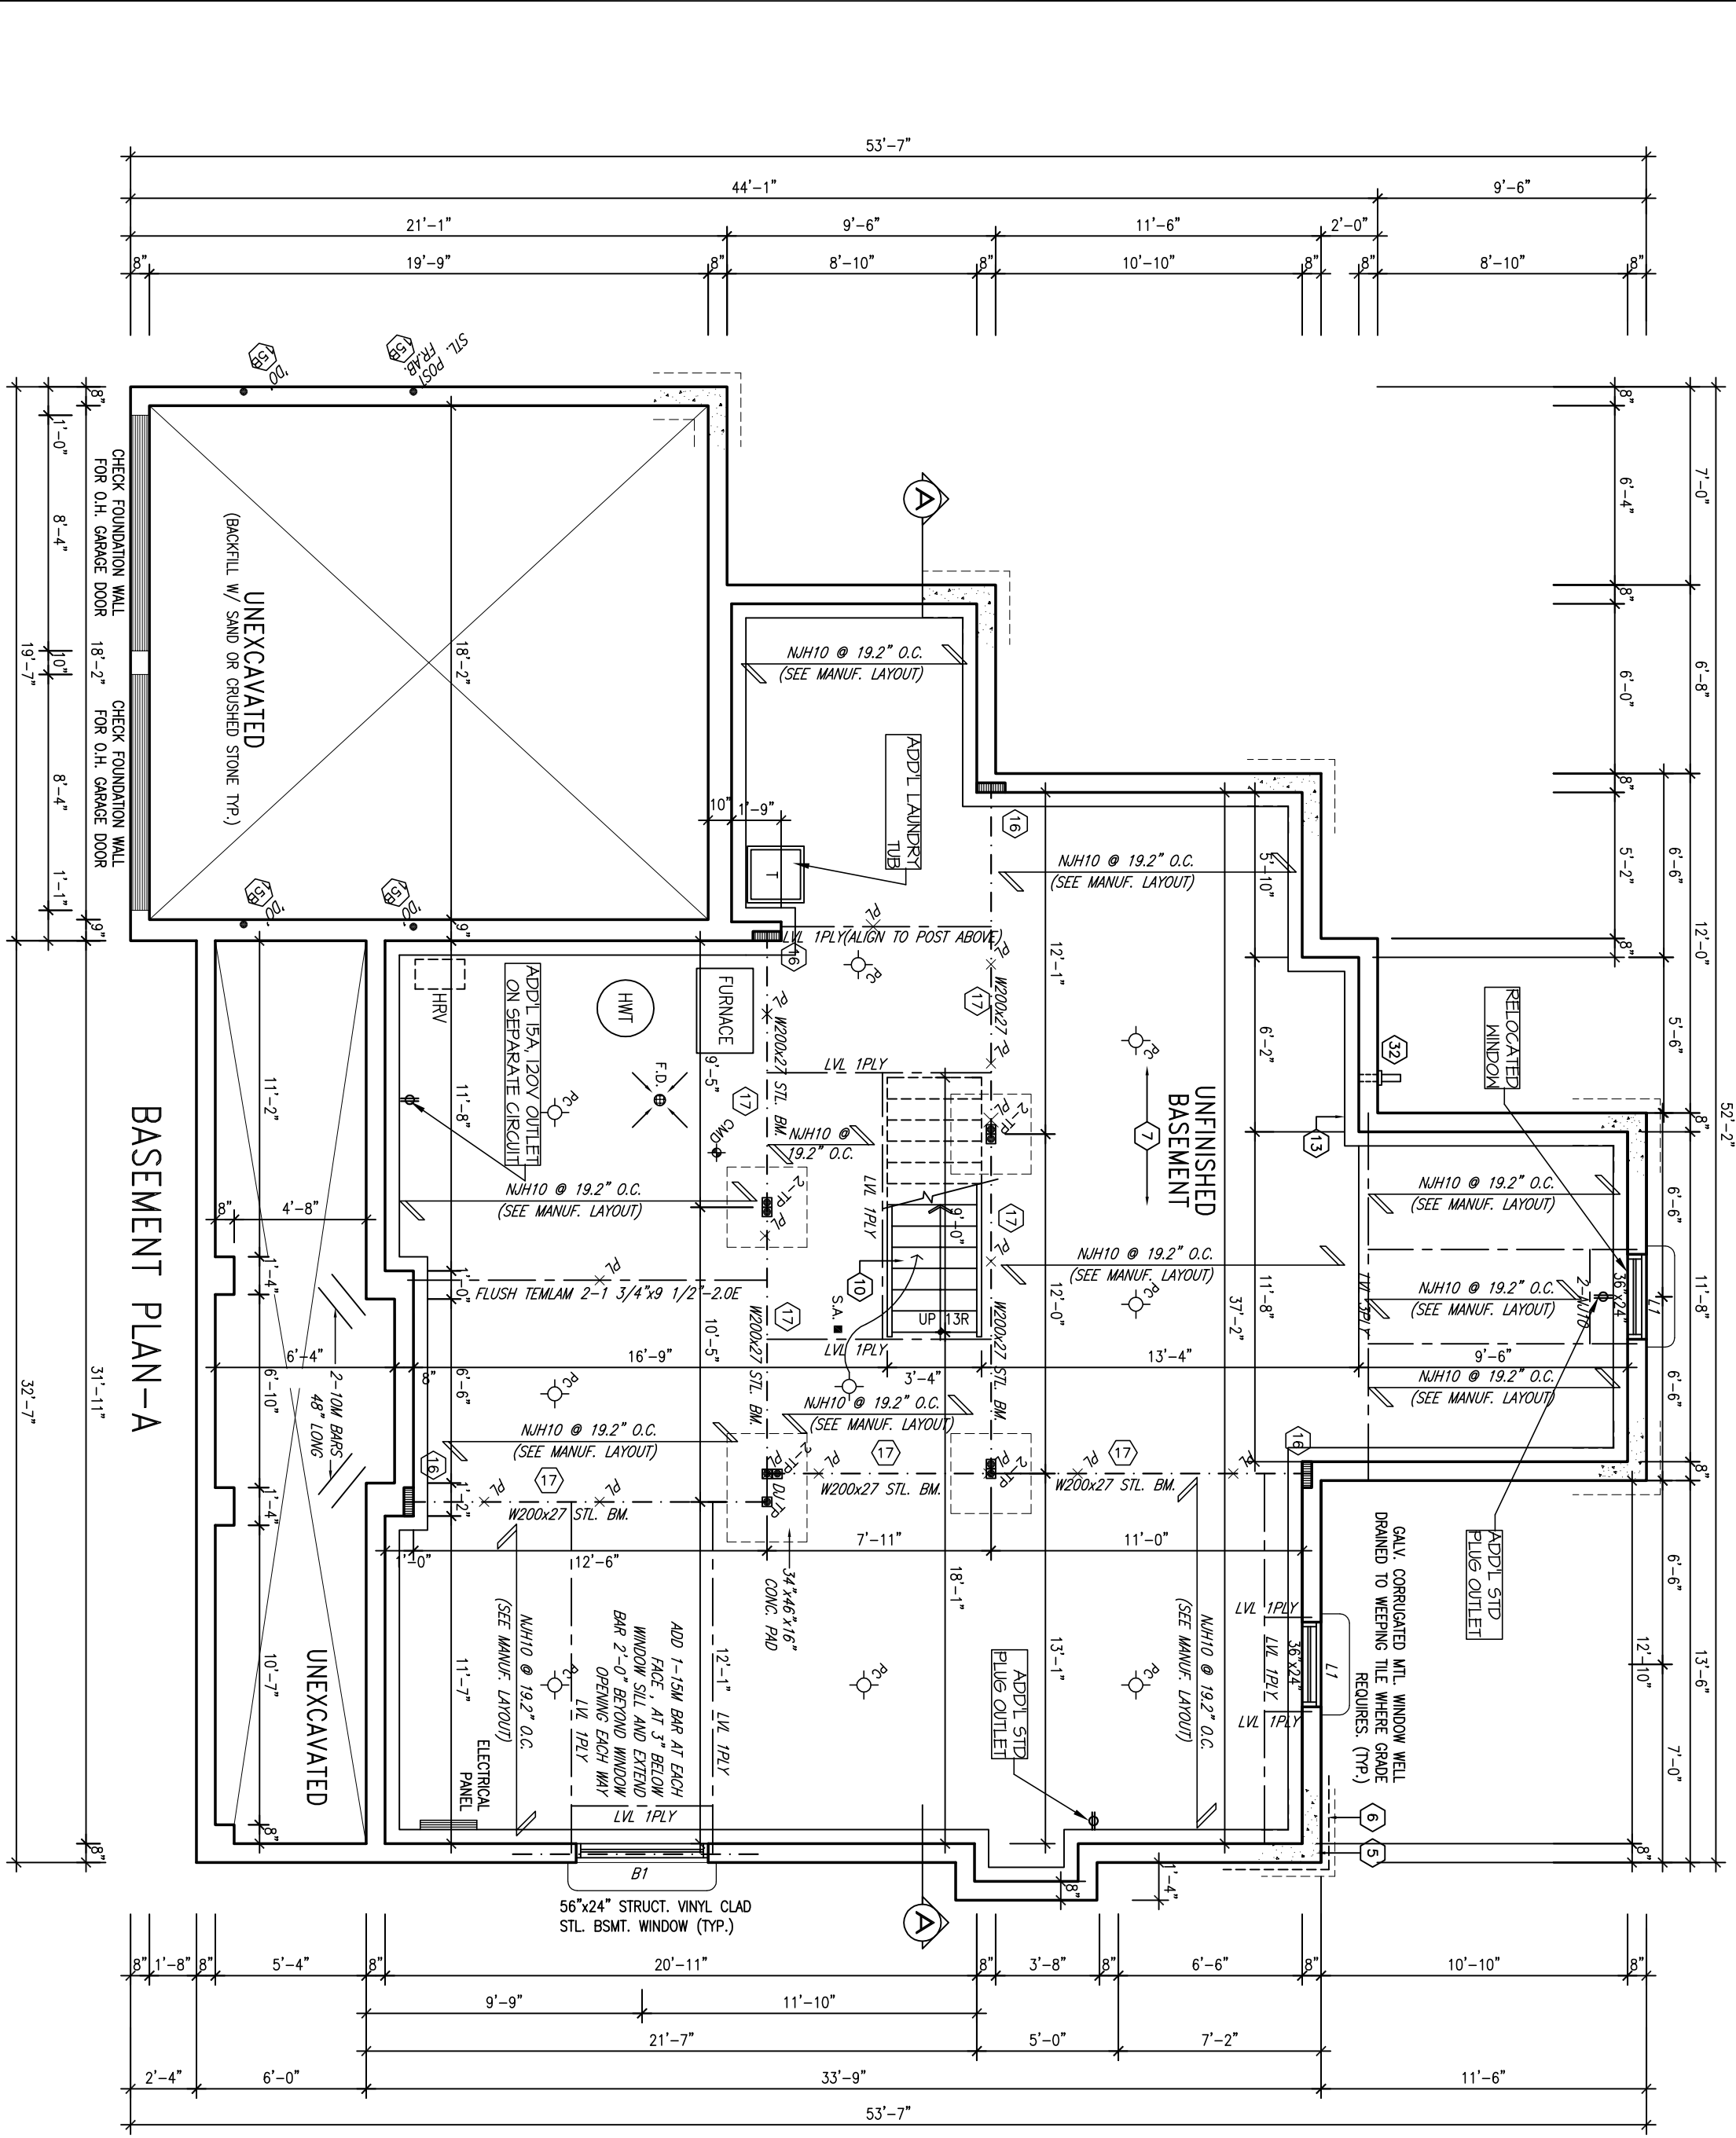

**Viljoen
Architect
Inc.**

300 A Wilson Avenue
North York, Ontario
M3H 1S8
TEL: (416) 630-2255
FAX: (416) 630-4782

BABYLONIAN-2007-A

SITE: SHADOW RIDGE2


LOT NUMBER:

69

CIVIC ADDRESS:
XXXX

No.	Description	Date	By
5	REV. AS PER CONST. SUMMARY	JUL2-14	SD
4	REV. AS PER ENGR'S REVIEW W250X33 ST. BEAM IN LIEU OF LVL	AUG1-14	SD
3	ISSUED FOR TRUSS & JOIST LAYOUT	JUL3-14	SD
2	REV. AS PER CONST. SUMMARY	JUN20-14	SD
1	PRELIMINARY SKETCH	FEB25-14	SD
REVISIONS			

footprint: S3-A	
sht. title: BASEMENT-A	
drawn by: TDS	
checked by: OF	
date: FEB. 2007	
scale: 3/16"=1'	
sheet no:	1A 6

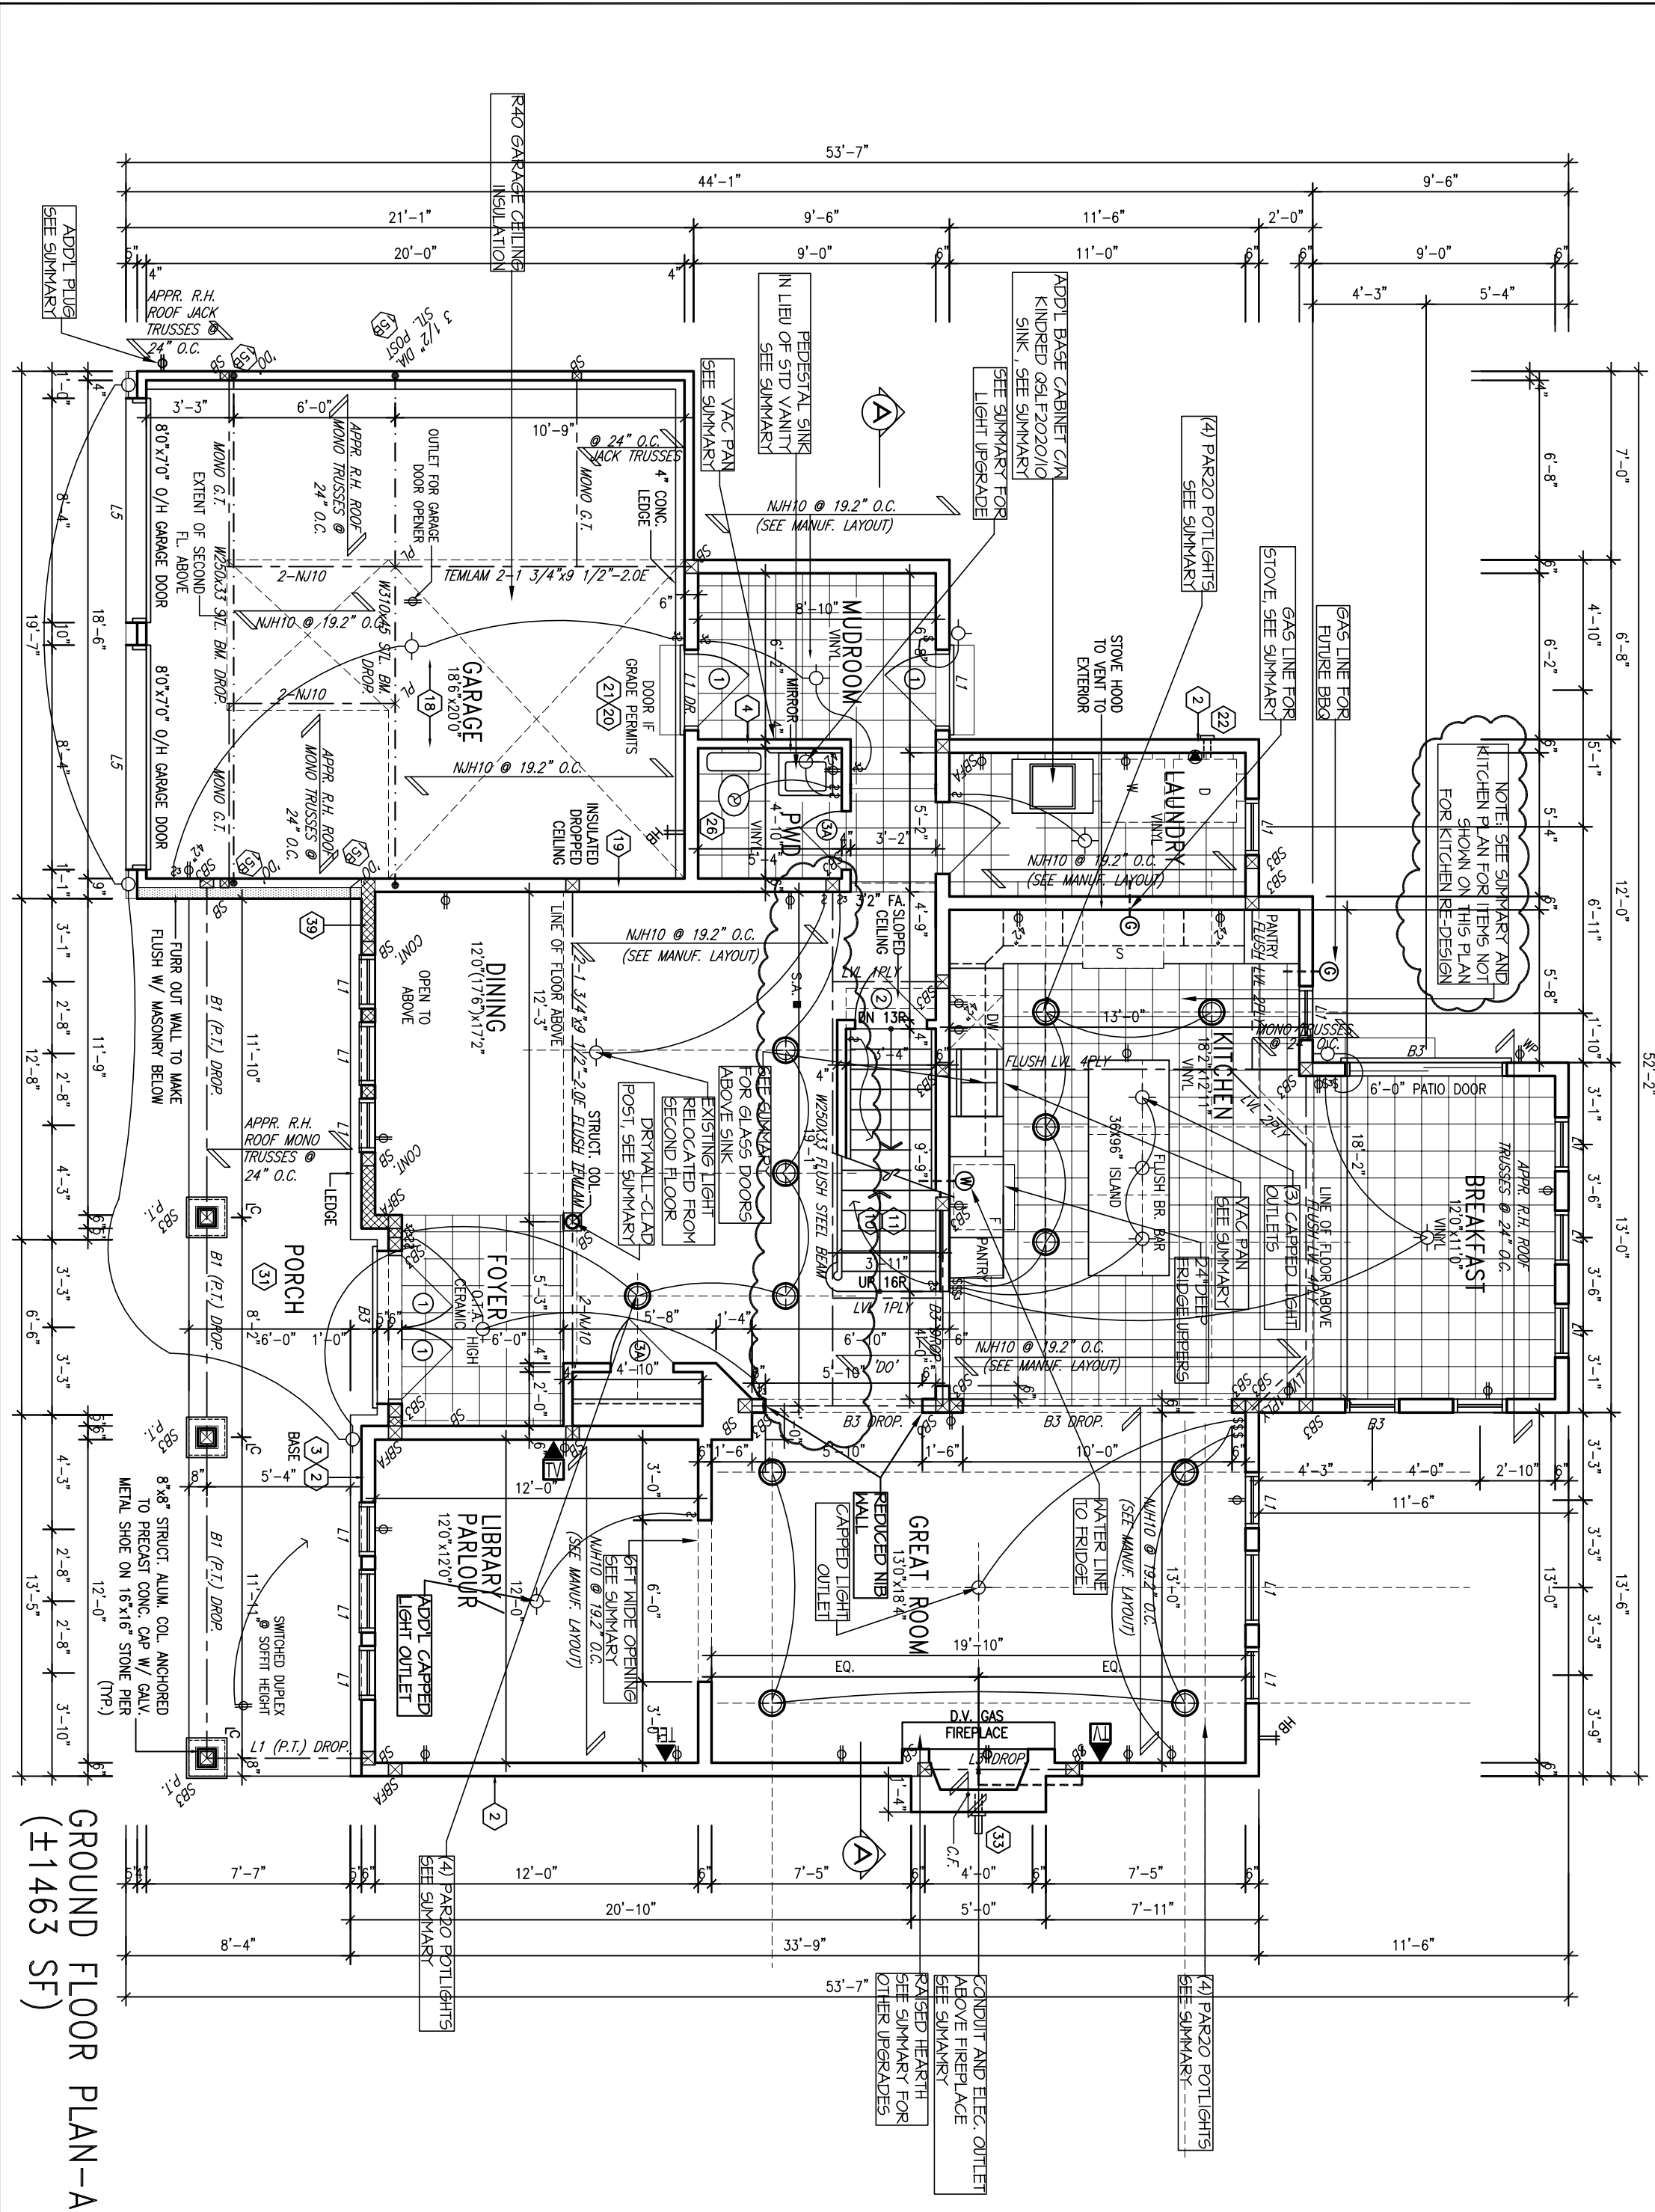

Viljoen Architect Inc.

300 A Wilson Avenue
North York, Ontario
M3H 1S8
TEL: (416) 630-2255
FAX: (416) 630-4782

BABYLONIAN-2007-A


SITE: **SHADOW RIDGE2**

LOT NUMBER: **69**

CIVIC ADDRESS: XXXX

No.	Description	Date	By
5	REV. AS PER CONST. SUMMARY	JUL2-14	SD
4	REV. AS PER ENGR'S REVIEW W250X33 ST. BEAM IN LIEU OF LVL	AUG1-14	SD
3	ISSUED FOR TRUSS & JOIST LAYOUT	JUL3-14	SD
2	REV. AS PER CONST. SUMMARY	JUN20-14	SD
1	PRELIMINARY SKETCH	FEB25-14	SD
REVISIONS			

footprint: S3-A
sh. title: GROUND FLOOR-A
drawn by: TD5
checked by: OF
date: FEB. 2007
scale: 3/16"=1'
sheet no:
2A 6

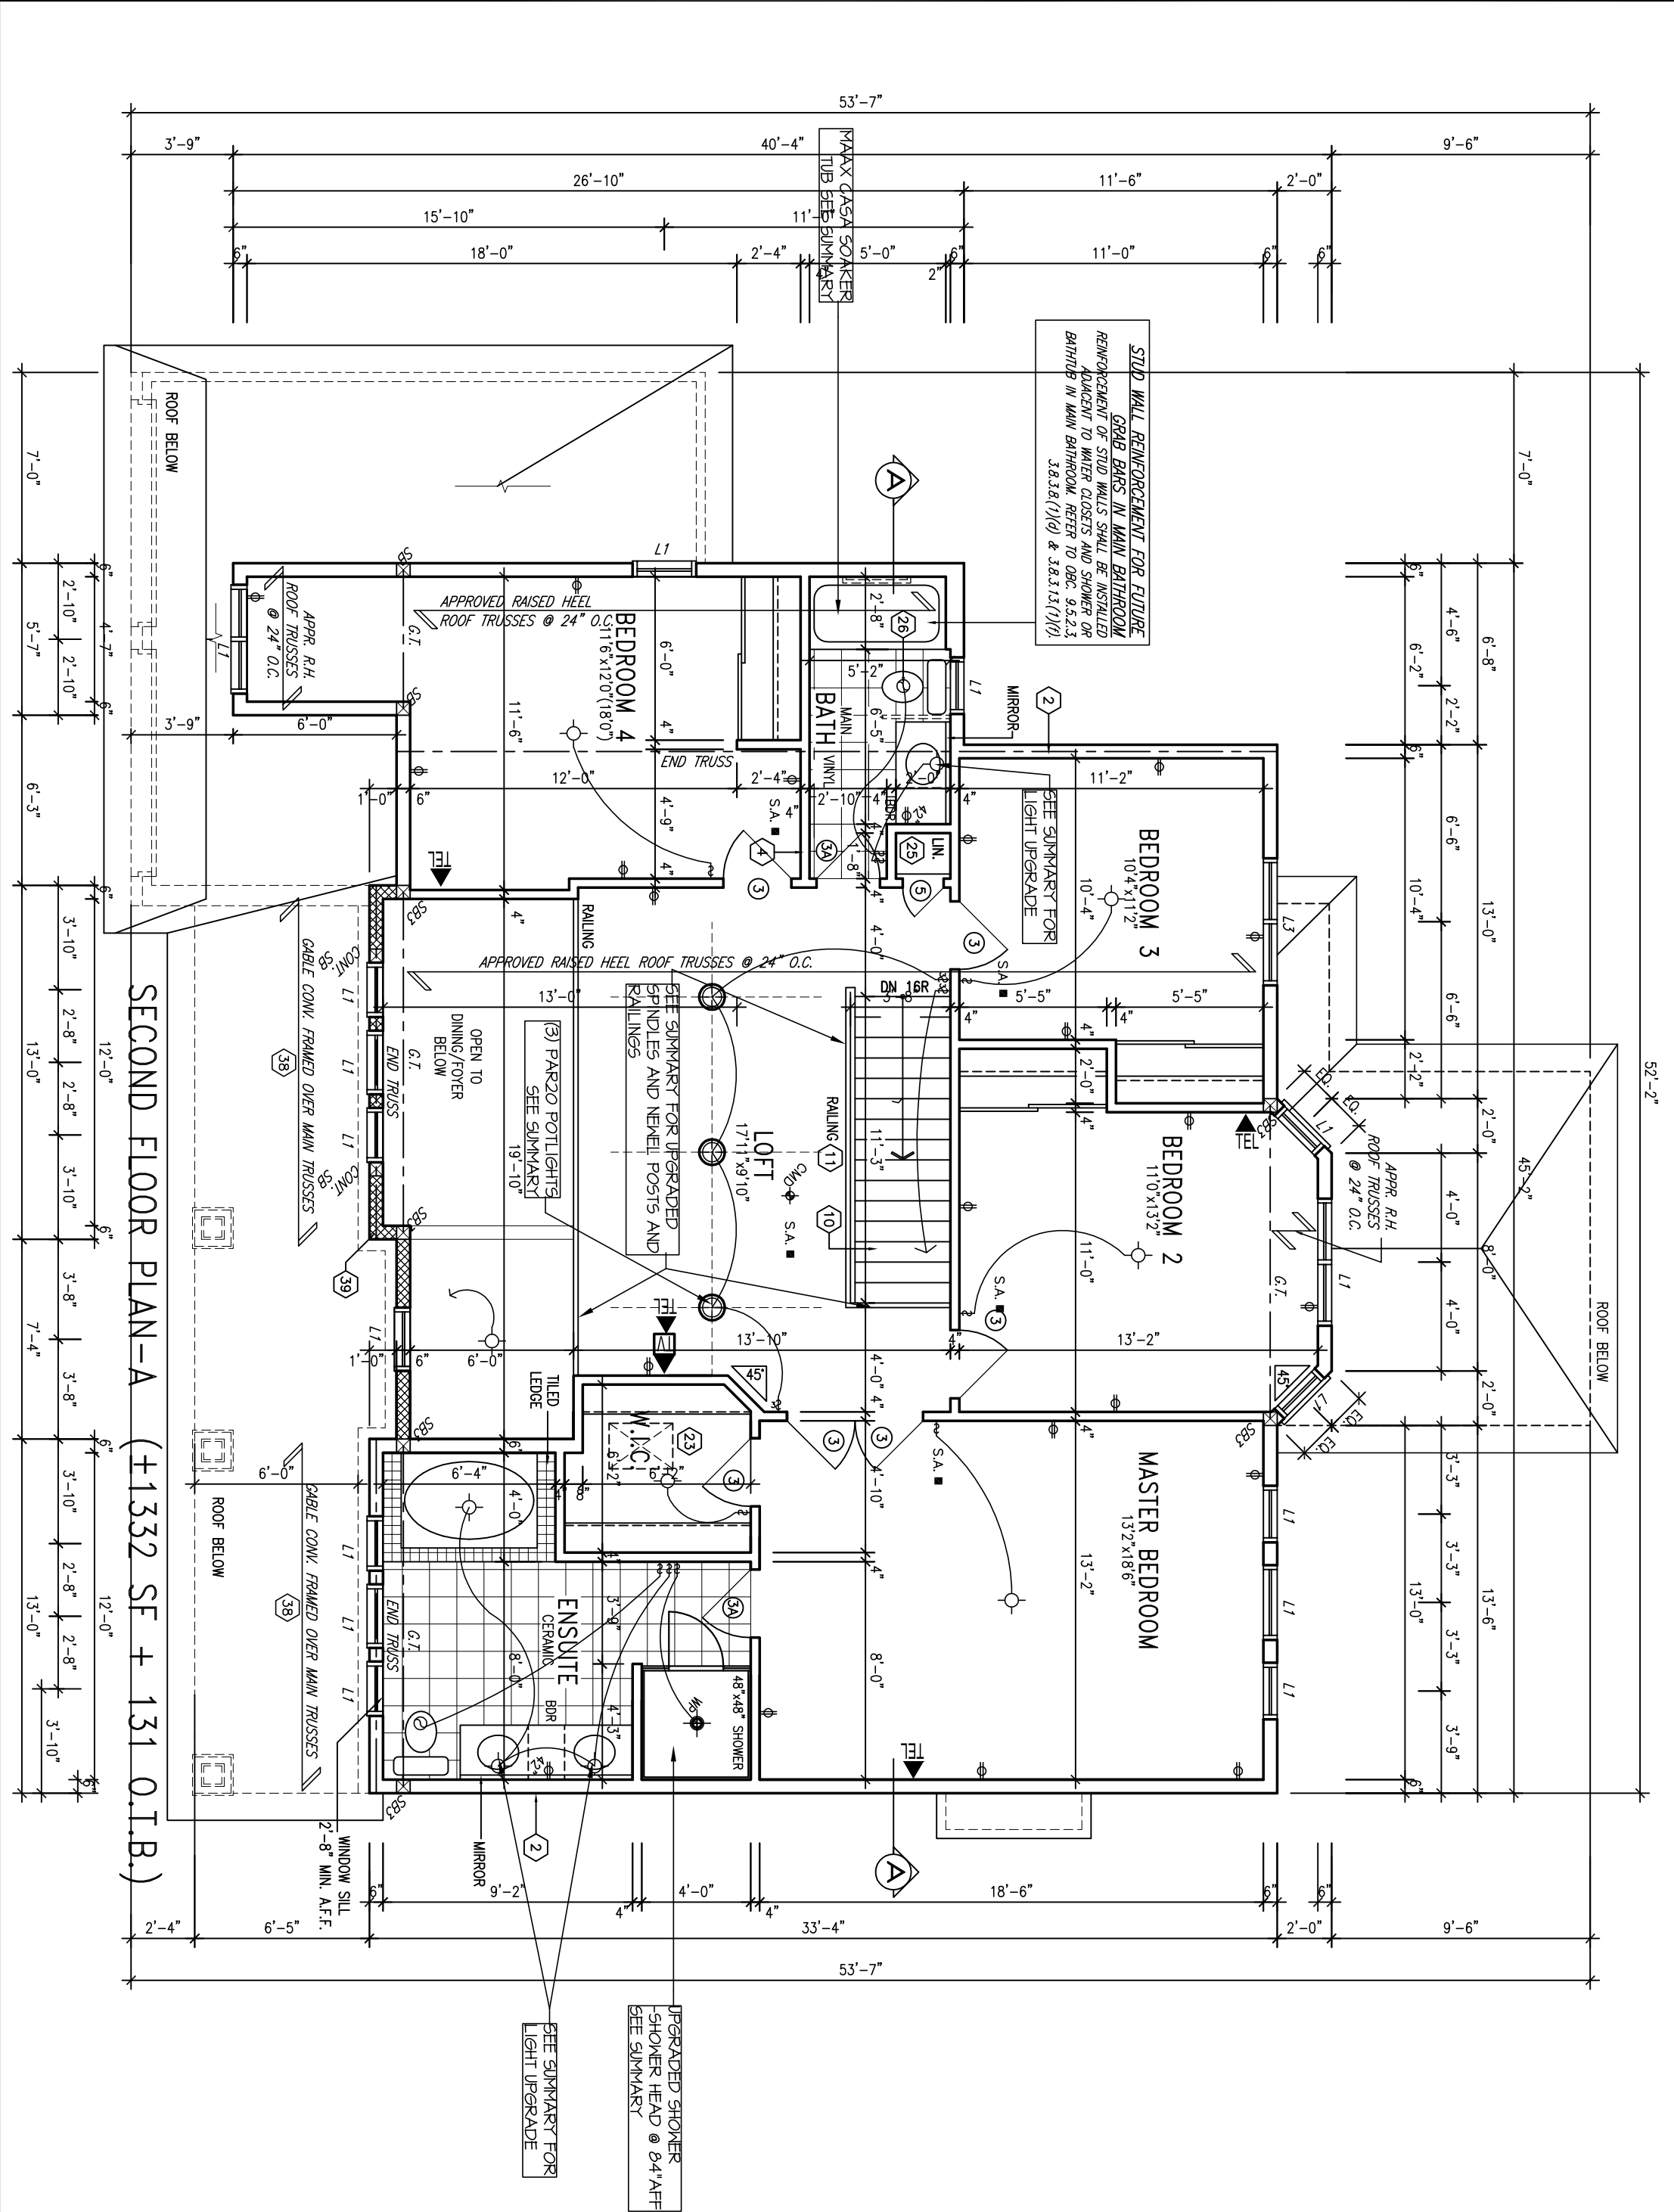

Viljoen
Architect
Inc.

300 A Wilson Avenue
North York, Ontario
M3H 1S8
TEL: (416) 630-2255
FAX: (416) 630-4782

BABYLONIAN-2007-A

SITE: SHADOW RIDGE2


LOT NUMBER:

CIVIC ADDRESS:
XXXX


69

No.	Description	Date	By
5	REV. AS PER CONST. SUMMARY	JUL2-14	SD
4	REV. AS PER ENGR'S REVIEW W250X33 ST. BEAM IN LIEU OF LVL	AUG1-14	SD
3	ISSUED FOR TRUSS & JOIST LAYOUT	JUL3-14	SD
2	REV. AS PER CONST. SUMMARY	JUN20-14	SD
1	PRELIMINARY SKETCH	FEB25-14	SD
REVISIONS			

Footprint: 53-A	
Sht. title: SECOND FLOOR-A	
drawn by: TDS	
checked by: OF	
date: FEB. 2007	
scale: 3/16"=1'	
sheet no:	3A 6

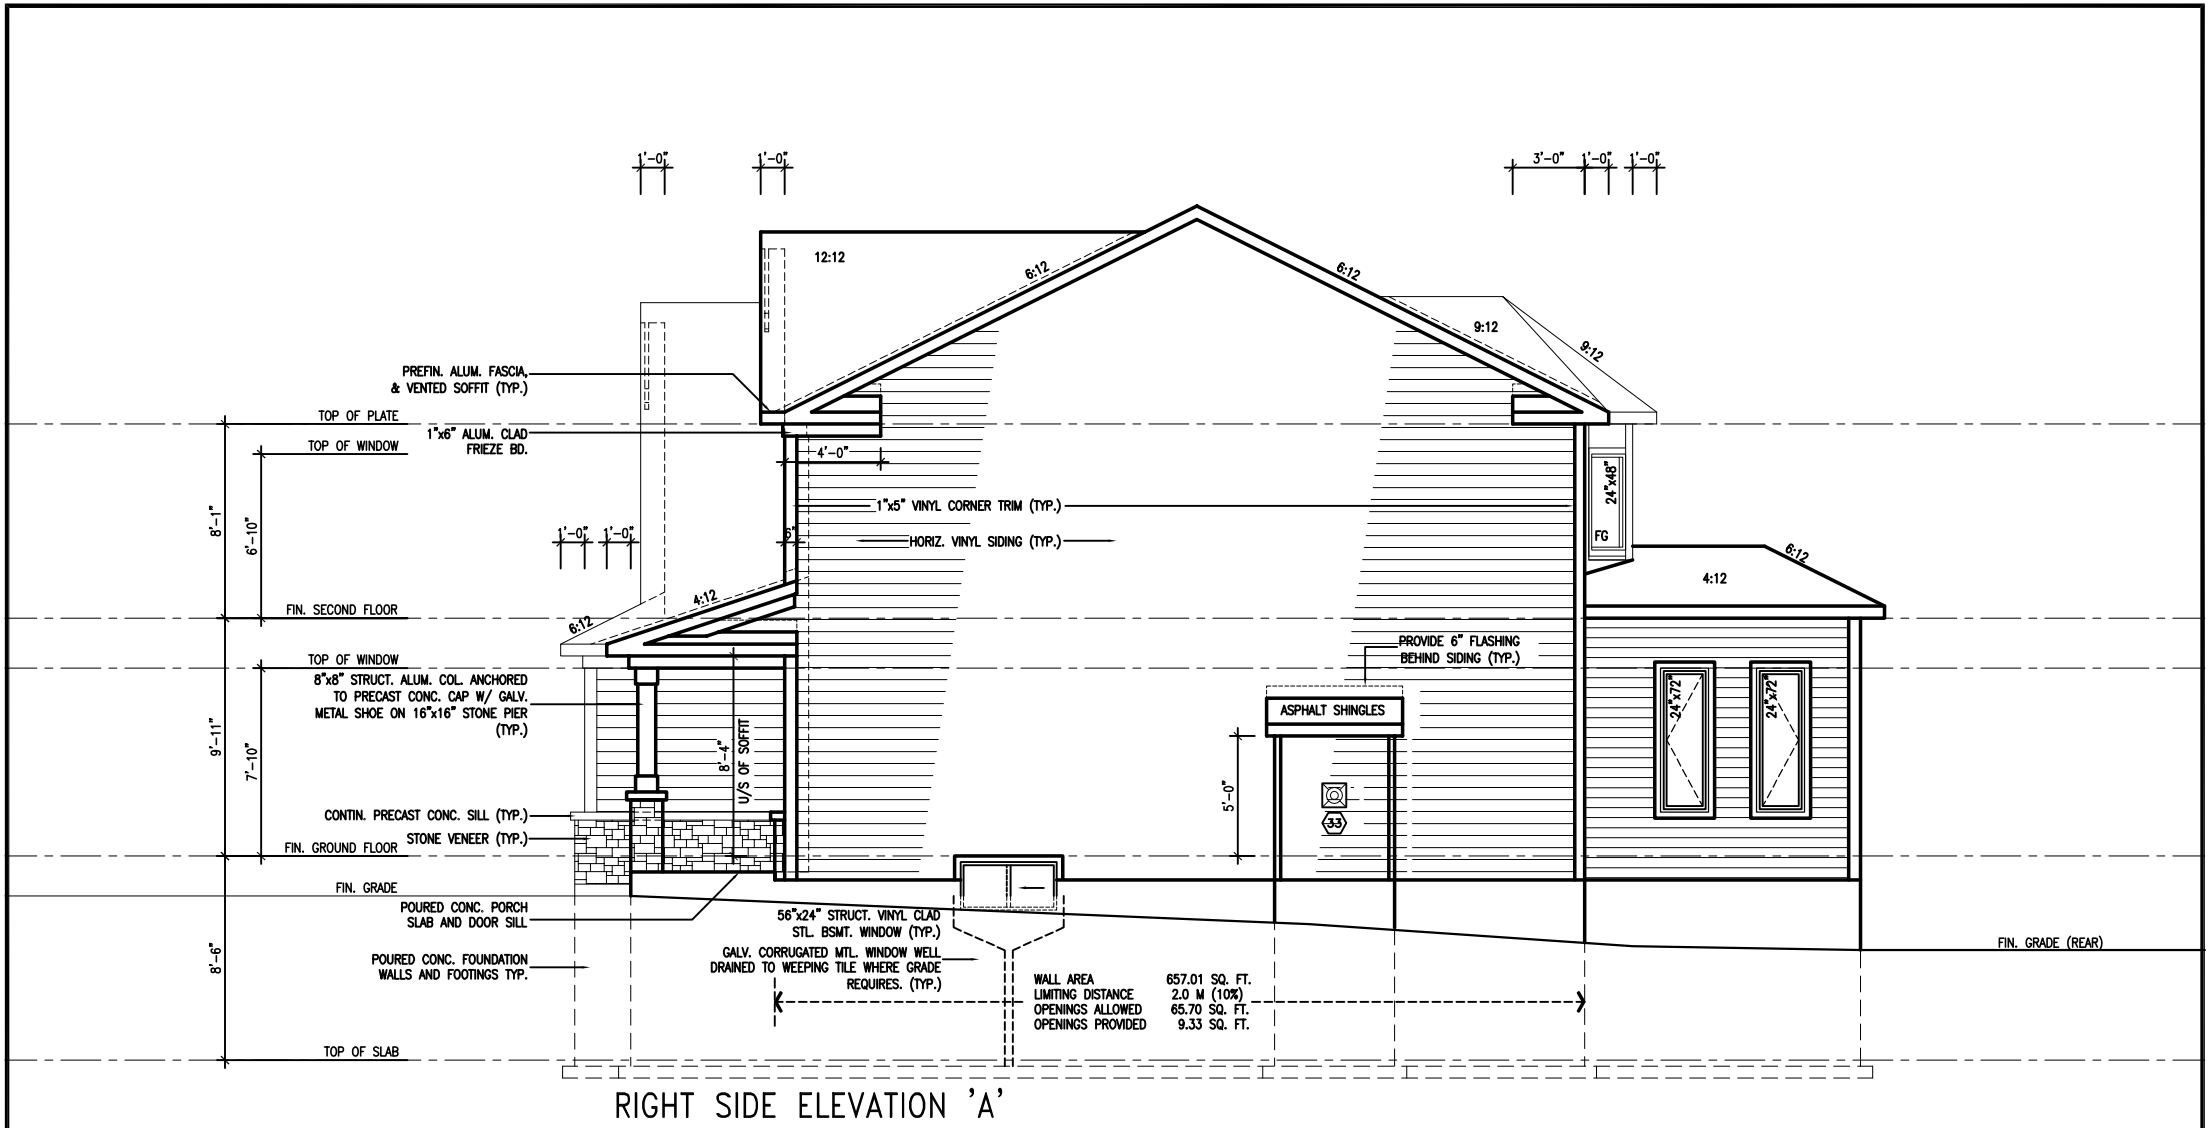

RIGHT SIDE ELEVATION 'A'

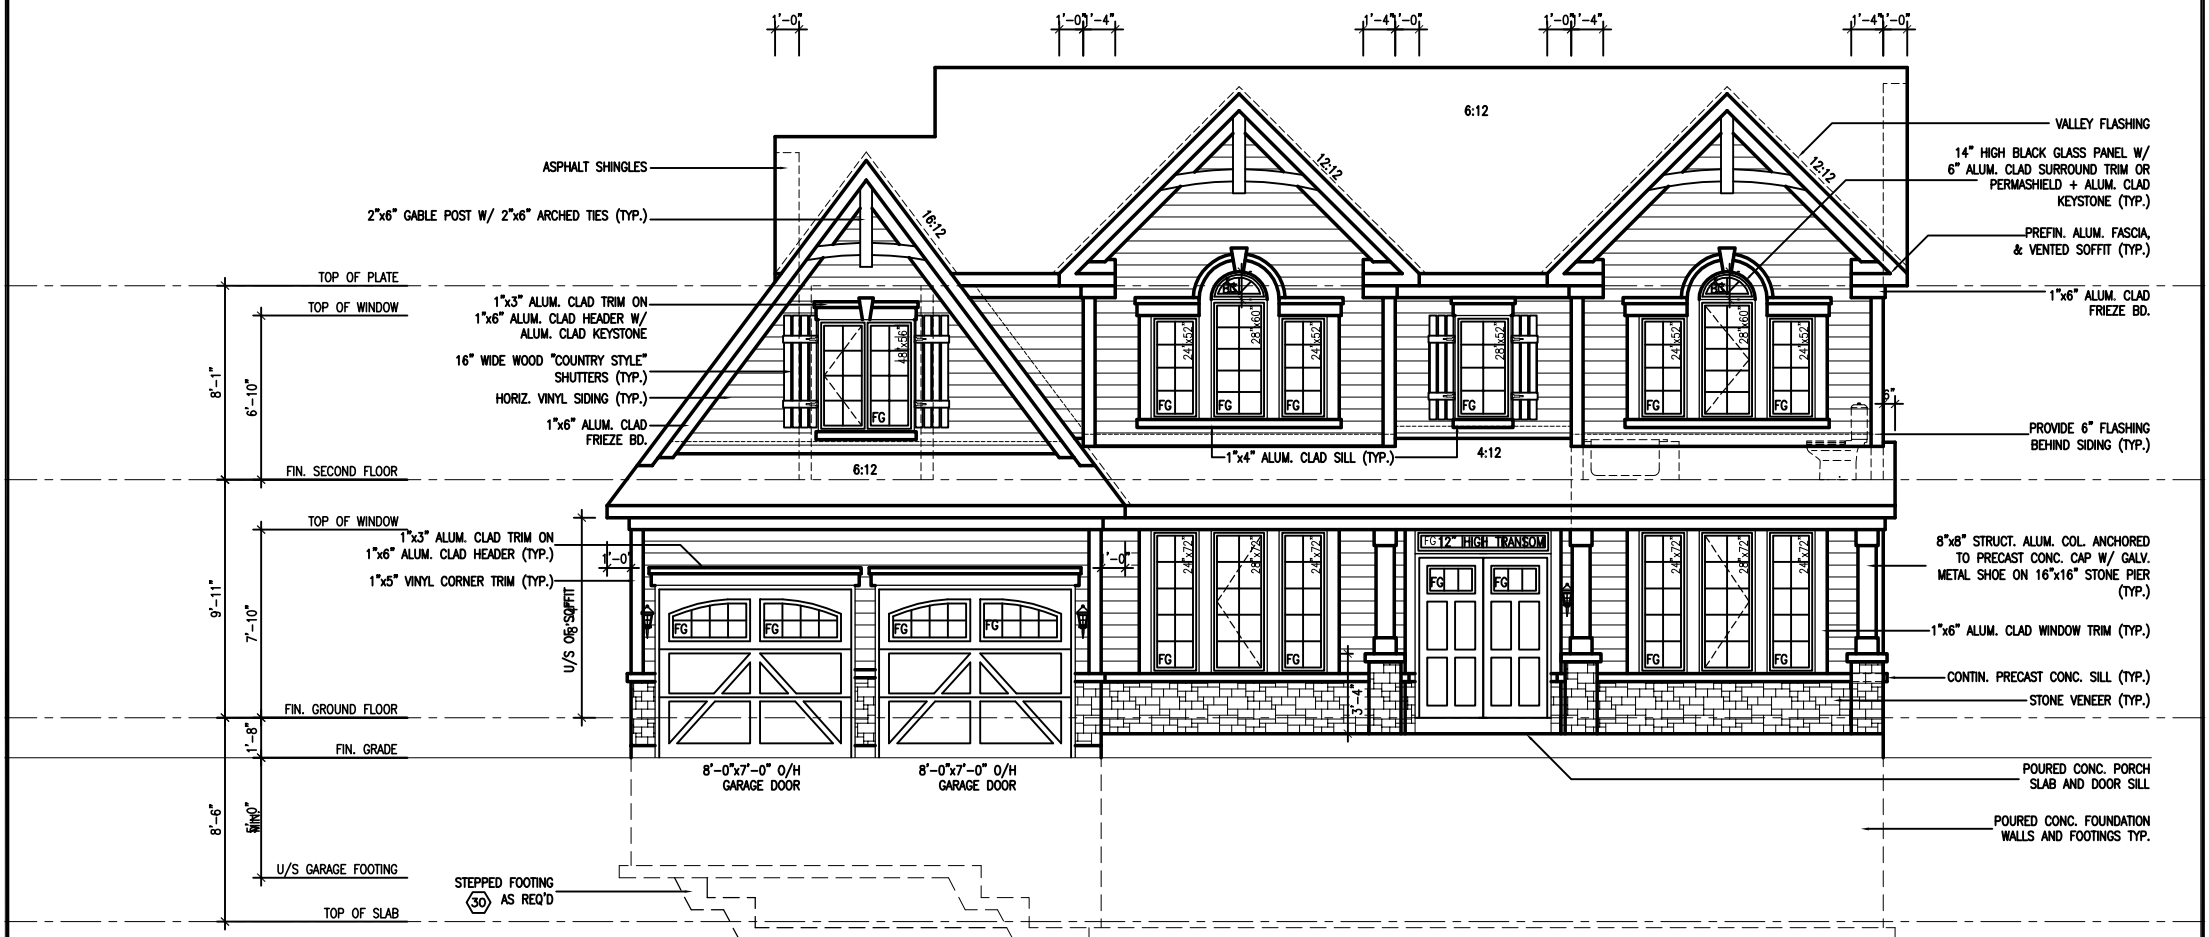

FRONT ELEVATION 'A'



Viljoen
Architect
Inc.

300 A Wilson Avenue
North York, Ontario
M3H 1S8
TEL: (416) 630-2255
FAX: (416) 630-4782

BABYLONIAN-2007-A

SITE: SHADOW RIDGE2




LOT NUMBER:

69

CIVIC ADDRESS:
XXXX

No.	Description	Date	By
5	REV. AS PER CONST. SUMMARY	JUL2-14	SD
4	REV. AS PER ENGR'S REVIEW W250X33 ST. BEAM IN LIEU OF LVL	AUG1-14	SD
3	ISSUED FOR TRUSS & JOIST LAYOUT	JUL3-14	SD
2	REV. AS PER CONST. SUMMARY	JUN20-14	SD
1	PRELIMINARY SKETCH	FEB25-14	SD

Footprint:	S3-A
sht. title:	ELEVATIONS-A
drawn by:	TDS
checked by:	OF
date:	FEB. 2007
scale:	1/8"=1'
sheet no:	4A 6

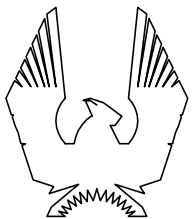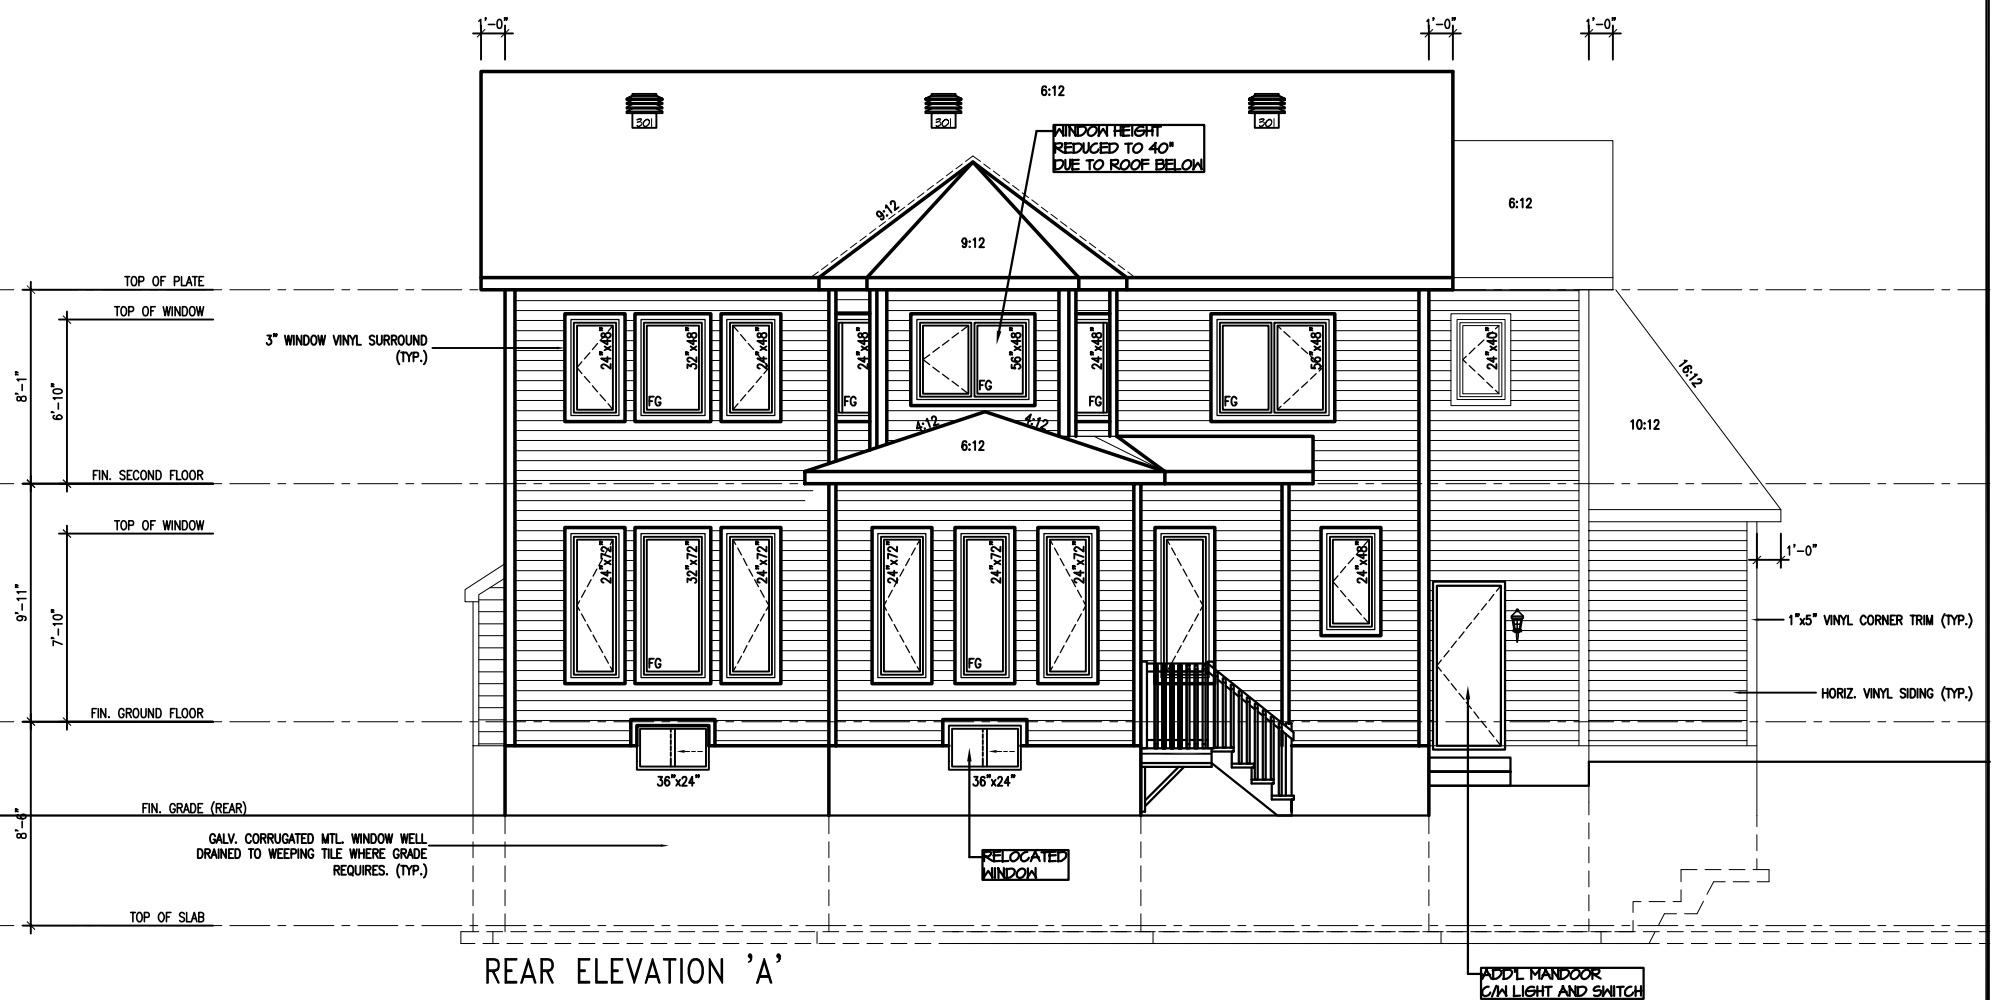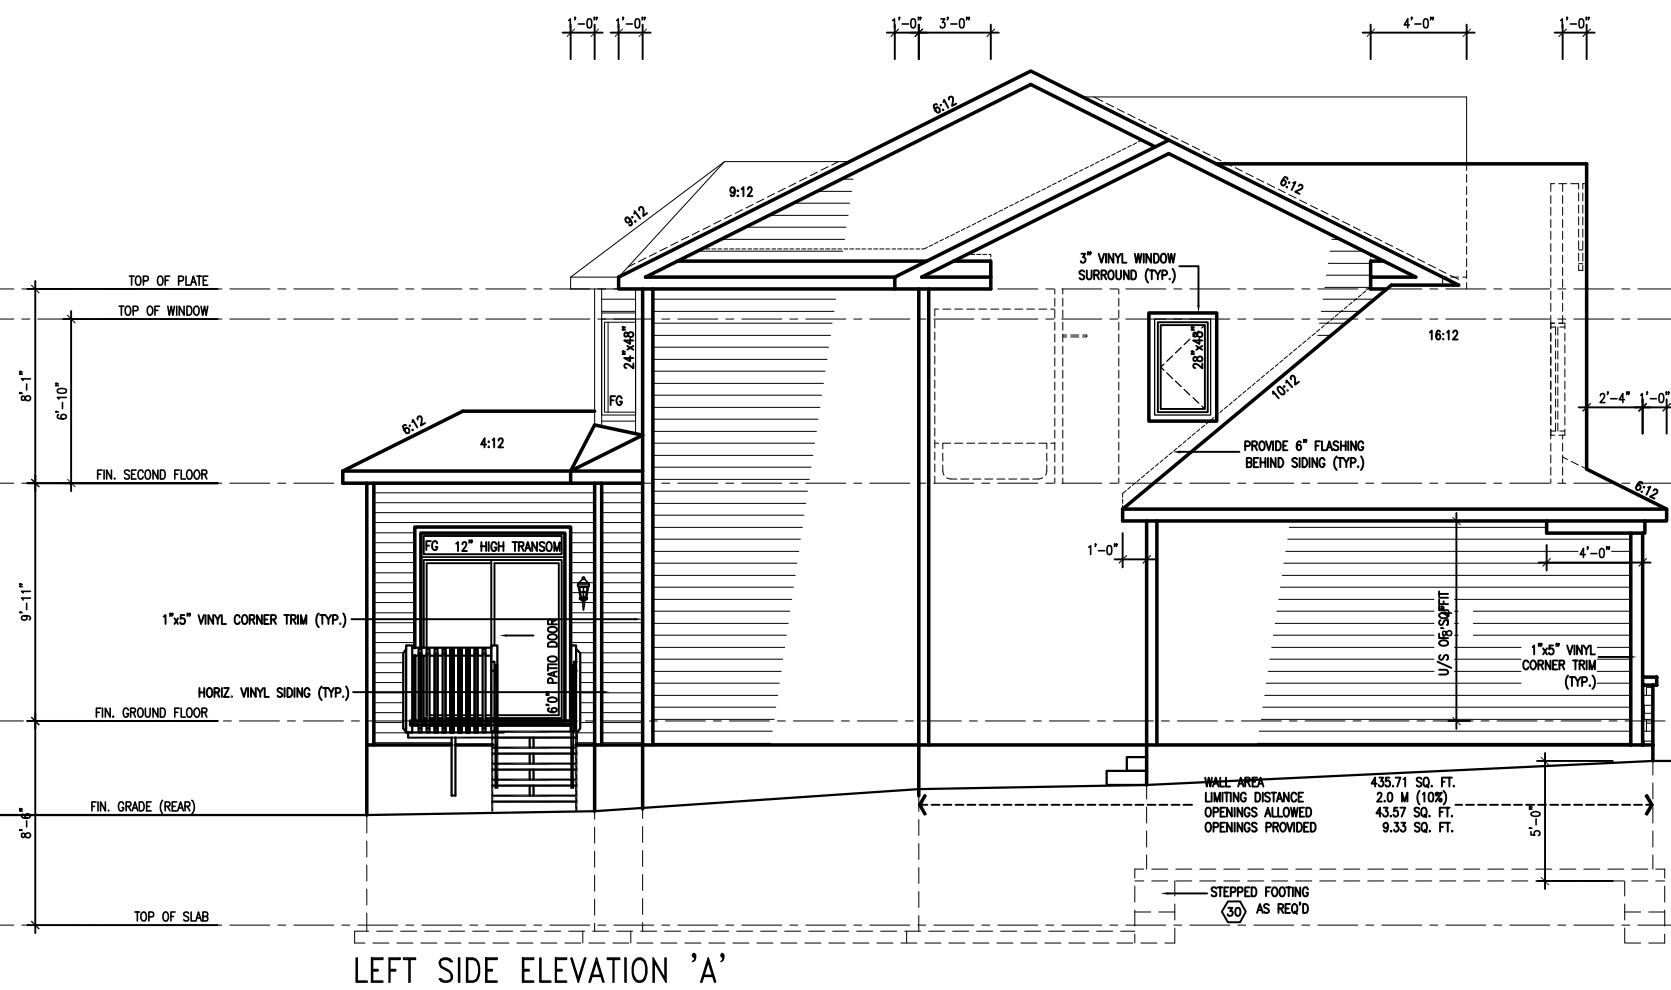

Viljoen
Architect
Inc.

300 A Wilson Avenue
North York, Ontario
M3H 1S8
TEL: (416) 630-2255
FAX: (416) 630-4782

BABYLONIAN-2007-A

SITE: SHADOW RIDGE2

LOT NUMBER:
CIVIC ADDRESS:
XXXX


69

5	REV. AS PER CONST. SUMMARY	JUL2-14	SD
4	REV. AS PER ENGR'S REVIEW W250X33 ST. BEAM IN LIEU OF LVL	AUG1-14	SD
3	ISSUED FOR TRUSS & JOIST LAYOUT	JUL3-14	SD
2	REV. AS PER CONST. SUMMARY	JUN20-14	SD
1	PRELIMINARY SKETCH	FEB25-14	SD
No.	Description	Date	By
REVISIONS			

Footprint:	S3-A
sht. title:	ELEVATIONS-A
drawn by:	TDS
checked by:	OF
date:	FEB. 2007
scale:	1/8"=1'
sheet no:	

$$\frac{5A}{6}$$

AREA CALCULATIONS		ELEV. A
GROUND FLOOR AREA	1463 SF	
SECOND FLOOR AREA	1332 SF	
SUBTOTAL	2795 SF	
DEDUCT ALL OPEN AREAS	131 SF	
TOTAL NET AREA	2664 SF	
	(247.49 m ²)	
FINISHED BSMT AREA	00 SF	
COVERAGE	1855 SF	
W/OUT PORCH	(172.33 m ²)	
COVERAGE	2057 SF	
W/ PORCH	(191.10 m ²)	

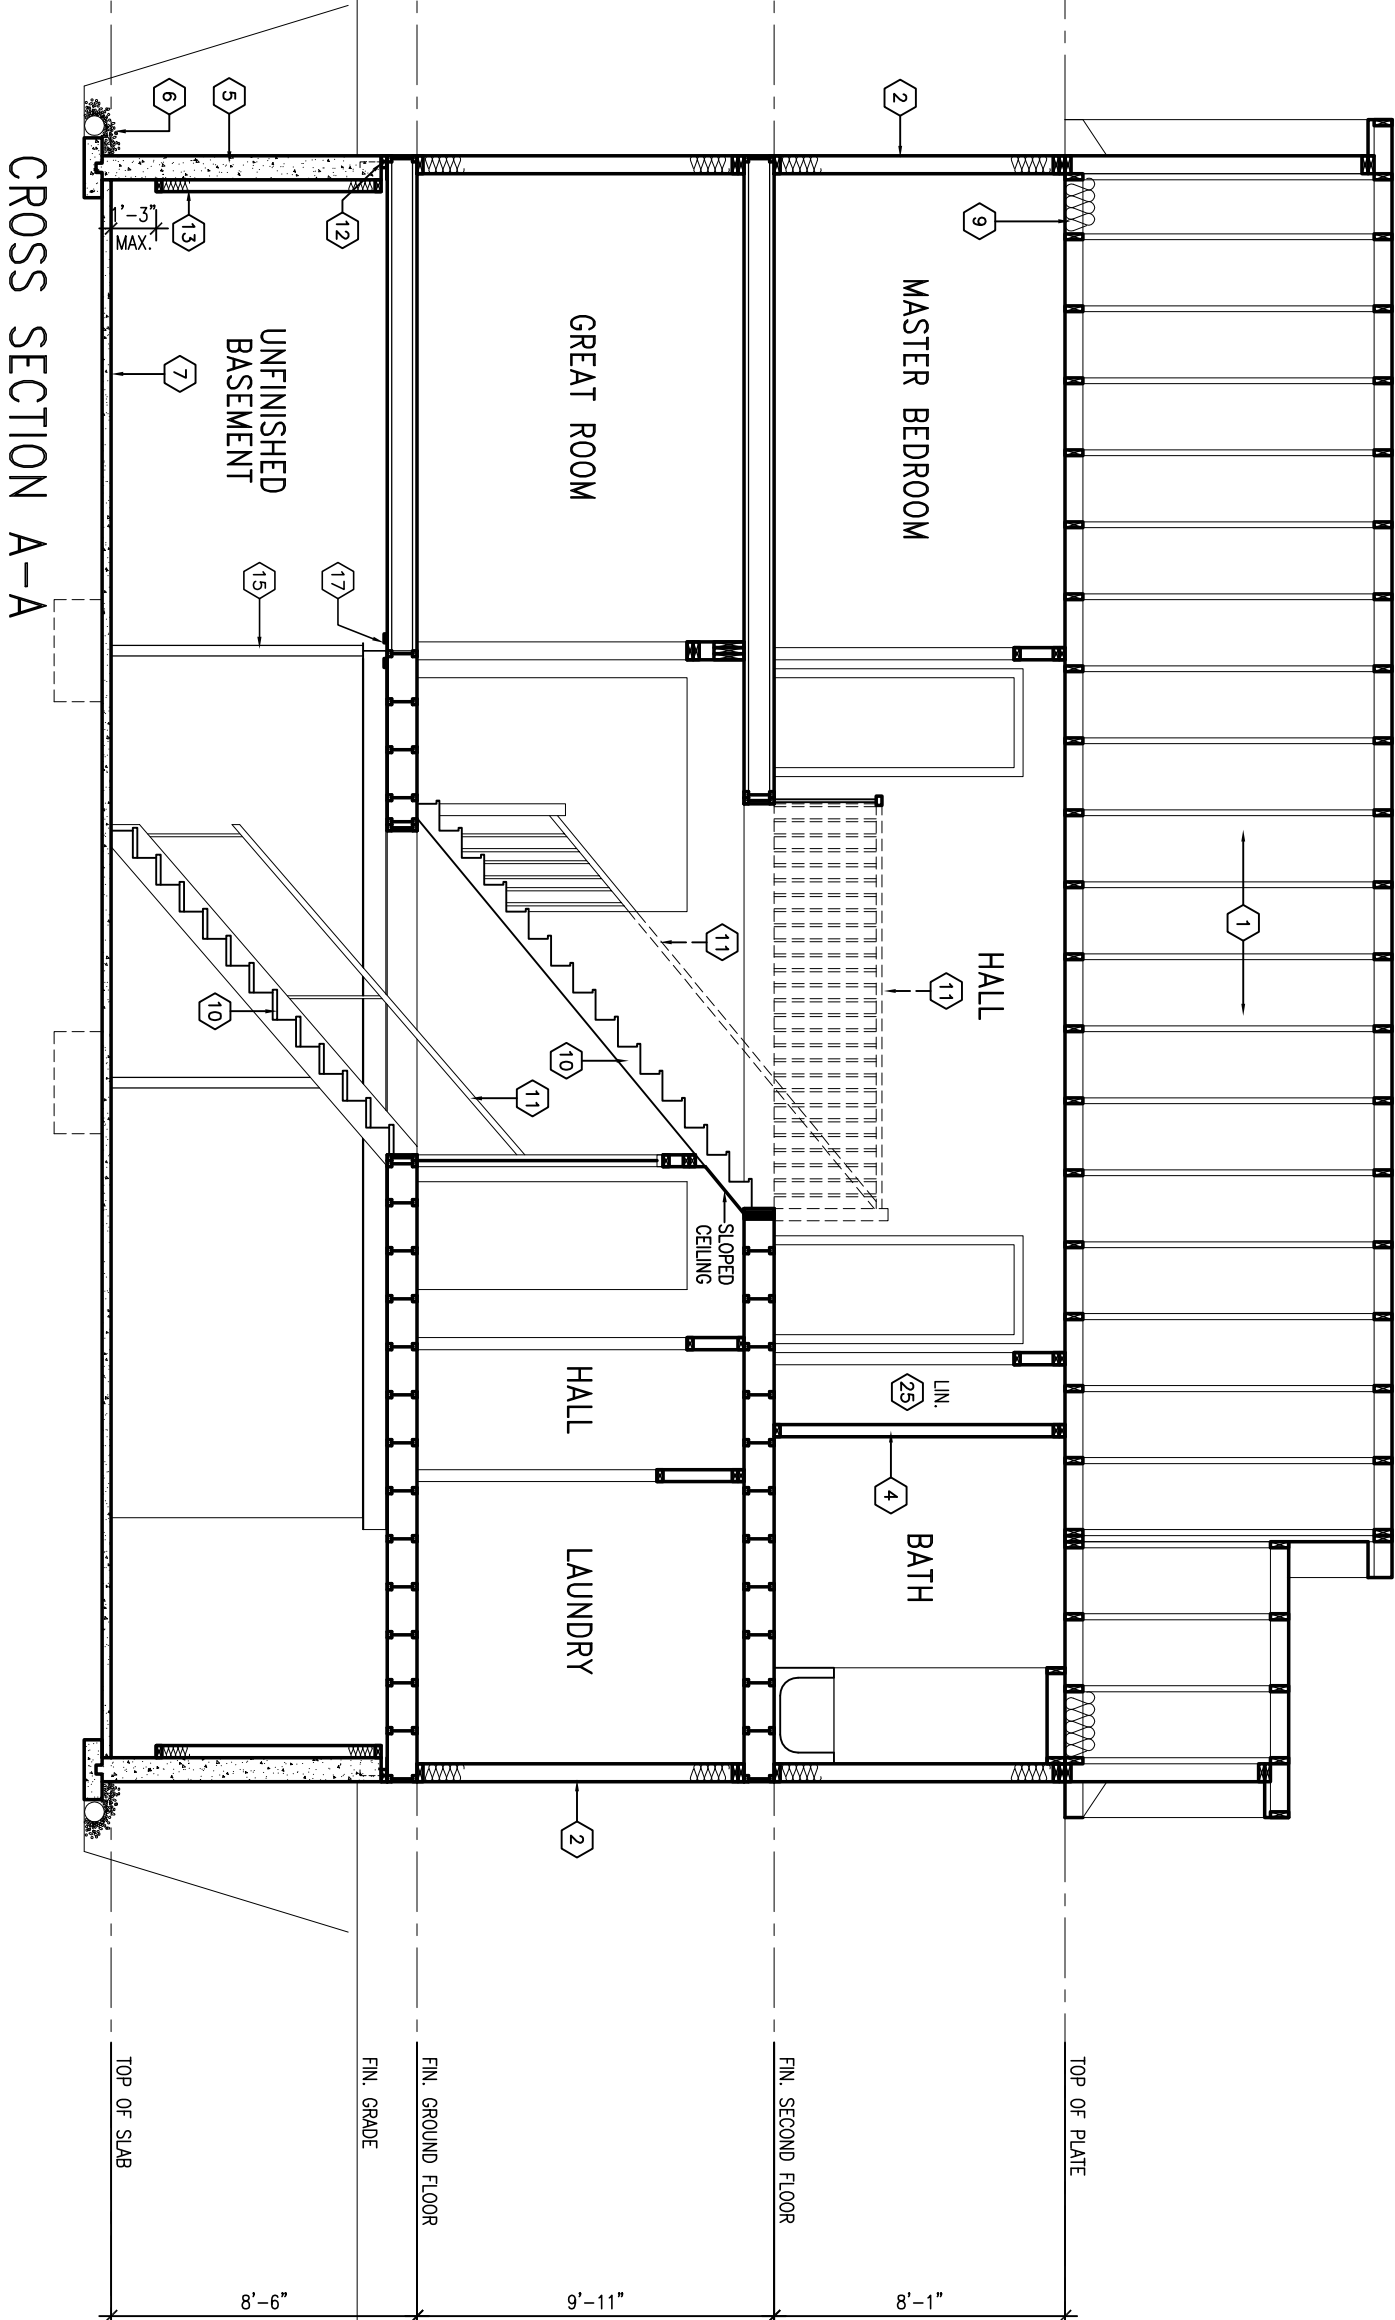

BABYLONIAN-2007

SITE: SHADOW RIDGE2


LOT NUMBER:

CIVIC ADDRESS:
XXXX

69

No.	Description	Date	By
5	REV. AS PER CONST. SUMMARY	JUL2-14	SD
4	REV. AS PER ENGR'S REVIEW W/250X33 ST. BEAM IN LIEU OF LVL	AUG1-14	SD
3	ISSUED FOR TRUSS & JOIST LAYOUT	JUL3-14	SD
2	REV. AS PER CONST. SUMMARY	JUN20-14	SD
1	PRELIMINARY SKETCH	FEB25-14	SD
REVISIONS			

footprint:	53
sht. title:	SECTION
drawn by:	TD5
checked by:	OF
date:	FEB. 2007
scale:	3/16"=1'
sheet no:	6

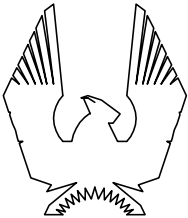

PHOENIX HOMES

Viljoen
Architect
Inc.

300 A Wilson Avenue
North York, Ontario
M3H 1S8
TEL: (416) 630-2255
FAX: (416) 630-4782