


NOTE: PROVIDE 2-10M TOP AND BOTTOM BARS ALL AROUND FOUNDATION WALLS (UNLESS NOTED OTHERWISE)

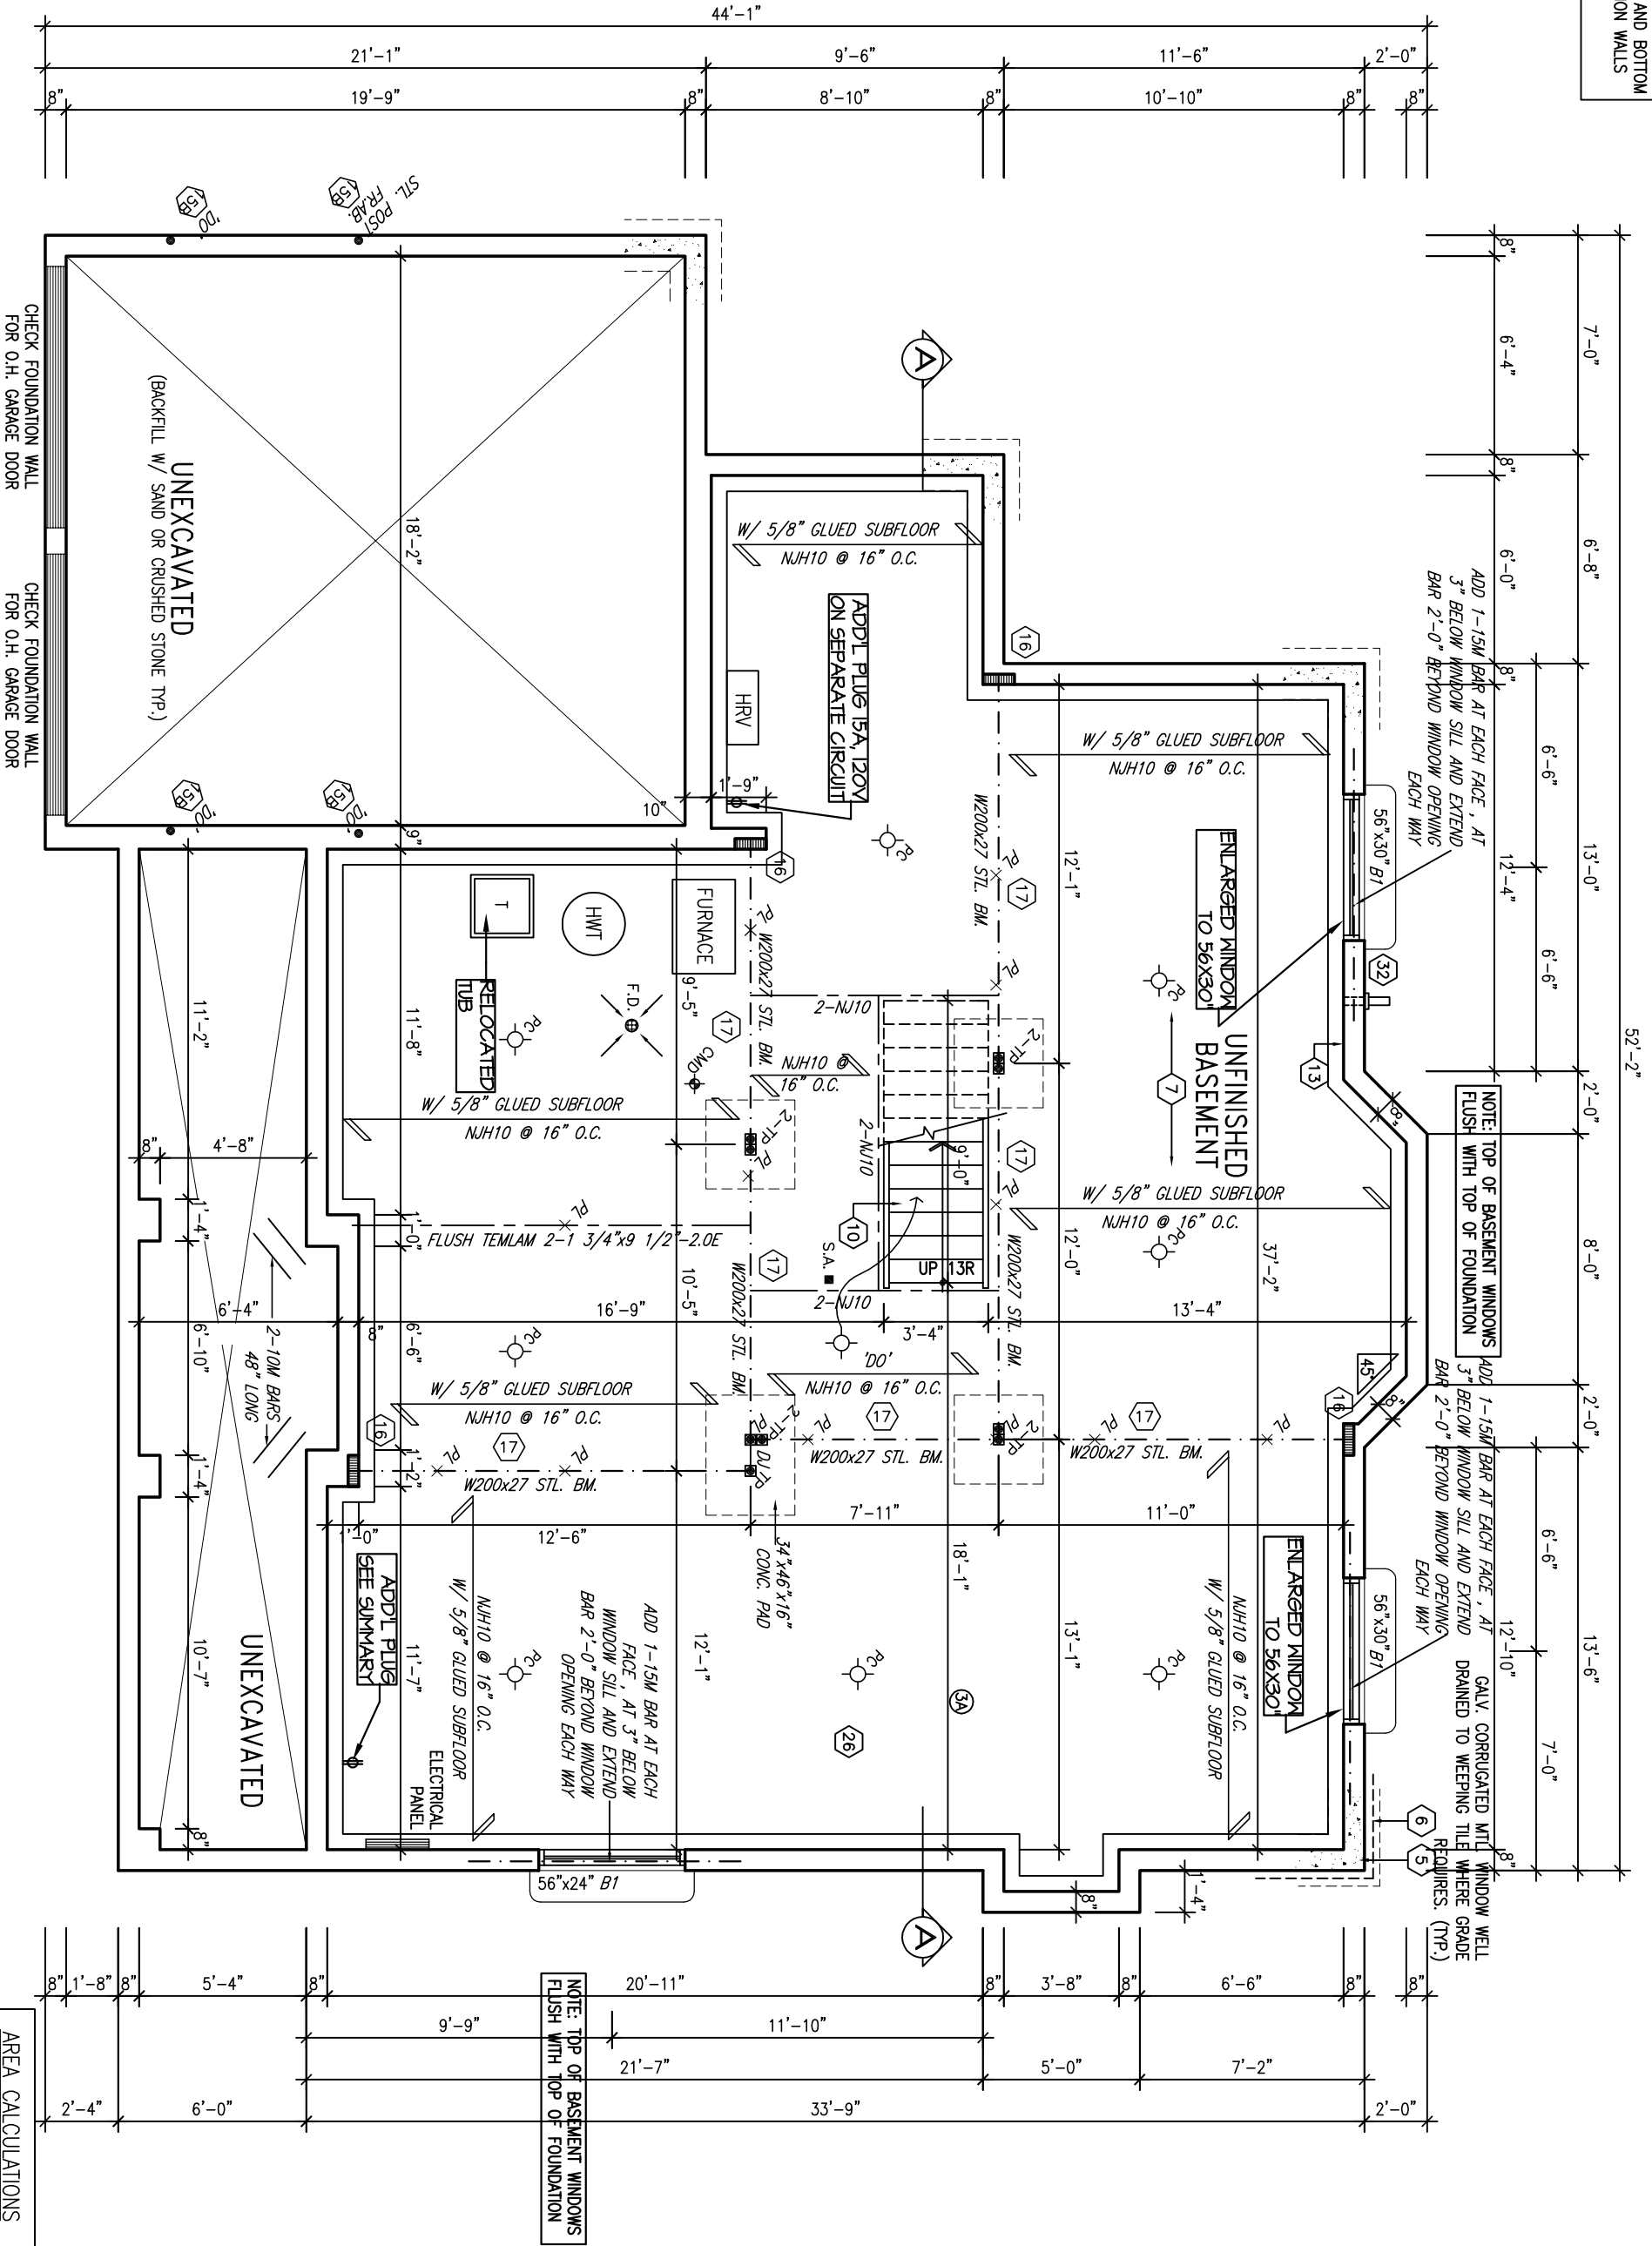

BASEMENT PLAN-A

AREA CALCULATIONS		ELEV. A
GROUND FLOOR AREA	1314 SF	
SECOND FLOOR AREA	1463 SF	
SUBTOTAL	2777 SF	
DEDUCT ALL OPEN AREAS	200 SF	
TOTAL NET AREA	2577 SF	
	(239.40 m ²)	
FINISHED BSMT AREA	00 SF	
COVERAGE	1720 SF	
W/OUT PORCH	(159.79 m ²)	
COVERAGE	1922 SF	
W/ PORCH	(178.55 m ²)	



Viljoen Architect Inc.

300 A Wilson Avenue
North York, Ontario
M3H 1S8
TEL: (416) 630-2255
FAX: (416) 630-4782

BABYLONIAN-2007-A

SITE: SHADOW RIDGE2

LOT NUMBER:


CIVIC ADDRESS:
6549 WATERDOWN ST.

71

No.	Description	Date	By
3	REV. AS PER CONST SUMMARY	NOV13-13	SD
2	REV. AS PER CONST SUMMARY	NOV4-13	SD
1	ISSUED FOR FOUNDATION ONLY	AUG1-13	SD
REVISIONS			

Footprint:	53-A
sht. title:	BASEMENT-A
drawn by:	TD5
checked by:	OF
date:	FEB. 2007
scale:	3/16"=1'
sheet no:	1A 6

GROUND FLOOR PLAN-A

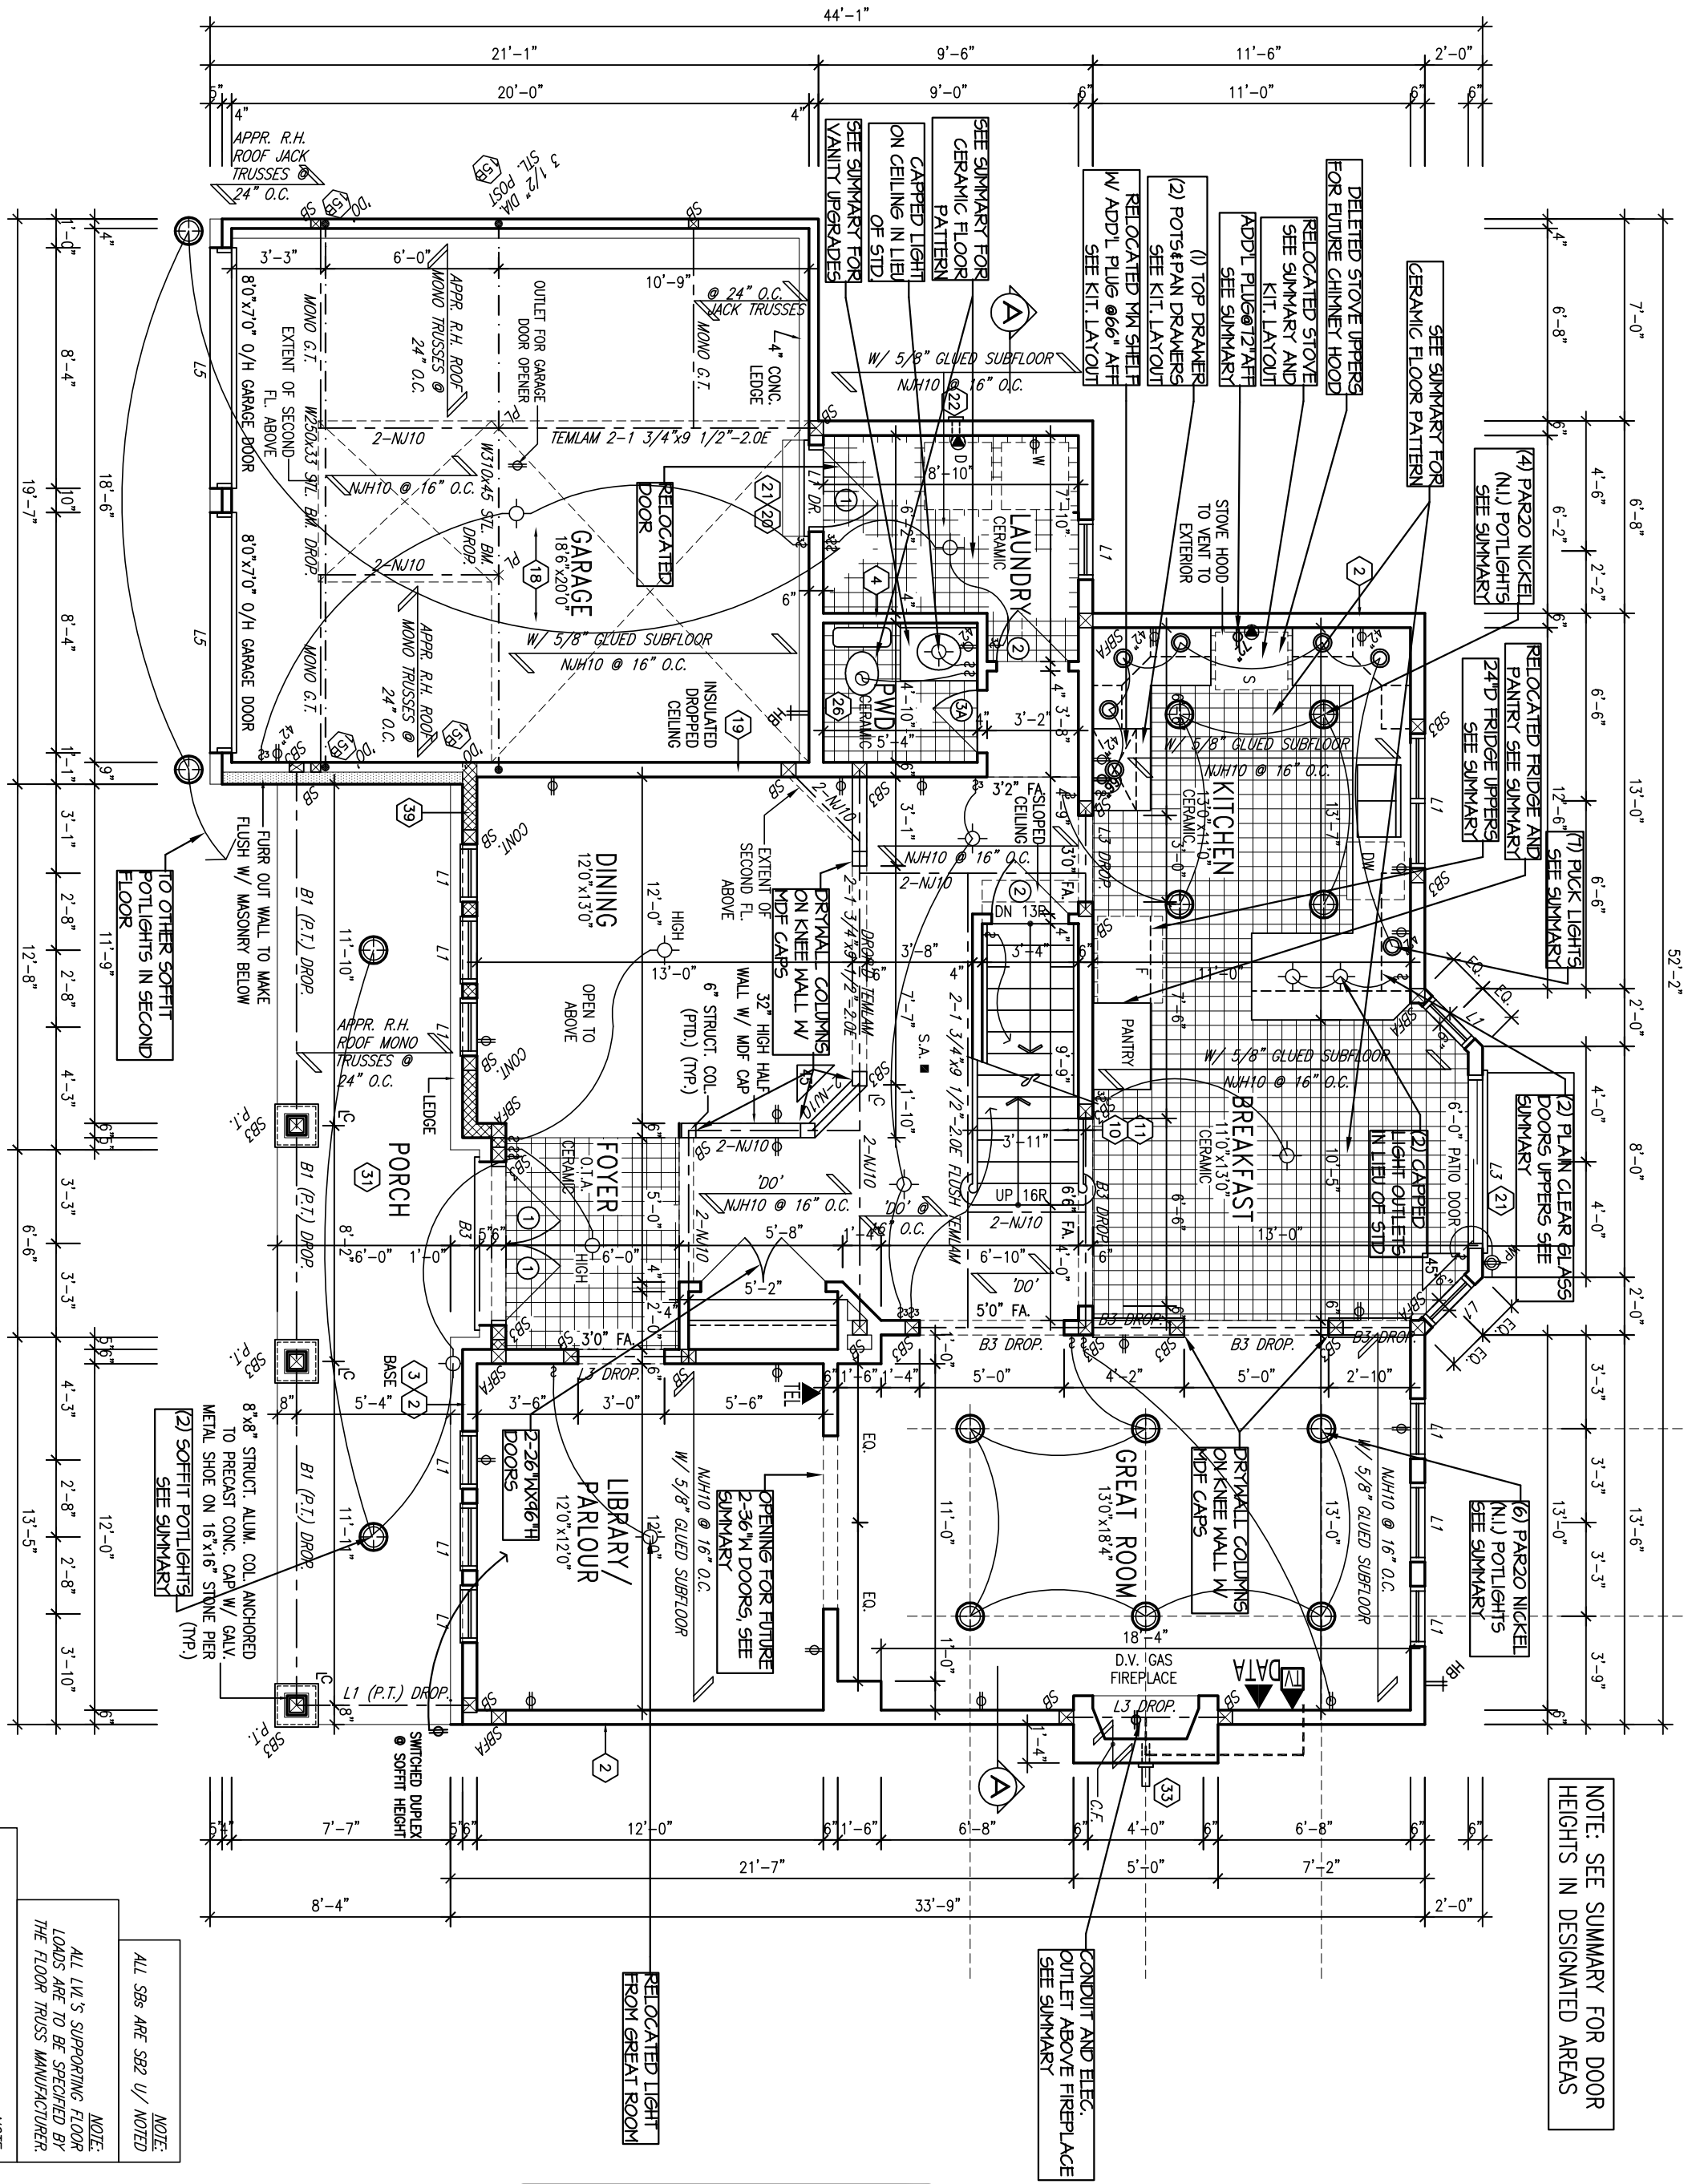


NOTE:
FLOOR FRAMING INFO REFER TO KOTT SHOP
DRAWINGS FOR ALL TRUSS-JOIST INFORMATION
AND DETAILS, UNLESS OTHERWISE NOTED.

ALL LVL'S SUPPORTING FLOOR LOADS ARE TO BE SPECIFIED BY THE FLOOR TRUSS MANUFACTURER.

NOTE:
ALL SBS ARE SB2 U/ NOTED

NOTE:

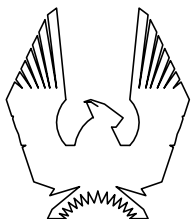

PHOENIX HOMES

Viljoen
Architect
Inc.

300 A Wilson Avenue
North York, Ontario
M3H 1S8
TEL: (416) 630-2255
FAX: (416) 630-4782

BABYLONIAN-2007-A

SITE: SHADOW RIDGE2

LOT NUMBER:


CIVIC ADDRESS:
6549 WATERDOWN ST.

71

3	REV. AS PER CONST SUMMARY	NOV13-13	SD
2	REV. AS PER CONST SUMMARY	NOV4-13	SD
1	ISSUED FOR FOUNDATION ONLY	AUG1-13	SD
No.	Description	Date	By
REVISIONS			

footprint:	S3-A
sht. title:	GROUND FLOOR-A
drawn by:	TDS
checked by:	OF
date:	FEB. 2007
scale:	3/16"=1'
sheet no:	

$$\frac{2A}{6}$$

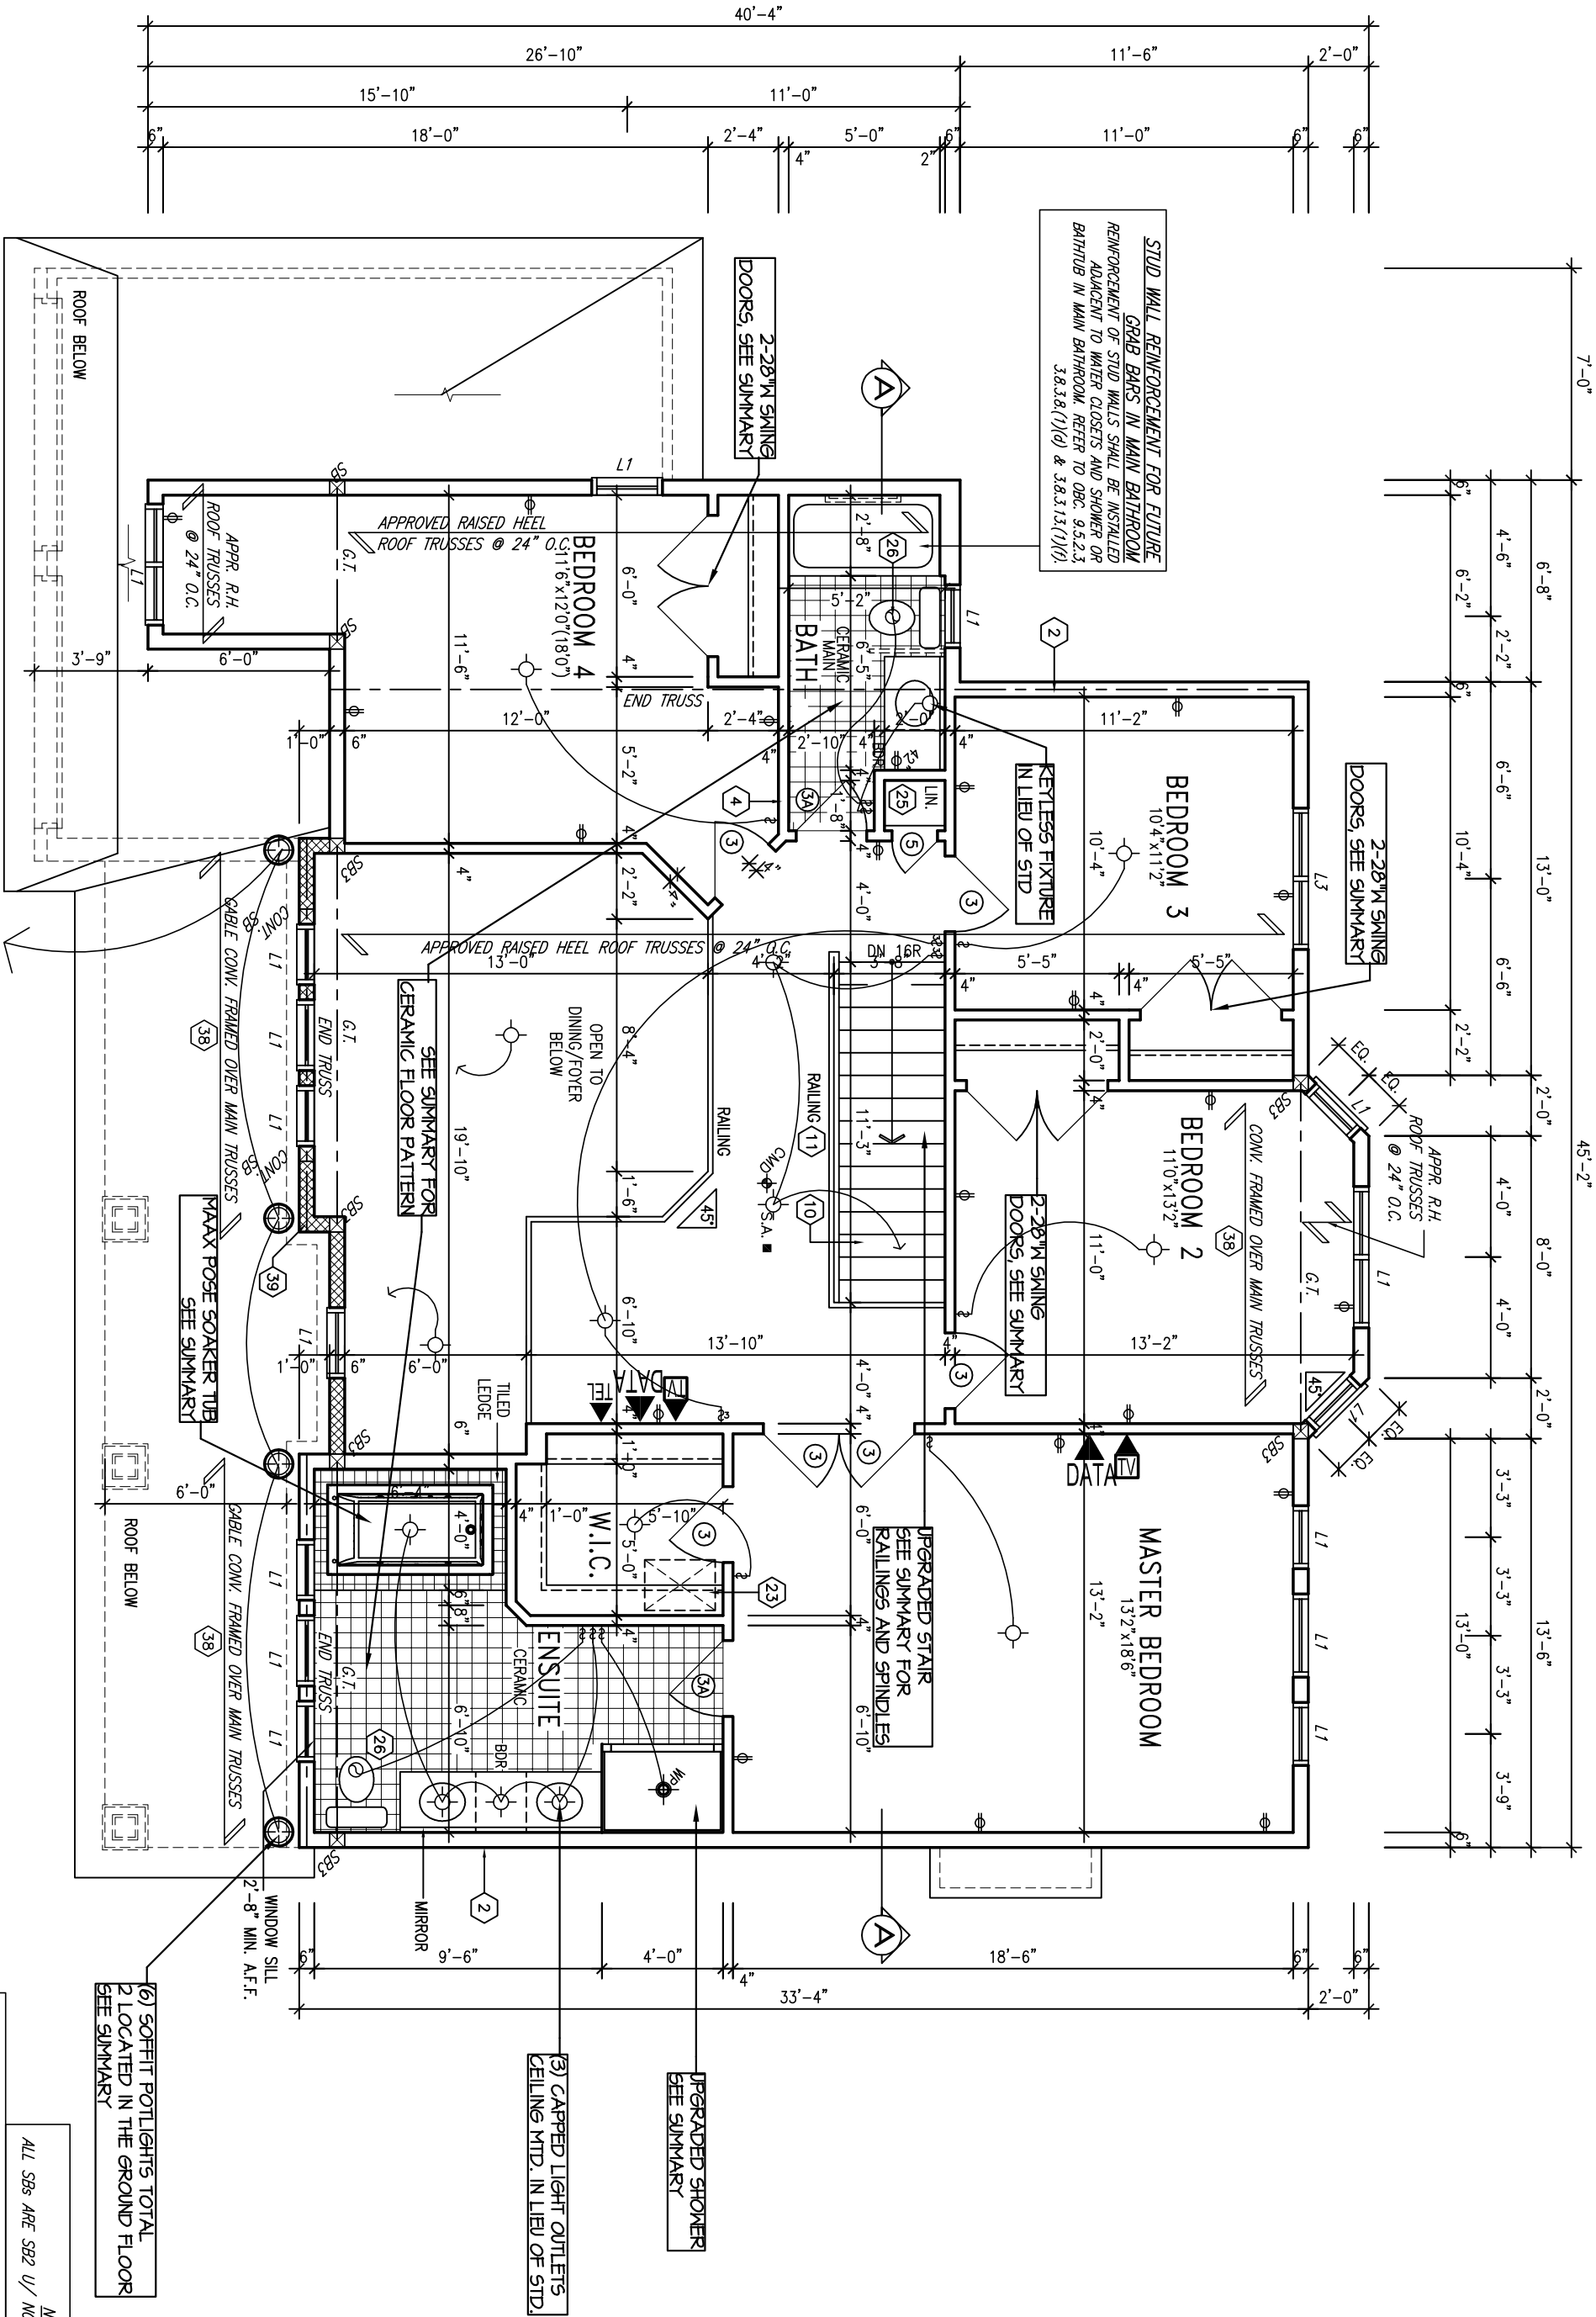

SECOND FLOOR PLAN-A

Viljoen Architect Inc.

300 A Wilson Avenue
North York, Ontario
M3H 1S8
TEL: (416) 630-2255
FAX: (416) 630-4782

BABYLONIAN-2007-A

SITE: SHADOW RIDGE2


LOT NUMBER:

CIVIC ADDRESS:
6549 WATERDOWN ST.


71

No.	Description	Date	By
3	REV. AS PER CONST SUMMARY	NOV13-13	SD
2	REV. AS PER CONST SUMMARY	NOV4-13	SD
1	ISSUED FOR FOUNDATION ONLY	AUG1-13	SD
REVISIONS			


footprint:	S3-A
sht. title:	SECOND FLOOR-A
drawn by:	TD5
checked by:	OF
date:	FEB. 2007
scale:	3/16"=1'
sheet no:	3A 6

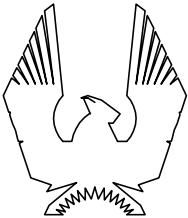

PHOENIX HOMES

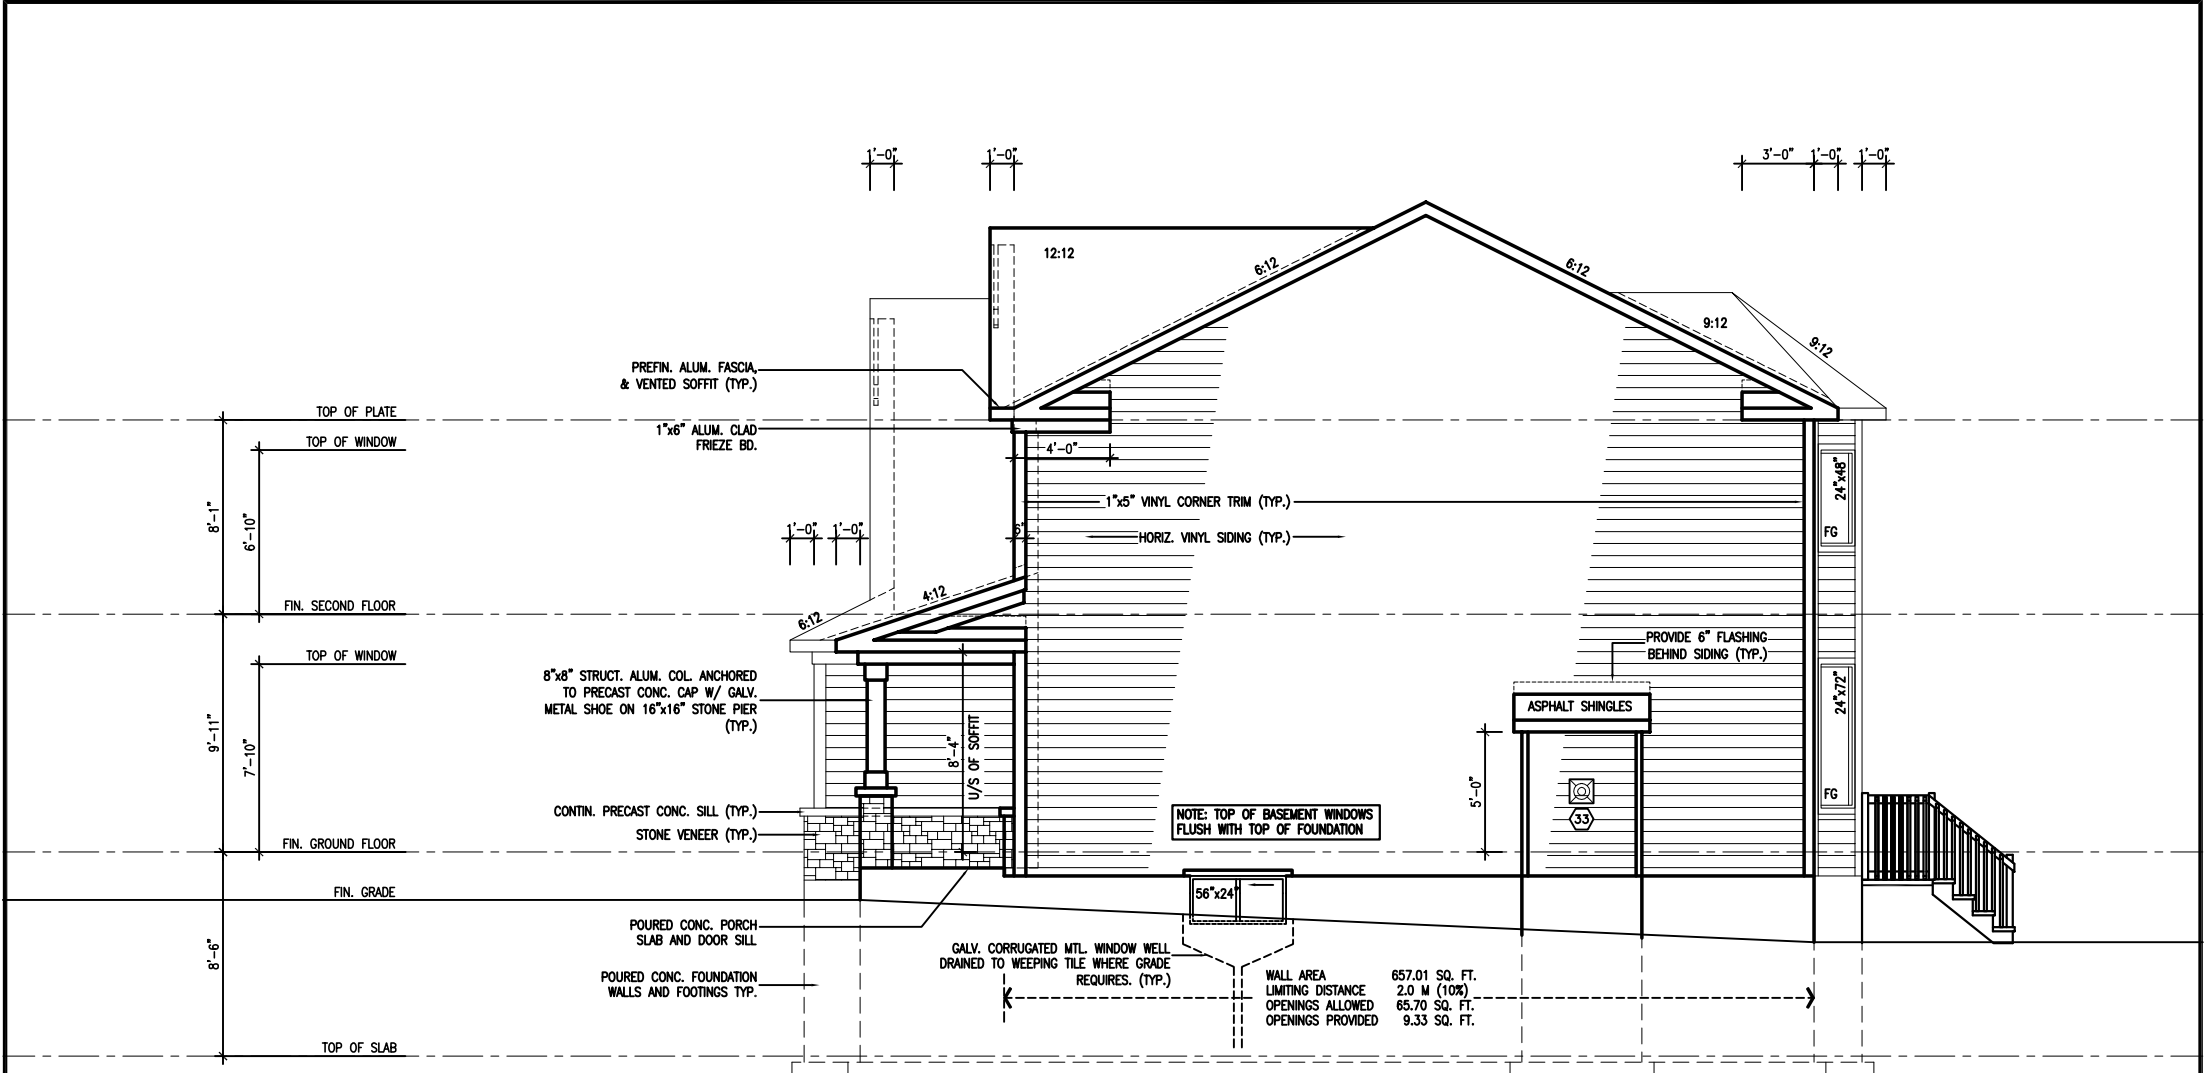

RIGHT SIDE ELEVATION 'A'

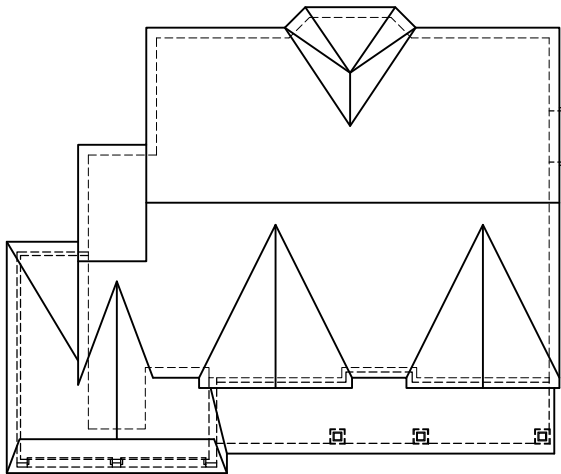

ROOF PLAN 'A'



FRONT ELEVATION 'A'



Viljoen Architect Inc.

300 A Wilson Avenue
North York, Ontario
M3H 1S8
TEL: (416) 630-2255
FAX: (416) 630-4782

BABYLONIAN-2007-A

SITE: SHADOW RIDGE2


LOT NUMBER:

71

CIVIC ADDRESS:
6549 WATERDOWN ST.

No.	Description	Date	By
3	REV. AS PER CONST SUMMARY	NOV13-13	SD
2	REV. AS PER CONST SUMMARY	NOV4-13	SD
1	ISSUED FOR FOUNDATION ONLY	AUG1-13	SD


Footprint:	S3-A
sht. title:	ELEVATIONS-A
drawn by:	TDS
checked by:	OF
date:	FEB. 2007
scale:	1/8"=1'
sheet no:	4A 6

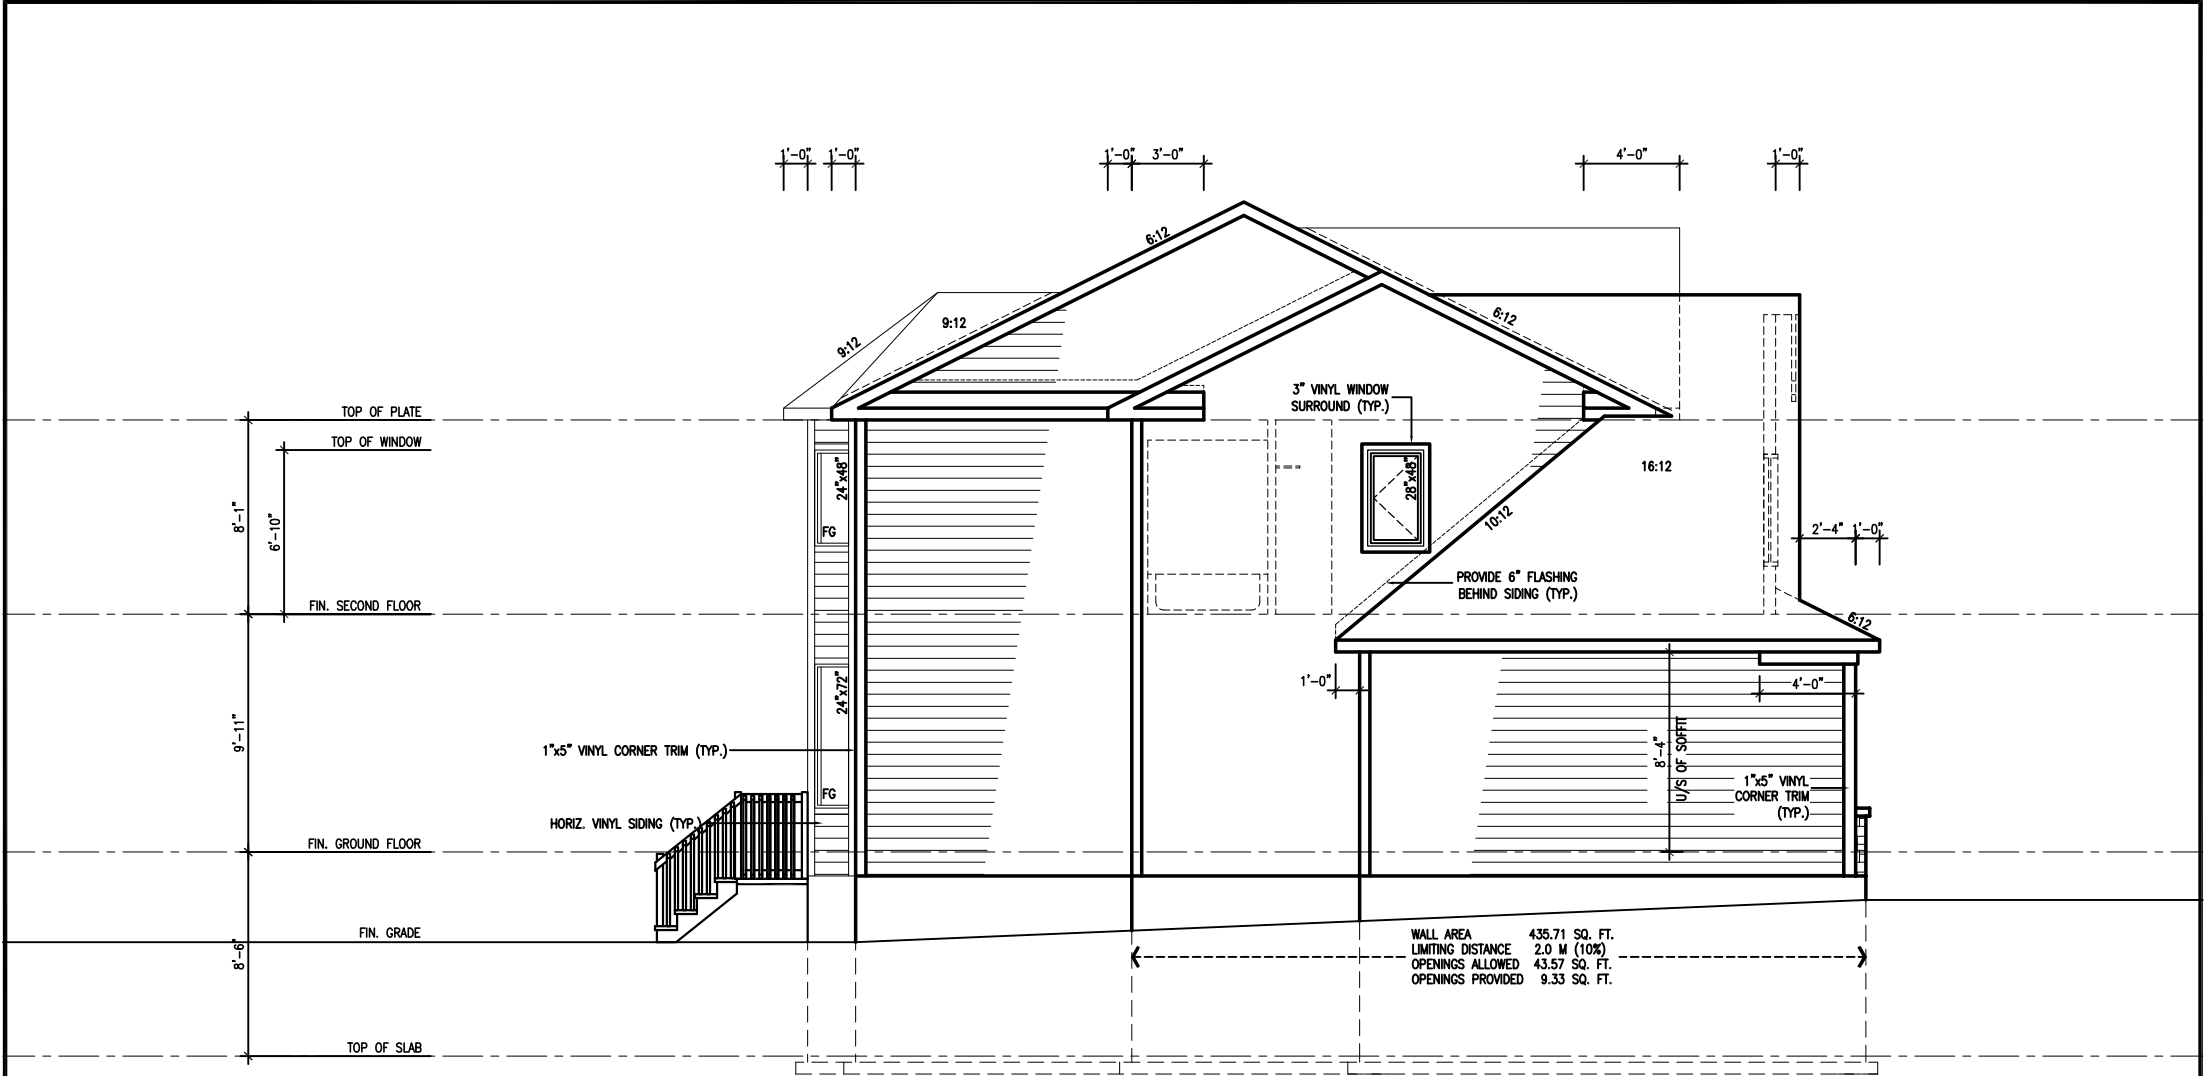

LEFT SIDE ELEVATION 'A'



REAR ELEVATION 'A'

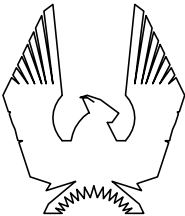

PHOENIX HOMES

Viljoen Architect Inc.

300 A Wilson Avenue
North York, Ontario
M3H 1S8
TEL: (416) 630-2255
FAX: (416) 630-4782

BABYLONIAN-2007-A

SITE: **SHADOW RIDGE2**

LOT NUMBER: **71**

CIVIC ADDRESS:
6549 WATERDOWN ST.

No.	Description	Date	By
3	REV. AS PER CONST SUMMARY	NOV13-13	SD
2	REV. AS PER CONST SUMMARY	NOV4-13	SD
1	ISSUED FOR FOUNDATION ONLY	AUG1-13	SD

Footprint: **S3-A**

sht. title: **ELEVATIONS-A**



drawn by: **TDS**

checked by: **OF**

date: **FEB. 2007**

scale: **1/8"=1'**

sheet no: **5A**
6

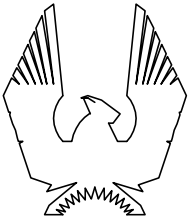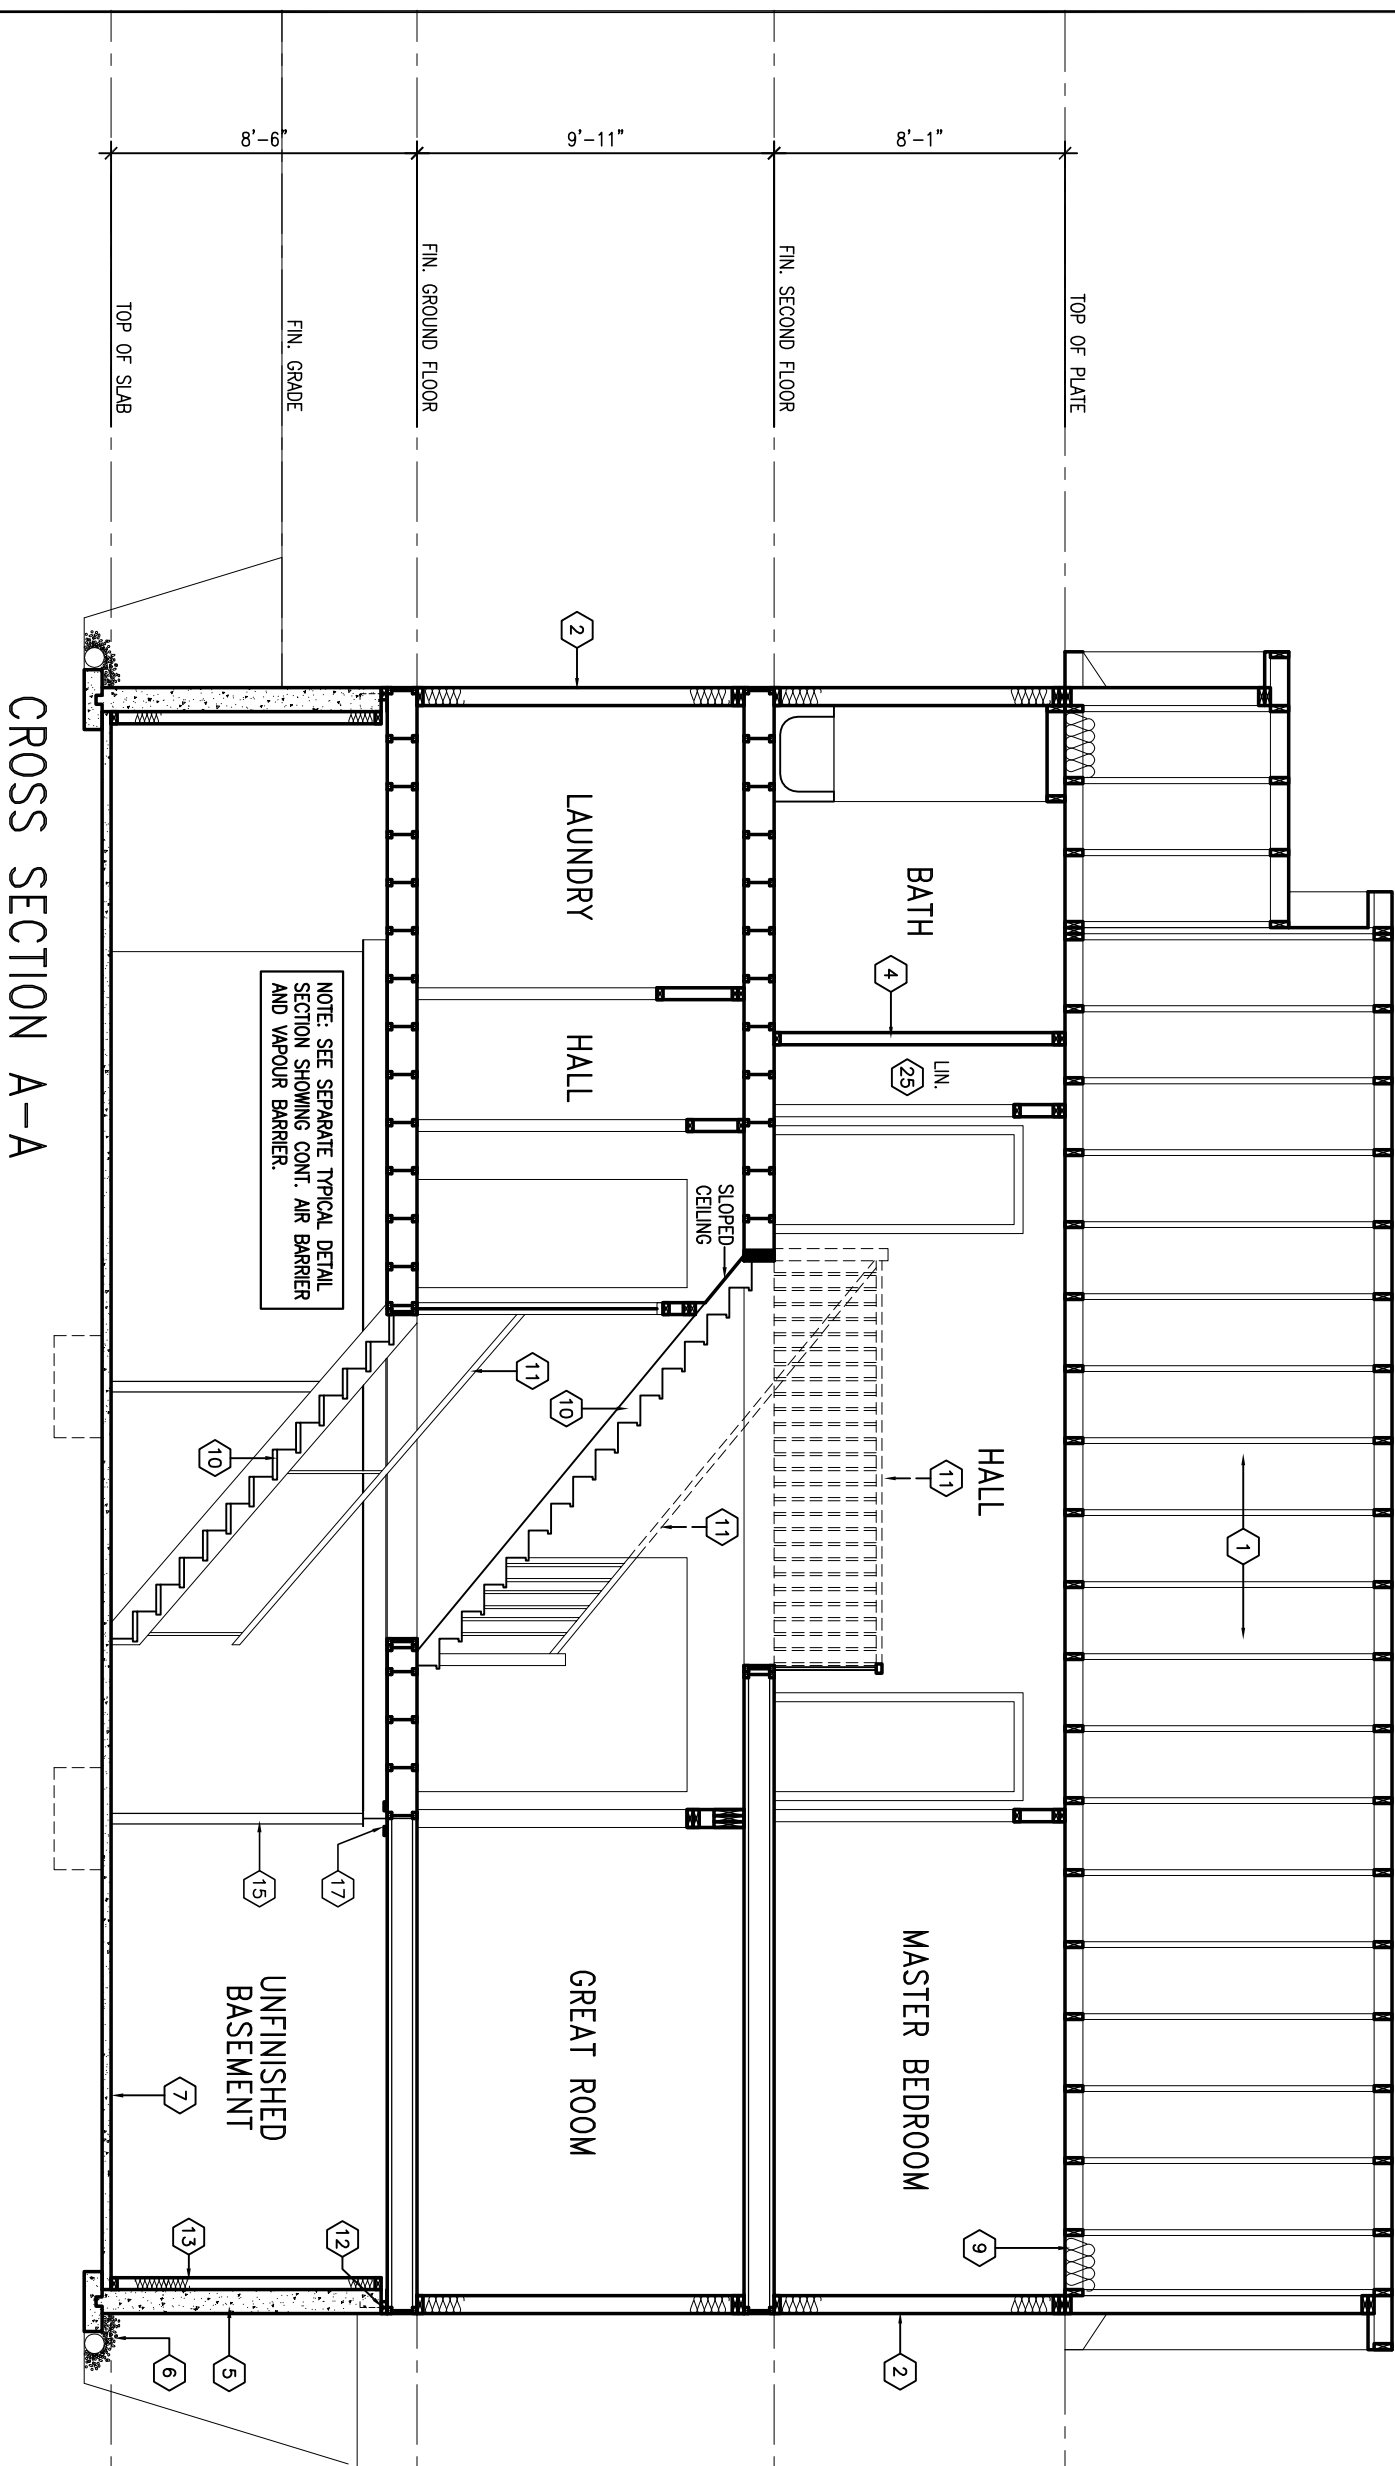

PHOENIX HOMES

Viljoen
Architect
Inc.

300 A Wilson Avenue
North York, Ontario
M3H 1S8
TEL: (416) 630-2255
FAX: (416) 630-4782

BABYLONIAN-2007

SITE: SHADOW RIDGE2

LOT NUMBER:

71

CIVIC ADDRESS:
6549 WATERDOWN ST.

3	REV. AS PER CONST SUMMARY	NOV13-13	SD
2	REV. AS PER CONST SUMMARY	NOV4-13	SD
1	ISSUED FOR FOUNDATION ONLY	AUG1-13	SD
No.	Description	Date	By
REVISIONS			

Footprint: 53
sht. title: SECTION
drawn by: TDS
checked by: OF
date: FEB. 2007
scale: 3/16"=1'

sheet no:

6
6