

SPRUE WALL ELEVATION

CUSTOMER APPROVAL

I have reviewed these drawings and understand the details of the layout and the Cartier Kitchens specifications.

Signature

Date

[Signature]
July 21st 12

lot 32 Pizzo

Note: This drawing is an artistic interpretation of the general appearance of the design. It is not meant to be an exact rendition.


DESIGNED BY: LORI DISAVERIO,
DCR 73 SHADOW RIDGE - KITCHEN



Designed: 4/13/2012
Printed: 4/22/2012

All

Drawing #: 1

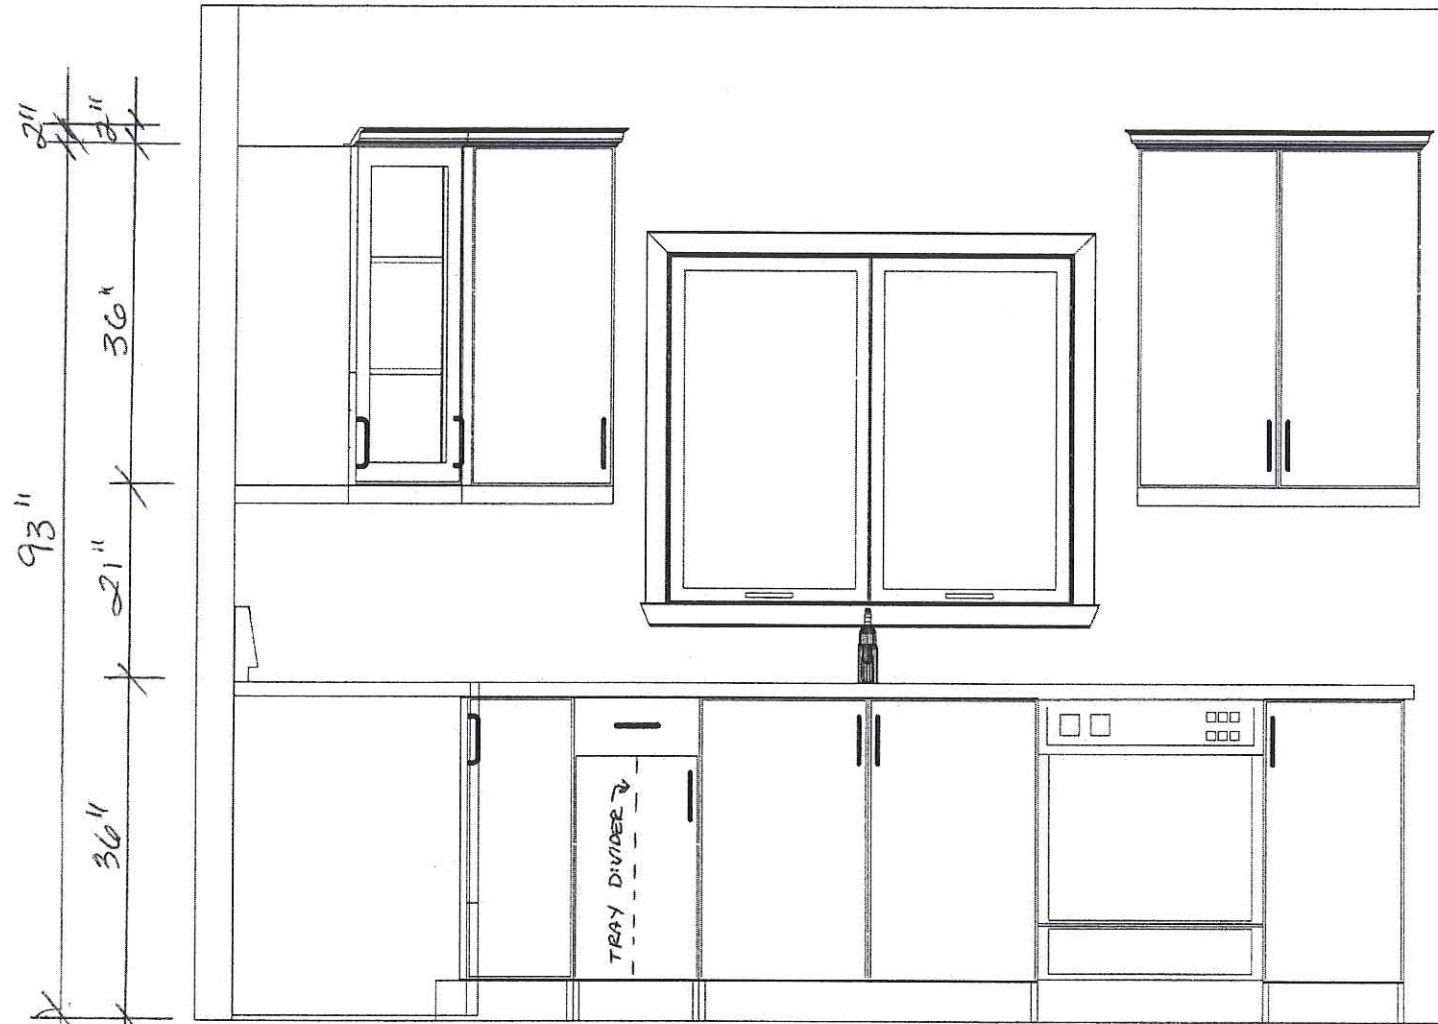

CUSTOMER APPROVAL

I have reviewed these drawings and understand the details of the layout and the Cartier Kitchens specifications.

Signature

Date

Lot 32 Pizzo
July 21st/12

Note: This drawing is an artistic interpretation of the general appearance of the design. It is not meant to be an exact rendition.

DESIGNED BY: LORI DISAVERIO.
 DCR 73 SHADOW RIDGE - KITCHEN



Designed: 4/13/2012
 Printed: 4/22/2012

All

Drawing #: 1

32