


STUD WALL REINFORCEMENT FOR FUTURE.
GRAB BARS IN MAIN BATHROOM
REINFORCEMENT OF STUD WALLS SHALL BE INSTALLED
ADJACENT TO WATER CLOSETS AND SHOWER OR
BATHUB IN MAIN BATHROOM. REFER TO DBC. 9.5.2.3.
3.8.3.8.(1)(g) & 3.8.3.13.(1)(f). AND DETAILS PROVIDED
ON PAGE 02

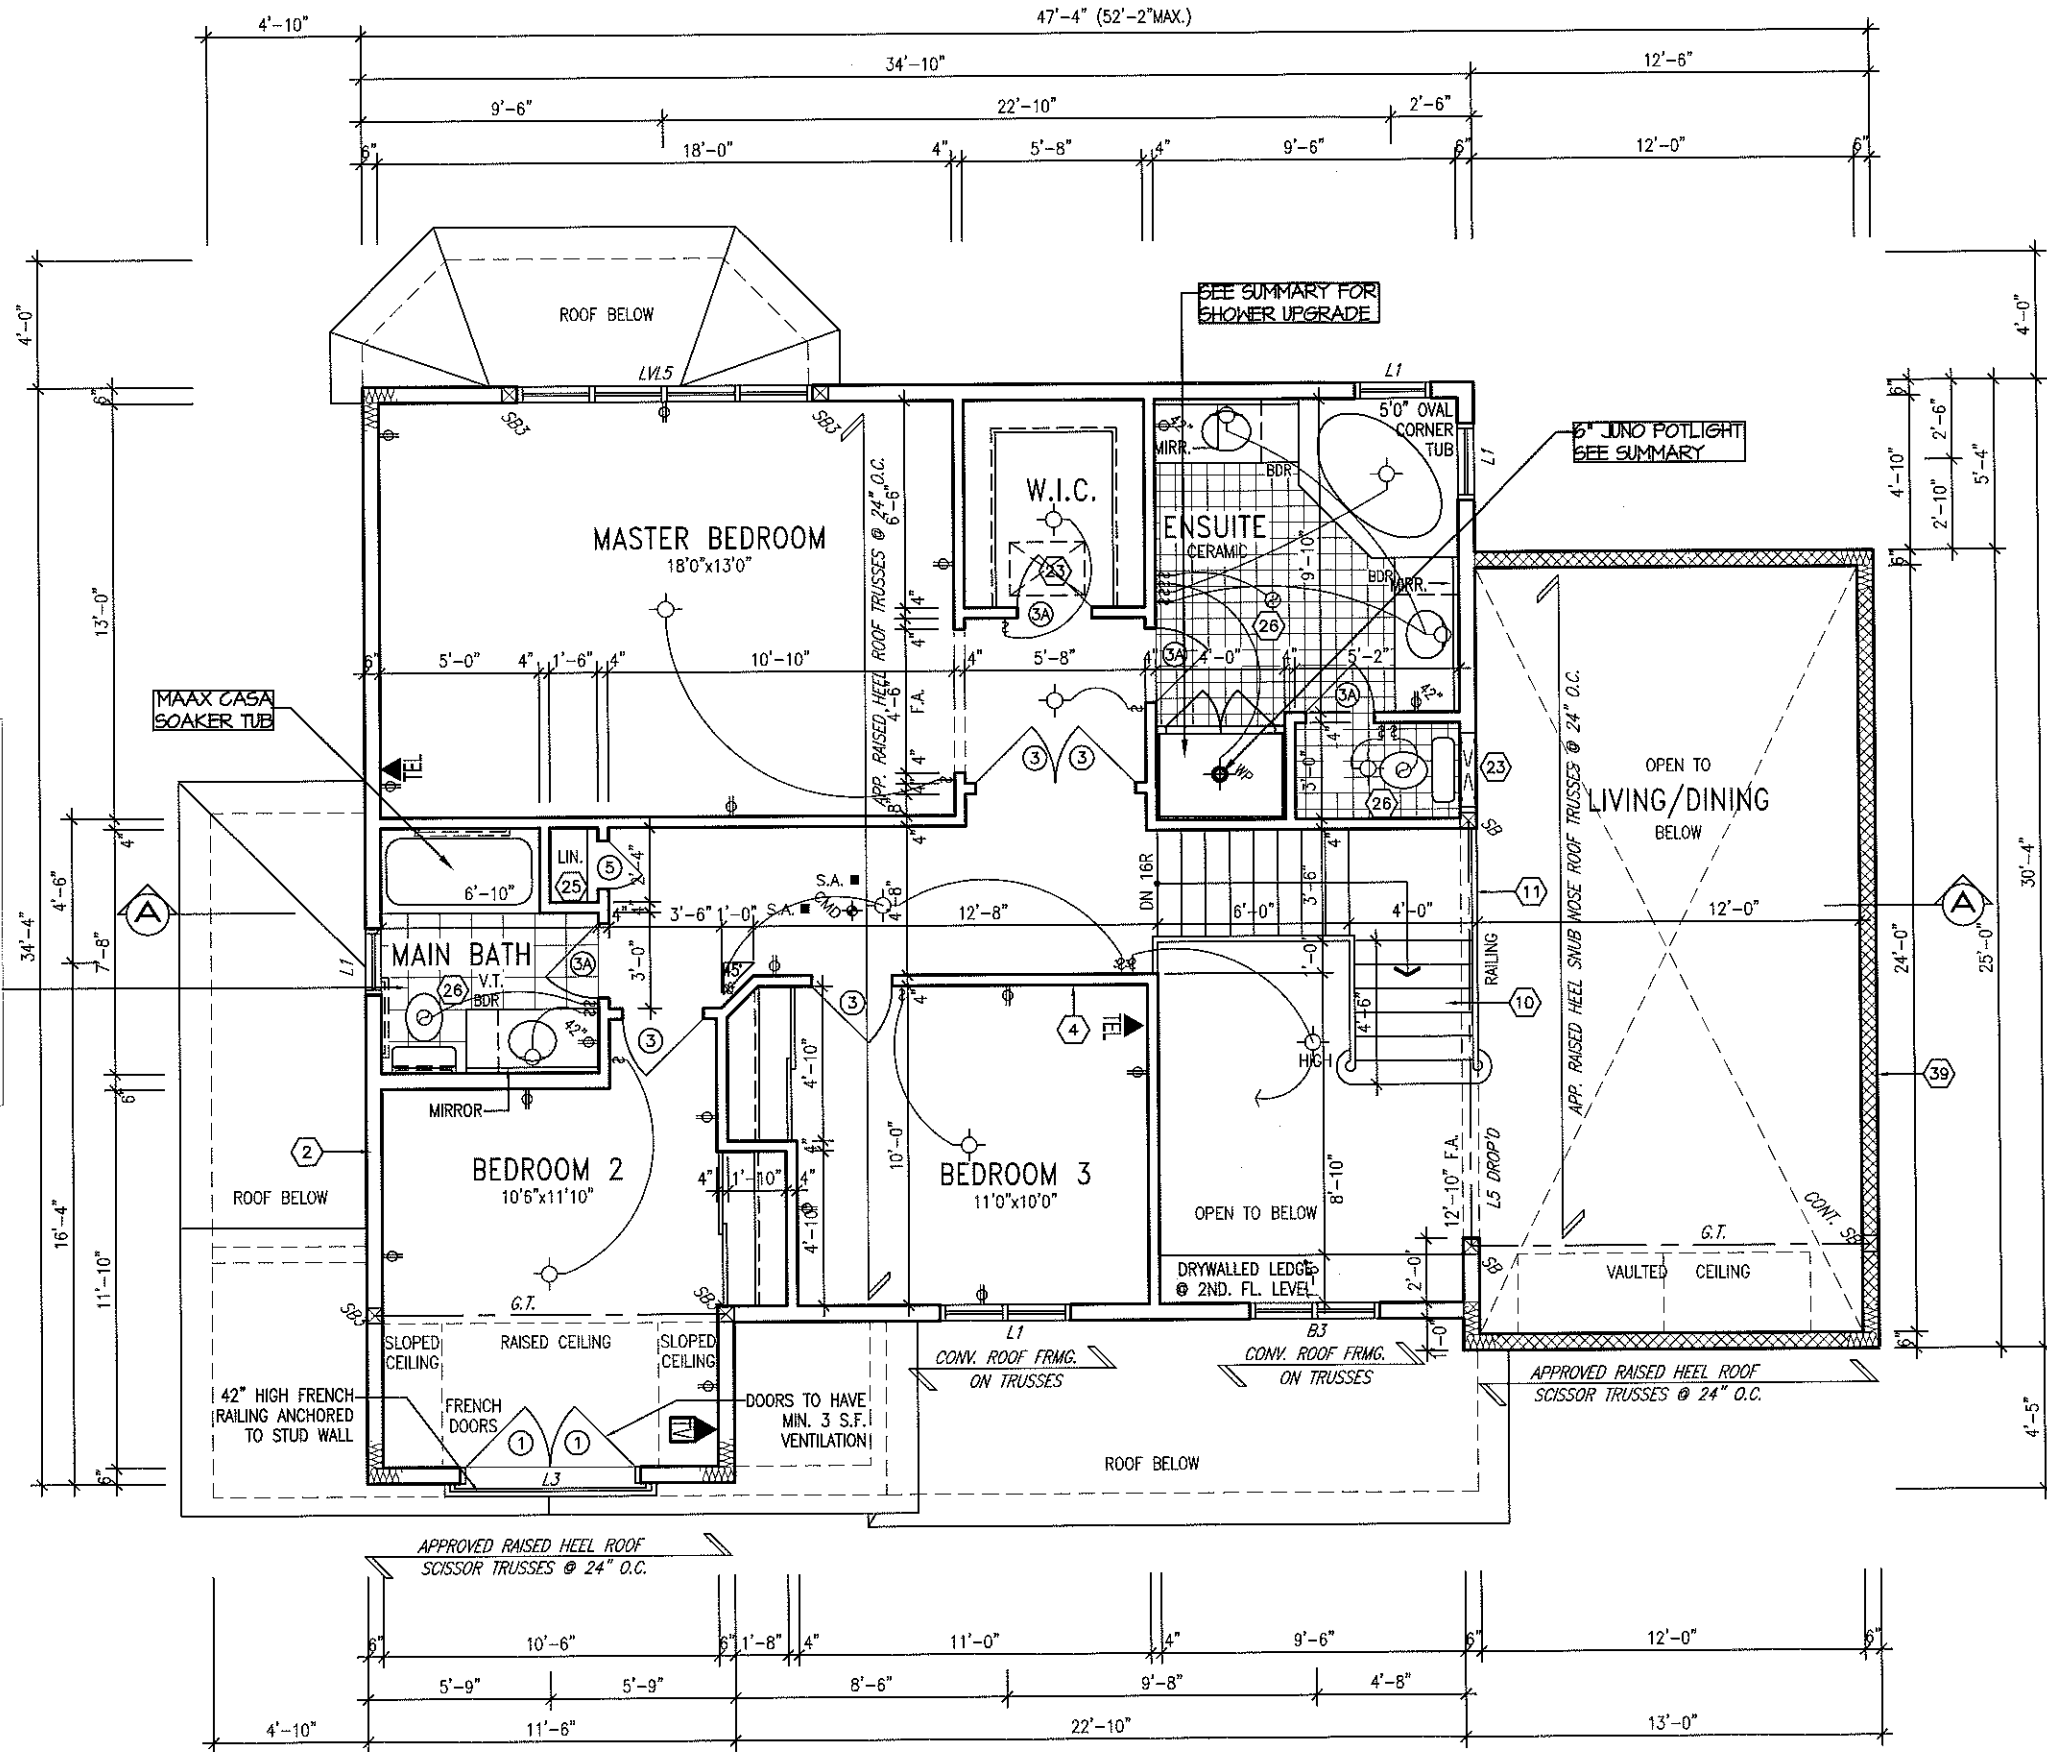

SECOND FLOOR PLAN (3 BEDROOM) 'A'

NOTE: ROOF FRAMING INFORMATION
ALL LAMINATED VENEER LUMBER (LVL) BEAMS, BUILT-UP BEAMS,
GIRDER TRUSSES AND METAL HANGER CONNECTIONS SUPPORTING
ROOF FRAMING TO BE DESIGNED AND CERTIFIED BY ROOF TRUSS
MANUFACTURER. REFER TO ROOF TRUSS SHOP DRAWINGS FOR
ALL ROOF FRAMING INFORMATION UNLESS OTHERWISE NOTED ON
ARCHITECTURAL DRAWINGS.


NOTE: ROOF TRUSS INFORMATION REFER TO ROOF
TRUSS SHOP DRAWINGS FOR ALL ROOF FRAMING
INFORMATION UNLESS OTHERWISE NOTED.

NOTE:
ALL SBs ARE SB2 U/ NOTED

MERKHET-2007-A

Viljoen
Architect
Inc.

300 A Wilson Avenue
North York, Ontario
M3H 1S8
TEL: (416) 630-2255
FAX: (416) 630-4752

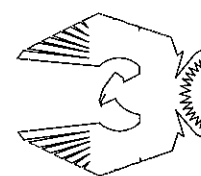

PHOENIX HOMES





SITE: SHADOW RIDGE 2

LOT NUMBER: 73


CIVIC ADDRESS:
6553 WATERDOWN ST.

Footprint: S2-A	Sheet: 3A
Sheet title: SECOND FLOOR-A	6
Drawn by: MB	
Checked by: OF	
Date: FEB. 2007	
Scale: 3/16"=1'	
Sheet no:	

No.	Description	Date	By
3	REV. AS PER CONST. SUMMARY	AUG28-12	SD
2	REV. AS PER CONST. SUMMARY	JUL12-12	SD
1	ISSUED FOR FOUNDATION ONLY	MAY22-12	SD

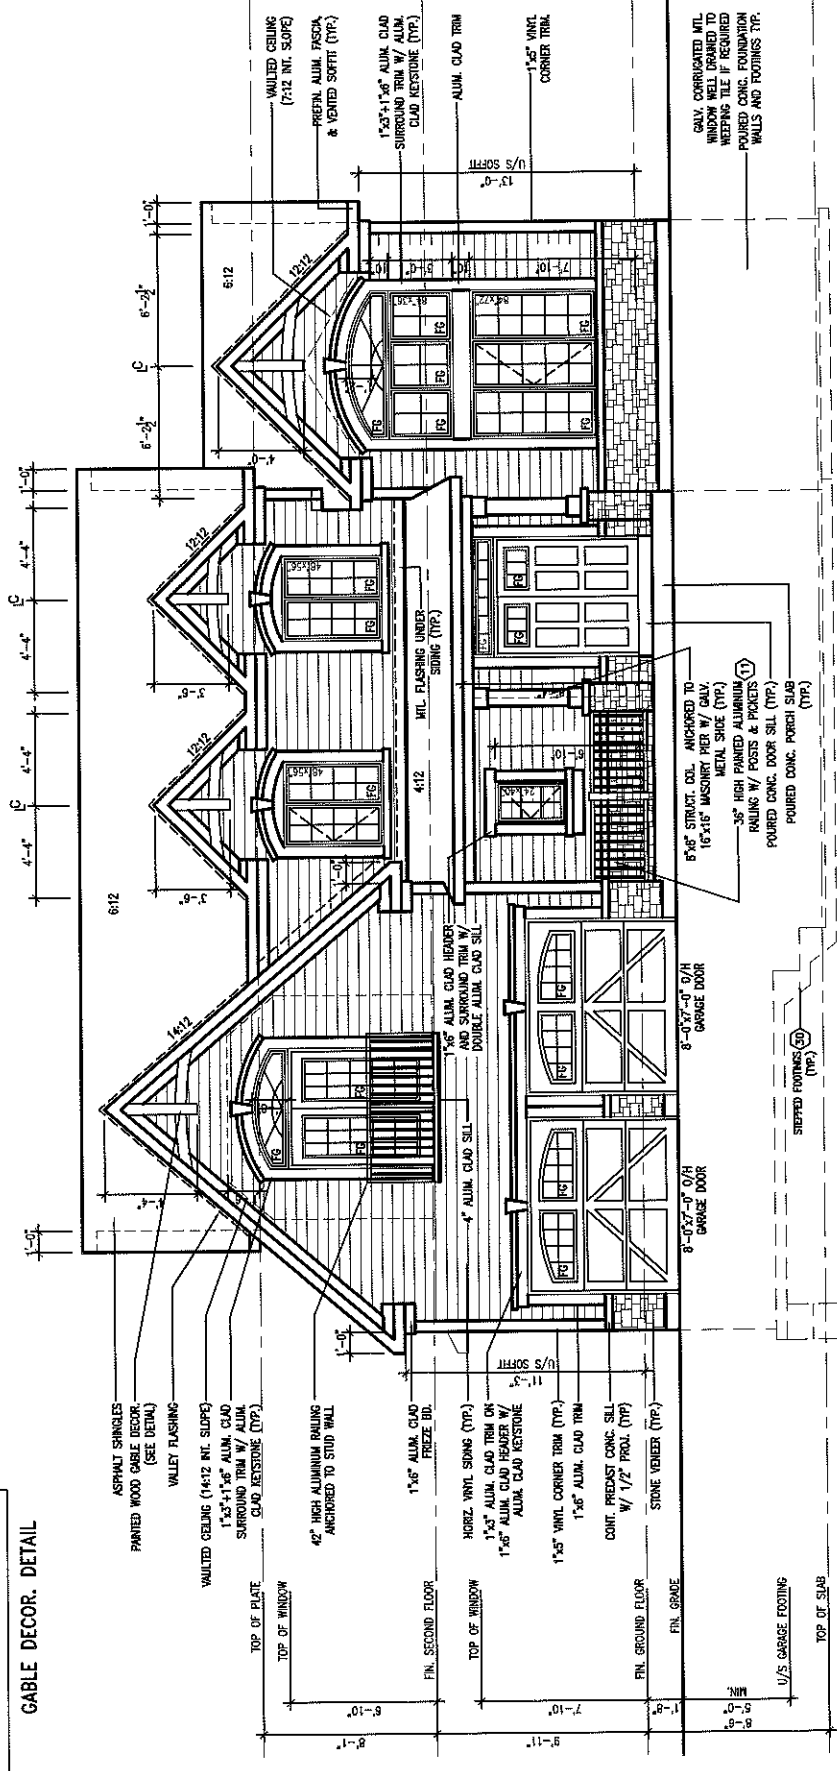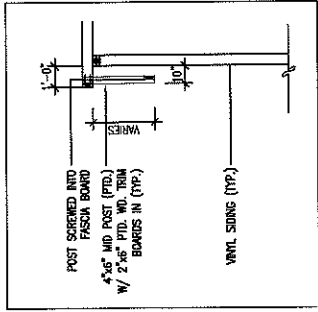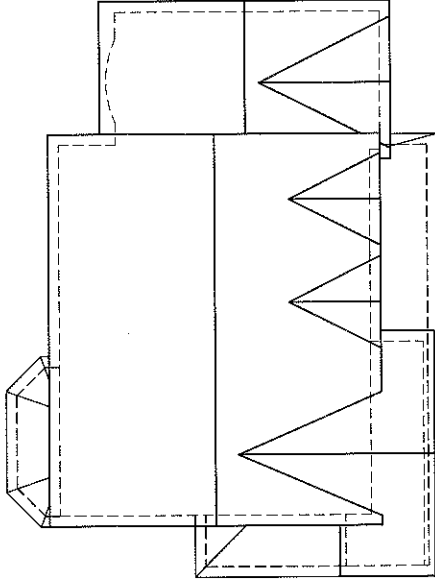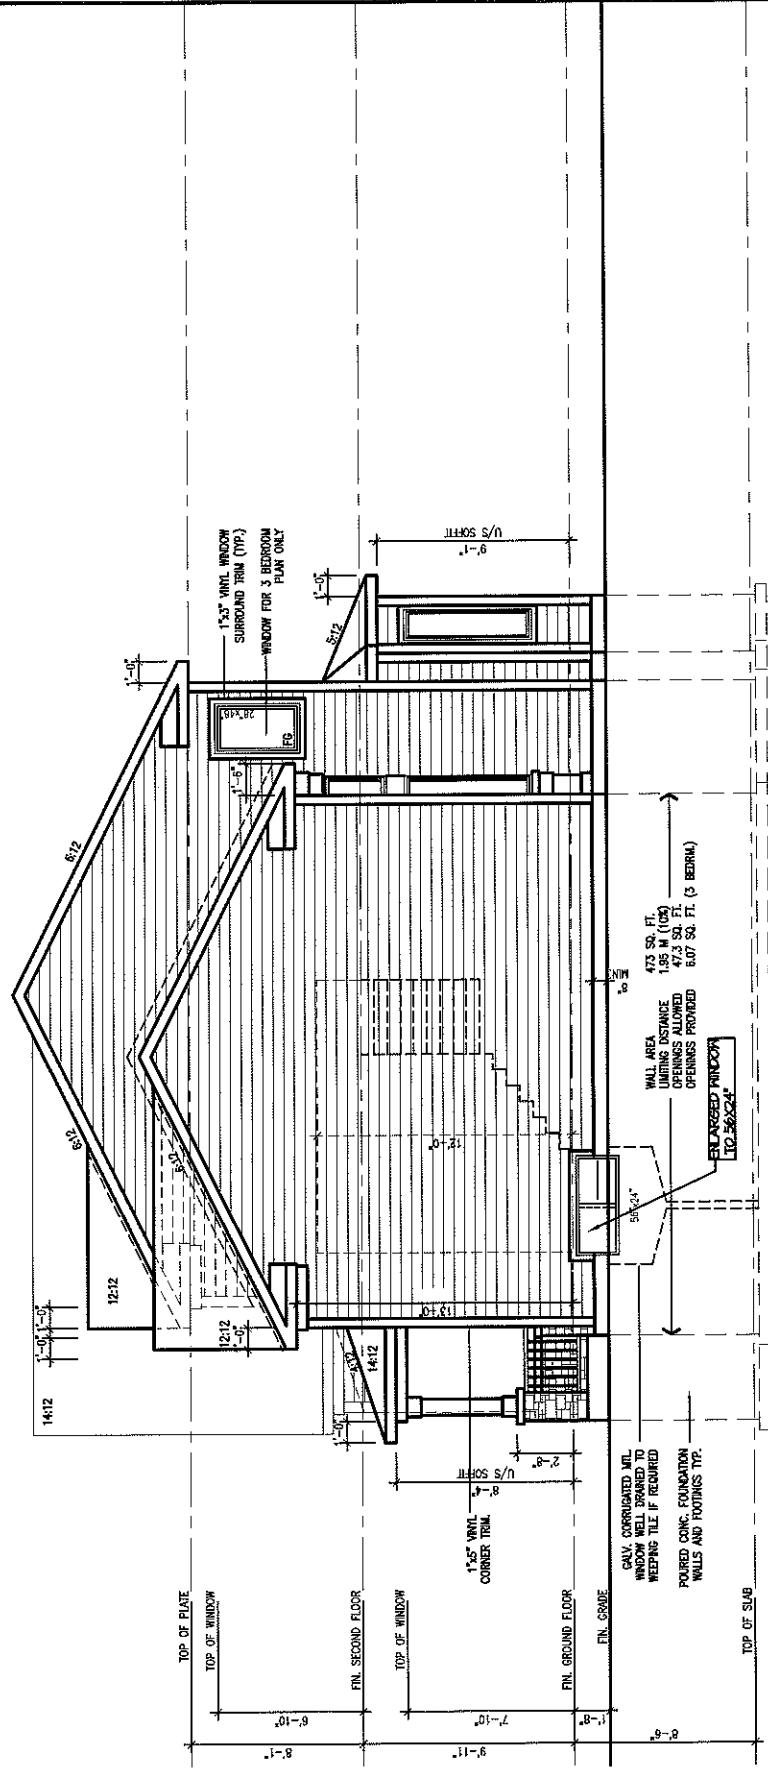

FRONT ELEVATION 'A'

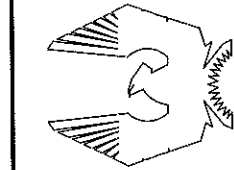

**Viljoen
Architect
Inc.**

300 A. Wilson Avenue
North York, Ontario
M3H 1S8
TEL: (416) 630-2255
FAX: (416) 630-4782

PHOENIX HOMES

MERKHEIT-2007-A


SITE: SHADOW RIDGE 2

LOT NUMBER: **73**

CIVIC ADDRESS:
6553 WATERDOWN ST.


Footprint:	S2-A
Shl. Title:	ELEVATIONS-A
Drawn by:	MB
Checked by:	OF
Date:	FEB. 2007
Scale:	1/8"=1'
Sheet No:	4A
	6

No.	Description	Date	By
3	REV. AS PER CONST. SUMMARY	AUG28-12	SD
2	REV. AS PER CONST. SUMMARY	JUL12-12	SD
1	ISSUED FOR FOUNDATION ONLY	MAY22-12	SD

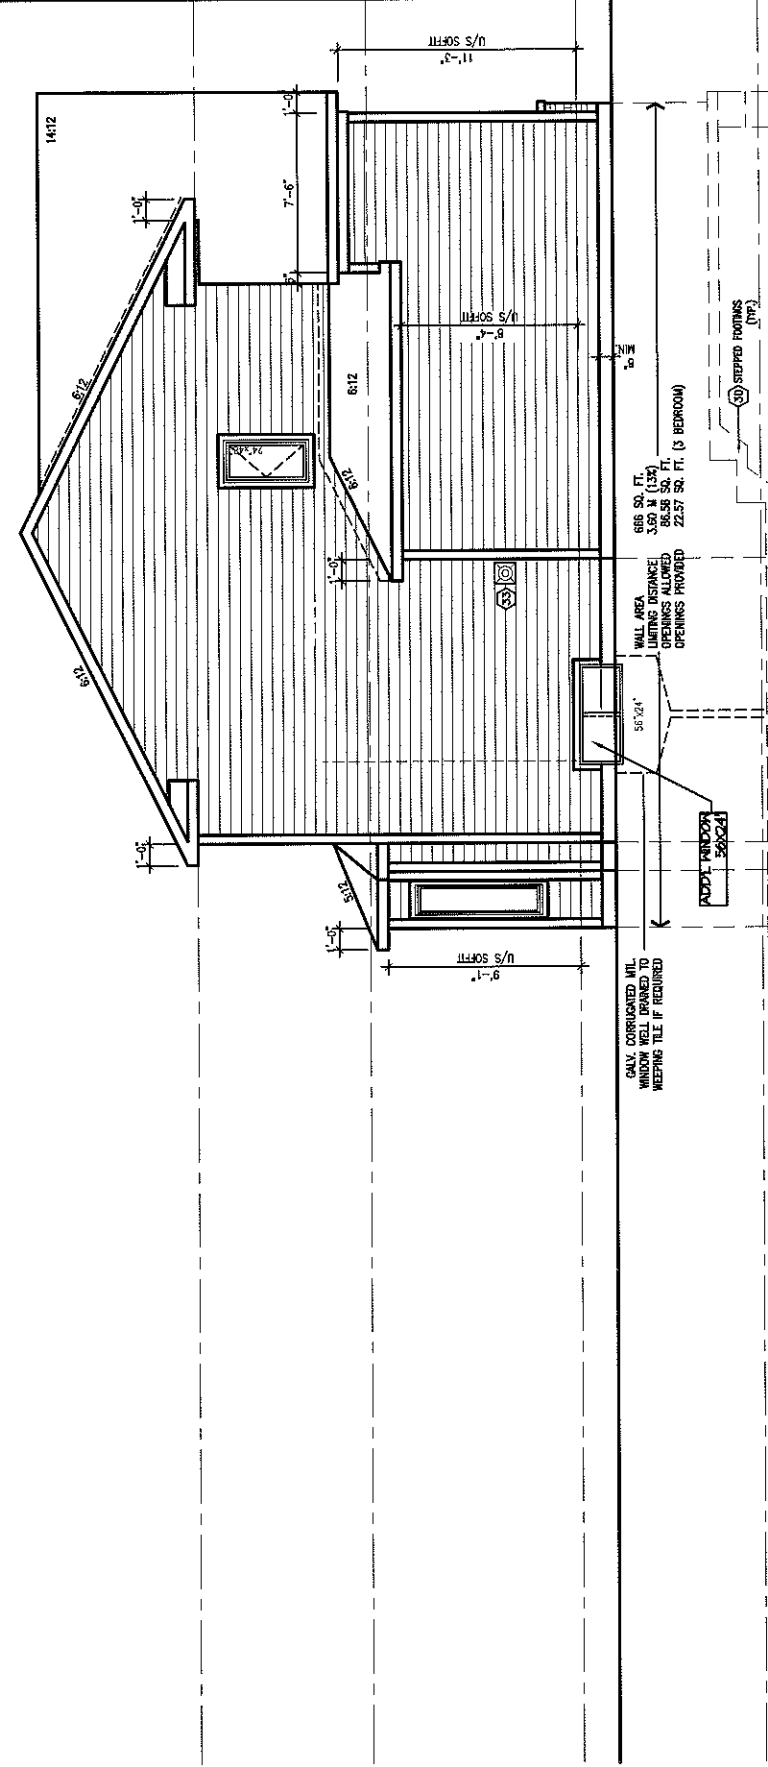

LEFT SIDE ELEV. 'A' (3 BEDRM.)

NOTE:
REFER TO FRONT ELEVATION FOR
TYPICAL NOTES & INFORMATION

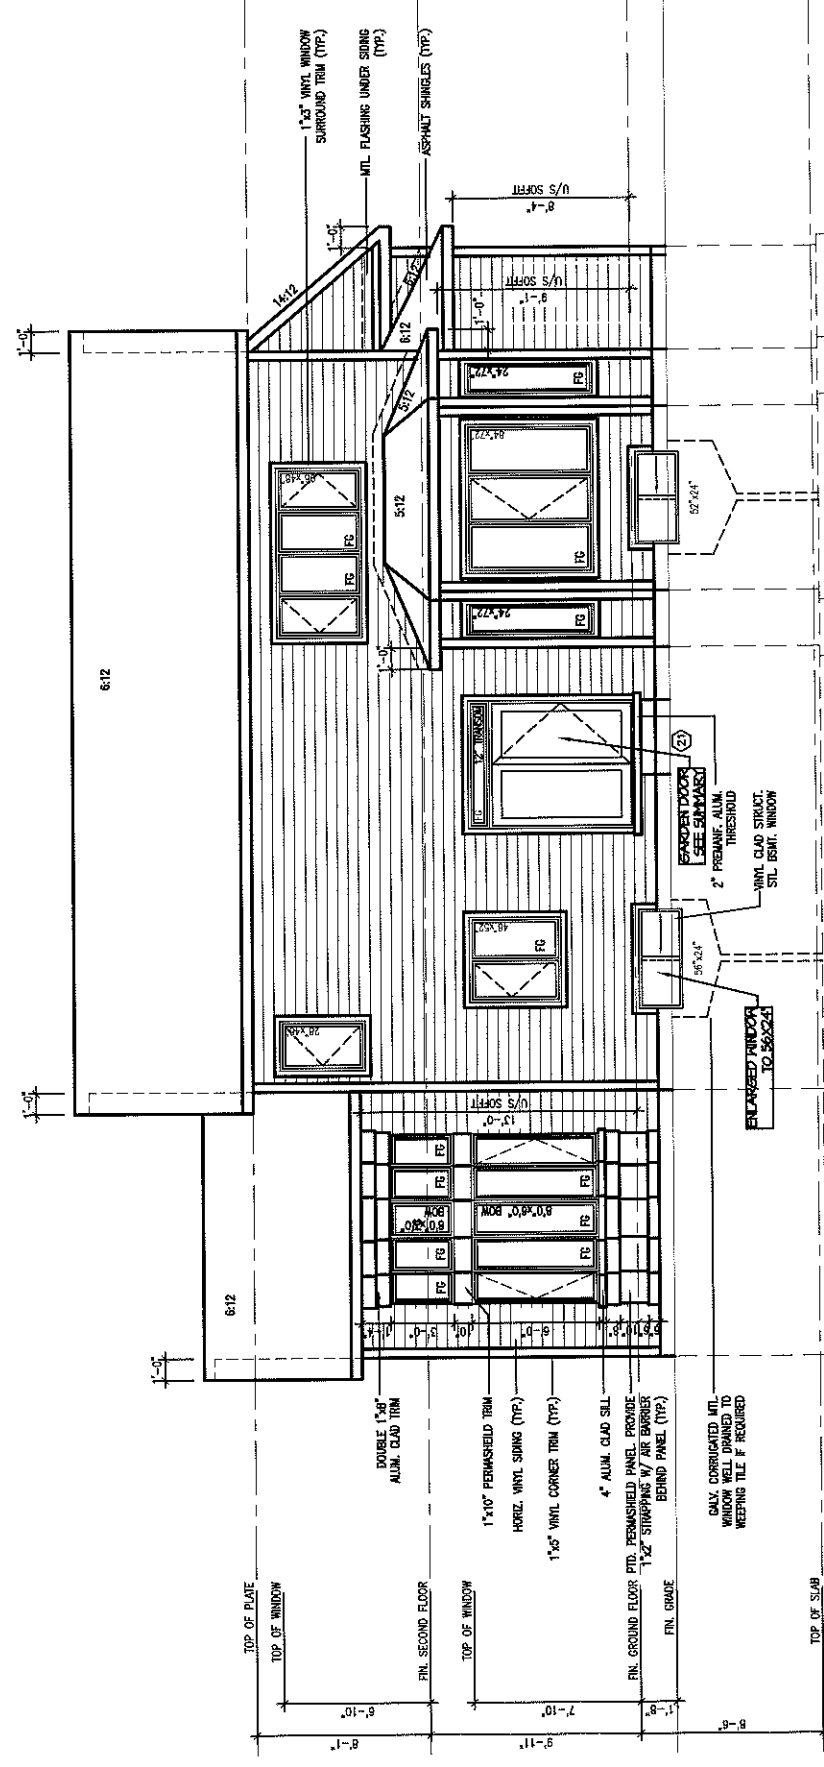

REAR ELEVATION 'A' (3 BEDRM.)

NOTE:
REFER TO FRONT ELEVATION FOR
TYPICAL NOTES & INFORMATION


footprint:	S2-A
sht. title:	ELEVATIONS-A
drawn by:	MB
checked by:	OF
date:	FEB. 2007
scale:	1/8"=1'
sheet no:	5A
	6

3 REV.	AS PER CONST. SUMMARY	AUG28-12	SD	
2 REV.	AS PER CONST. SUMMARY	JUL12-12	SD	
1	ISSUED FOR FOUNDATION ONLY	MAY22-12	SD	
No.	Description	Date	By	
REVISIONS				

MERKHET-2007-A
SITE: SHADOW RIDGE 2
LOT NUMBER: 73
CIVIC ADDRESS: 6553 WATERDOWN ST.

Viljoen Architect Inc.

300 A. Wilson Avenue
North York, Ontario
M2H 1S8
TEL: (416) 630-2255
FAX: (416) 630-4782

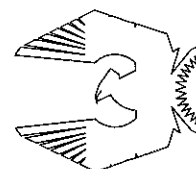

PHOENIX HOMES