

DCR PHOENIX HOMES

SHADOW RIDGE 2

LOT #75

BABYLONIAN (S3)

KITCHEN

MOUNTING HT: 96"

LIGHT VALNCE

CROWN MOULDING


CUSTOMER APPROVAL

I have reviewed these drawings and understand the details of the layout and the Cartier Kitchens specifications.

Signature

Date

Aug. 22/13

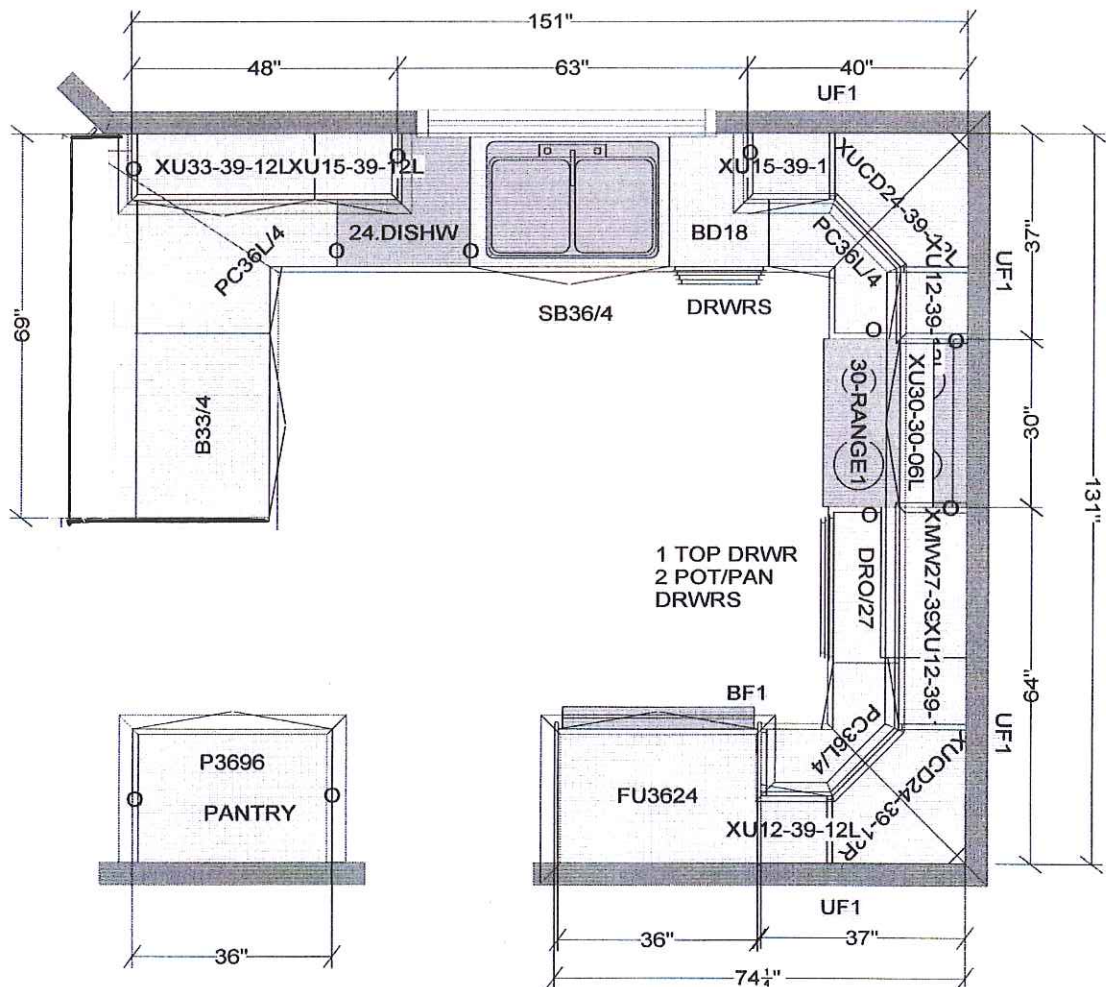

All dimensions, size designations given are subject to verification on job site and adjustment to fit job conditions.

CARTIER KITCHENS OTTAWA



2020
TECHNOLOGIES

This is an original design and must not be released or copied unless applicable fee has been paid or job order placed.


DRAWN BY: LORI DISAVERIO, B.I.D.
CARTIER KITCHENS OTTAWA

Designed: 5/26/2013
Printed: 5/26/2013

DCR - #75 SR2 - BABYLONIAN (S3) - KITCHEN

All

Drawing #: 1 No Scale.

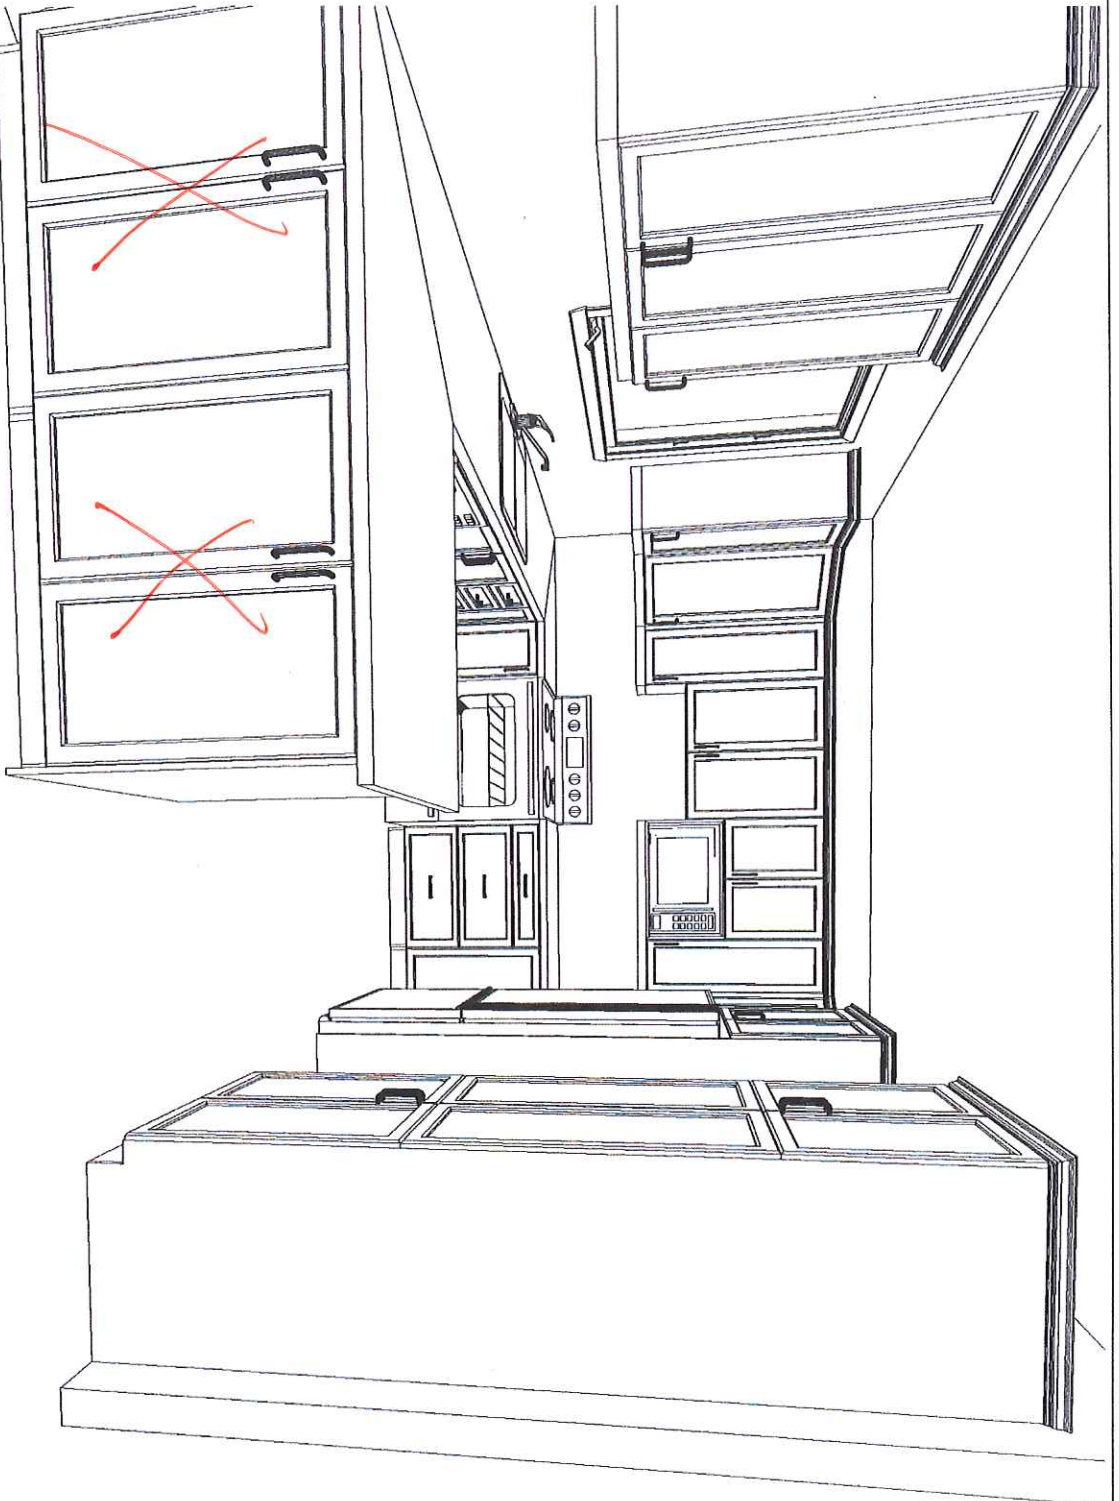

NO CABINETS ON BACKSIDE
 → TO HAVE STANDARD BREAKFAST BAR

3D View #1

CUSTOMER APPROVAL

I have reviewed these drawings and understand the details of the layout and the Carter Kitchens specifications.

Signature

MR

KR

Date

Aug. 20/13

Note: This drawing is an artistic interpretation of the general appearance of the design. It is not meant to be an exact rendition.

DRAWN BY: LORI DISAVERIO, B.I.D

DCR - #75 SR2 - BABYLONIAN (S3) - KITCHEN

All

Drawing #: 1



2020
 TECHNOLOGIES

Designed: 5/26/2013
 Printed: 5/26/2013

NO CABINETS ON BACK
 - TO HAVE STANDARD
 BREAKFAST BAR

CUSTOMER APPROVAL


I have reviewed these drawings and understand the details of the layout and the Cartier Kitchens specifications.

Signature

(Signature)

Date

Aug. 22/13

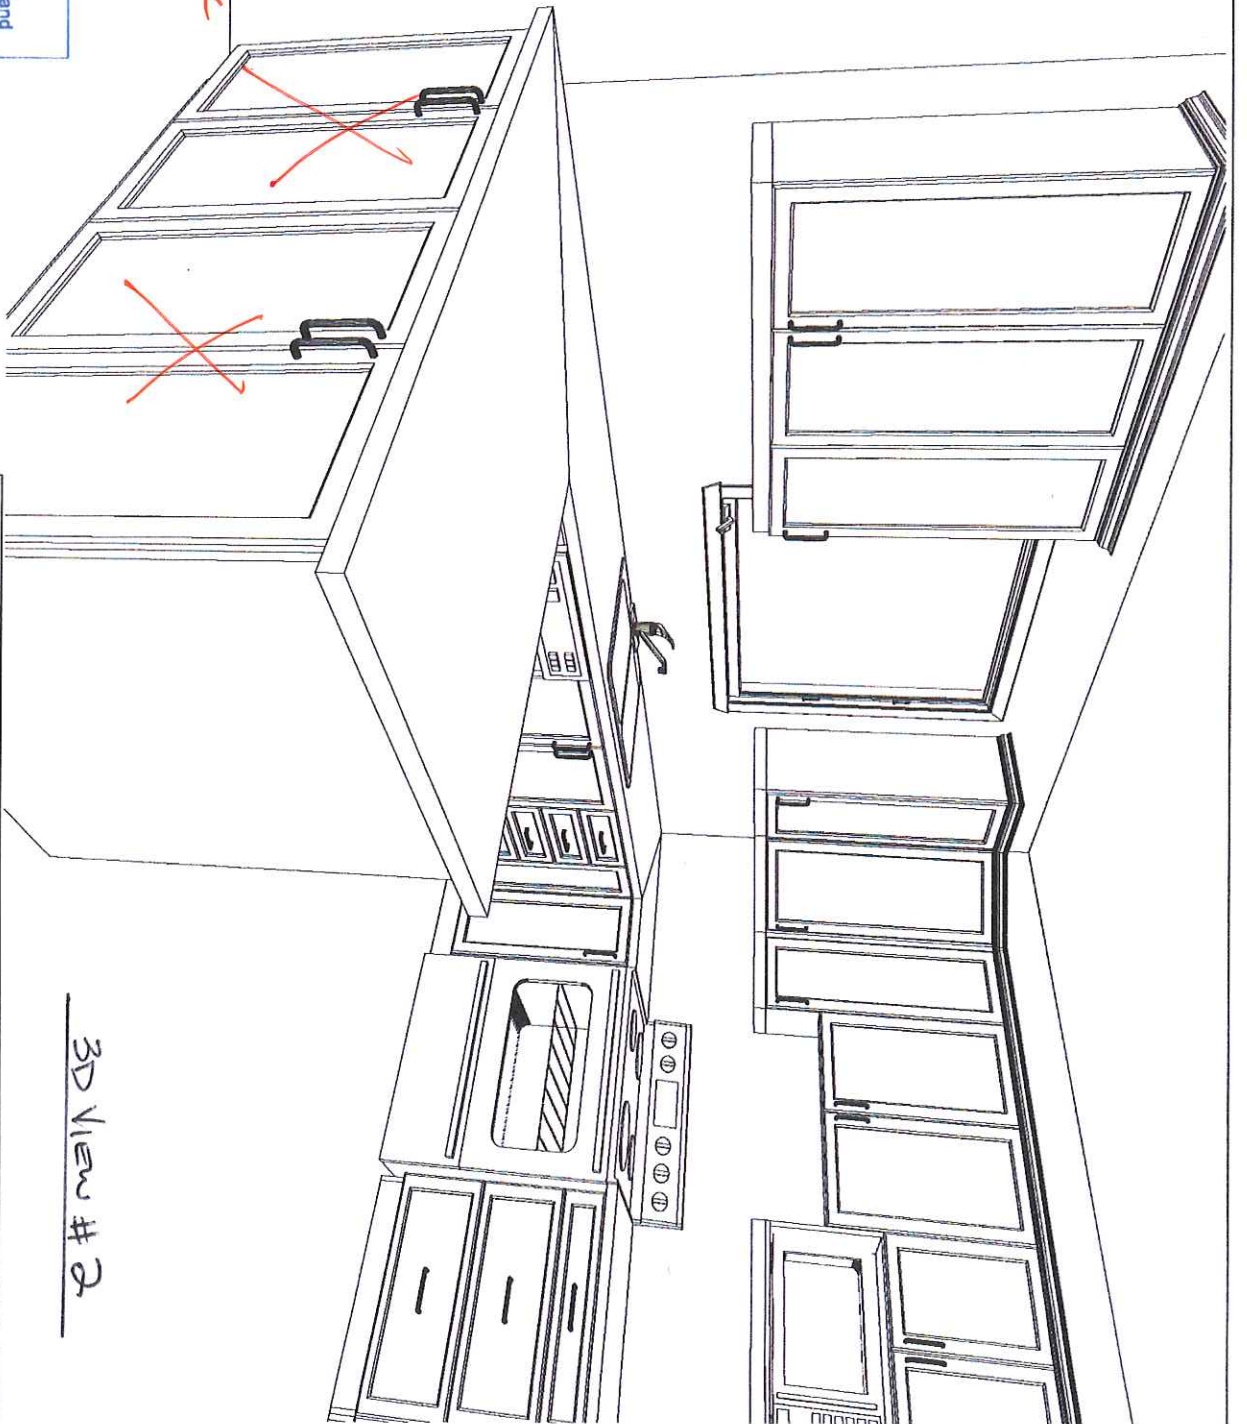

3D View #2

Note: This drawing is an artistic interpretation of the general appearance of the design. It is not meant to be an exact rendition.




Designed: 5/26/2013
 Printed: 5/26/2013

DRAWN BY: LORI DISAVERIO, B.I.D



DCR - #75 SR2 - BABYLONIAN (S3) - KITCHEN All

Drawing #: 1

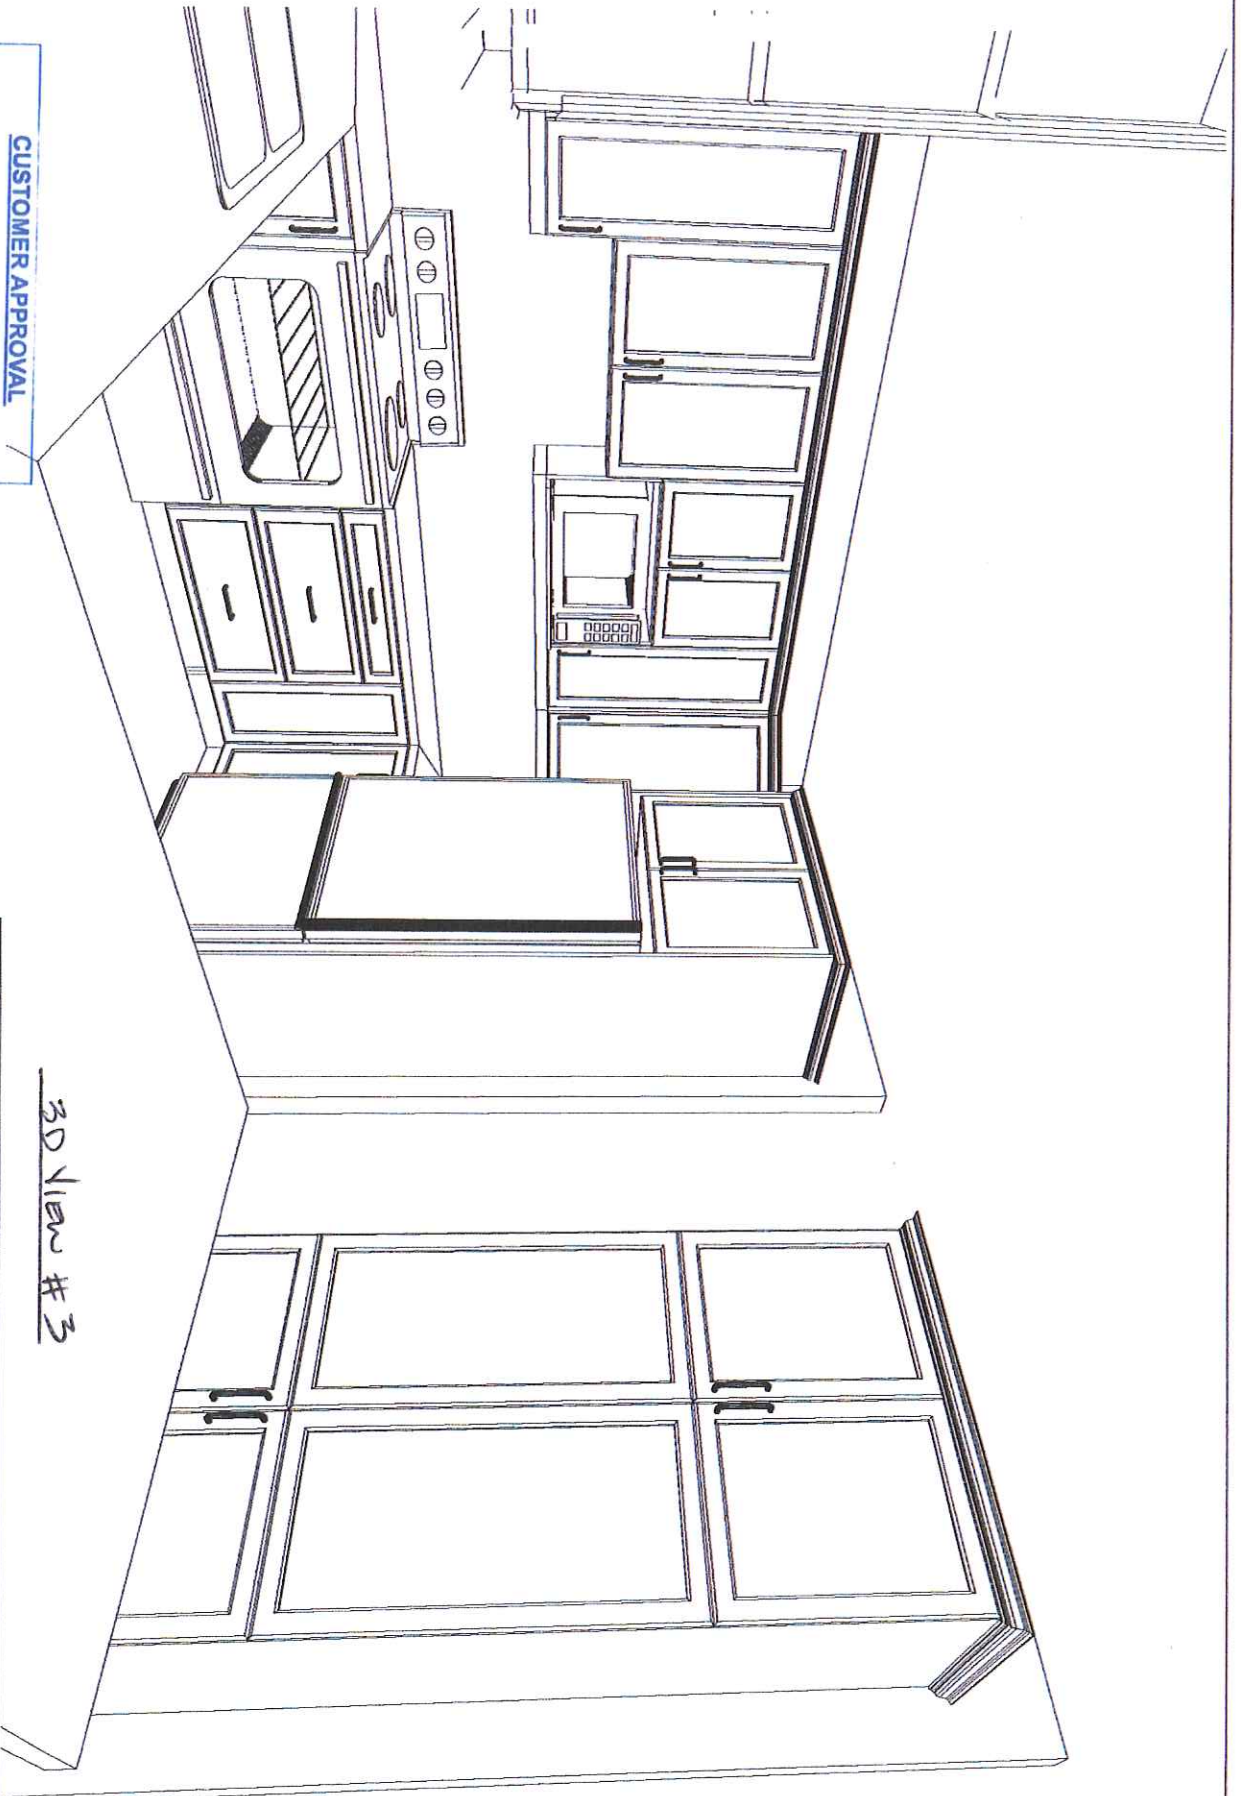

3D View #3

CUSTOMER APPROVAL

I have reviewed these drawings and understand the details of the layout and the Carter Kitchens specifications.

Signature

MR. K

Date

Aug. 22/13

Note: This drawing is an artistic interpretation of the general appearance of the design. It is not meant to be an exact rendition.

DRAWN BY: LORI DISAVERIO, B.I.D



DCR - #75 SR2 - BABYLONIAN (S3) - KITCHEN All



2020
TECHNOLOGIES

Designed: 5/26/2013
Printed: 5/26/2013

Drawing #: 1

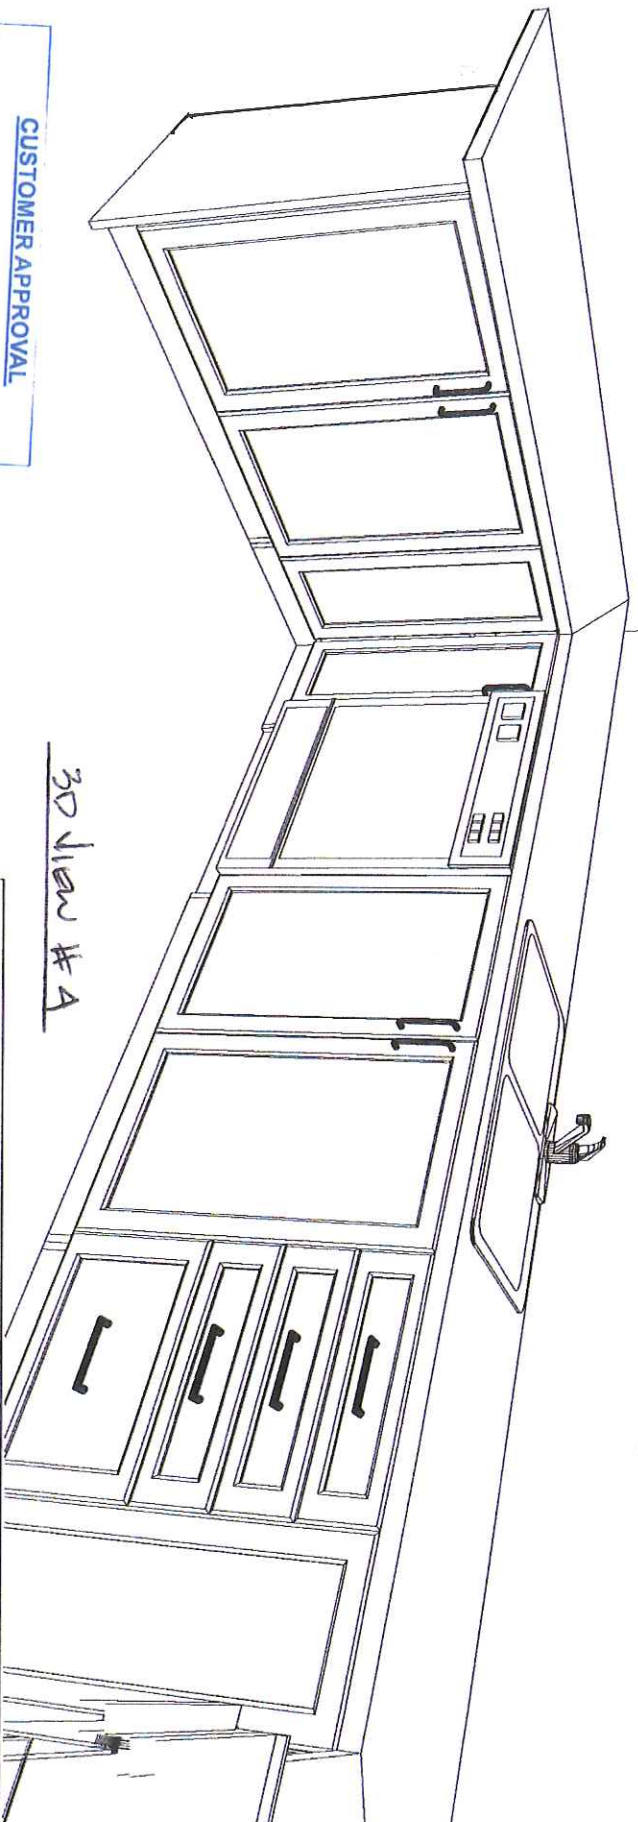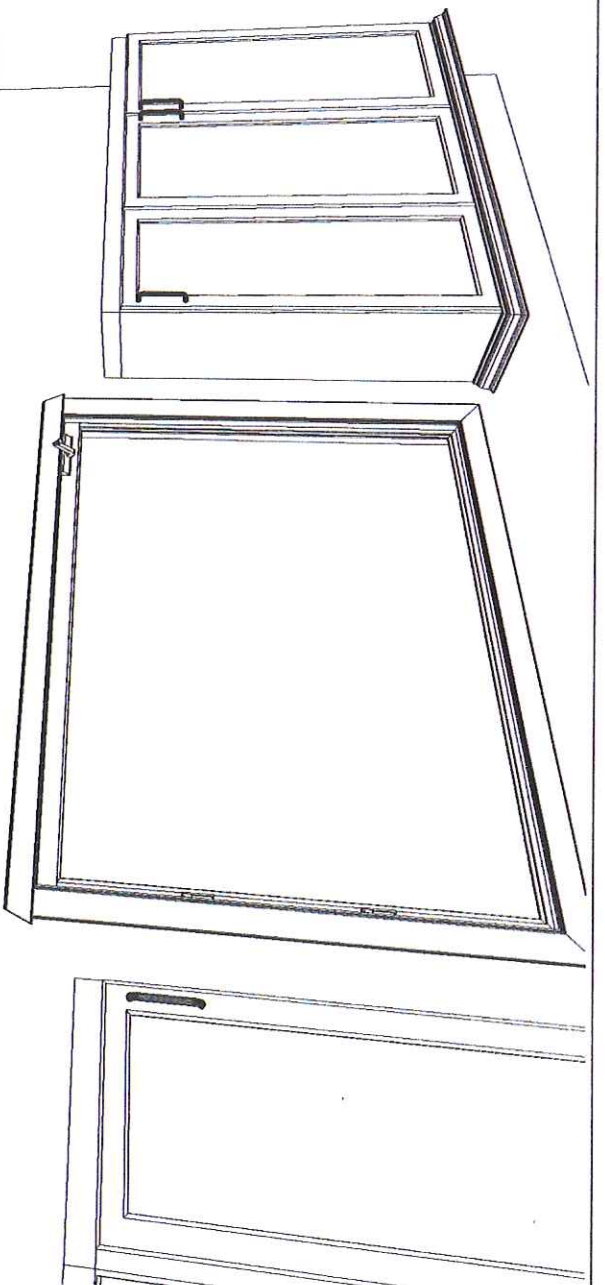

30 View # 4

CUSTOMER APPROVAL

I have reviewed these drawings and understand the details of the layout and the Carter Kitchens specifications.

Signature

MR. H.R.

Date

Aug. 22/13


Note: This drawing is an artistic interpretation of the general appearance of the design. It is not meant to be an exact rendition.

DRAWN BY: LORI DISAVERIO, B.I.D


DCR - #75 SR2 - BABYLONIAN (S3) - KITCHEN

All

Drawing #: 1

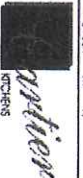

Designed: 5/26/2013
Printed: 5/26/2013

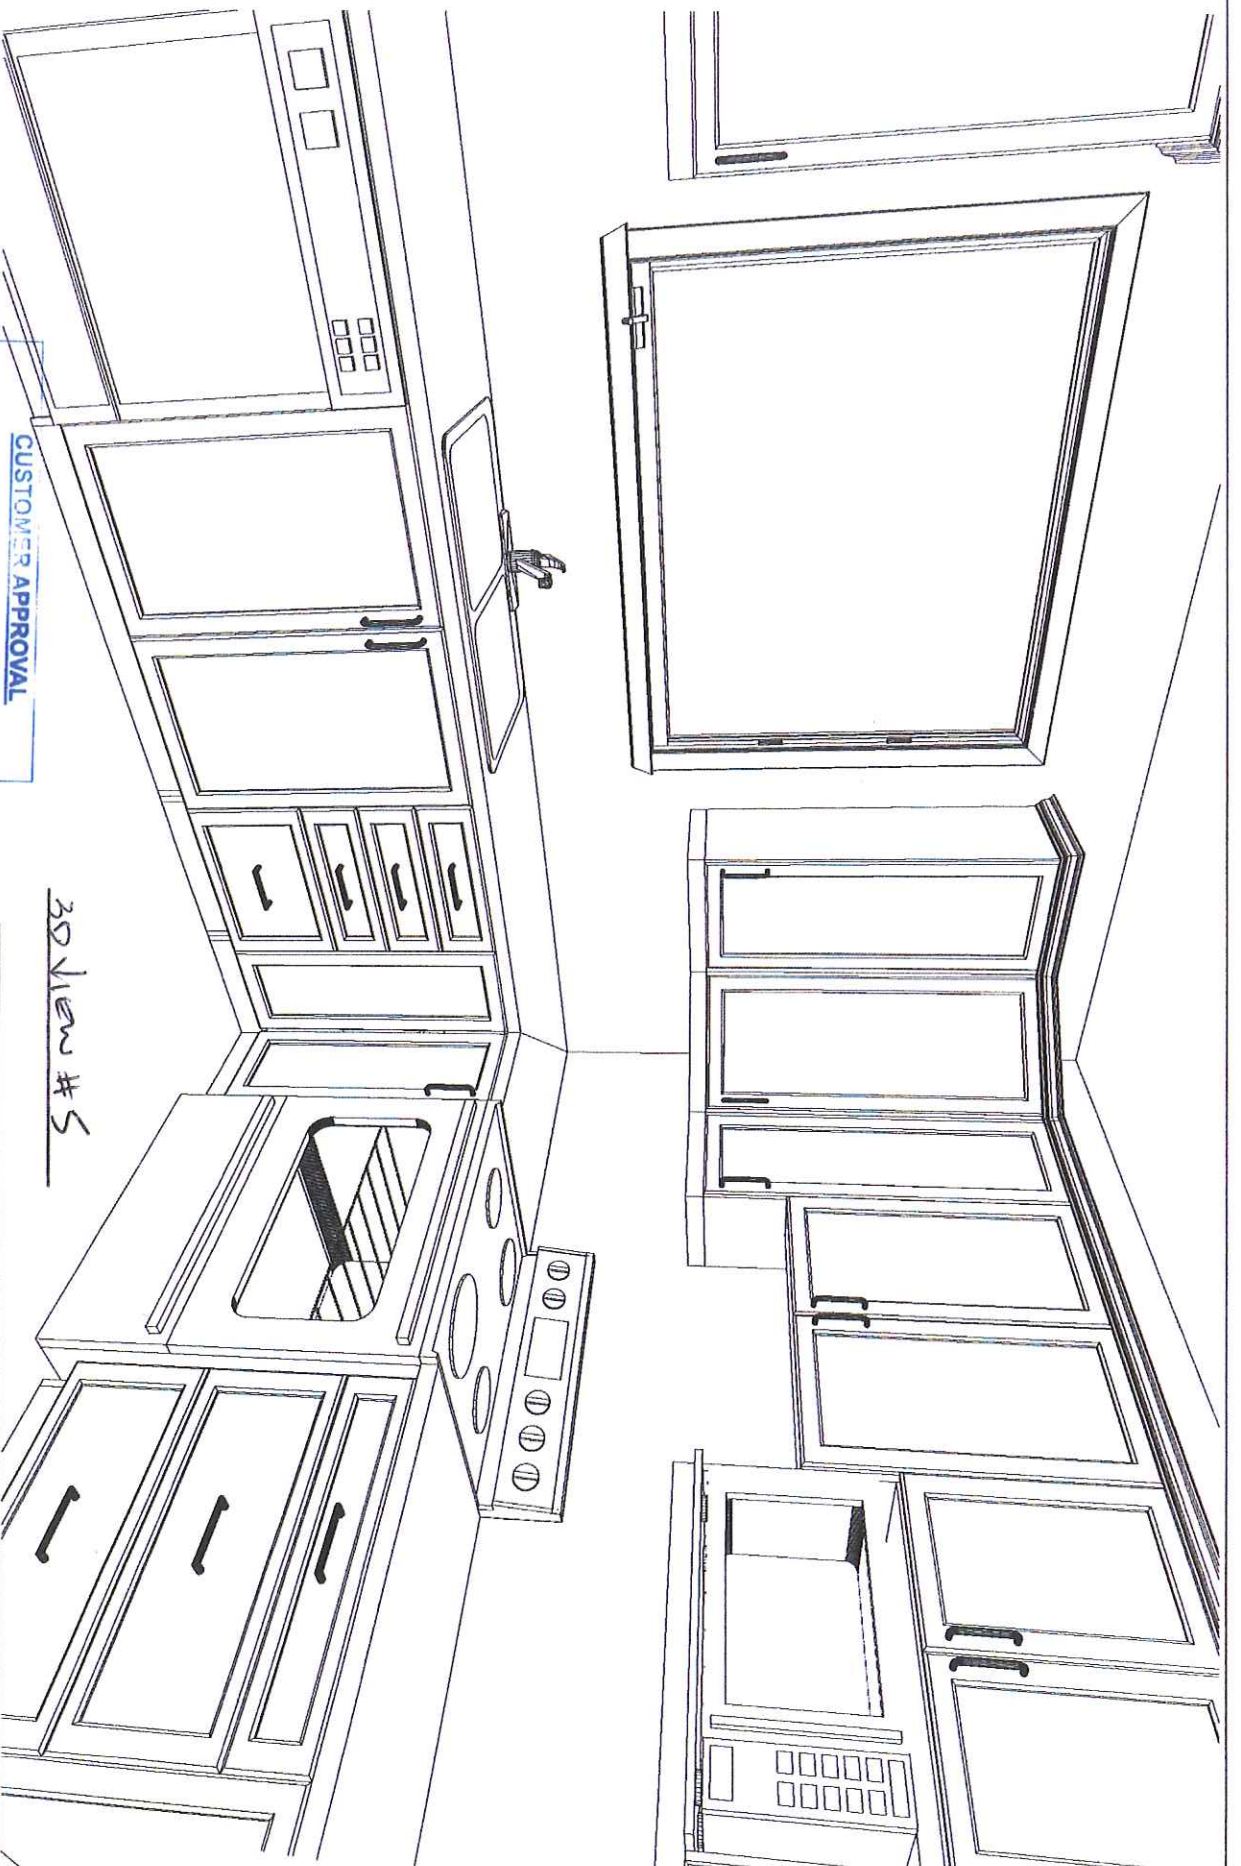

CUSTOMER APPROVAL

I have reviewed these drawings and understand the details of the layout and the Carter Kitchens specifications.

Signature

[Handwritten signature]

Date

Aug. 22/13

3D View #5

Note: This drawing is an artistic interpretation of the general appearance of the design. It is not meant to be an exact rendition.

DRAWN BY: LORI DISAVERIO, B.I.D.

DCR - #75 SR2 - BABYLONIAN (S3) - KITCHEN

All

Drawing #: 1

2020
TECHNOLOGIES

option
KITCHENS

Designed: 5/26/2013
Printed: 5/26/2013