



3D View # 3
OPT. 2 - 24" d. Pantry & Fridge upper

CUSTOMER APPROVAL

I have reviewed these drawings and understand the details of the layout and the Cartier Kitchens specifications.

Signature

(Signature)

Date

Note: This drawing is an artistic interpretation of the general appearance of the design. It is not meant to be an exact rendition.




Designed: 11/4/2012
 Printed: 11/4/2012



DESIGNED BY: LORI DISAVERIO,

DCR - #83 SR2 - GREGORIAN (S1) - KITCHEN - All

Drawing #: 1

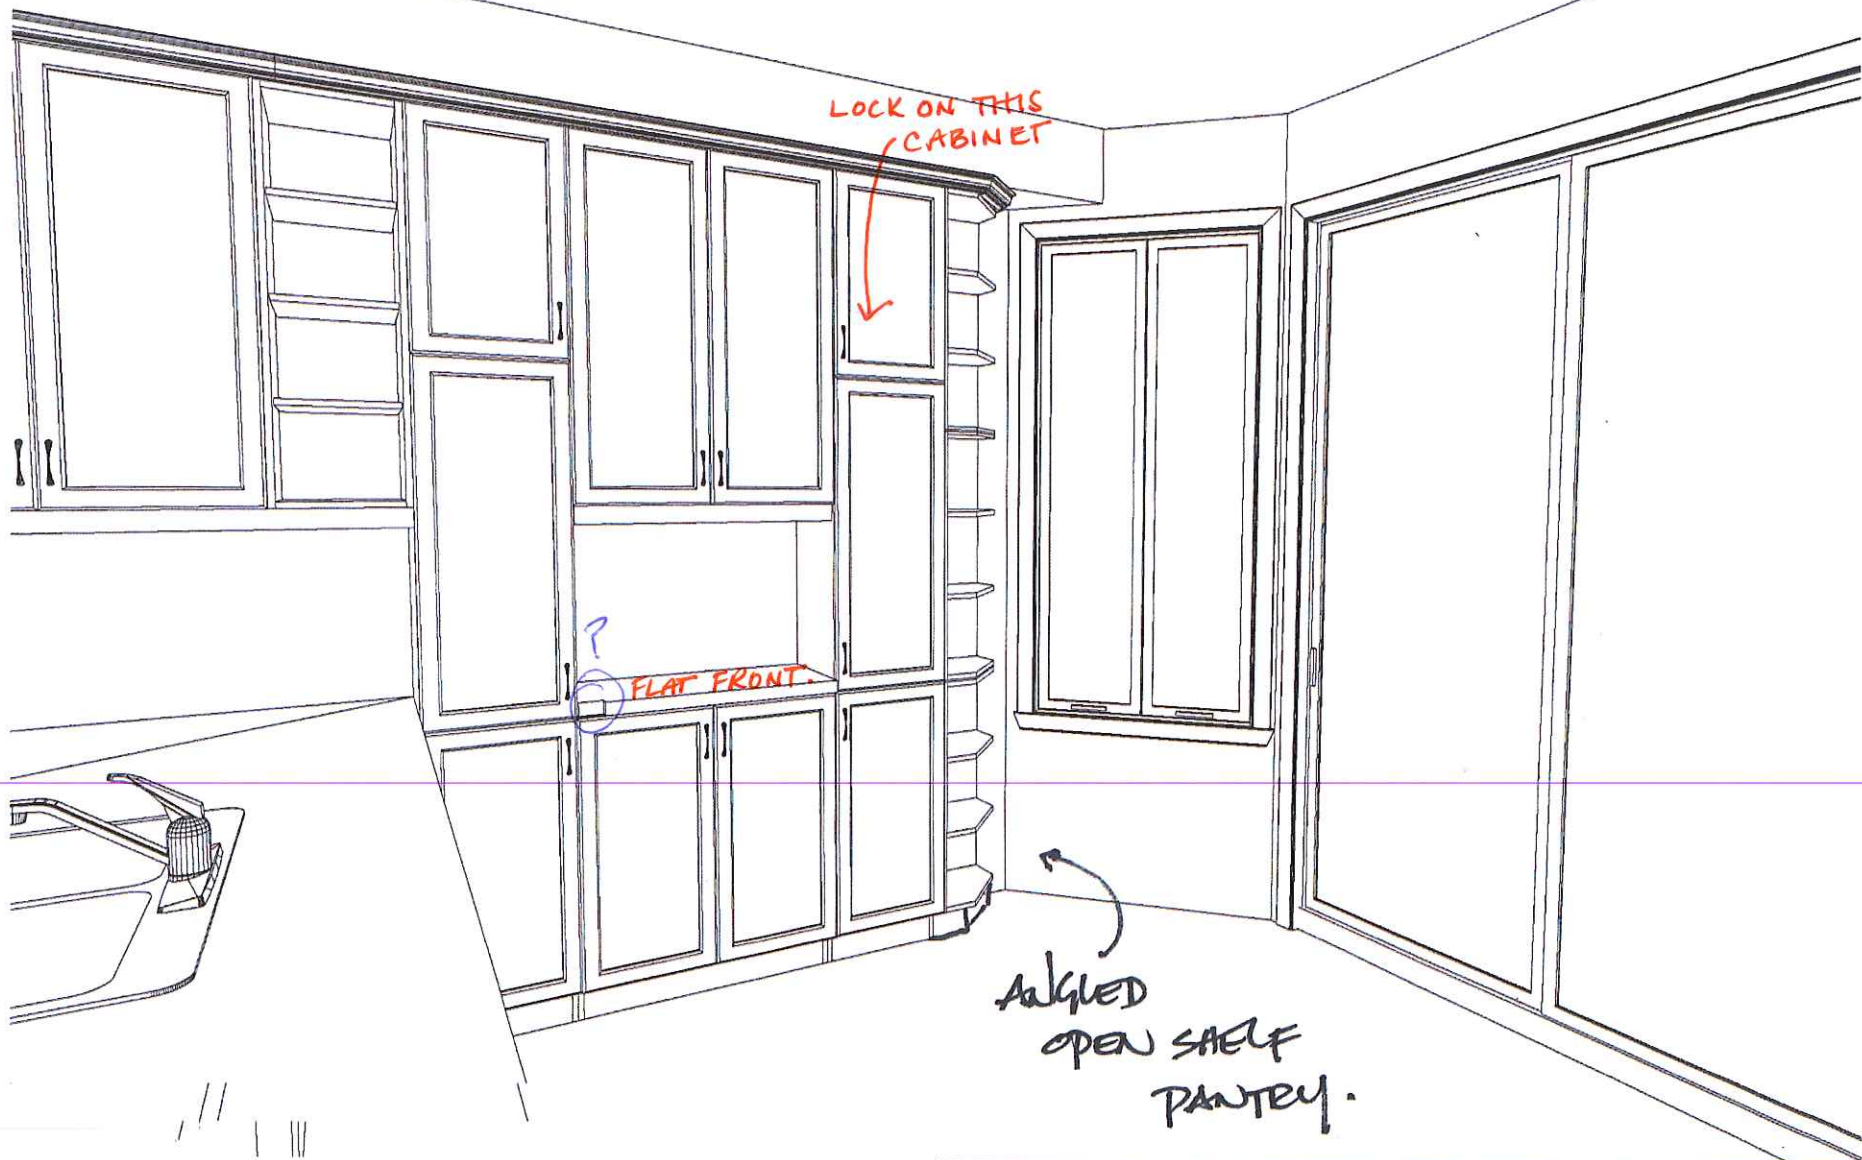

(X) EB
 (X) Steve B...

Note: This drawing is an artistic interpretation of the general appearance of the design. It is not meant to be an exact rendition.



Designed: 2/3/2013
Printed: 2/3/2013



DESIGNED BY: LORI DISAVERIO,

DCR - #83 SR2 - GREGORIAN (S1) - KITCHEN All

Drawing #: 1



Angled
OPEN SHELF
PANTRY

(X) EB

(X) Steve Brown

Note: This drawing is an artistic interpretation of the general appearance of the design. It is not meant to be an exact rendition.



Designed: 2/3/2013
Printed: 2/3/2013




DESIGNED BY: LORI DISAVERIO.

DCR - #83 SR2 - GREGORIAN (S1) - KITCHEN All

Drawing #: 1

CHIMNEY HOOD

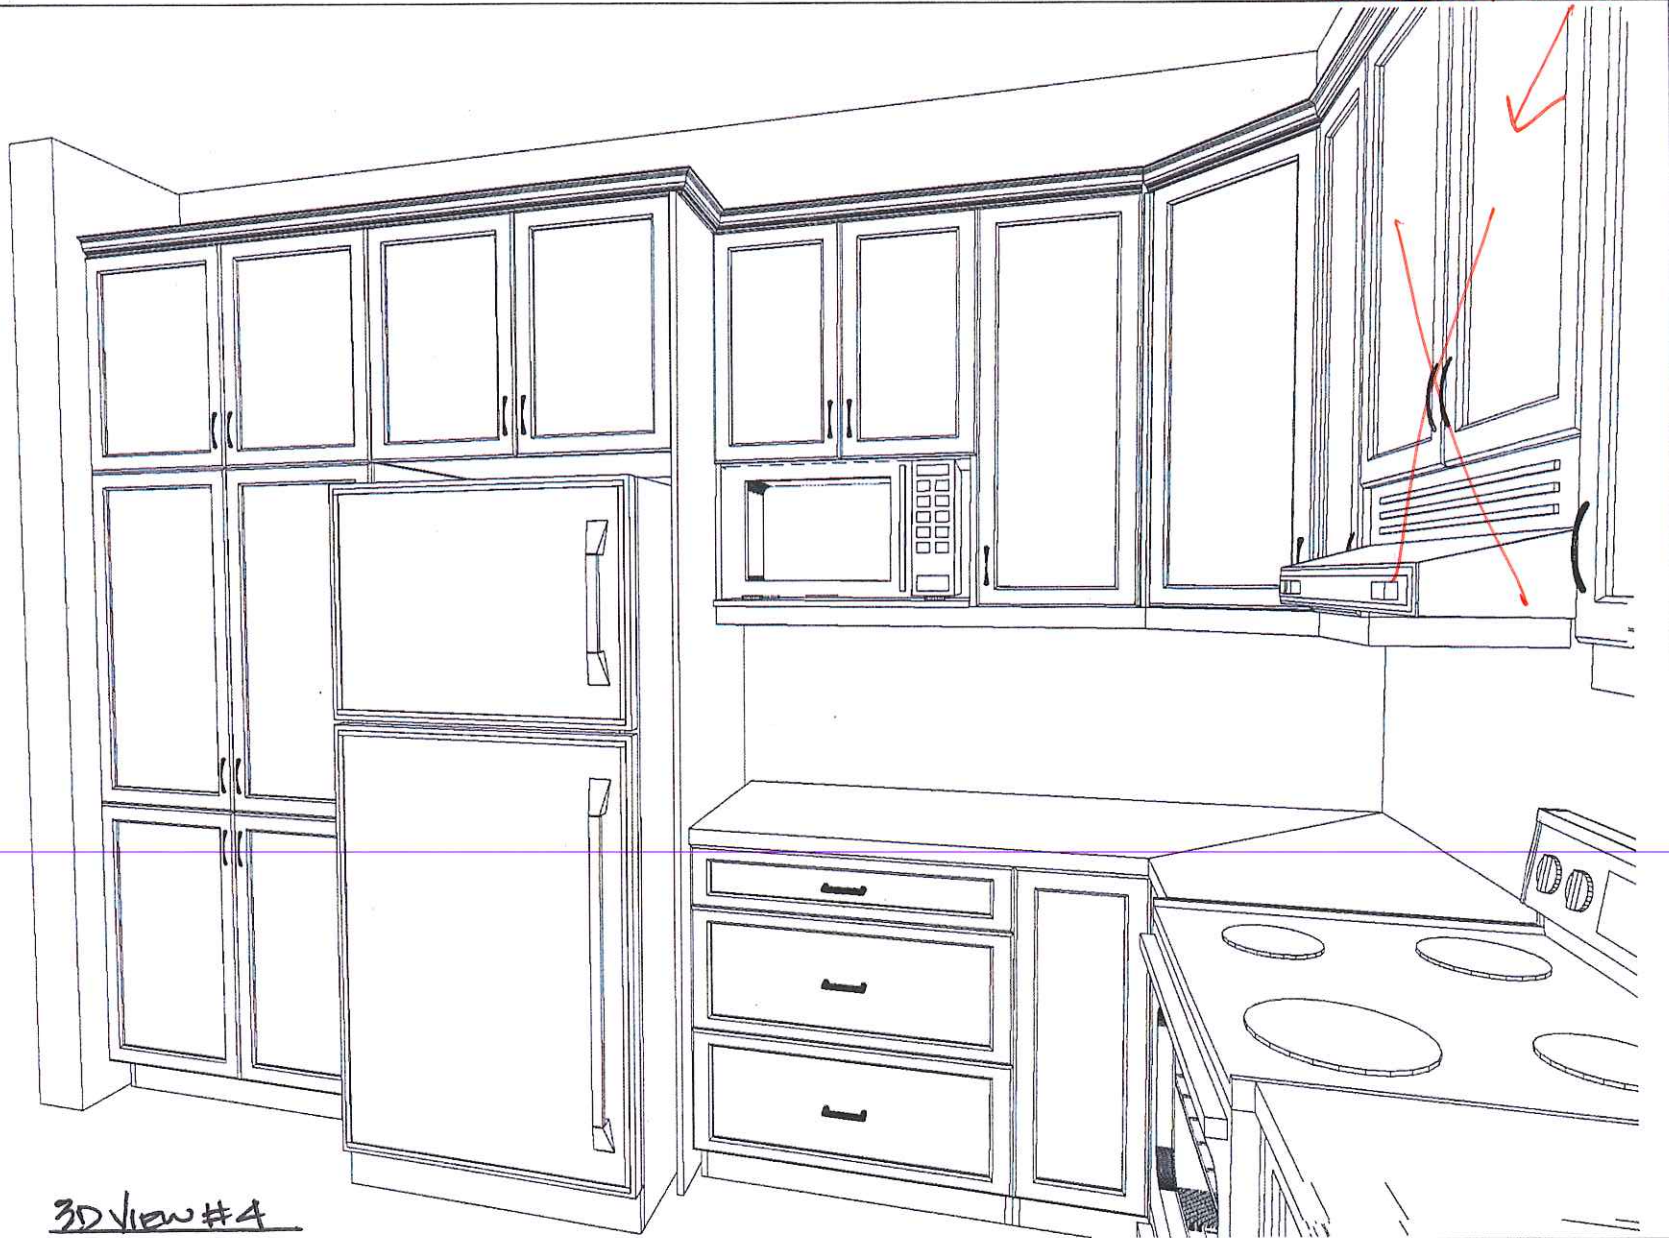

3D View #4

CUSTOMER APPROVAL

I have reviewed these drawings and understand the details of the layout and the Cartier Kitchens specifications.

Signature



Date

2pt. 2- 24" d. Pantry

Fridge upper

Note: This drawing is an artistic interpretation of the general appearance of the design. It is not meant to be an exact rendition.

DESIGNED BY: LORI DISAVERIO.

DCR - #83 SR2 - GREGORIAN (S1) - KITCHEN - All



Designed: 11/4/2012
Printed: 11/4/2012

Drawing #: 1