


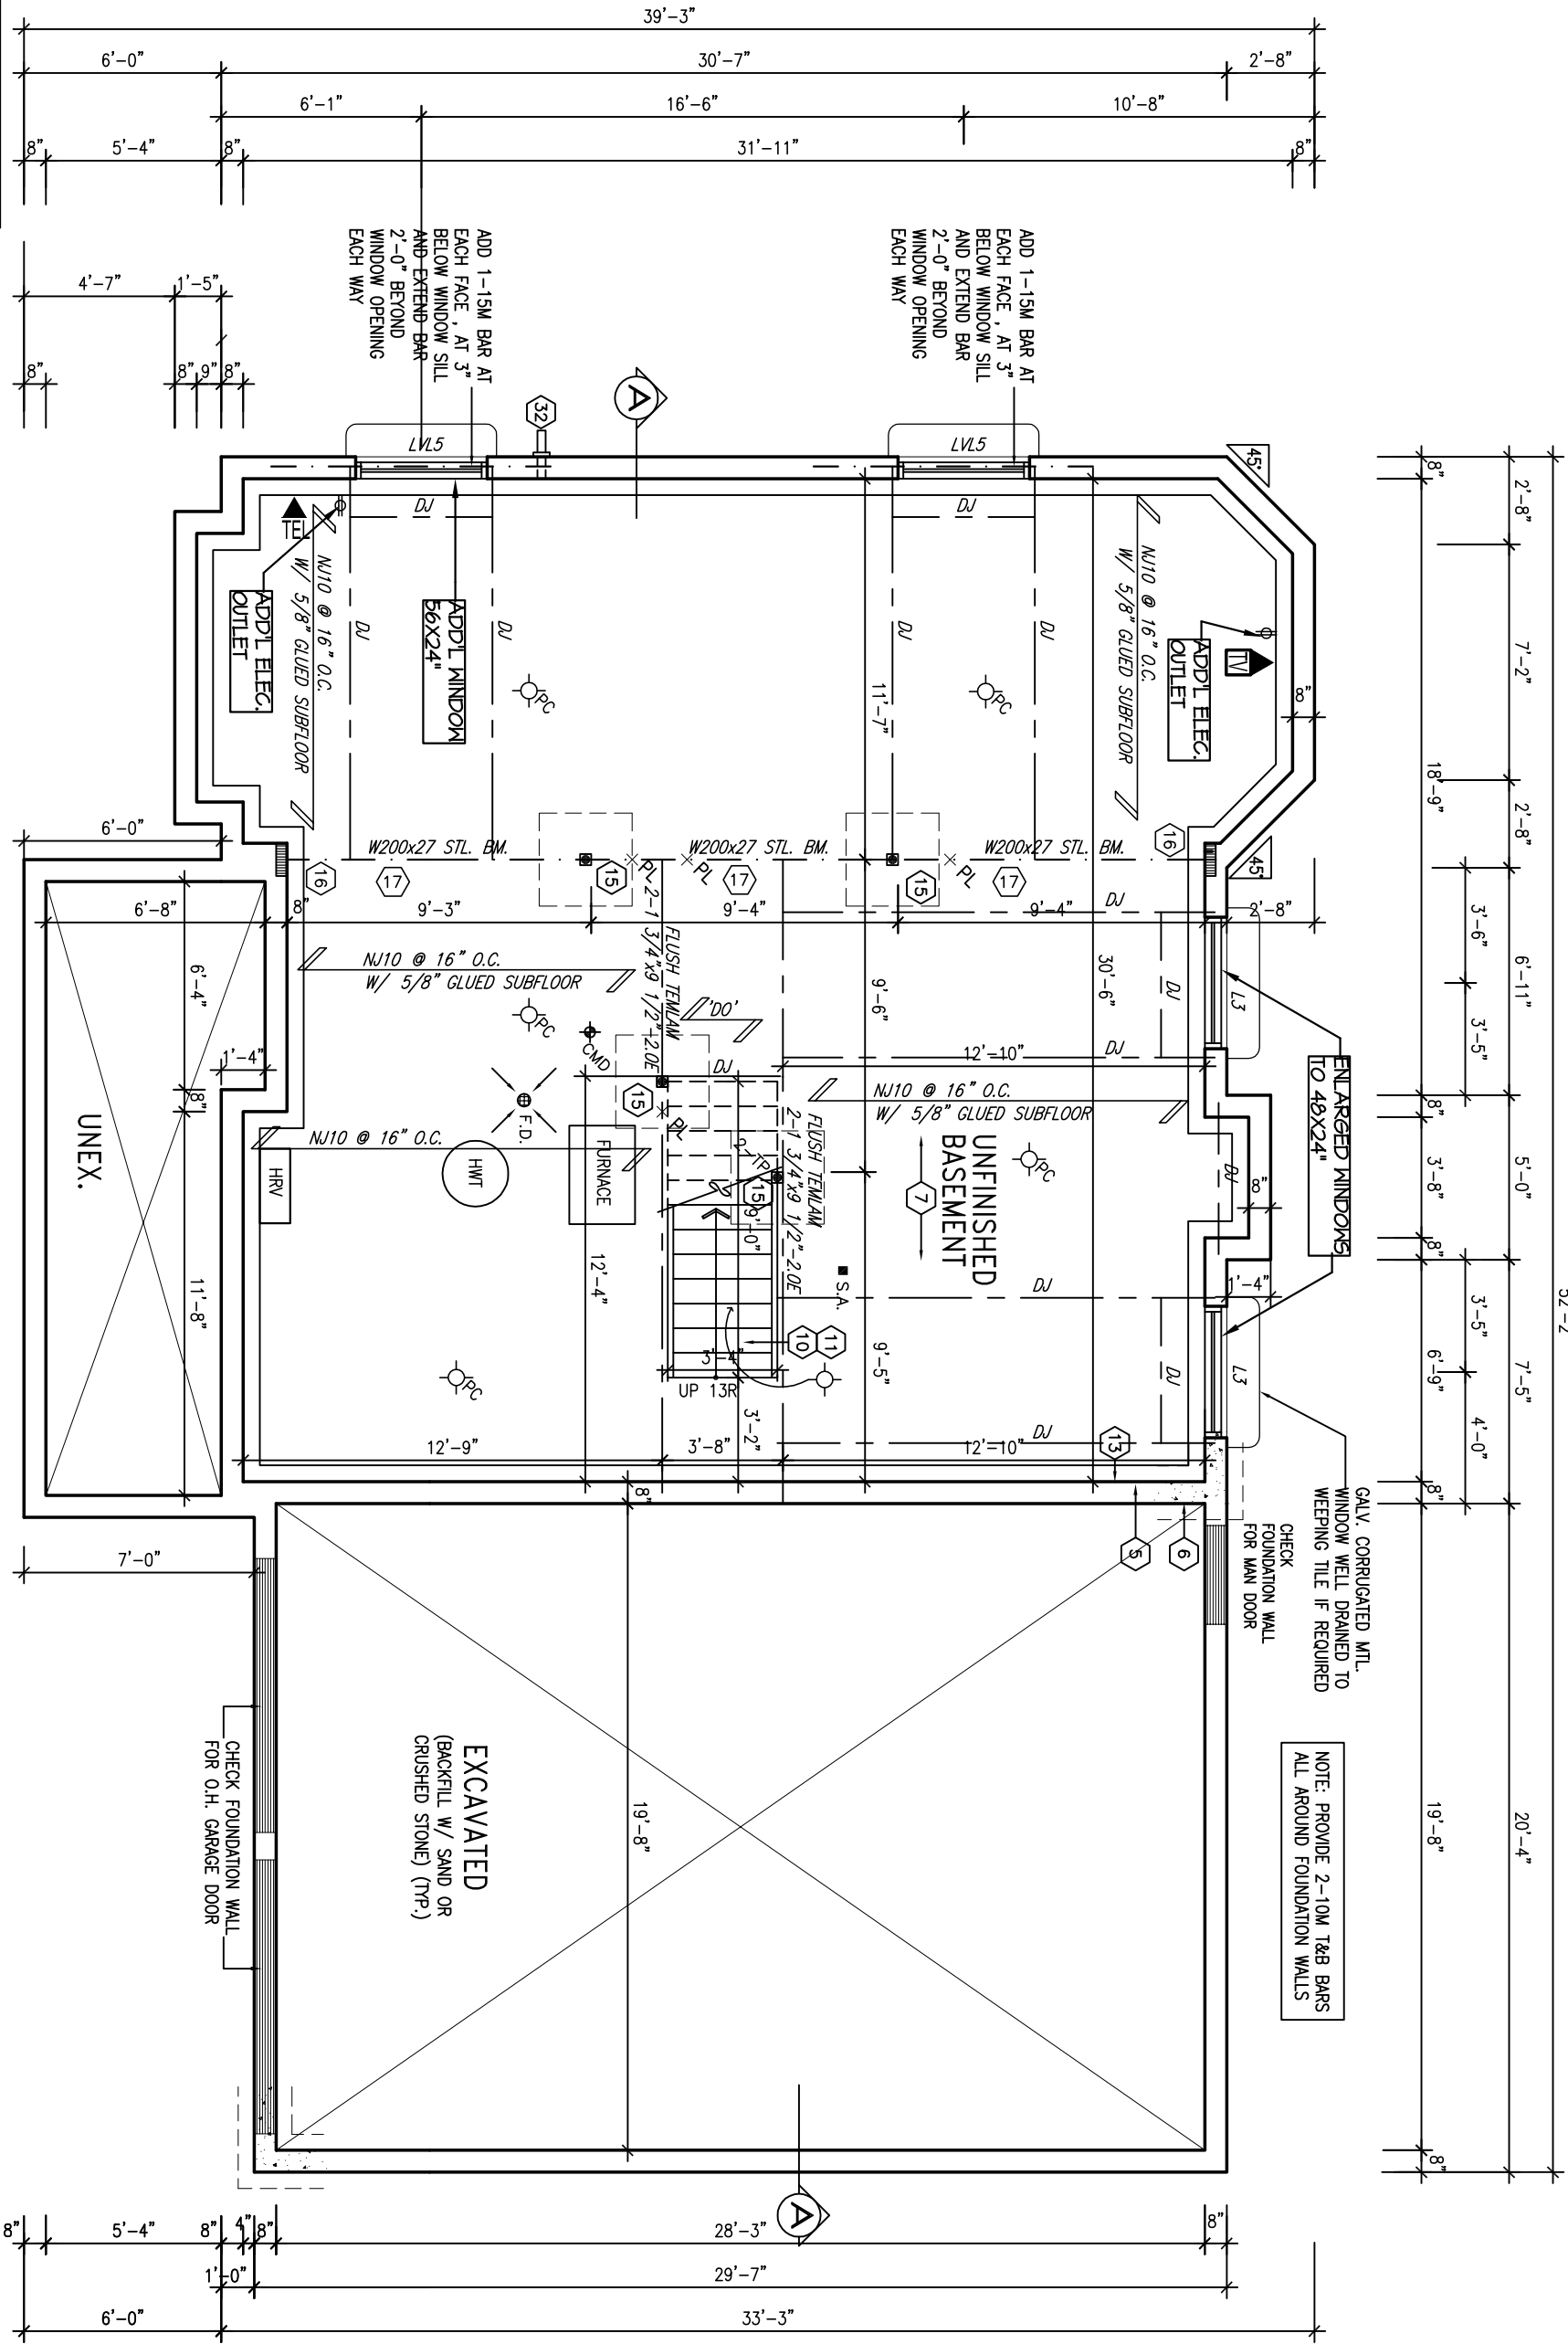


AREA CALCULATIONS		ELEV. B
GROUND FLOOR AREA	1009 SF	
SECOND FLOOR AREA	1000 SF	
SUBTOTAL	2009 SF	
DEDUCT ALL OPEN AREAS	36 SF	
TOTAL NET AREA	1973 SF	
	(183.29 m2)	
FINISHED BSMT AREA	0 SF	
COVERAGE	1437 SF	
W/OUT PORCH	(133.50 m2)	
COVERAGE	1566 SF	
W/ PORCH	(143.48 m2)	

BASEMENT PLAN 'B'

NOTE:
ALL LVL'S SUPPORTING FLOOR
LOADS ARE TO BE SPECIFIED BY
THE FLOOR TRUSS MANUFACTURER.

NOTE:
FRAMING INFO REFER TO NOTT SHOP
DRAWINGS FOR ALL TRUSS--JOIST INFORMATION
AND DETAILS. UNLESS OTHERWISE NOTED.

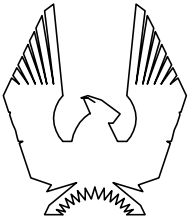

PHOENIX HOMES

Viljoen
Architect
Inc.

300 A Wilson Avenue
North York, Ontario
M3H 1S8
TEL: (416) 630-2255
FAX: (416) 630-4782

GREGORIAN-2007-B

SITE: SHADOW RIDGE2

LOT NUMBER:

CIVIC ADDRESS:
1605 STONECROP AVE.


83

2	REV. AS PER CONST. SUMMARY	JUL26-13	SD		
1	REV. AS PER CONST. SUMMARY	APR24-13	SD		
No.	Description	Date	By		
REVISIONS					

Footprint: SI-B
sht. title: BASEMENT PLAN-B
drawn by: CL
checked by: OF
date: FEB. 2007
scale: 3/16"=1'

sheet no:

1B
6

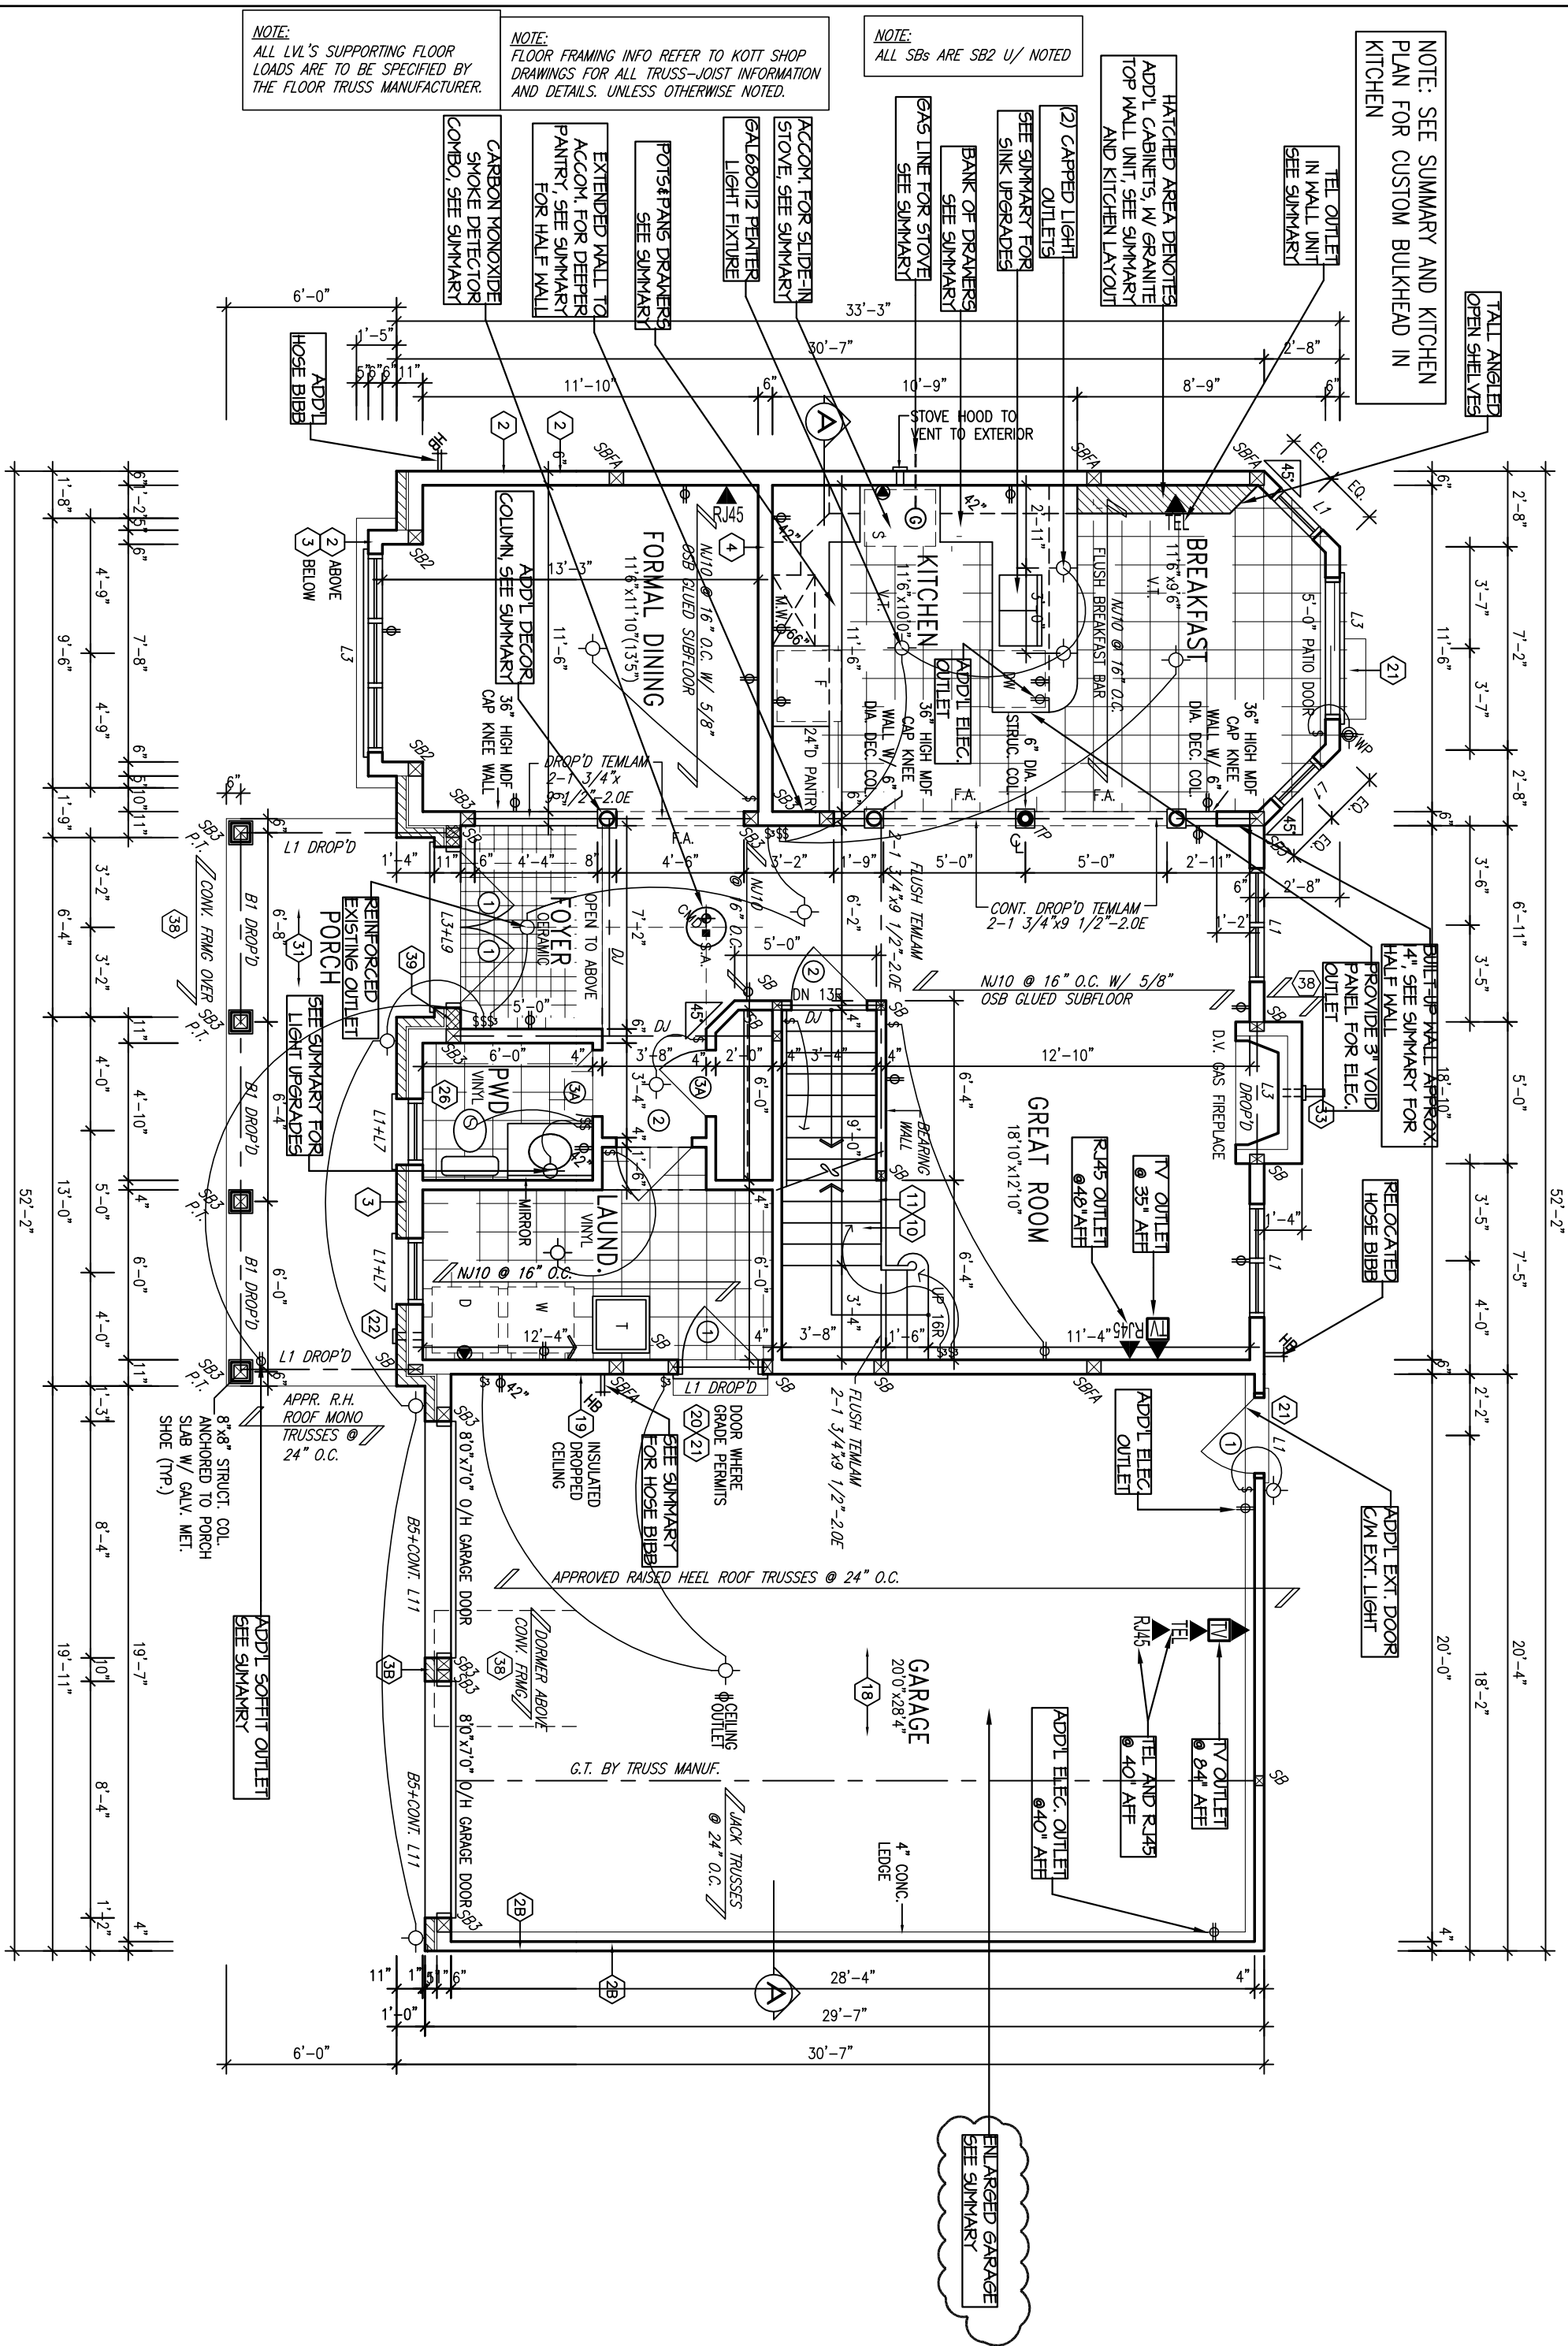

300 A Wilson Avenue
North York, Ontario
M3H 1S8
TEL: (416) 630-2255
FAX: (416) 630-4782

GREGORIAN-2007-B

SITE: SHADOW RIDGE2

LOT NUMBER:

CIVIC ADDRESS:
1605 STONECROP AVE.

83

2	REV. AS PER CONST. SUMMARY	JUL26-13	SD
1	REV. AS PER CONST. SUMMARY	APR24-13	SD
No.	Description	Date	By
REVISIONS			

footprint:	SI-B
sht. title:	GROUND FLOOR-B
drawn by:	CL
checked by:	OF
date:	FEB. 2007
scale:	3/16"=1'



sheet no:

$$\frac{2B}{6}$$

NOTE:
ALL SBS ARE SB2 U/ NOTED

NOTE:
ROOF TRUSS INFORMATION REFER TO ROOF TRUSS SHOP DRAWINGS FOR ALL ROOF FRAMING INFORMATION UNLESS OTHERWISE NOTED.

NOTE: ROOF FRAMING INFORMATION:
ALL LAMINATED VENEER LUMBER (LVL) BEAMS, BUILT-UP BEAMS,
GIRDER TRUSSES AND METAL HANGER CONNECTIONS SUPPORTING
ROOF FRAMING TO BE DESIGNED AND CERTIFIED BY ROOF TRUSS
MANUFACTURER. REFER TO ROOF TRUSS SHOP DRAWINGS FOR
ALL ROOF FRAMING INFORMATION UNLESS OTHERWISE NOTED ON
ARCHITECTURAL DRAWINGS.

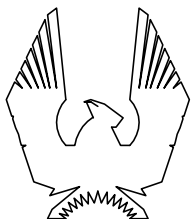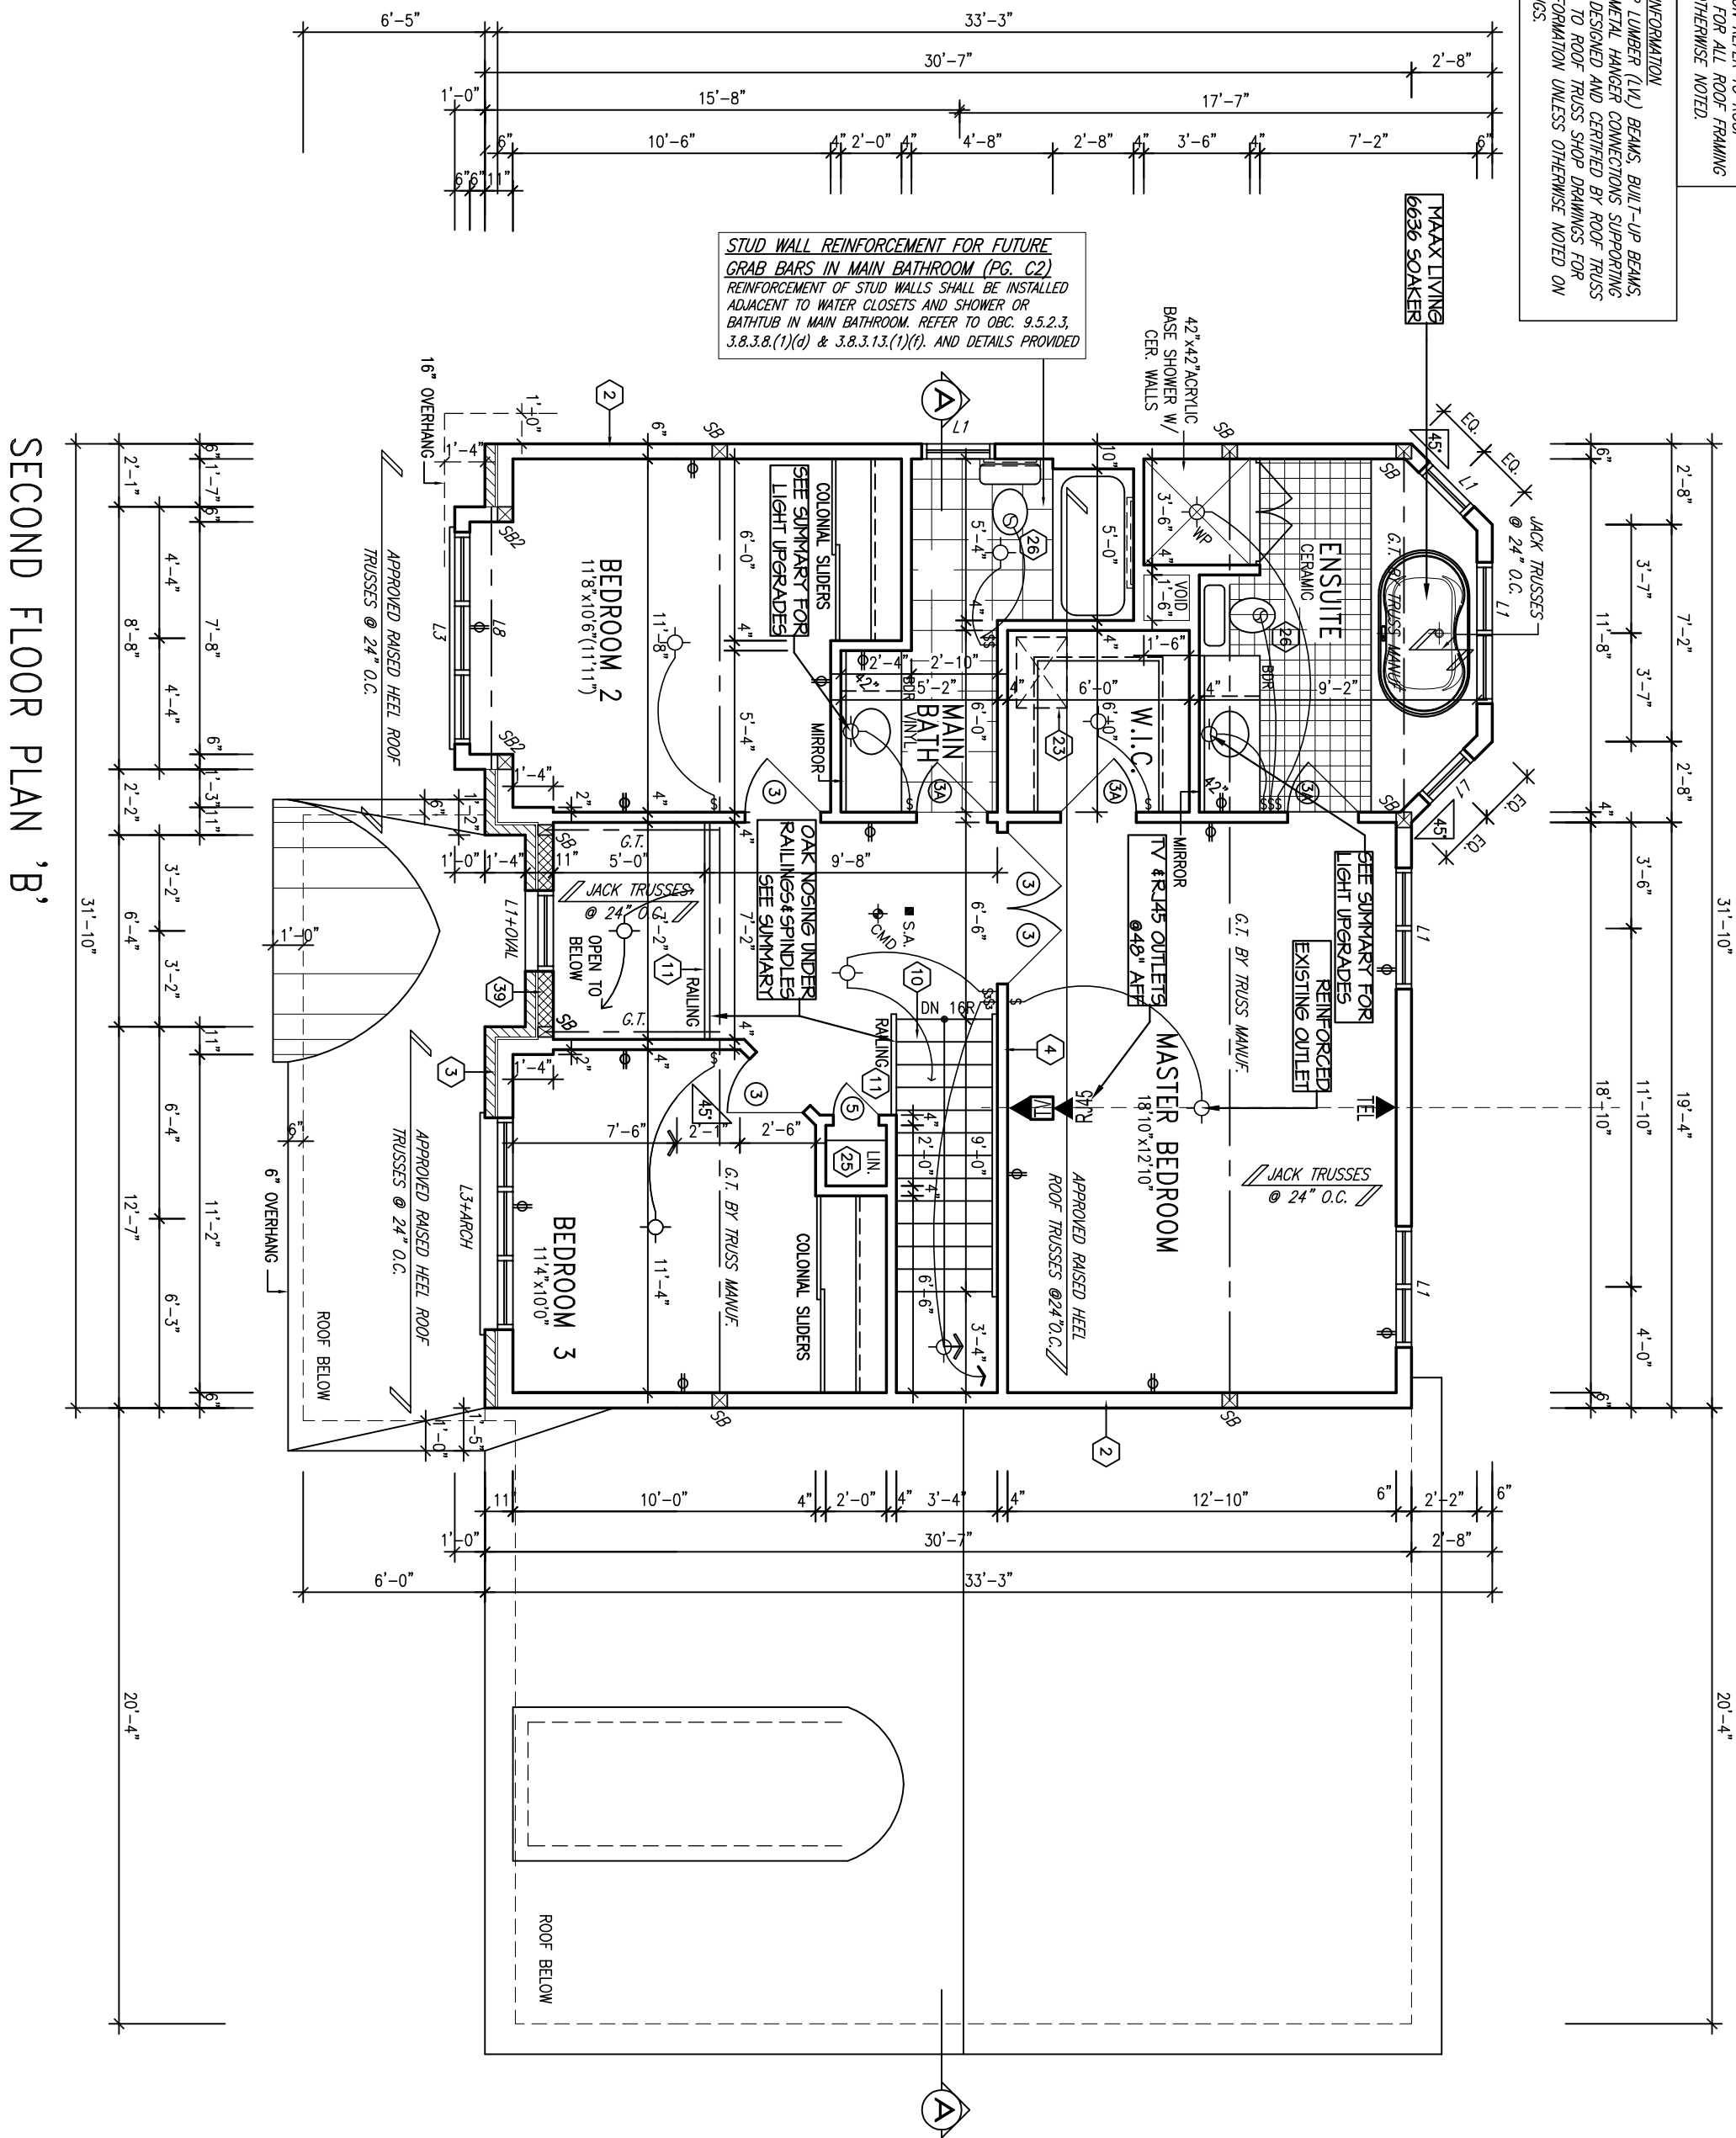

Viljoen
Architect
Inc.

300 A Wilson Avenue
North York, Ontario
M3H 1S8
TEL: (416) 630-2255
FAX: (416) 630-4782

GREGORIAN-2007-B

SITE: SHADOW RIDGE2


LOT NUMBER:

CIVIC ADDRESS:
1605 STONECROP AVE.

83


2	REV. AS PER CONST. SUMMARY	JUL26-13	SD
1	REV. AS PER CONST. SUMMARY	APR24-13	SD
No.	Description	Date	By
REVISIONS			

footprint: 51-B	
sht. title: SECOND FLOOR-B	
drawn by: CL	
checked by: OF	
date: FEB. 2007	
scale: 3/16"=1'	
sheet no:	

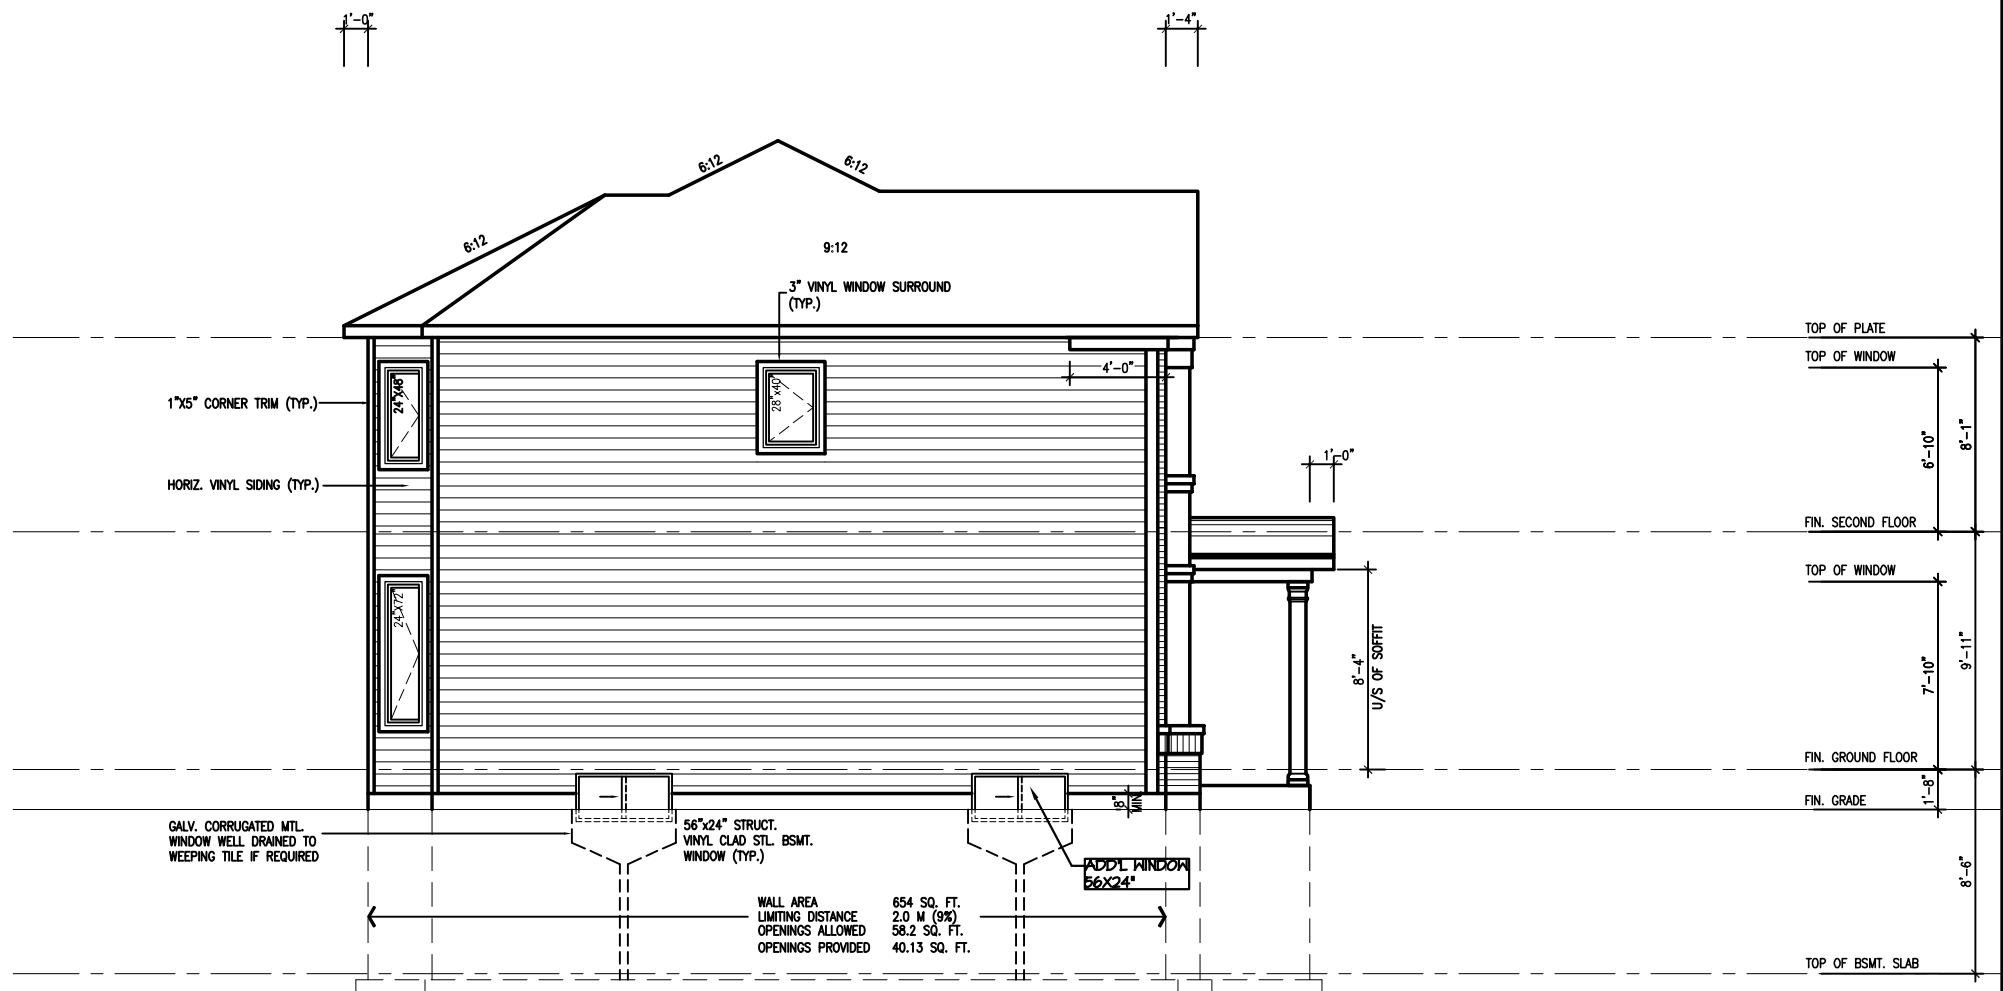


LEFT ELEVATION 'B'

NOTE:
REFER TO FRONT ELEVATION FOR TYPICAL
NOTES & INFORMATION

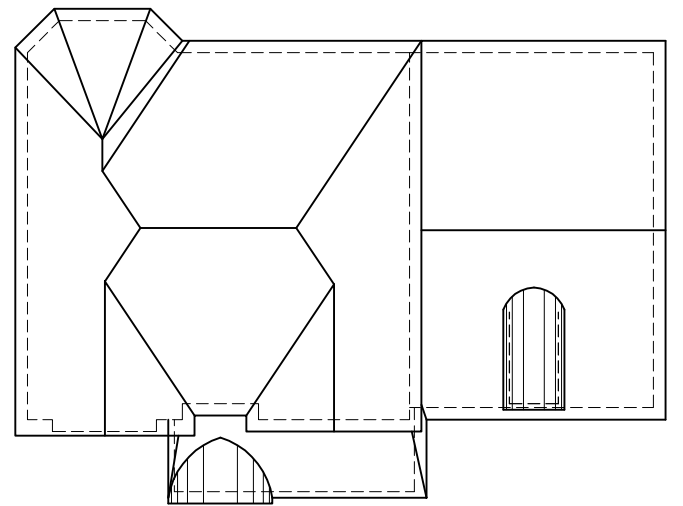


ROOF PLAN 'B'

N.T.S.

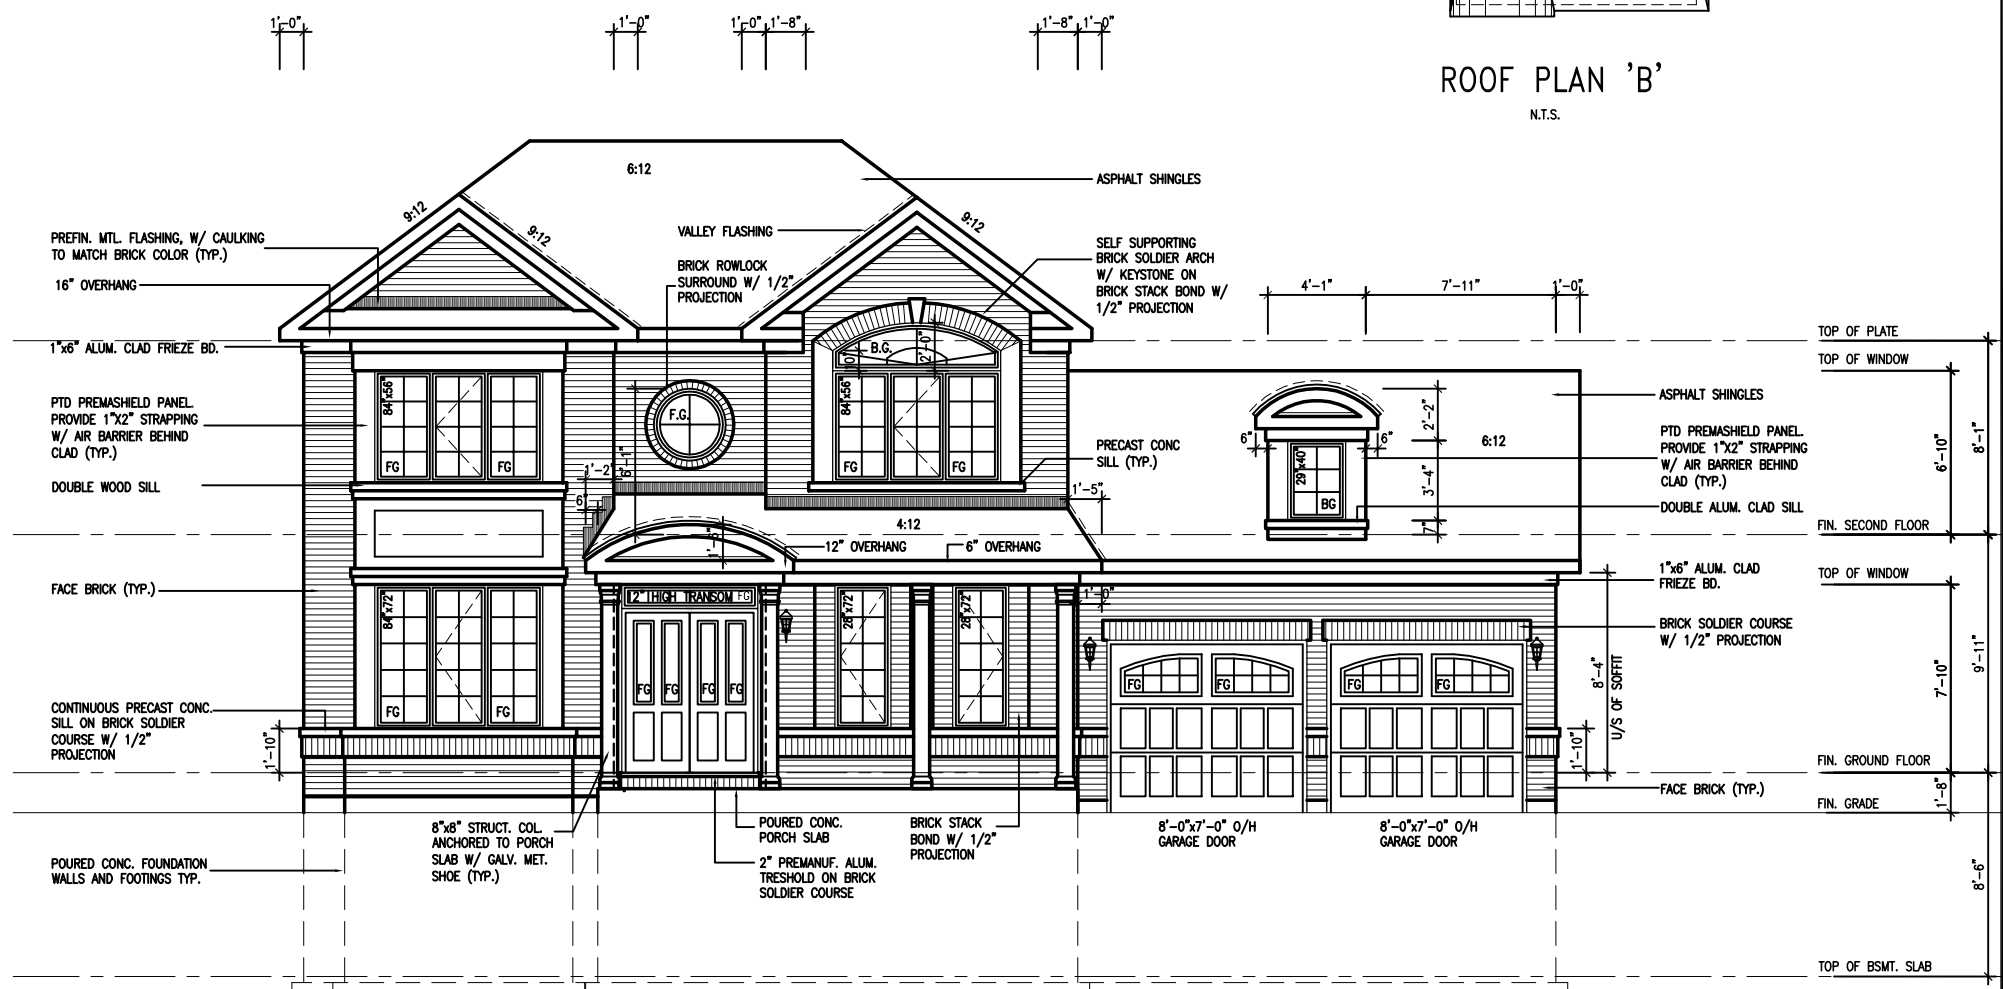

FRONT ELEVATION 'B' (ALL BRICK FRONT)

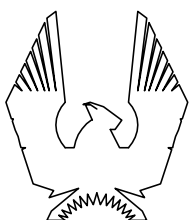

PHOENIX HOMES

**Viljoen
Architect
Inc.**

300 A Wilson Avenue
North York, Ontario
M3H 1S8
TEL: (416) 630-2255
FAX: (416) 630-4782

GREGORIAN-2007-B

SITE: SHADOW RIDGE2

LOT NUMBER:

83

CIVIC ADDRESS:
1605 STONECROP AVE.

No.	Description	Date	By
2	REV. AS PER CONST. SUMMARY	JUL26-13	SD
1	REV. AS PER CONST. SUMMARY	APR24-13	SD
REVISIONS			

Footprint: SI-B

sht. title: ELEVATIONS-B

drawn by: CL



checked by: OF

date: FEB. 2007

scale: 1/8"=1'

sheet no:

4B
6

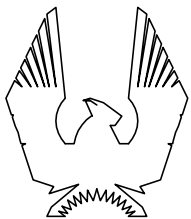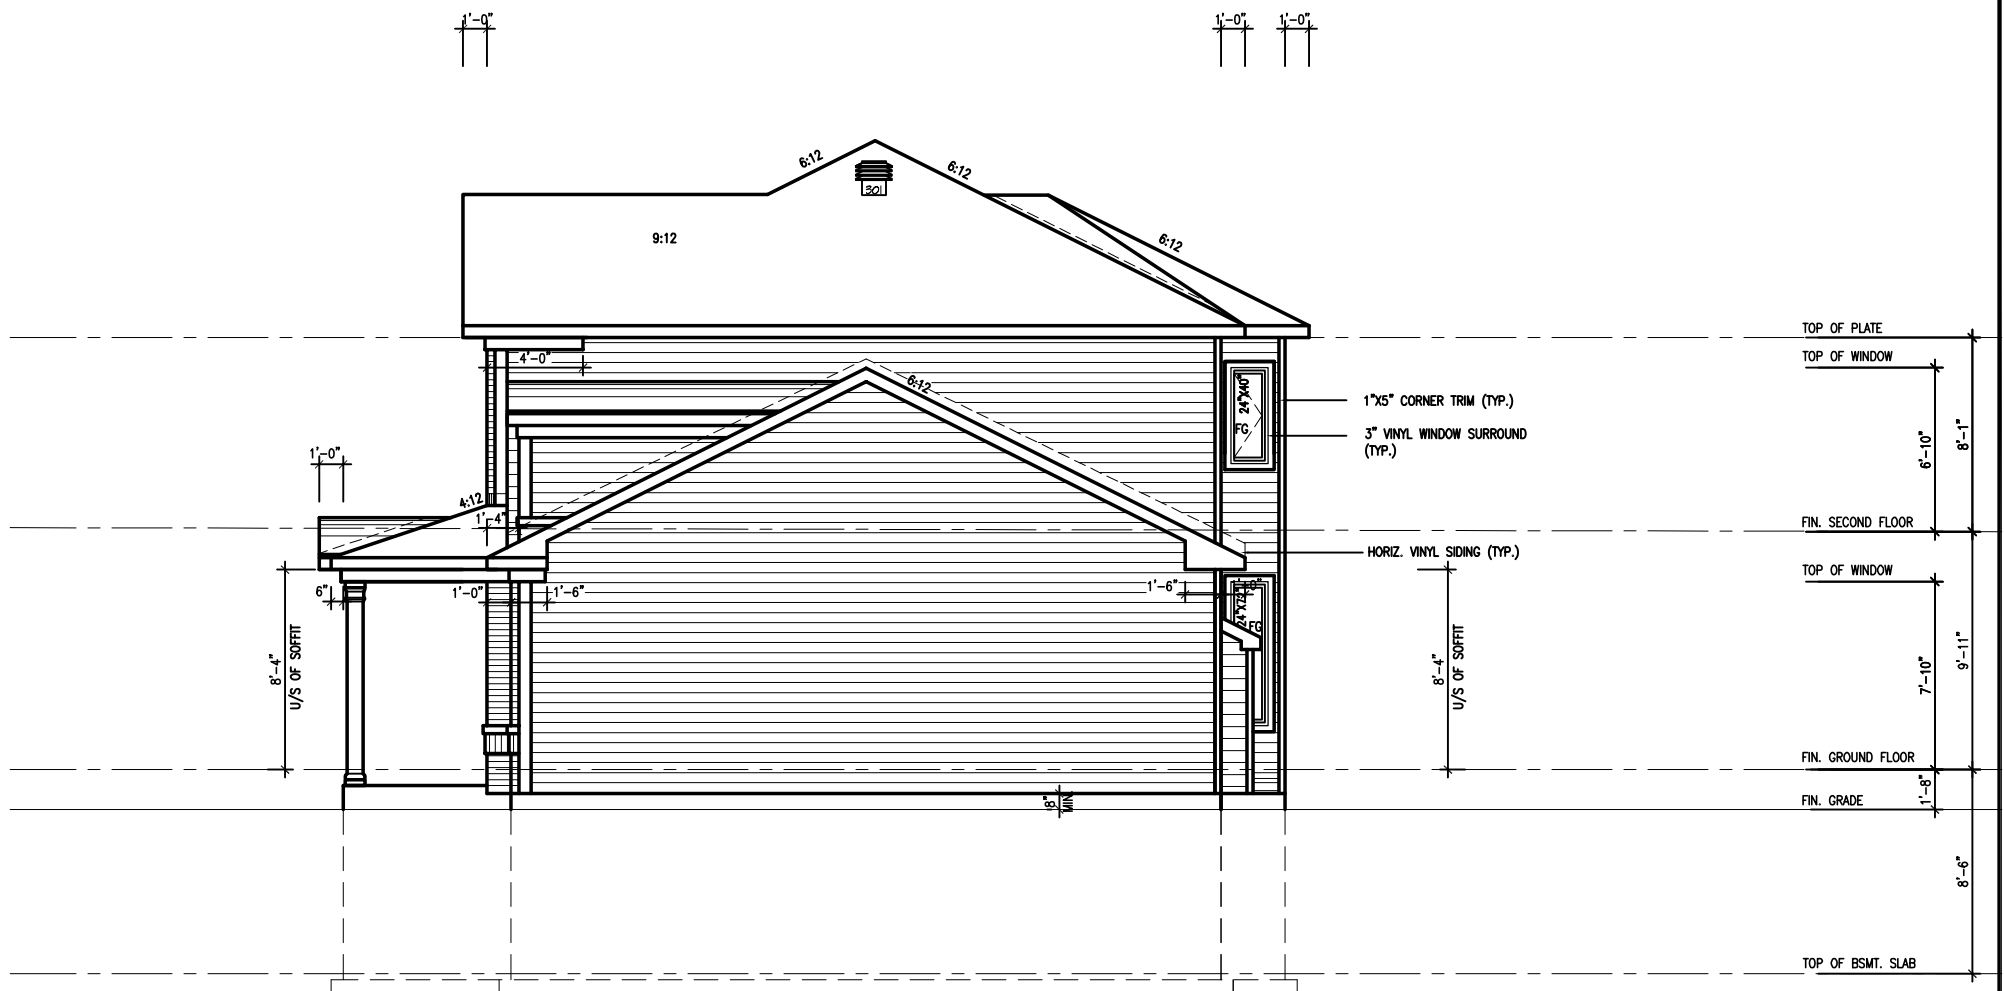

PHOENIX HOMES

**Viljoen
Architect
Inc.**

300 A Wilson Avenue
North York, Ontario
M3H 1S8
TEL: (416) 630-2255
FAX: (416) 630-4782

GREGORIAN-2007-B

SITE: SHADOW RIDGE2

LOT NUMBER:

CIVIC ADDRESS:
1605 STONECROP AVE.

83

NOTE:
REFER TO FRONT ELEVATION FOR TYPICAL
NOTES & INFORMATION

No.	Description	Date	By
2	REV. AS PER CONST. SUMMARY	JUL26-13	SD
1	REV. AS PER CONST. SUMMARY	APR24-13	SD
REVISIONS			

Footprint: 51-B

sht. title: ELEVATIONS-B

drawn by: CL


checked by: OF

date: FEB. 2007

scale: 1/8"=1'

sheet no:

5B
6

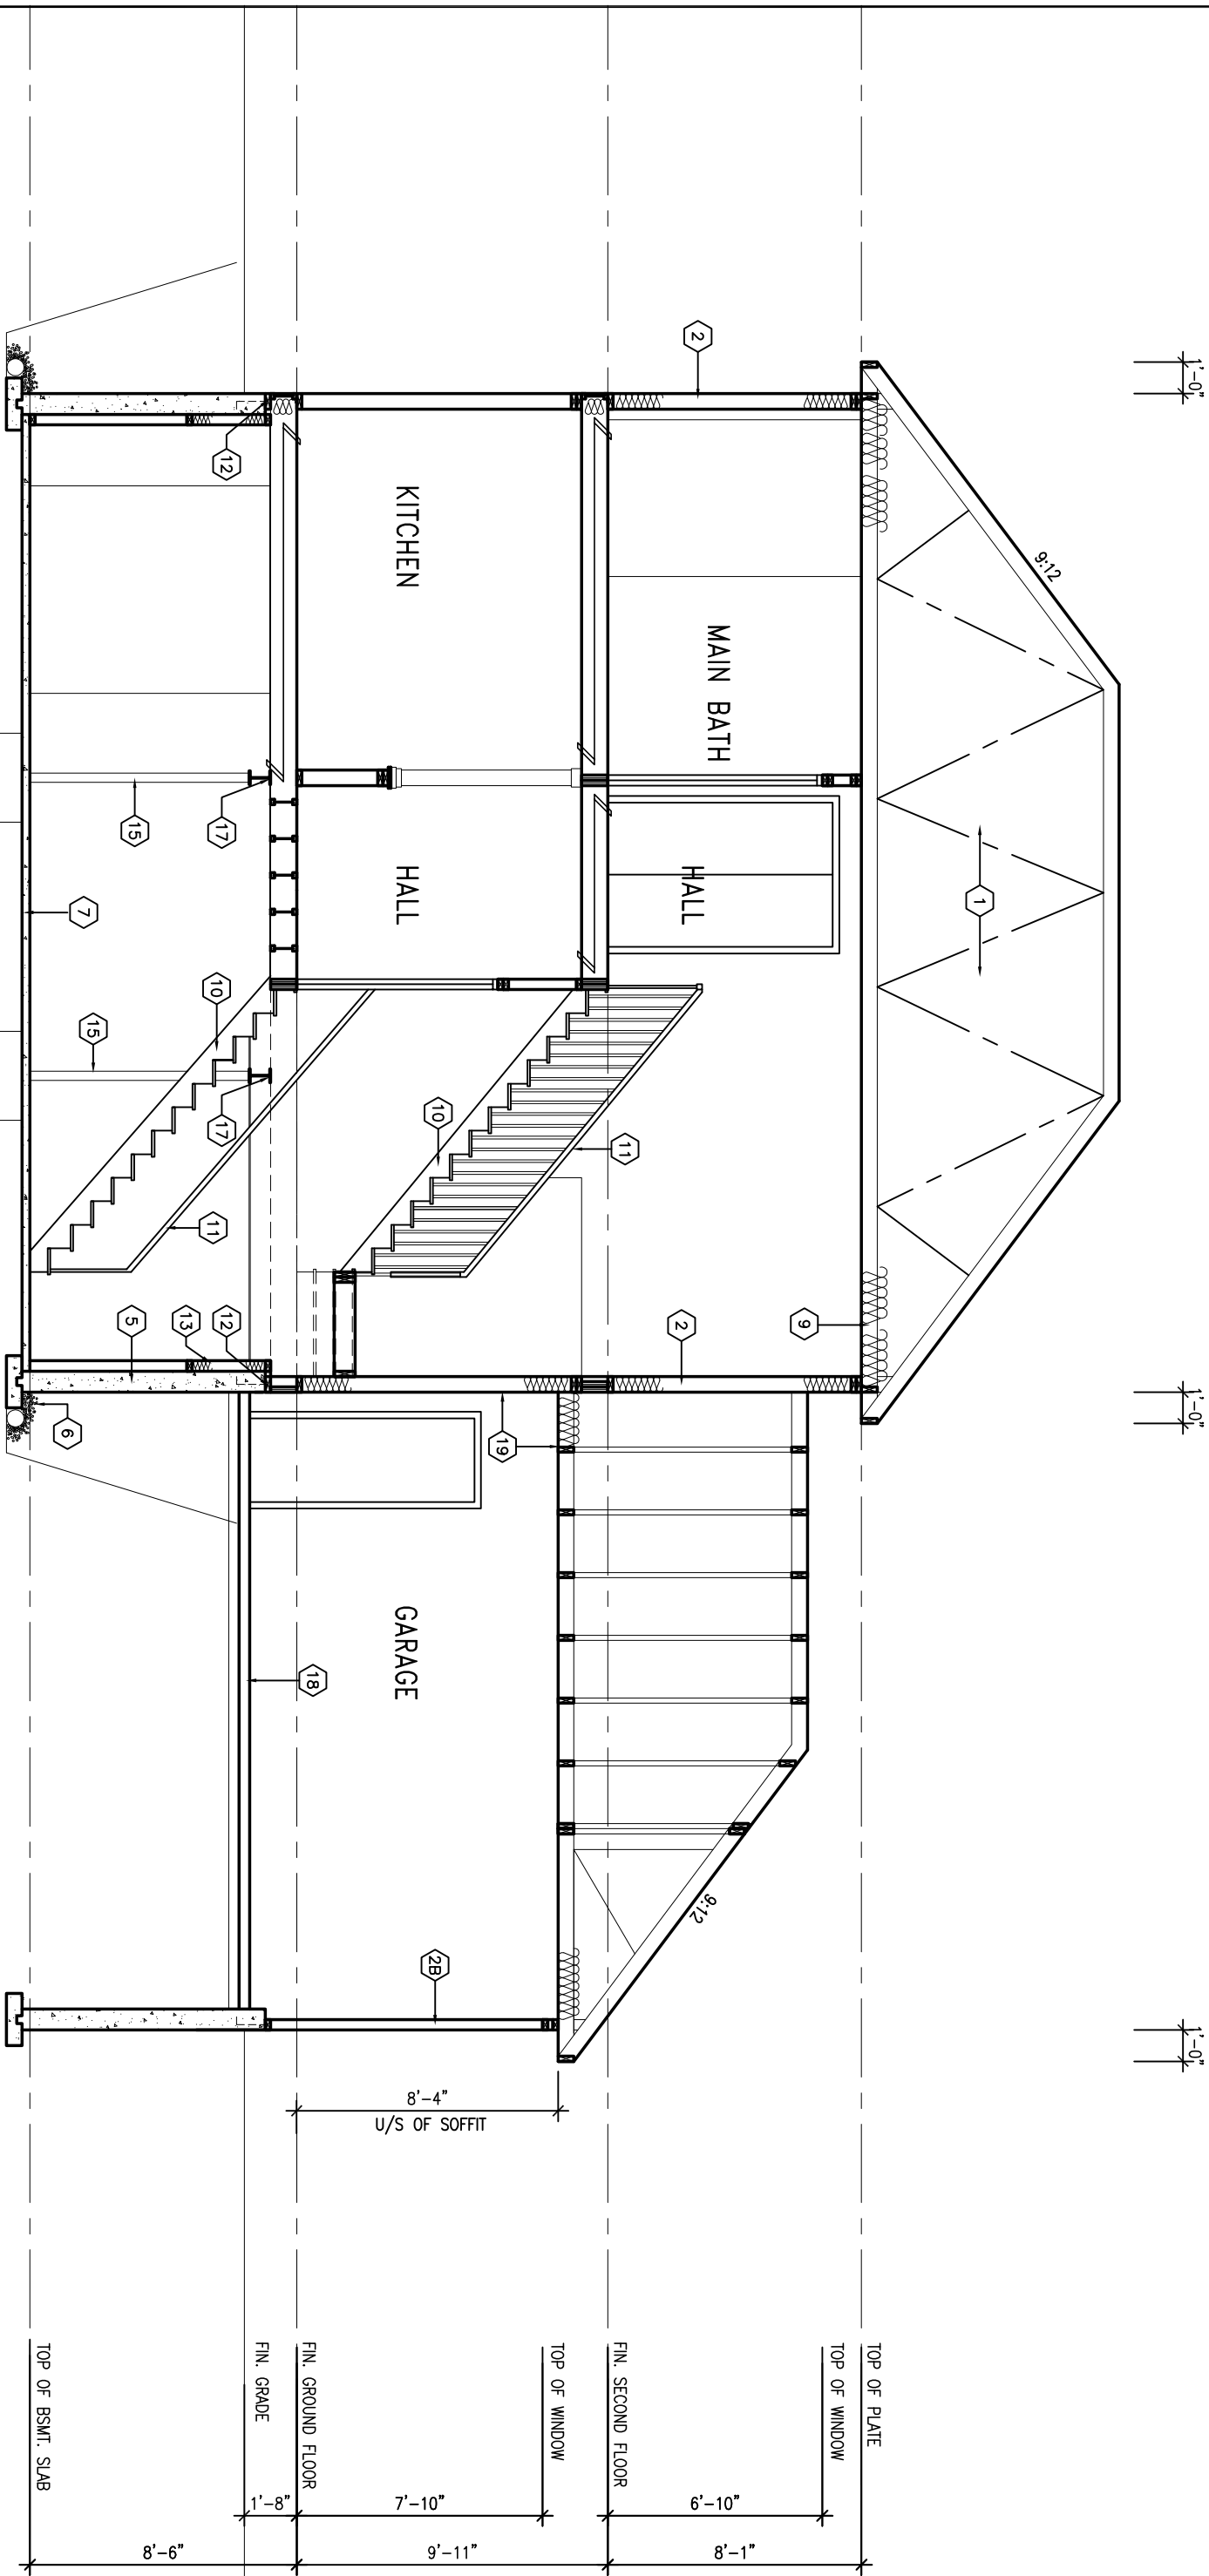


SECTION A-A

GREGORIAN-2007-A

Viljoen
Architect
Inc.

300 A Wilson Avenue
North York, Ontario
M3H 1S8
TEL: (416) 630-2255
FAX: (416) 630-4782

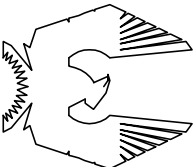

PHOENIX HOMES

SITE: SHADOW RIDGE2

LOT NUMBER:
CIVIC ADDRESS:
1605 STONECROP AVE.

83

REVISIONS		No.	Description	Date	By
1	REV. AS PER CONST. SUMMARY	APR24-13	SD		
2	REV. AS PER CONST. SUMMARY	JUL26-13	SD		

Footprint: S1-A

shl. title: SECTION

drawn by: CL

checked by: OF

date: FEB. 2007

scale: 3/16"=1'

sheet no:

6/6