


SW 7535
SANDY RIDGE

SW 7547
SANDBAR

SW 7633
TAUPE TONE

SW 6227
MEDITATIVE

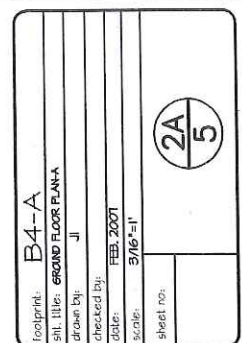

4	REV. AS PER CONST. SUMMARY	AUG14-14	SD
5	ISSUED FOR B.E.P. ONLY	JUL14-14	SD
2	ISSUED FOR B.E.P. ONLY	JUNE14-14	SD
1	FOR PERMIT APPLICATION ONLY	MAY26-14	SD
No.	Description	Date	By
REVISIONS			


B4-A CARTESIAN

SITE: WHITE TAIL RIDGE

LOT NUMBER: 18
CIVIC ADDRESS: 172 ANTLER CRT.


**Viljoen
Architect
Inc.**

300 A Wilson Avenue
North York, Ontario
M3H 1S8
TEL: (416) 630-2255
FAX: (416) 630-4782

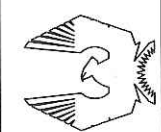

PHOENIX HOMES

PAINT SCHEME 2/2.

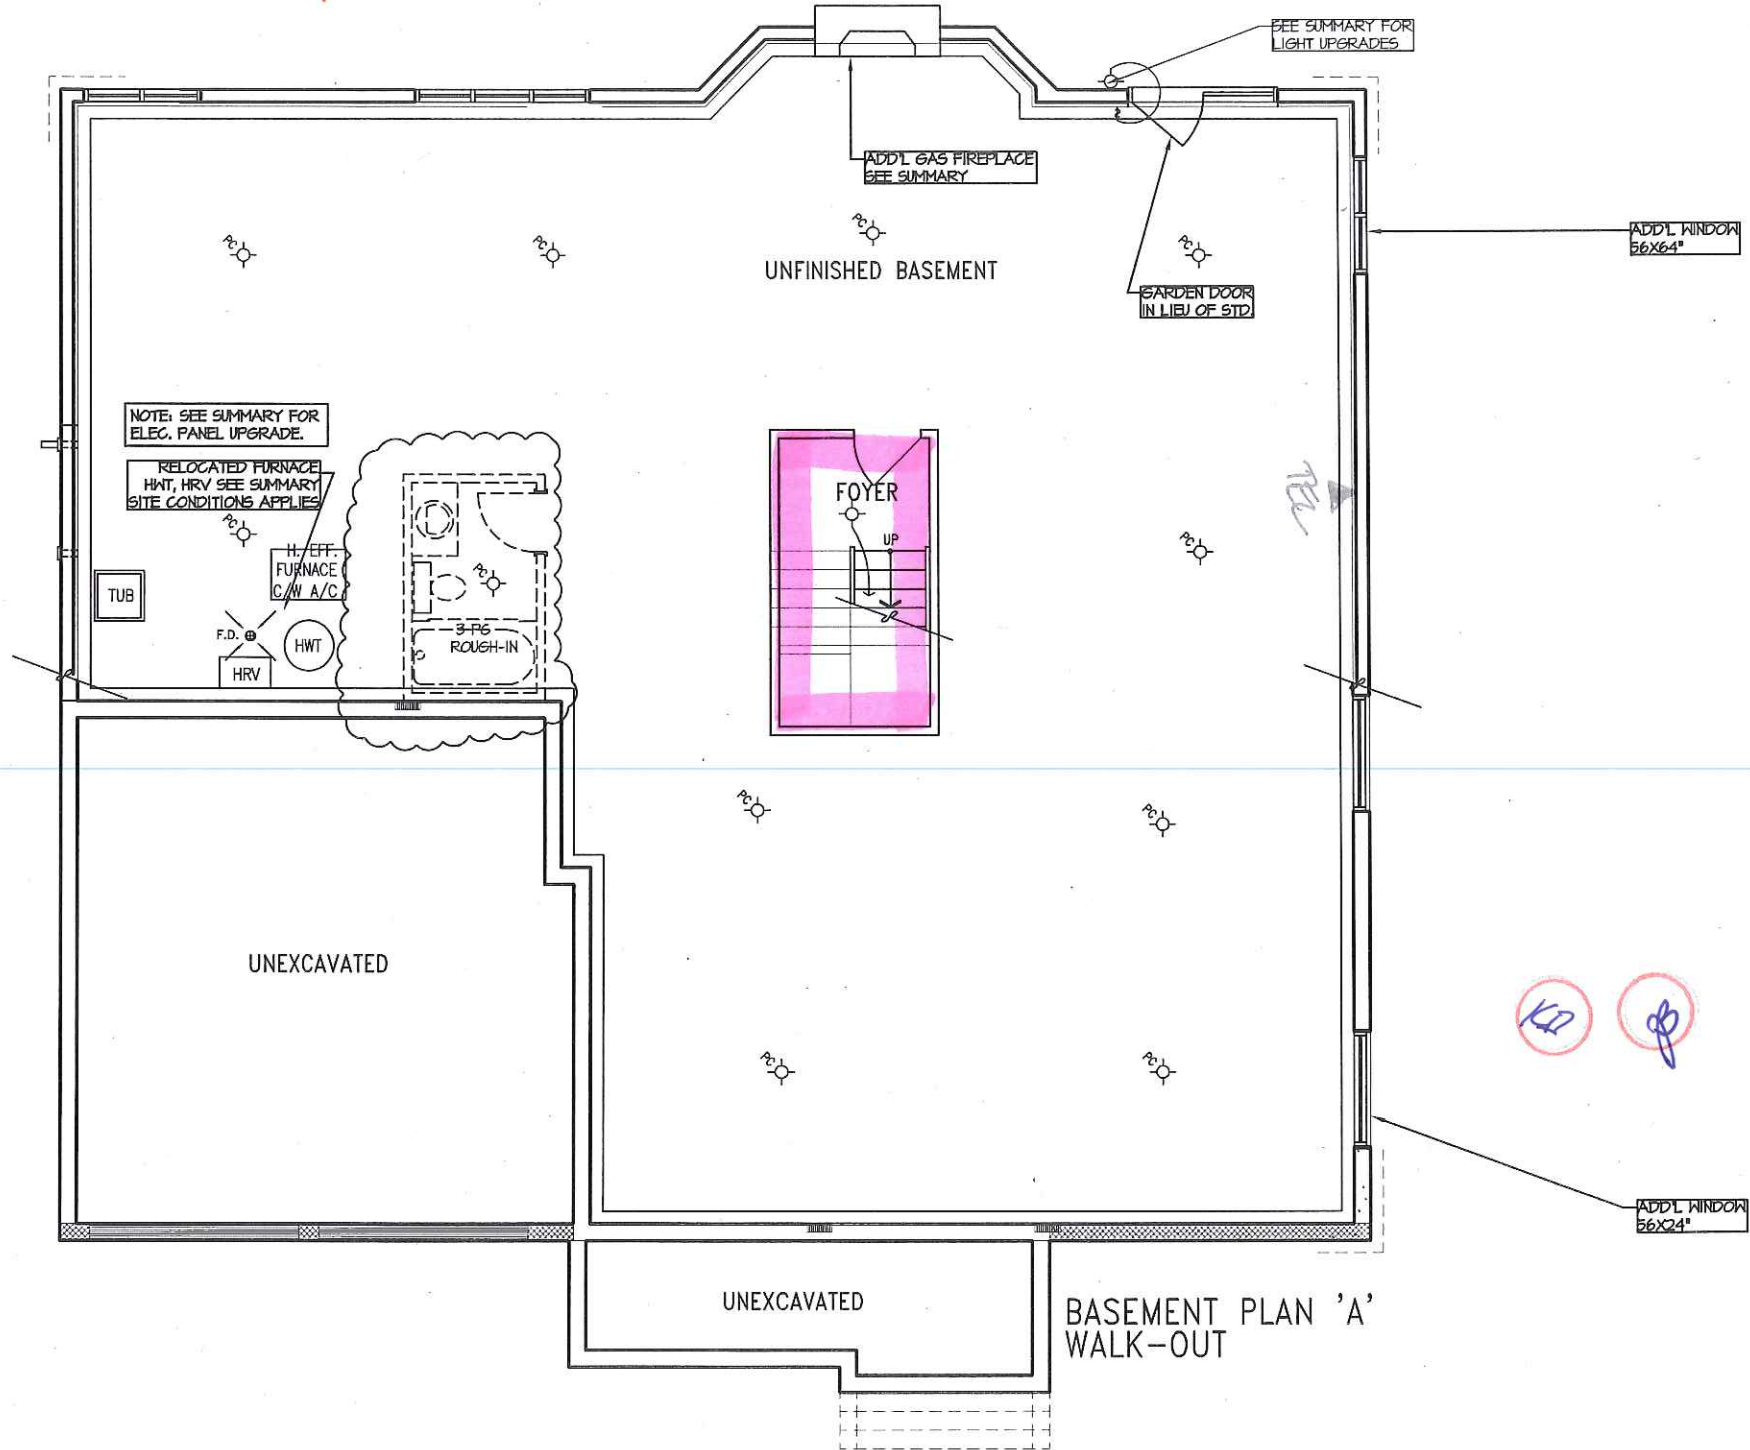

B4-A	
Project:	B4-A
Arch. Title:	BASMENT PLAN A
Drawn by:	J
Checked by:	
Date:	FEB. 2007
Scale:	3/16"=1'
Sheet no:	1A
	5

No.	Description	Date	By
4	REV. AS PER CONST. SUMMARY	AUG14-14	SD
5	ISSUED FOR BEP. ONLY	JUL4-14	SD
2	ISSUED FOR BEP. ONLY	JUN25-14	SD
1	FOR PERMIT APPLICATION ONLY	MAY26-14	SD

B4-A CARTESIAN


SITE: WHITE TAIL RIDGE

LOT NUMBER: 18

CIVIC ADDRESS: 172 ANTLER CRT.

Viljoen Architect Inc.

300 A. Wilson Avenue
Windsor, Ontario
N9H 1S9
TEL: (416) 630-2255
FAX: (416) 630-4782

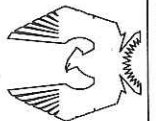

PHOENIX HOMES