


SW 6205
COMFORT GRAY

SW 7038
TONY TAUPE

SW 6073
PERFECT
GREIGE

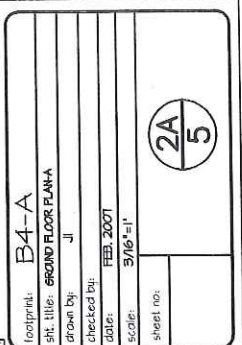

No.	Description	Date	By
1	ISSUED FOR PERMIT APPLN.	JUNE16-14	SD
2	ISSUED FOR DEP. ONLY	JUNE25-14	SD
3	ISSUED FOR DEP. ONLY	JULY7-14	SD
4	REV. AS PER CONST. SUMMARY	JULY29-14	SD

B4-A CARTESI AN


SITE: WHITE TAIL RIDGE

1

LOT NUMBER:
CIVIC ADDRESS:
128 ANTLER COURT

**Viljoen
Architect
Inc.**


3300 A. Wilson Avenue
North York, Ontario
M3H 1S8
TEL: (416) 630-2255
FAX: (416) 630-4782

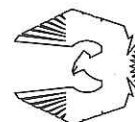

PHOENIX HOMES

PAINT SCHEME 2/2

SW 6073
PERFECT GREIGE.

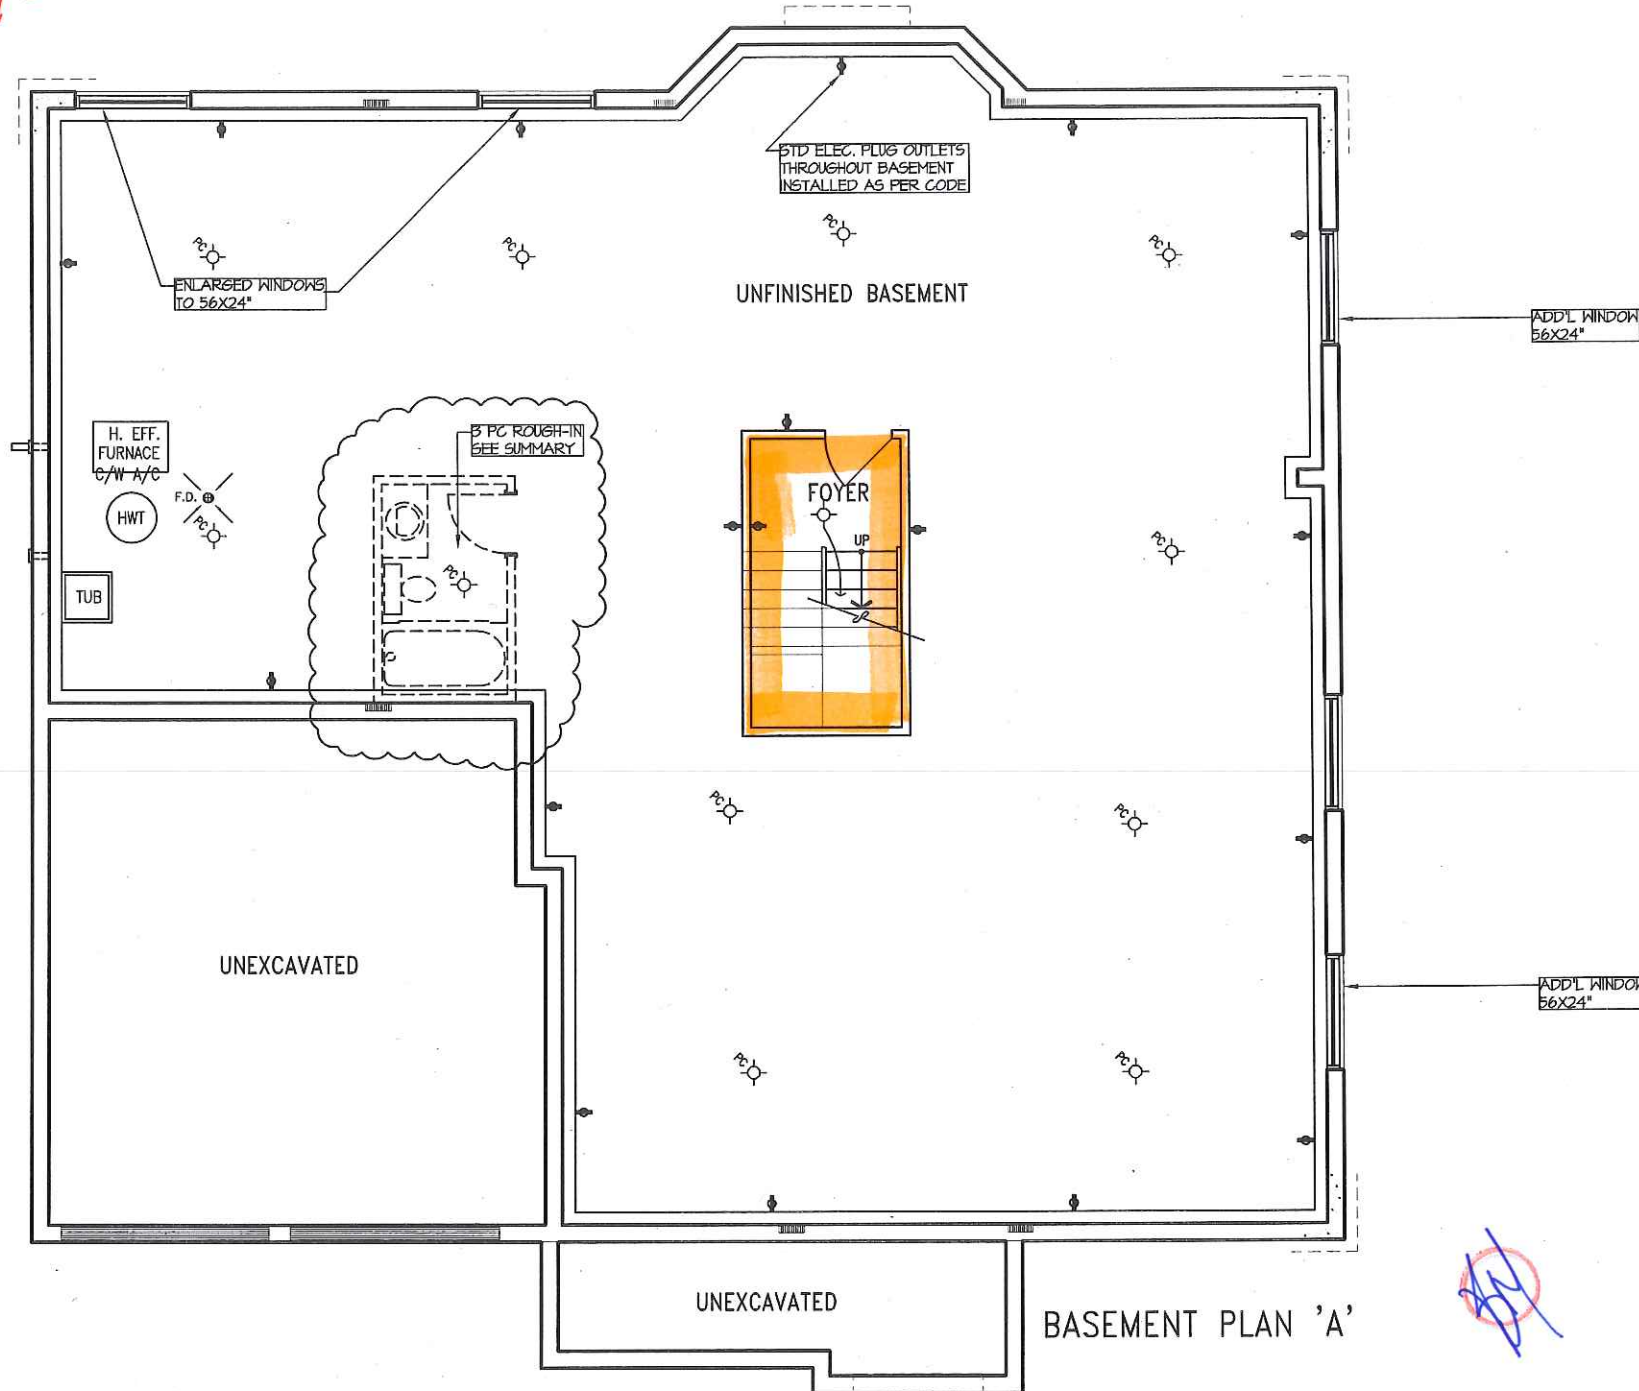

B4-A CARTESIAN

SITE: WHITE TAIL RIDGE

LOT NUMBER: 7

CIVIC ADDRESS: 128 ANTLER COURT

Viljoen Architect Inc.

300 A. Wilson Avenue
North York, Ontario
M2H 1C1
TEL: (416) 630-2255
FAX: (416) 630-4782

PHOENIX HOMES

footprint: B4-A

sh. title: BASEMENT PLAN A

drawn by: JJ

checked by: FEB. 2007

date: 3/16/01

scale: 3/16"=1'

sheet no:

No.	Description	Date	By
4	REV. AS PER CONST. SUMMARY	JULY28-14	SD
5	ISSUED FOR BEP. ONLY	JULY14	SD
2	ISSUED FOR BEP. ONLY	JUNE25-14	SD
1	ISSUED FOR PERMIT APPLN	JUNE16-14	SD

1A

5