

DCR PHOENIX HOMES


LOT #149
PATHWAYS
STRATHMORE (35-10) LEFT

KITCHEN / VANITIES
MOUNTING HEIGHT - 96


42" UPPERS INSTALLED @
18" ABOVE COUNTER

CABINETS:
HARDWARE -
STD WHITE INTERIOR
STD DRAWER SLIDES / HINGES
4 PCS - 5/8" KICK - FIN, BOTH ENDS
1 PCS - 90 DEG. CORNER MOULD
1 PCS - T-MOULD
4 PCS - FLAT MOULD

~~CROWN MOULDING~~

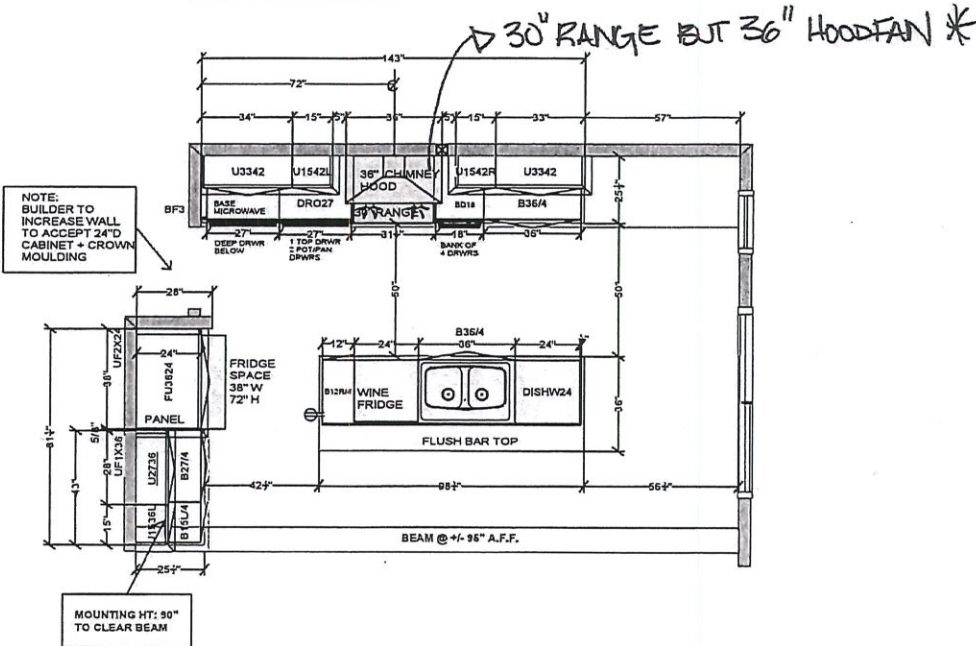

VANITIES

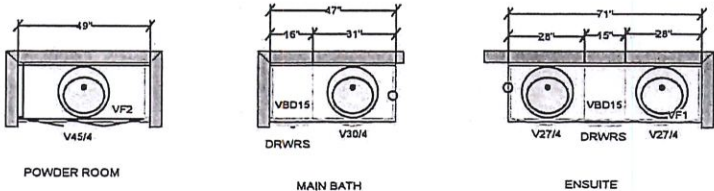

AS

CUSTOMER APPROVAL

I have reviewed these drawings and understand the details of the design and the Cartier Kitchens specifications.

Signature _____
Date _____

All dimensions size designations given are subject to verification on job site and adjustment to fit job conditions.




This is an original design and must not be released or copied unless applicable fee has been paid or job order placed.

Designed: 9/13/2020
Printed: 9/15/2020

DCR #149 PATHWAYS - Strathmore

All

Drawing #: 1 No Scale.

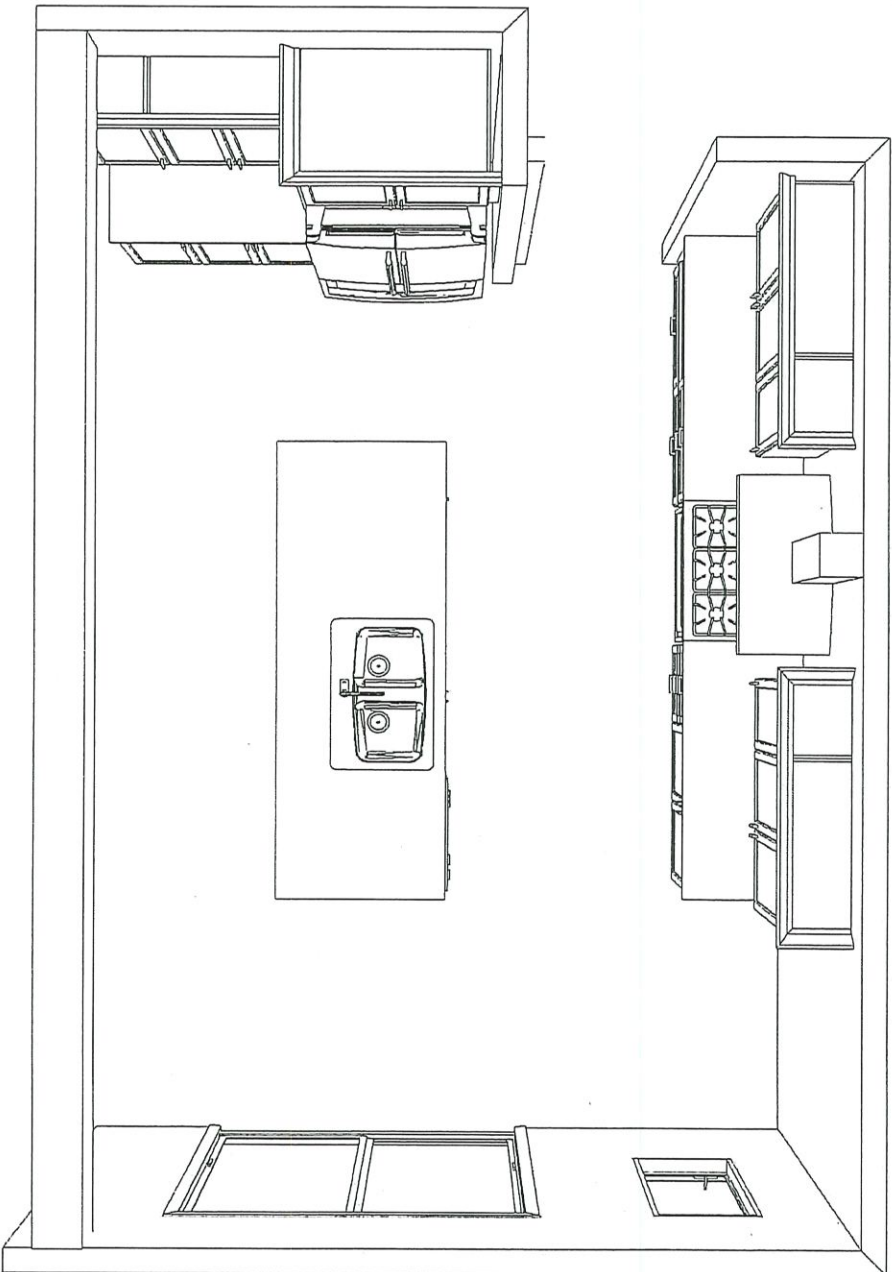

KITCHEN - TOP VIEW

CUSTOMER APPROVAL

I have reviewed these drawings and understand the details of the design and the Carter Kitchens specifications

Signature _____

Date _____

Note: This drawing is an artistic interpretation of the general appearance of the design. It is not meant to be an exact rendition.




Designed: 9/13/2020
Printed: 9/15/2020



DCR #149 PATHWAYS - Strathmore

All

Drawing #: 1

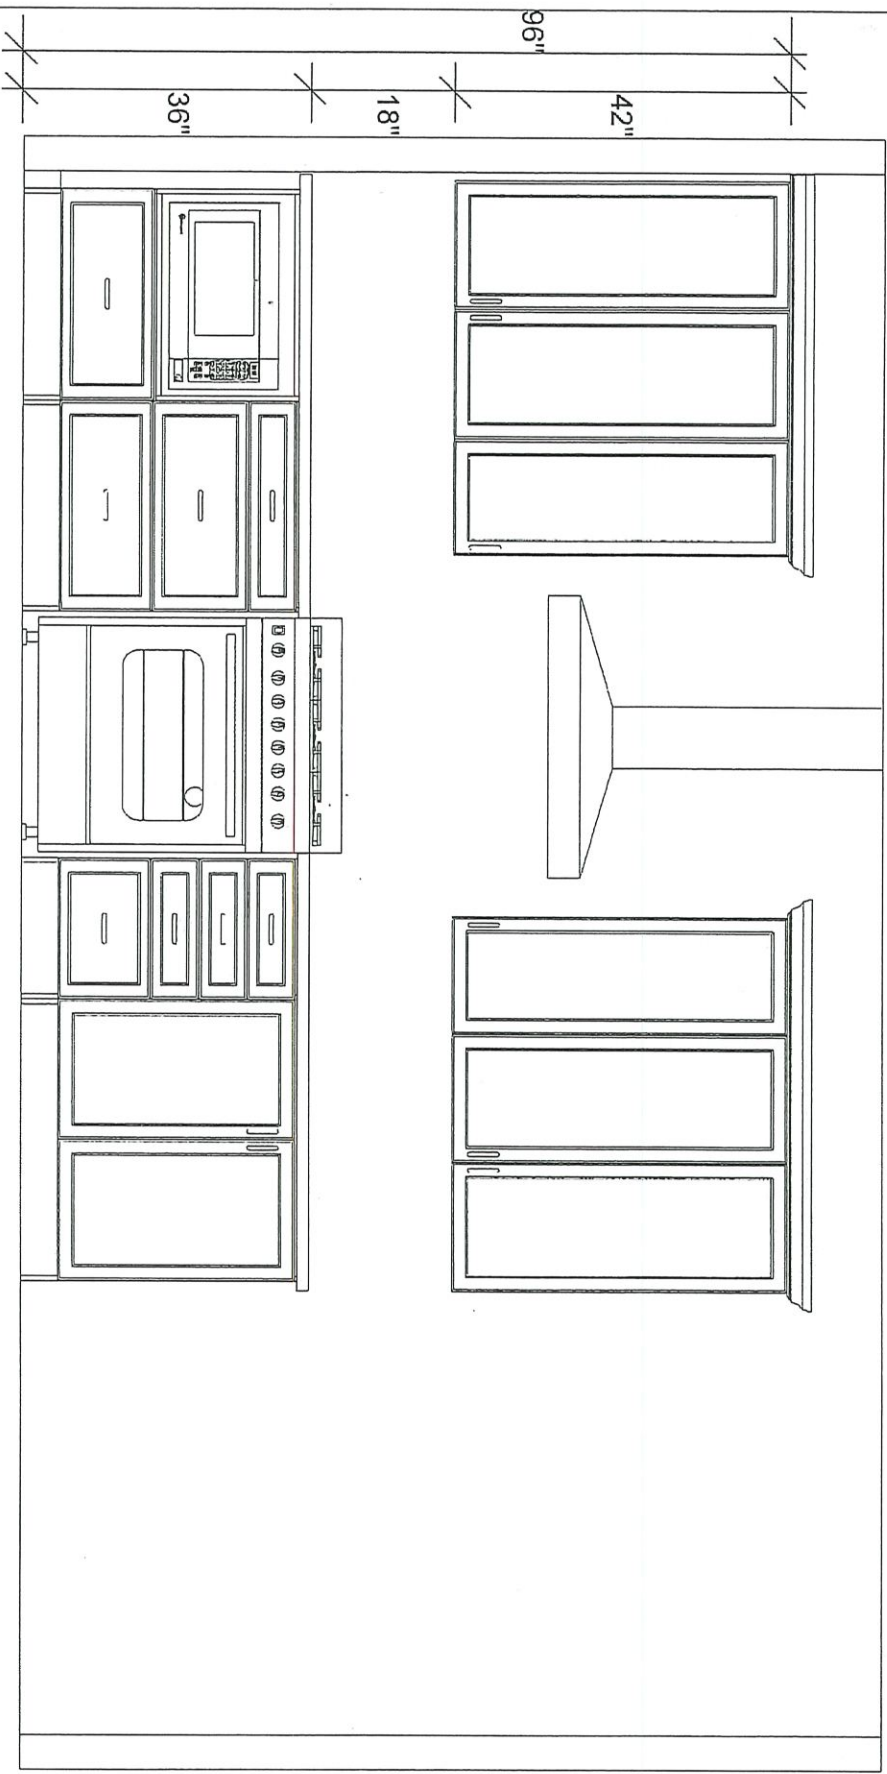

CUSTOMER APPROVAL

I have reviewed these drawings and understand the details of the design and the Cartier Kitchens specifications

Signature _____

Date _____

RANGE WALL ELEVATION

NO CROWN

Note: This drawing is an artistic interpretation of the general appearance of the design. It is not meant to be an exact rendition.



Designed: 9/13/2020
Printed: 9/15/2020




DCR #149 PATHWAYS - Strathmore

All

Drawing #: 1

BEAM

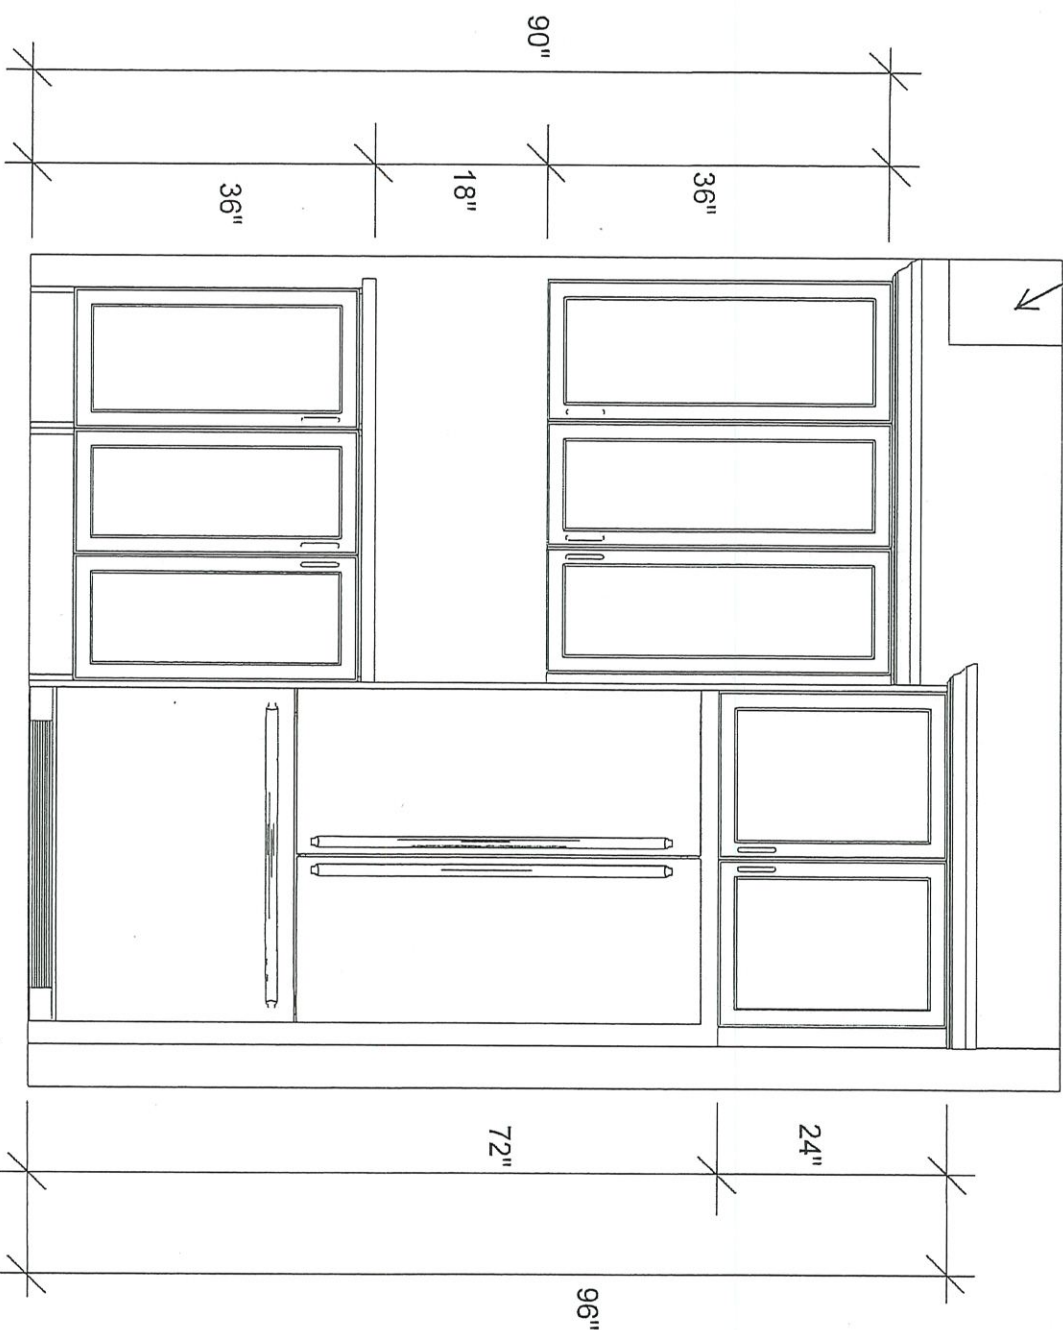

FRIDGE ELEVATION

NO CROWN

CUSTOMER APPROVAL

I have reviewed these drawings and understand the details of the design and the Cartier Kitchens specifications

Signature _____


Date _____

Note: This drawing is an artistic interpretation of the general appearance of the design. It is not meant to be an exact rendition.



Designed: 9/13/2020
Printed: 9/15/2020



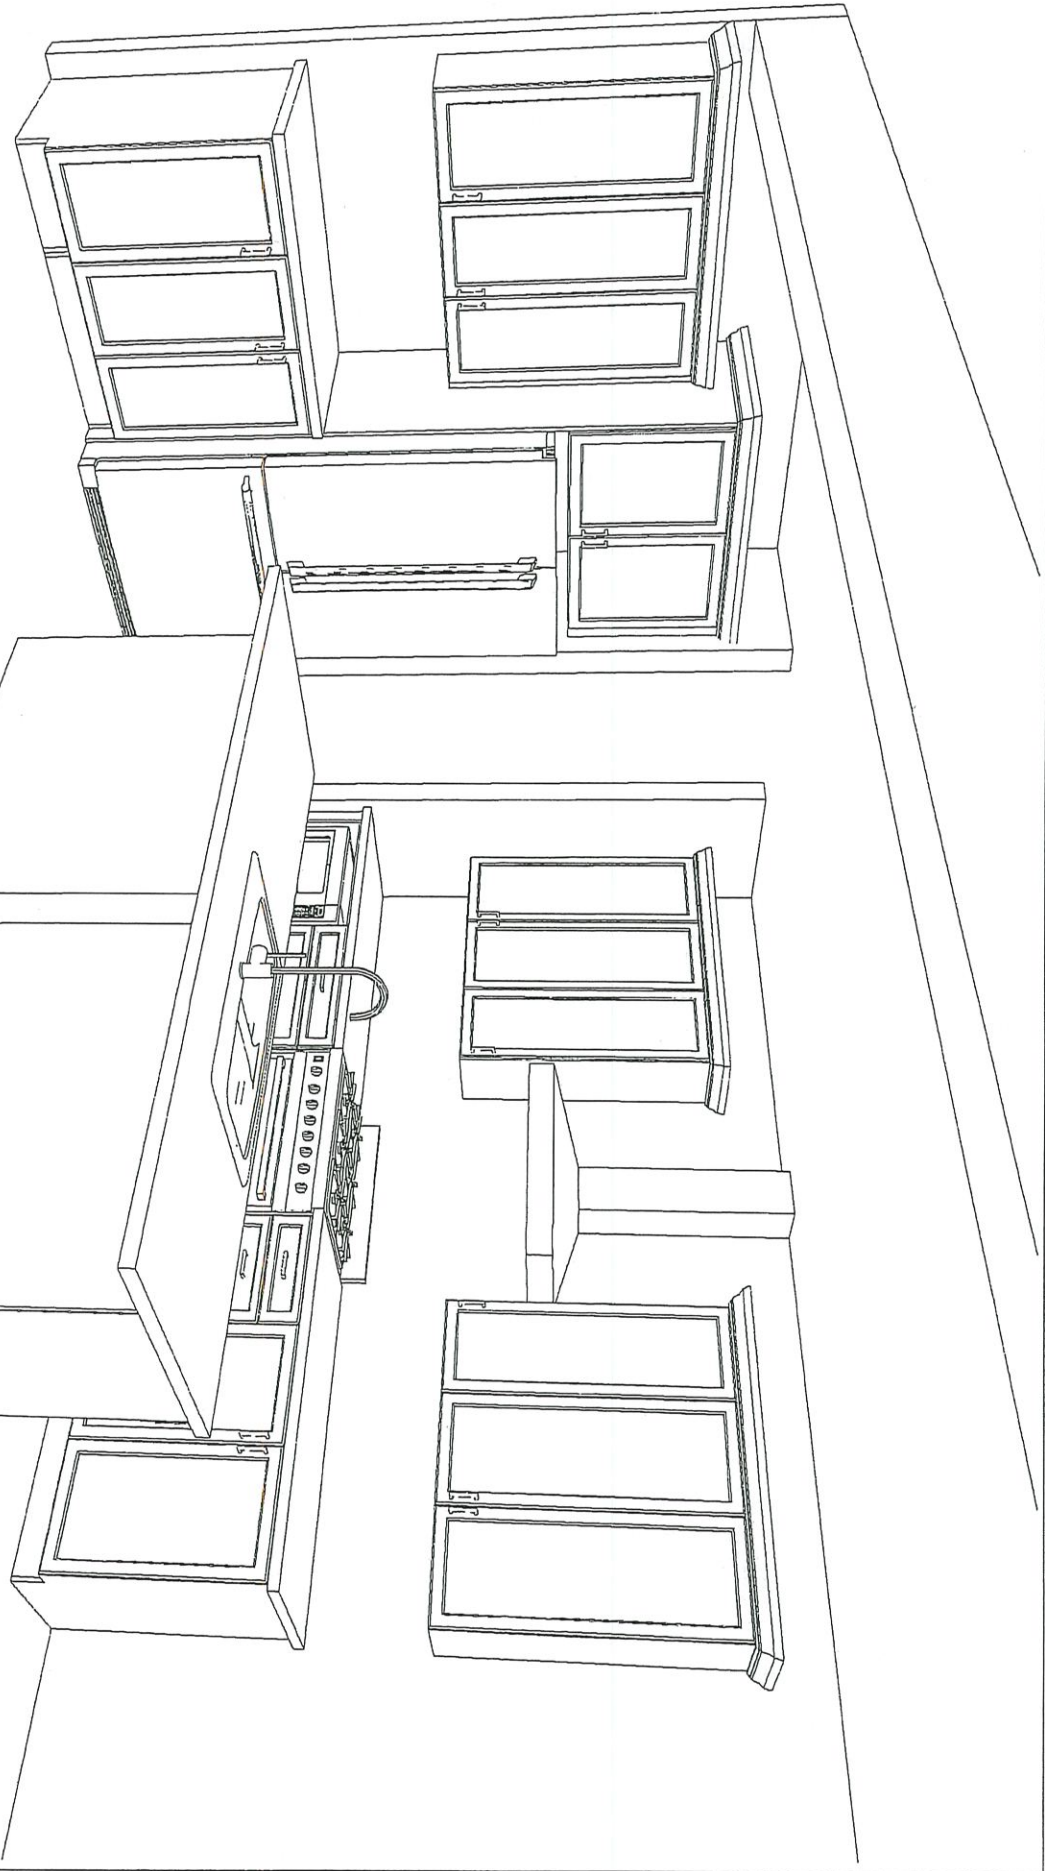

CUSTOMER APPROVAL

I have reviewed these drawings and understand the details of the design and the Cartier Kitchens specifications

Signature _____

Date _____

KITCHEN - 3D VIEW #1


* NO CROWN *

Note: This drawing is an artistic interpretation of the general appearance of the design. It is not meant to be an exact rendition.



Designed: 9/13/2020
Printed: 9/15/2020



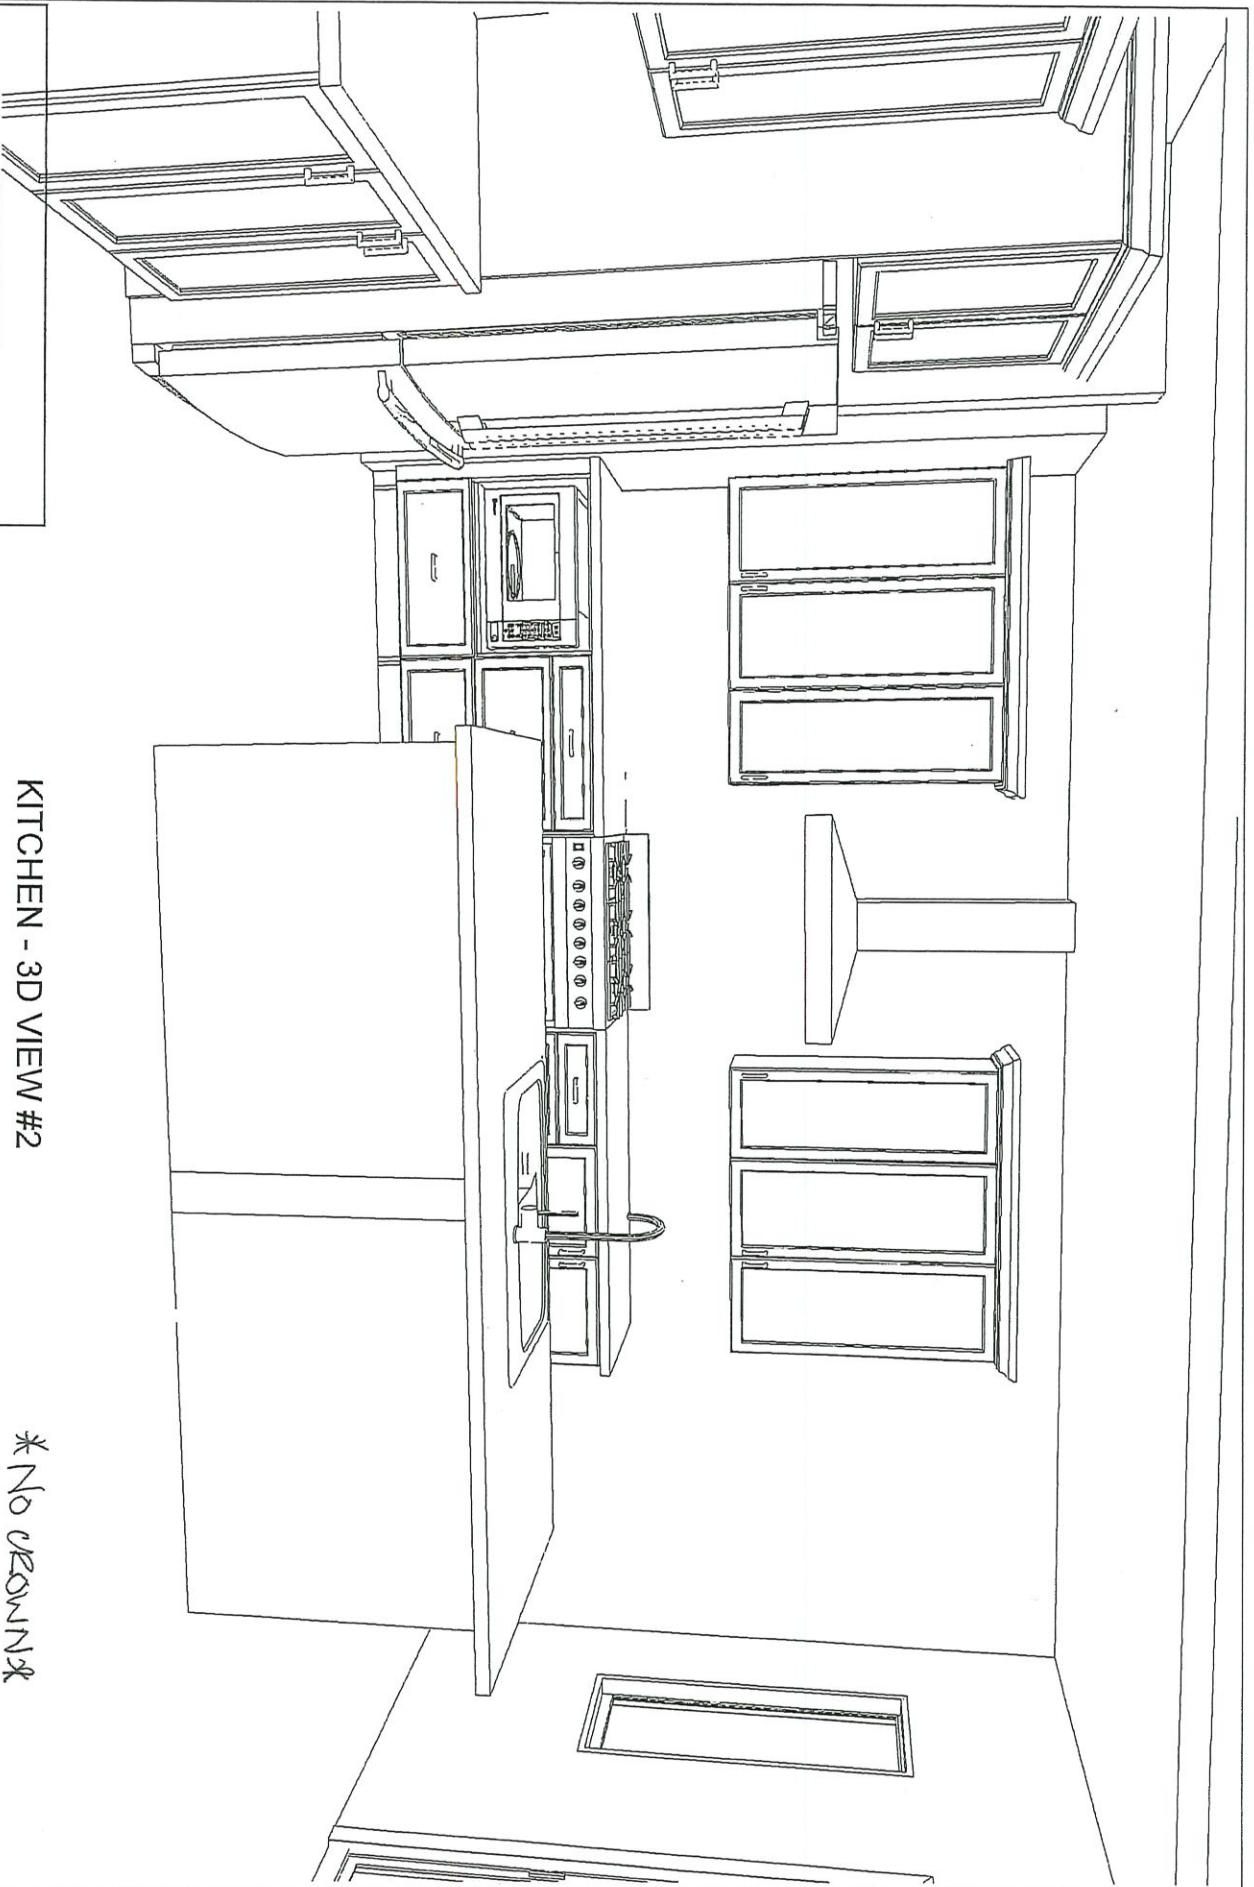

KITCHEN - 3D VIEW #2

* No crown *

I have reviewed these drawings and understand the details of the design and the Cartier Kitchens specifications

Signature _____

Date _____

Note: This drawing is an artistic interpretation of the general appearance of the design. It is not meant to be an exact rendition.




Designed: 9/13/2020
Printed: 9/15/2020

DCR #149 PATHWAYS - Strathmore

All

Drawing #: 1



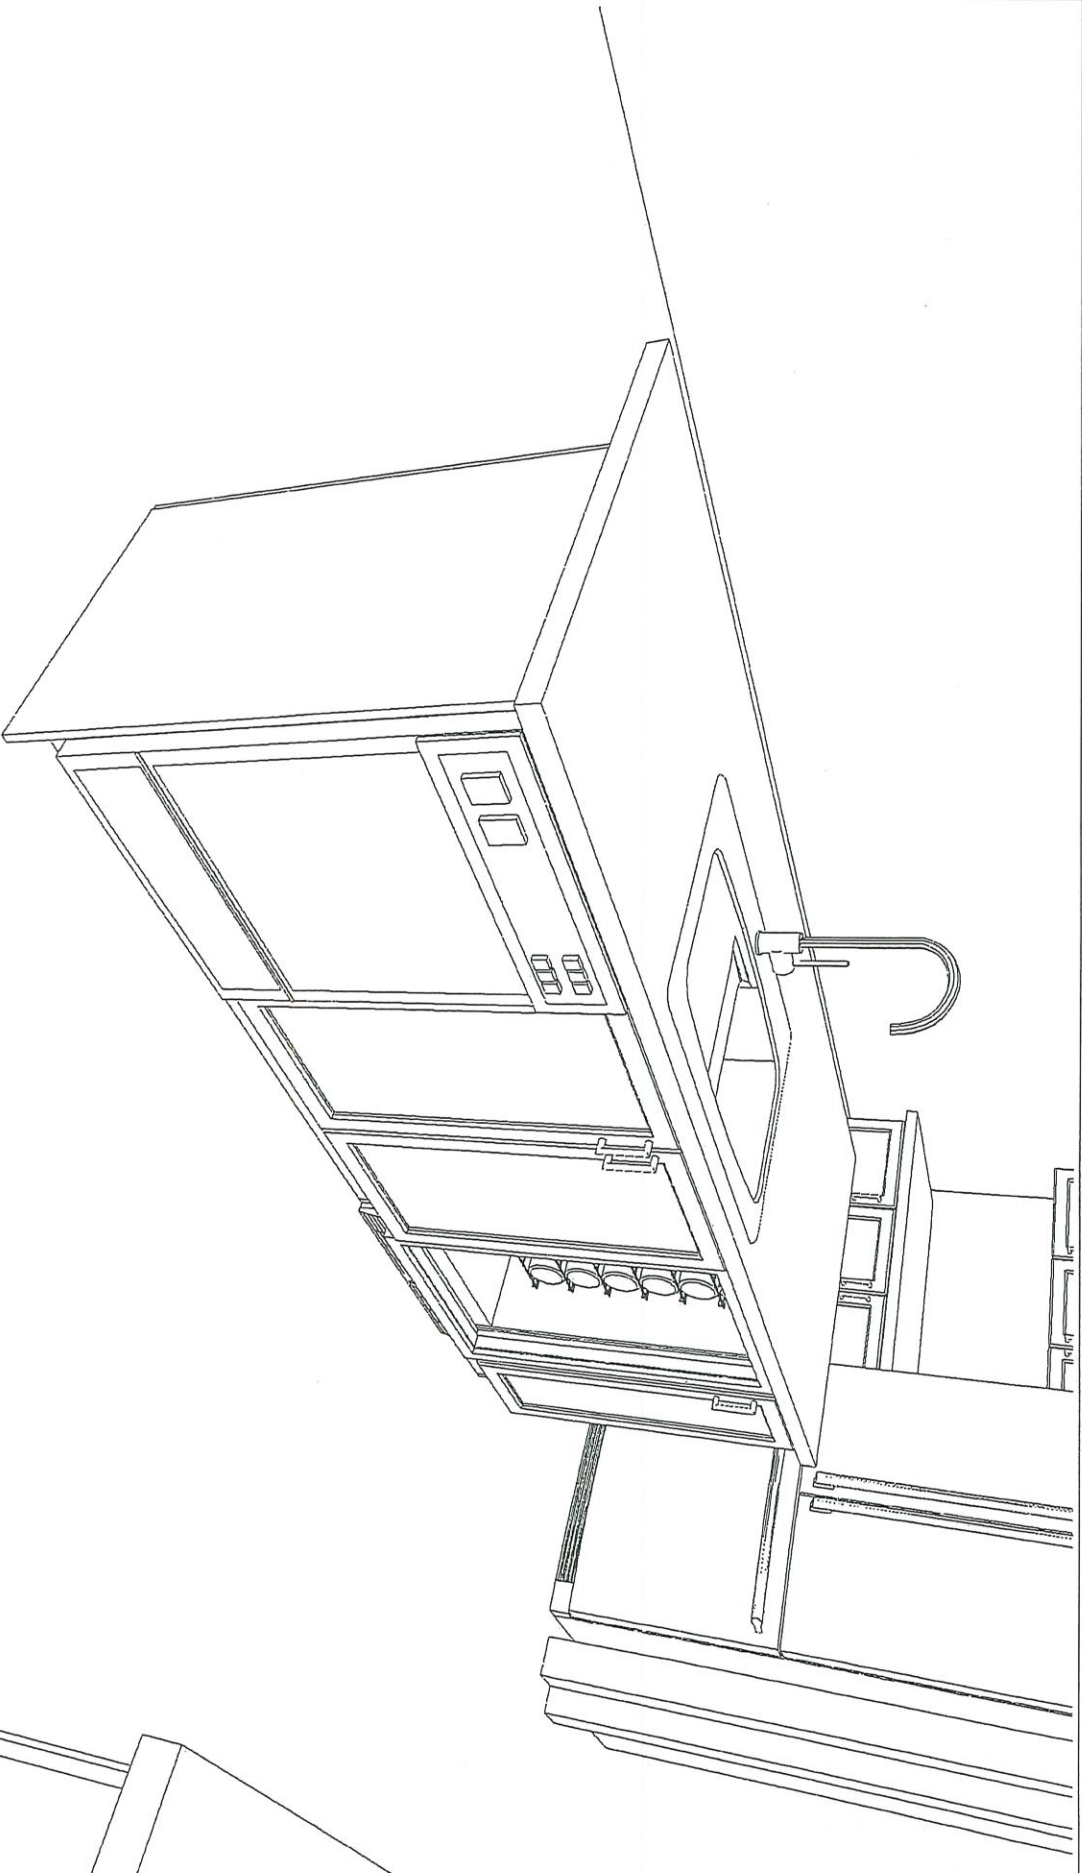

KITCHEN - 3D VIEW #3

No crown

CUSTOMER APPROVAL

I have reviewed these drawings and understand the details of the design and the Cartier Kitchens specifications

Signature _____

Date _____

Note: This drawing is an artistic interpretation of the general appearance of the design. It is not meant to be an exact rendition.



Designed: 9/13/2020
Printed: 9/15/2020

DCR #149 PATHWAYS - Strathmore

All

Drawing #: 1

