


9' FOUNDATION POUR

SITE COPY
City of Ottawa

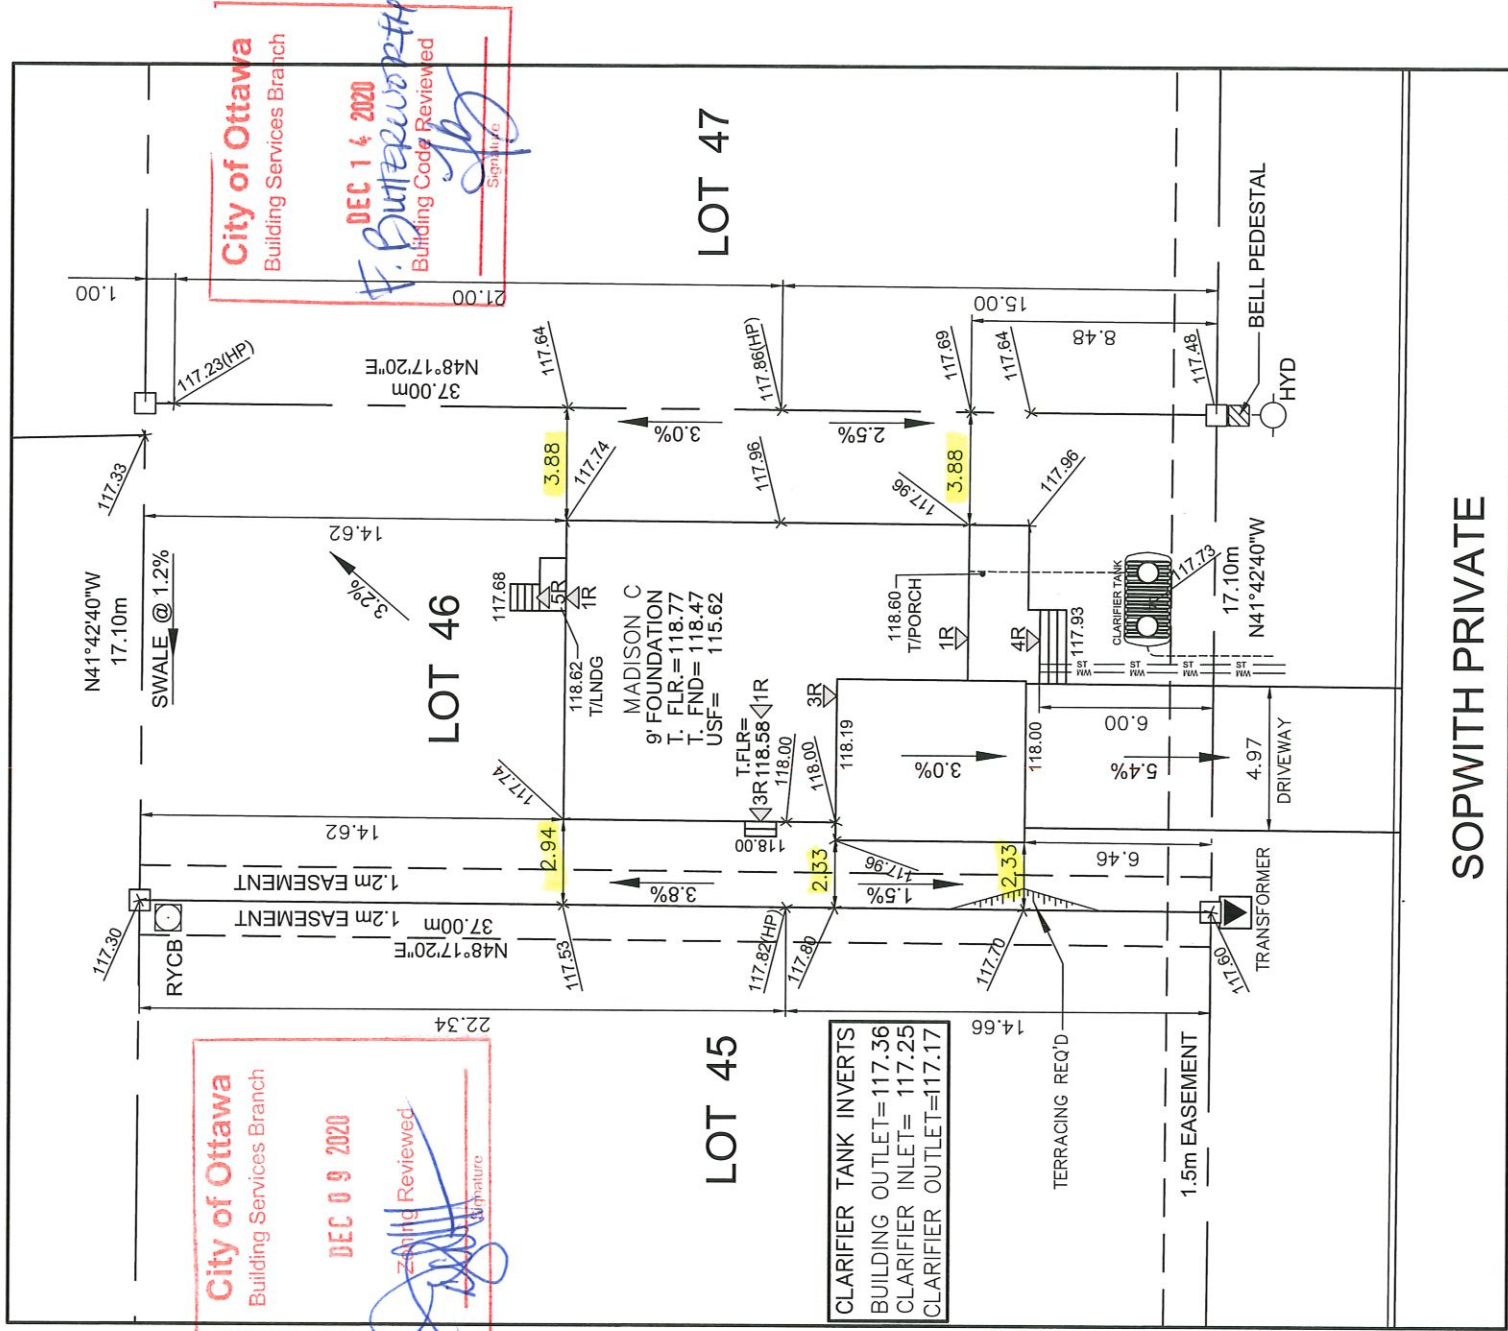

SOPWITH PRIVATE

Owner/Applicant

DCR/PHOENIX HOMES

Telephone # 723-9227

Plan # 4m-1593

Project name: DIAMONDVIEW ESTATES

Civic Address: 40 SOPWITH PVT

House model: MADISON C

Bldg. Ht. m

Lot coverage 24.8 %

Scale 1:250

Sod Area 508 m²

Asphalt Area 64 m²

CHECKED/APPROVED BY: T.L.MAK ENG.



LOT 46

SITE/GRADING PLAN
DIAMONDVIEW ESTATES

INDIVIDUAL LOT GRADING REVIEW SUMMARY FOR SITED HOUSE AS COMPARED WITH OVERALL SUBDIVISION PLAN



NOV 30 2020

NOTE: THIS PLAN IS NOT A SURVEY PLAN OR SUBDIVISION PLAN WITHIN THE MEANING OF PLANNING ACT.

THIS PLAN IS FOR REFERENCE ONLY AND IS PRELIMINARY IN NATURE, ALL DIMENSIONS SHOWN ARE APPROXIMATE. E.O&E.