



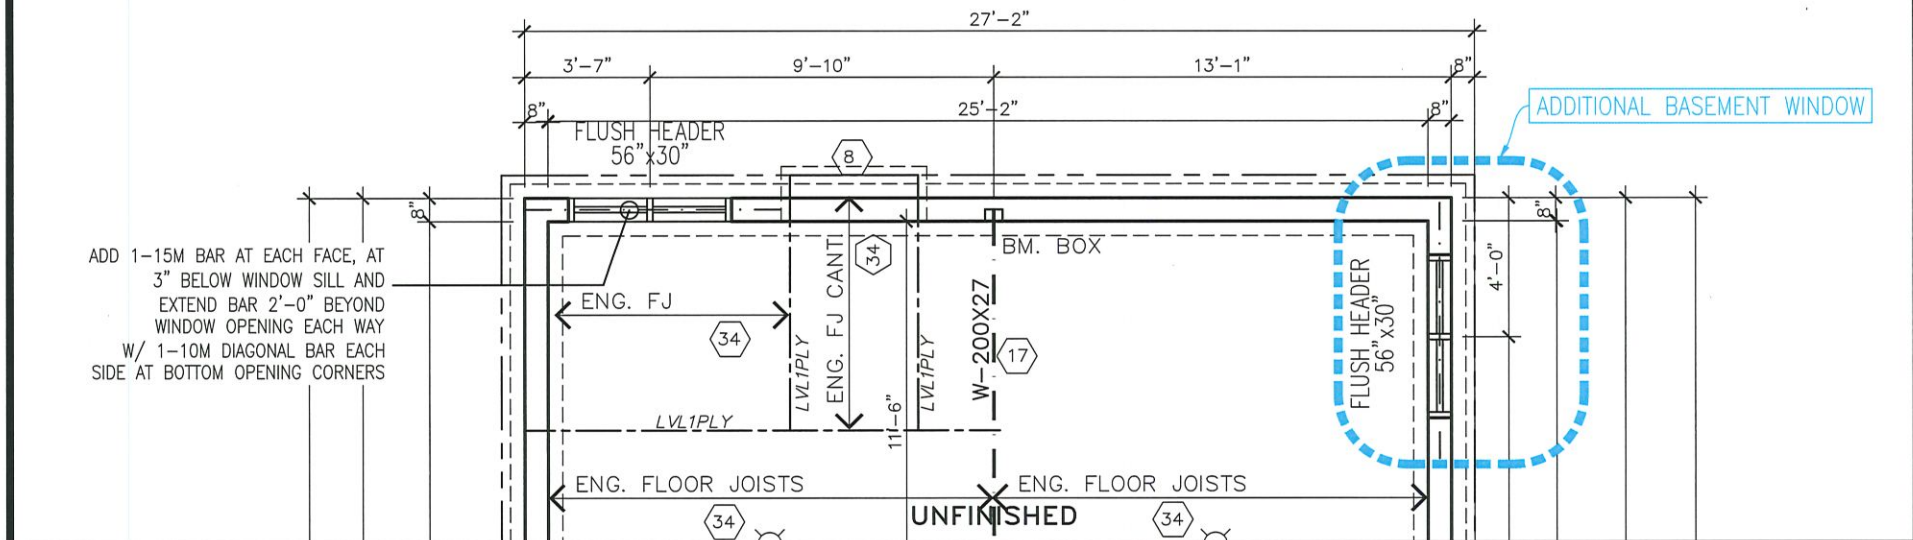

1 PARTIAL FOUNDATION PLAN
1 scale: 3/16"=1'-0"

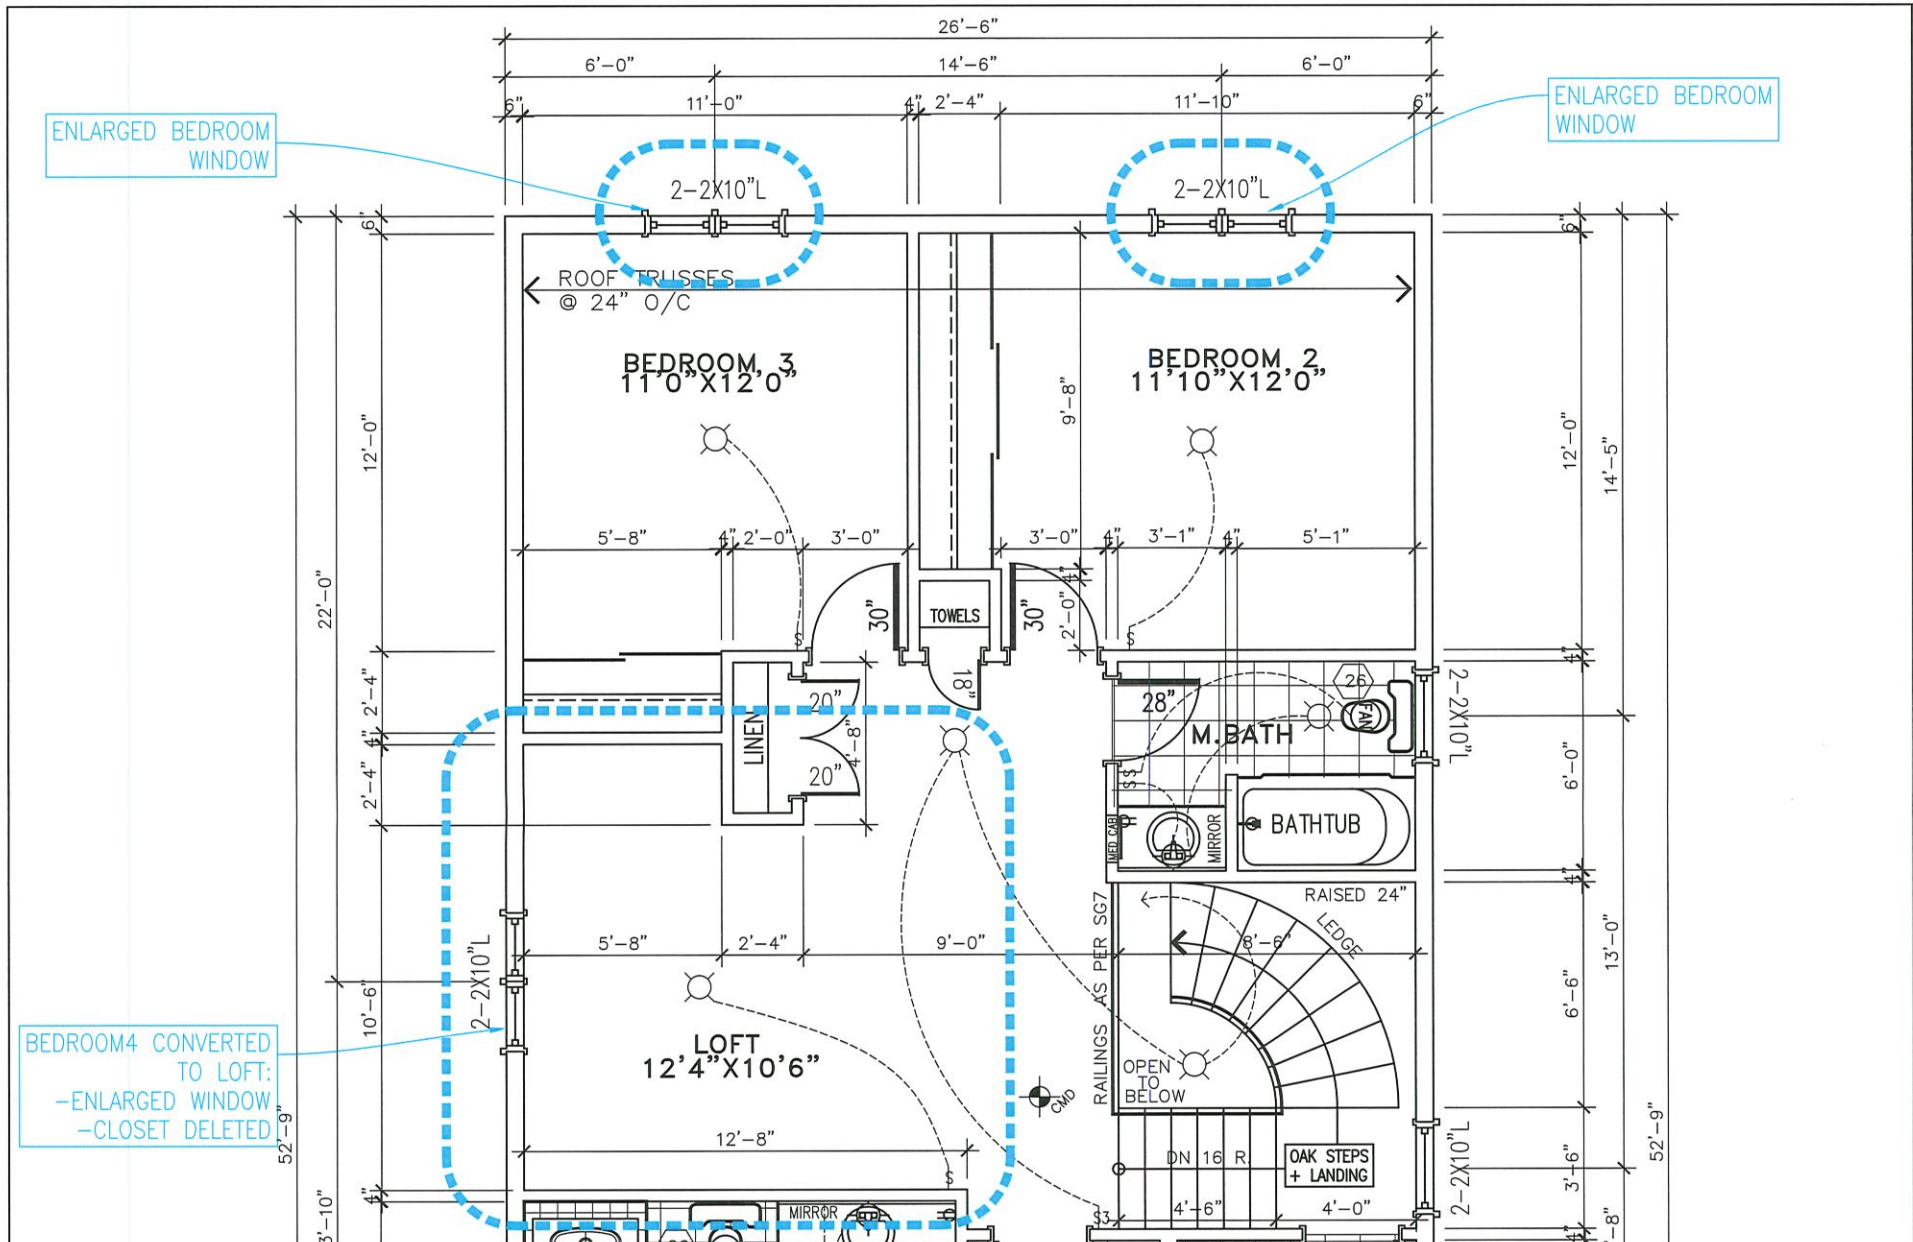

2 PARTIAL SECOND FLOOR PLAN
1 scale: 3/16"=1'-0"

PLANS TO BE READ WITH MASTER FOOTPRINTED PLANS.

ANGELO SARRAZIN
City of Ottawa
Building Services Branch
REVIEWED
By sarrazinan at 10:10 am, Nov 20, 2020
Building Code Reviewed

LICENSED PROFESSIONAL ENGINEER
V. ATAYEV
100134699
2020/11/13
PROVINCE OF ONTARIO

Structural Review Only.




ROSEMERE-2012-D
SITE: PATHWAYS
LOT NUMBER: 162
CIVIC ADDRESS: 154 MINIKAN STREET

2	ENGINEER MARKUPS APPLIED	XX/XX/XX	CB
1	WINDOW REVISIONS & SECOND FLOOR LOFT	03/11/20	CB
No.	Description	dd/mm/yy	By
REVISIONS			

footprint:	C10D
drawn by:	PL
date:	AUG/00
scale:	3/16"=1'-0"
sheet no:	1
	2



1 PARTIAL REAR ELEVATION
2 scale: 3/16"=1'-0"

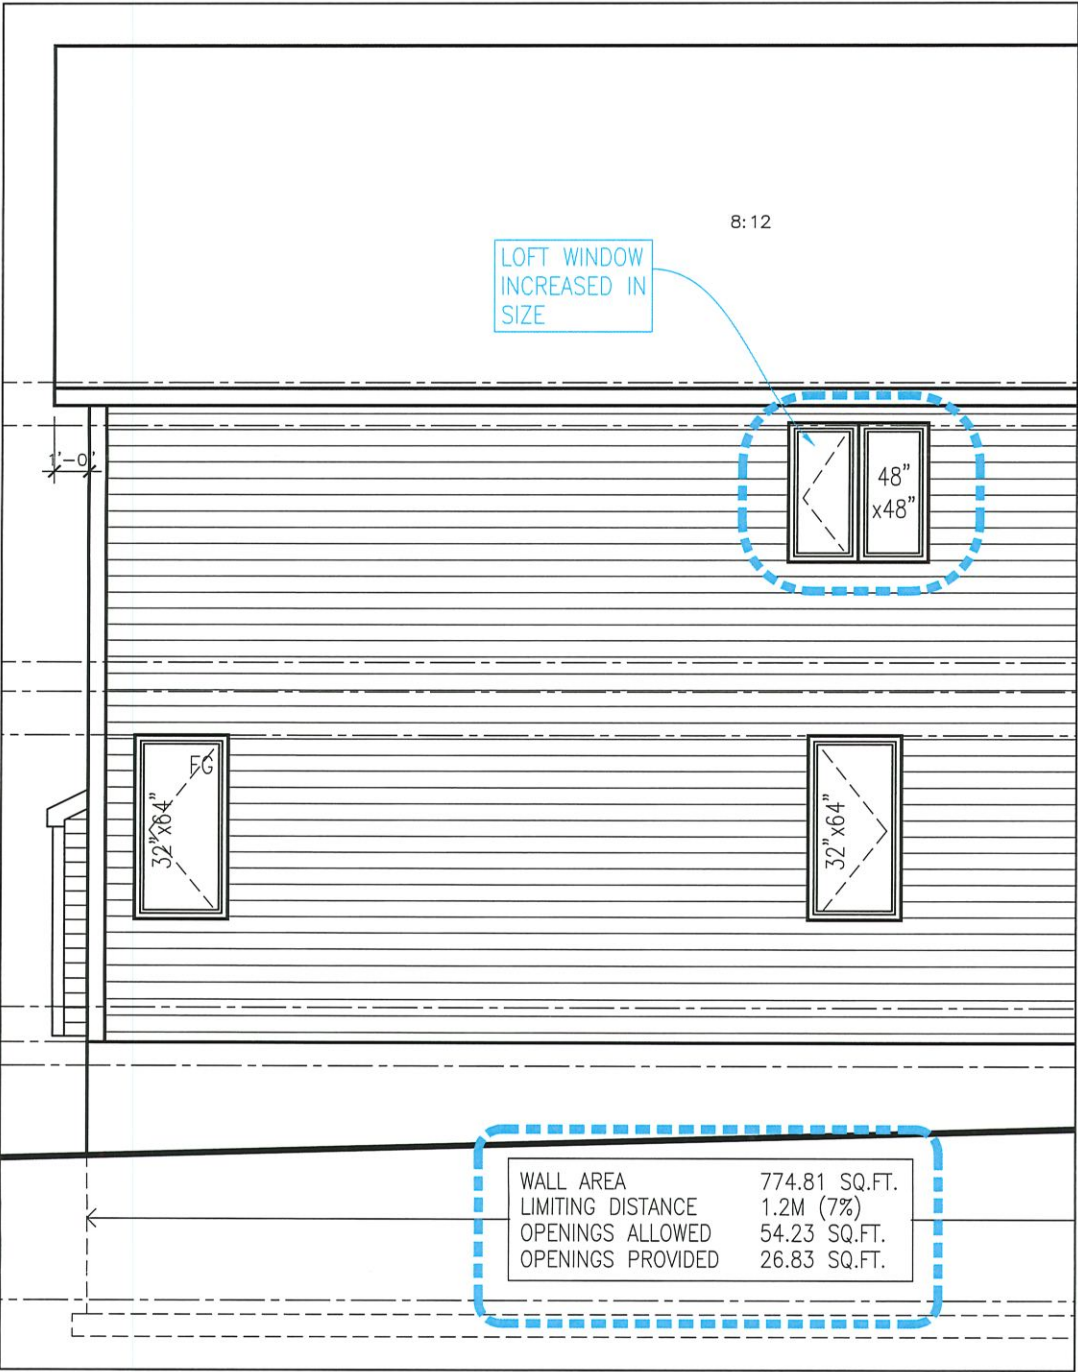

2 PARTIAL LEFT SIDE ELEVATION
2 scale: 3/16"=1'-0"



3 PARTIAL RIGHT SIDE ELEVATION
2 scale: 3/16"=1'-0"



ROSEMERE-2012-D

SITE: **PATHWAYS**

LOT NUMBER: **162**

CIVIC ADDRESS:
154 MINIKAN STREET

2	ENGINEER MARKUPS APPLIED	XX/XX/XX	CB
1	WINDOW REVISIONS & SECOND FLOOR LOFT	03/11/20	CB
No.	Description	dd/mm/yy	By
REVISIONS			

footprint: C10D

drawn by: PL

date: AUG/00

scale: 3/16"=1'-0"

sheet no: **2**