


DCR PHOENIX HOMES

LOT #43
DIAMONDDVIEW ESTATES
NEWINGTON
OPTIONAL CHEF'S KITCHEN
MOUNTING HEIGHT: 96

FILL TO CEILING WITH
1" MOULDING, FURRING PANEL &
CEILING CORWN

CABINETS -
HARDWARE -
STANDARD WHITE INTERIOR
METAL DRAWER BOX
3 PCS - 5/8" KICK - FIN. BOTH ENDS
3 PCS - LOOSE FILLER - 3 x 96
2 PCS - 90 DEG. CORNER MOULD
1 PCS - T-MOULD
1 PCS - FLAT MOULDING

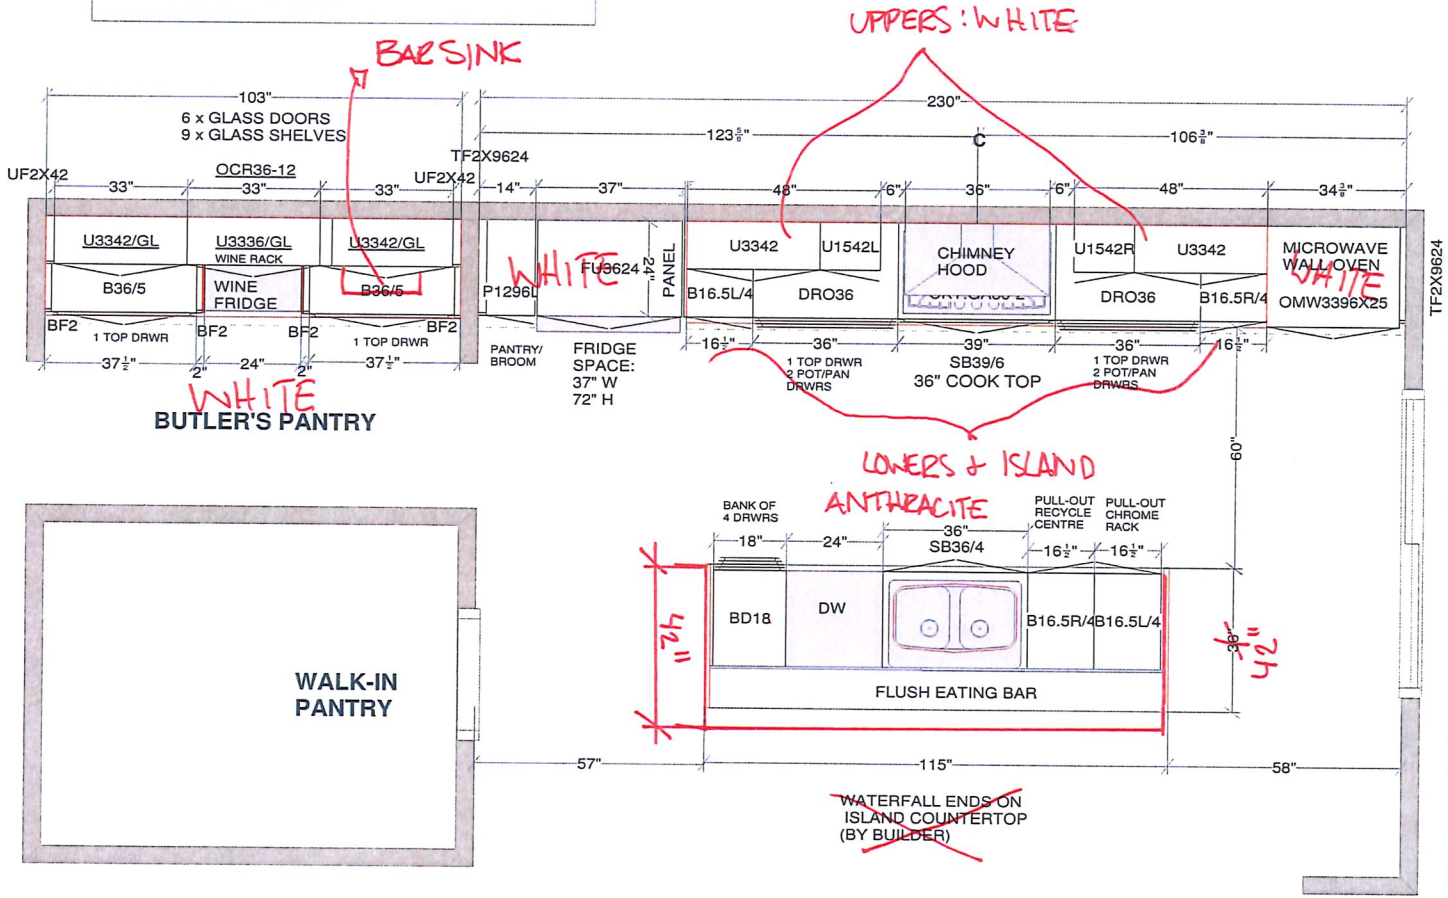

CUSTOMER APPROVAL

I have reviewed these drawings and understand the details of the design and the CARTIER KITCHENS specifications.

Signature _____

Date _____

All dimensions, size designations given are subject to verification on job site and adjustment to fit job conditions.

SPECTRUM KITCHEN and BATH DESIGN

DCR #43 DV - NEWINGTON - CHEF'S KITCHEN .kit



This is an original design and must not be released or copied unless applicable fee has been paid or job order placed.

DRAWN BY: LORI DISAVERIO, B.I.D


Designed: 2020-02-26
Printed: 2020-02-26

Nm *Sm*

All

Drawing #: 1 No Scale.

KITCHEN - 3D VIEW #3

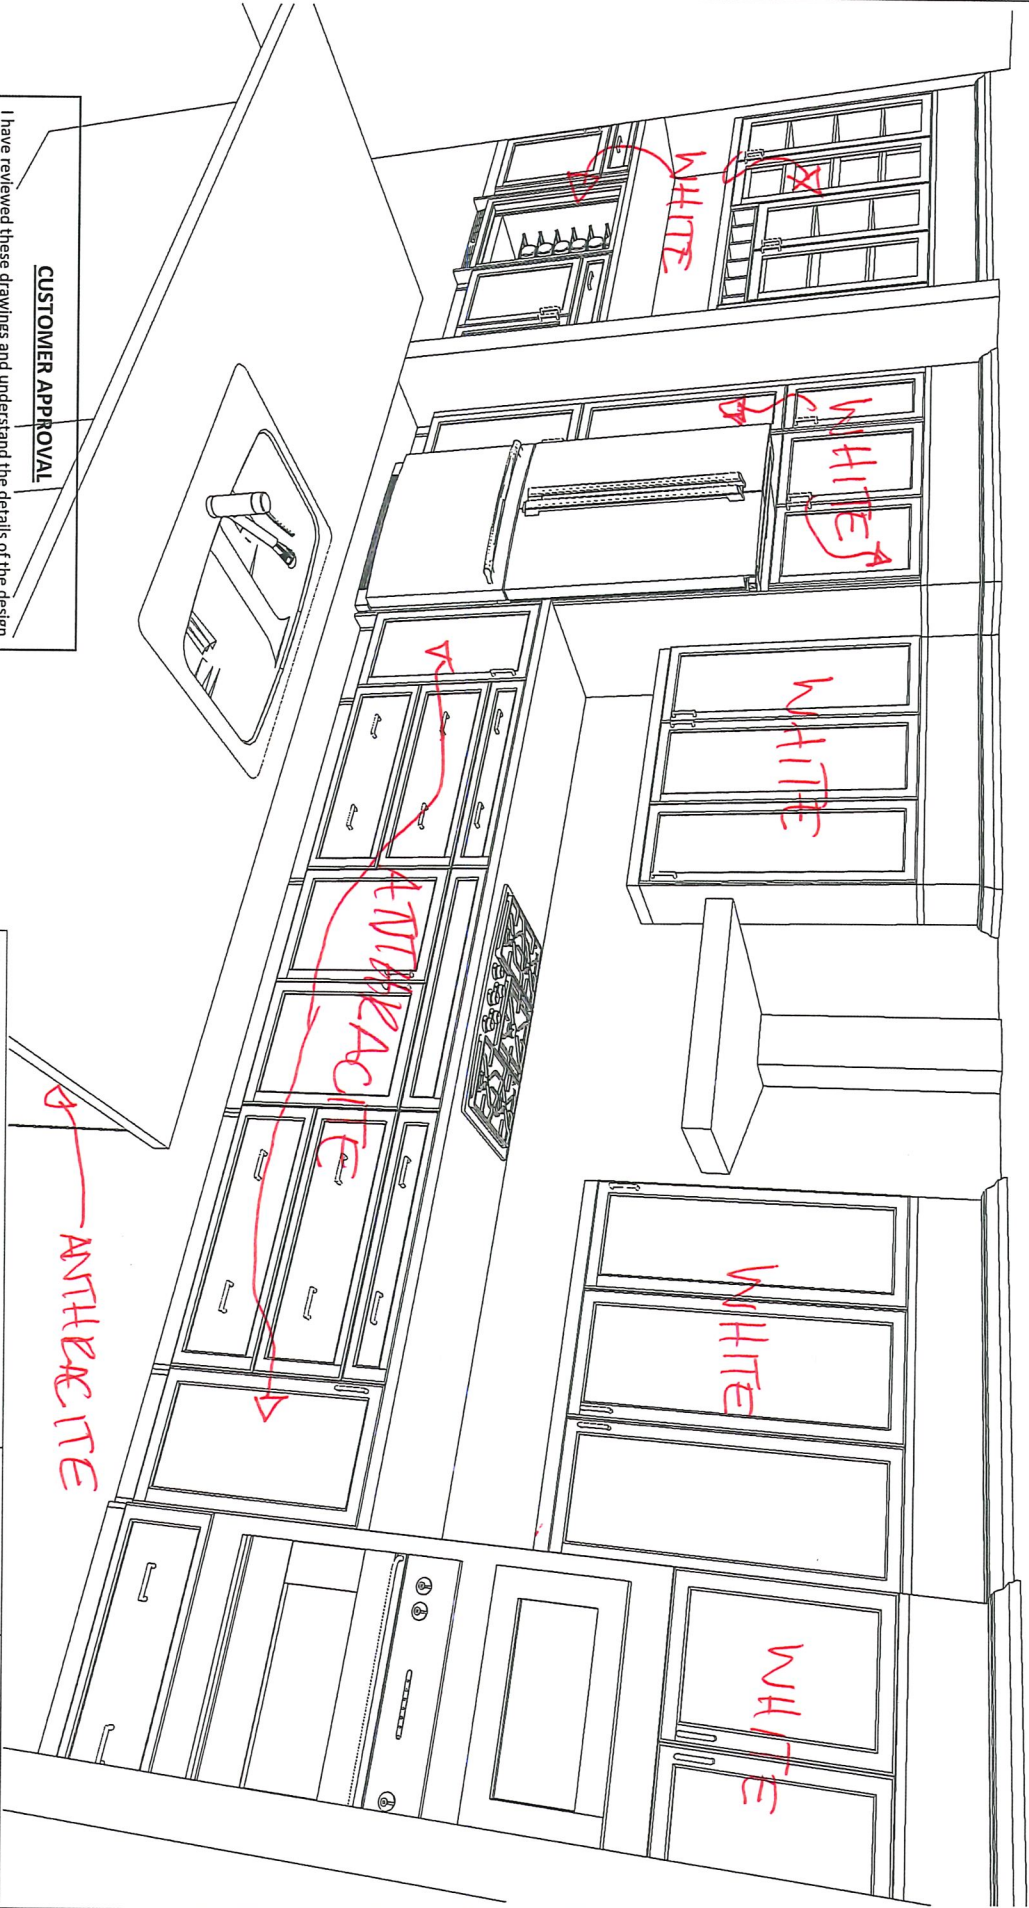

CUSTOMER APPROVAL

I have reviewed these drawings and understand the details of the design and the CARTIER KITCHENS specifications.

Signature _____

Date _____

Note: This drawing is an artistic interpretation of the general appearance of the design. It is not meant to be an exact rendition.

SPECTRUM KITCHEN and BATH DESIGN




Designed: 2020-02-26
Printed: 2020-02-26



DCR #43 DV - NEWINGTON - CHIEF'S KITCHEN

All

Drawing #: 1

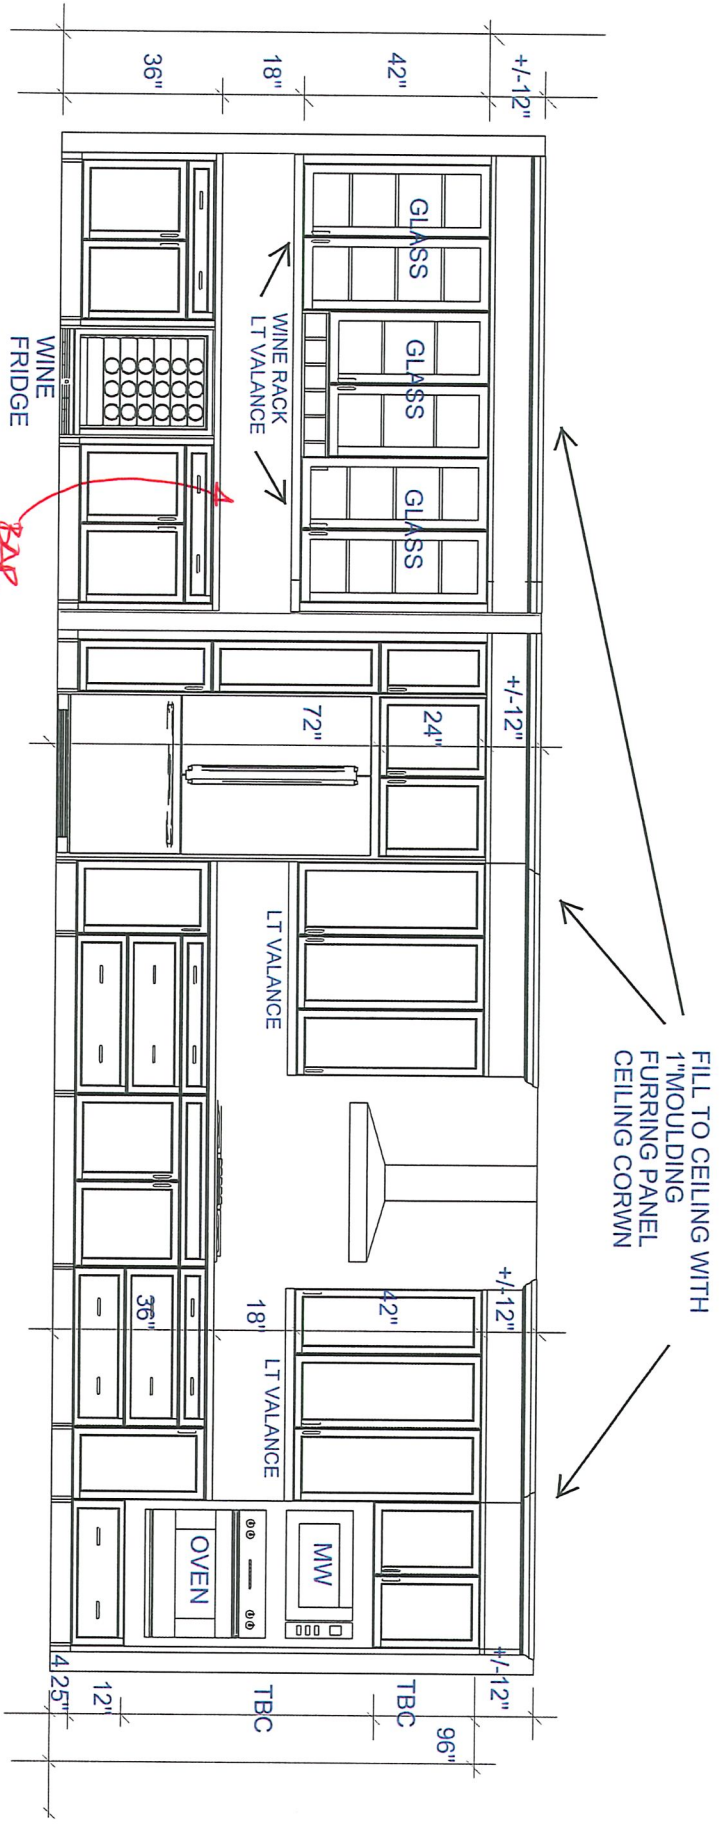

BUTLER'S PANTRY *BAE SINK*

FRIDGE, COOKTOP, OVEN WALL ELEVATION

CUSTOMER APPROVAL

I have reviewed these drawings and understand the details of the design and the CARTIER KITCHENS specifications.

Signature _____

Date _____

Note: This drawing is an artistic interpretation of the general appearance of the design. It is not meant to be an exact rendition.


Designed: 2020-02-26
Printed: 2020-02-26



SPECTRUM KITCHEN and BATH DESIGN

Nm *Sm*

KITCHEN - 3D VIEW #3

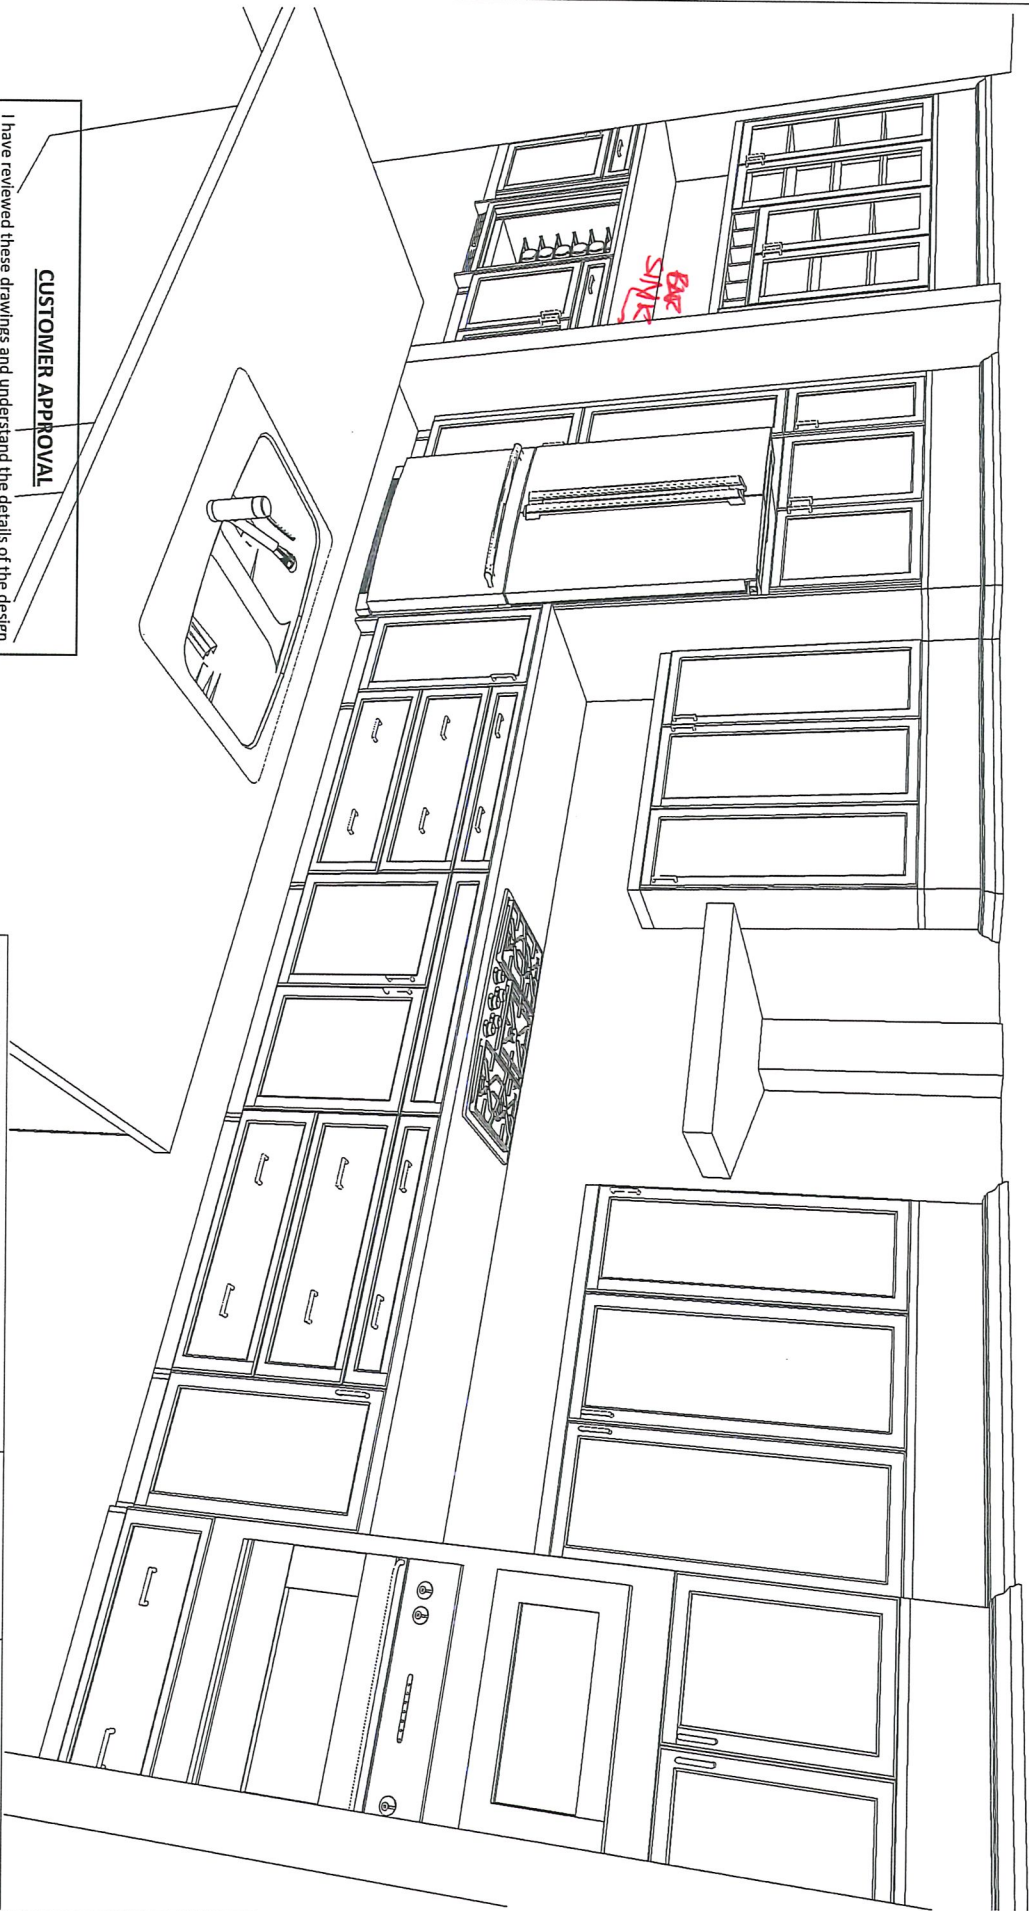

CUSTOMER APPROVAL

I have reviewed these drawings and understand the details of the design and the CARTIER KITCHENS specifications.

Signature _____

Date _____

Note: This drawing is an artistic interpretation of the general appearance of the design. It is not meant to be an exact rendition.

SPECTRUM KITCHEN and BATH DESIGN




Designed: 2020-02-26
Printed: 2020-02-26



DCR #43 DV - NEWINGTON - CHEF'S KITCHEN

All

Drawing #: 1

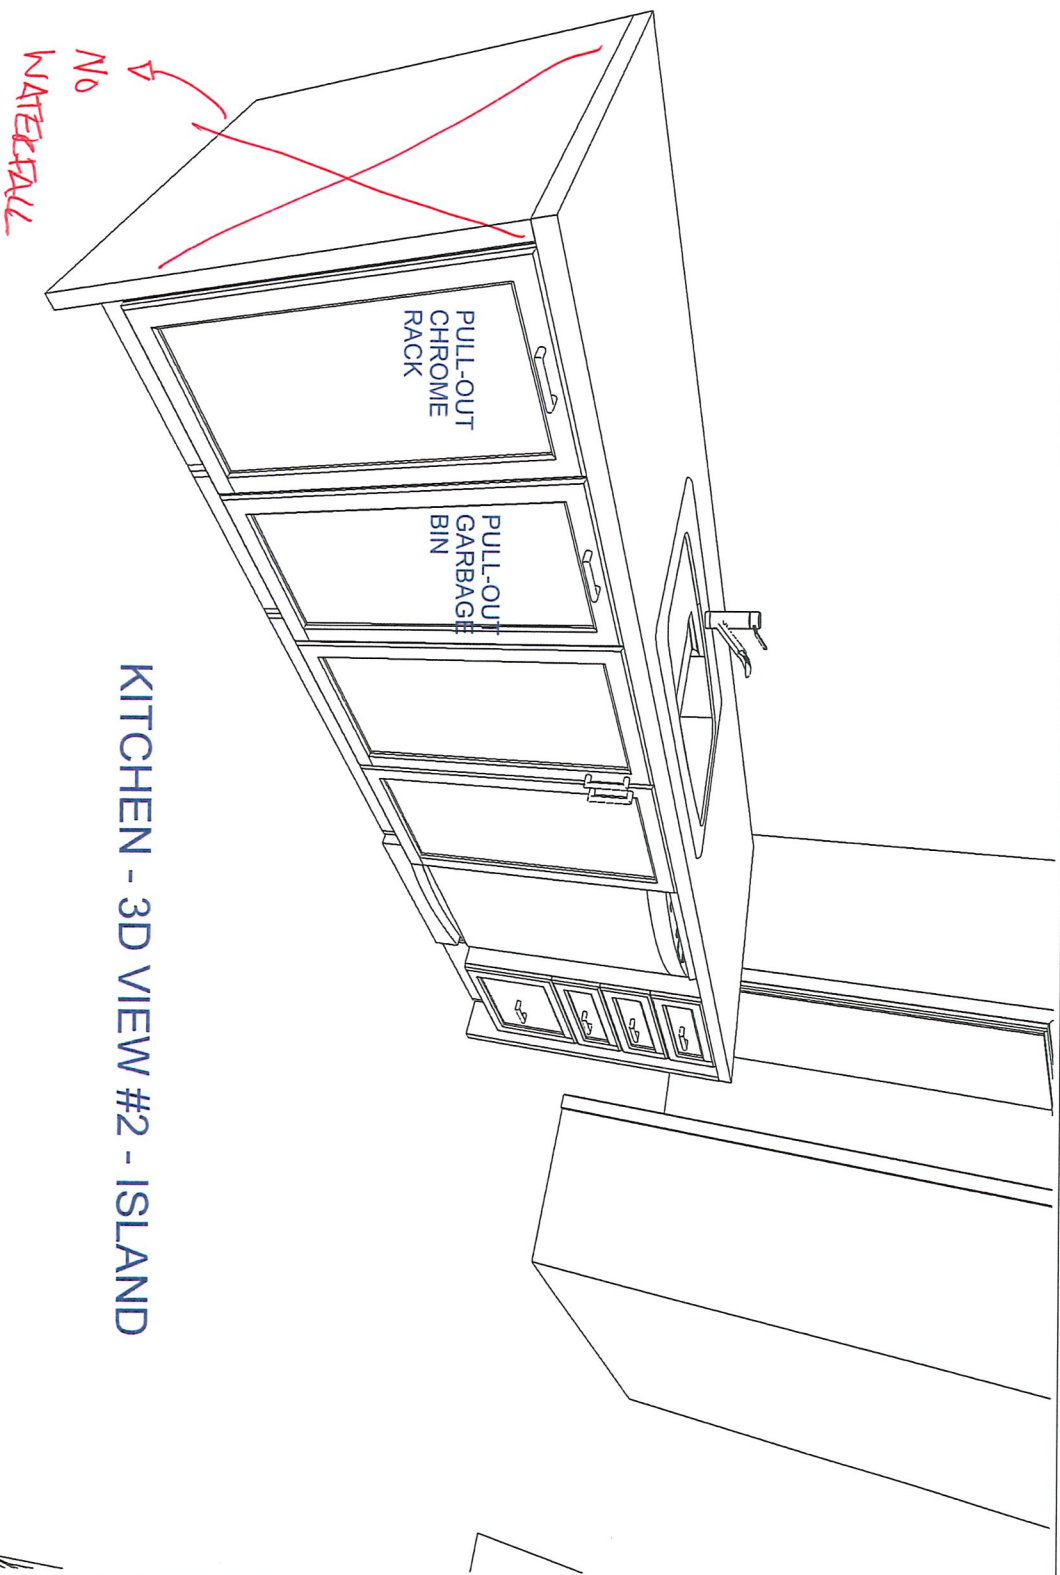

KITCHEN - 3D VIEW #2 - ISLAND

CUSTOMER APPROVAL

I have reviewed these drawings and understand the details of the design and the CARTIER KITCHENS specifications.

Signature _____

Date _____

Note: This drawing is an artistic interpretation of the general appearance of the design. It is not meant to be an exact rendition.

SPECTRUM KITCHEN and BATH DESIGN




Designed: 2020-02-26
Printed: 2020-02-26

Wm *Sm*

DCR #43 DV - NEWINGTON - CHEF'S KITCHEN

All

Drawing #: 1

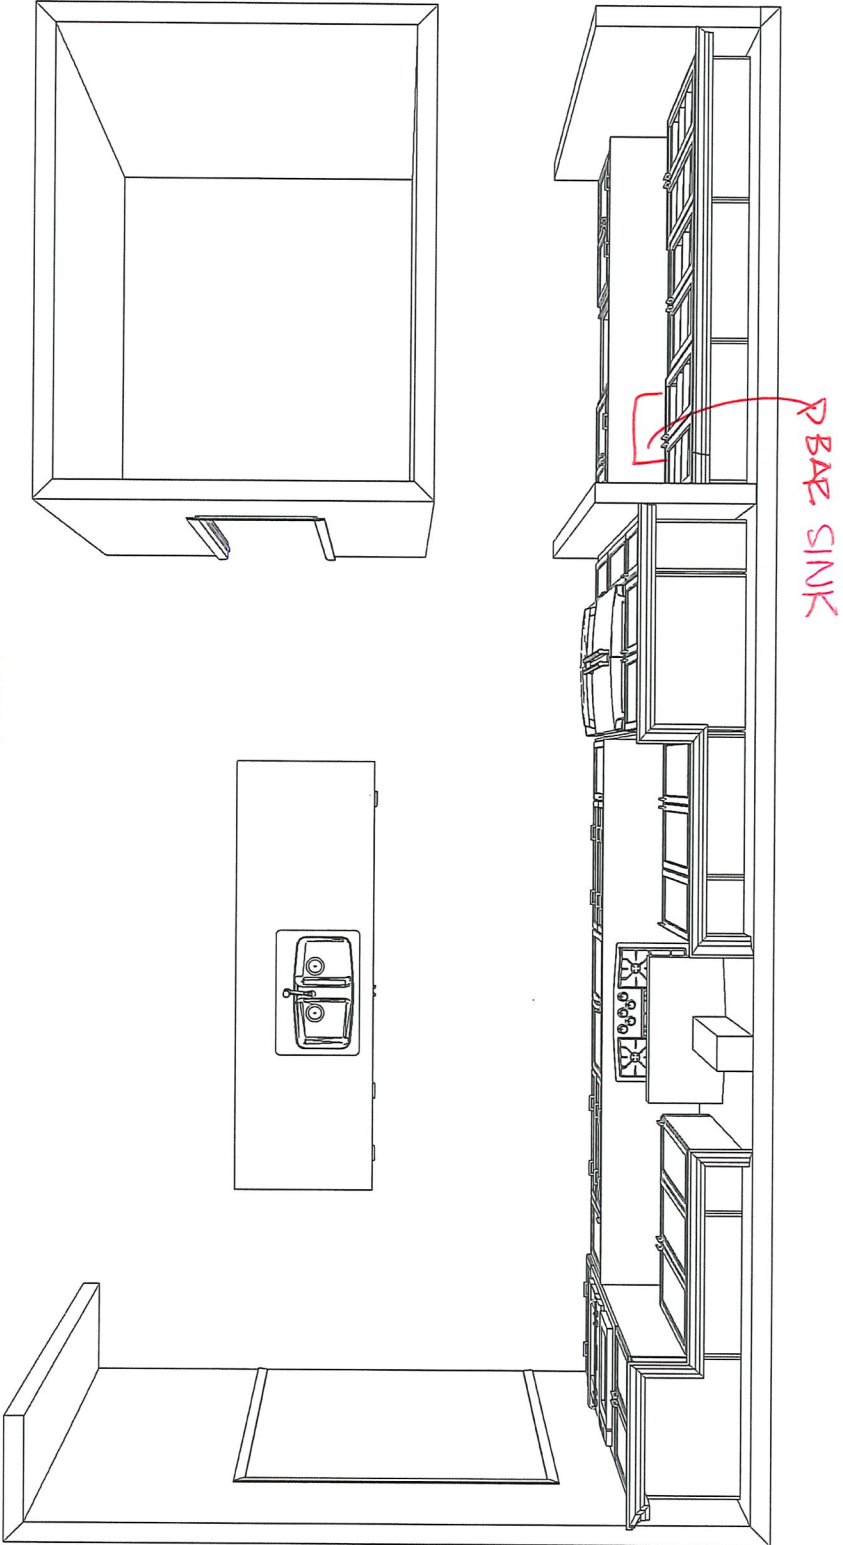

KITCHEN - TOP VIEW

CUSTOMER APPROVAL

I have reviewed these drawings and understand the details of the design and the CARTIER KITCHEN'S specifications.

Signature _____

Date _____

Note: This drawing is an artistic interpretation of the general appearance of the design. It is not meant to be an exact rendition.

SPECTRUM KITCHEN and BATH DESIGN




Designed: 2020-02-26
Printed: 2020-02-26

Am *Sm*

DCR #43 DV - NEWINGTON - CHEF'S KITCHEN

All

Drawing #: 1

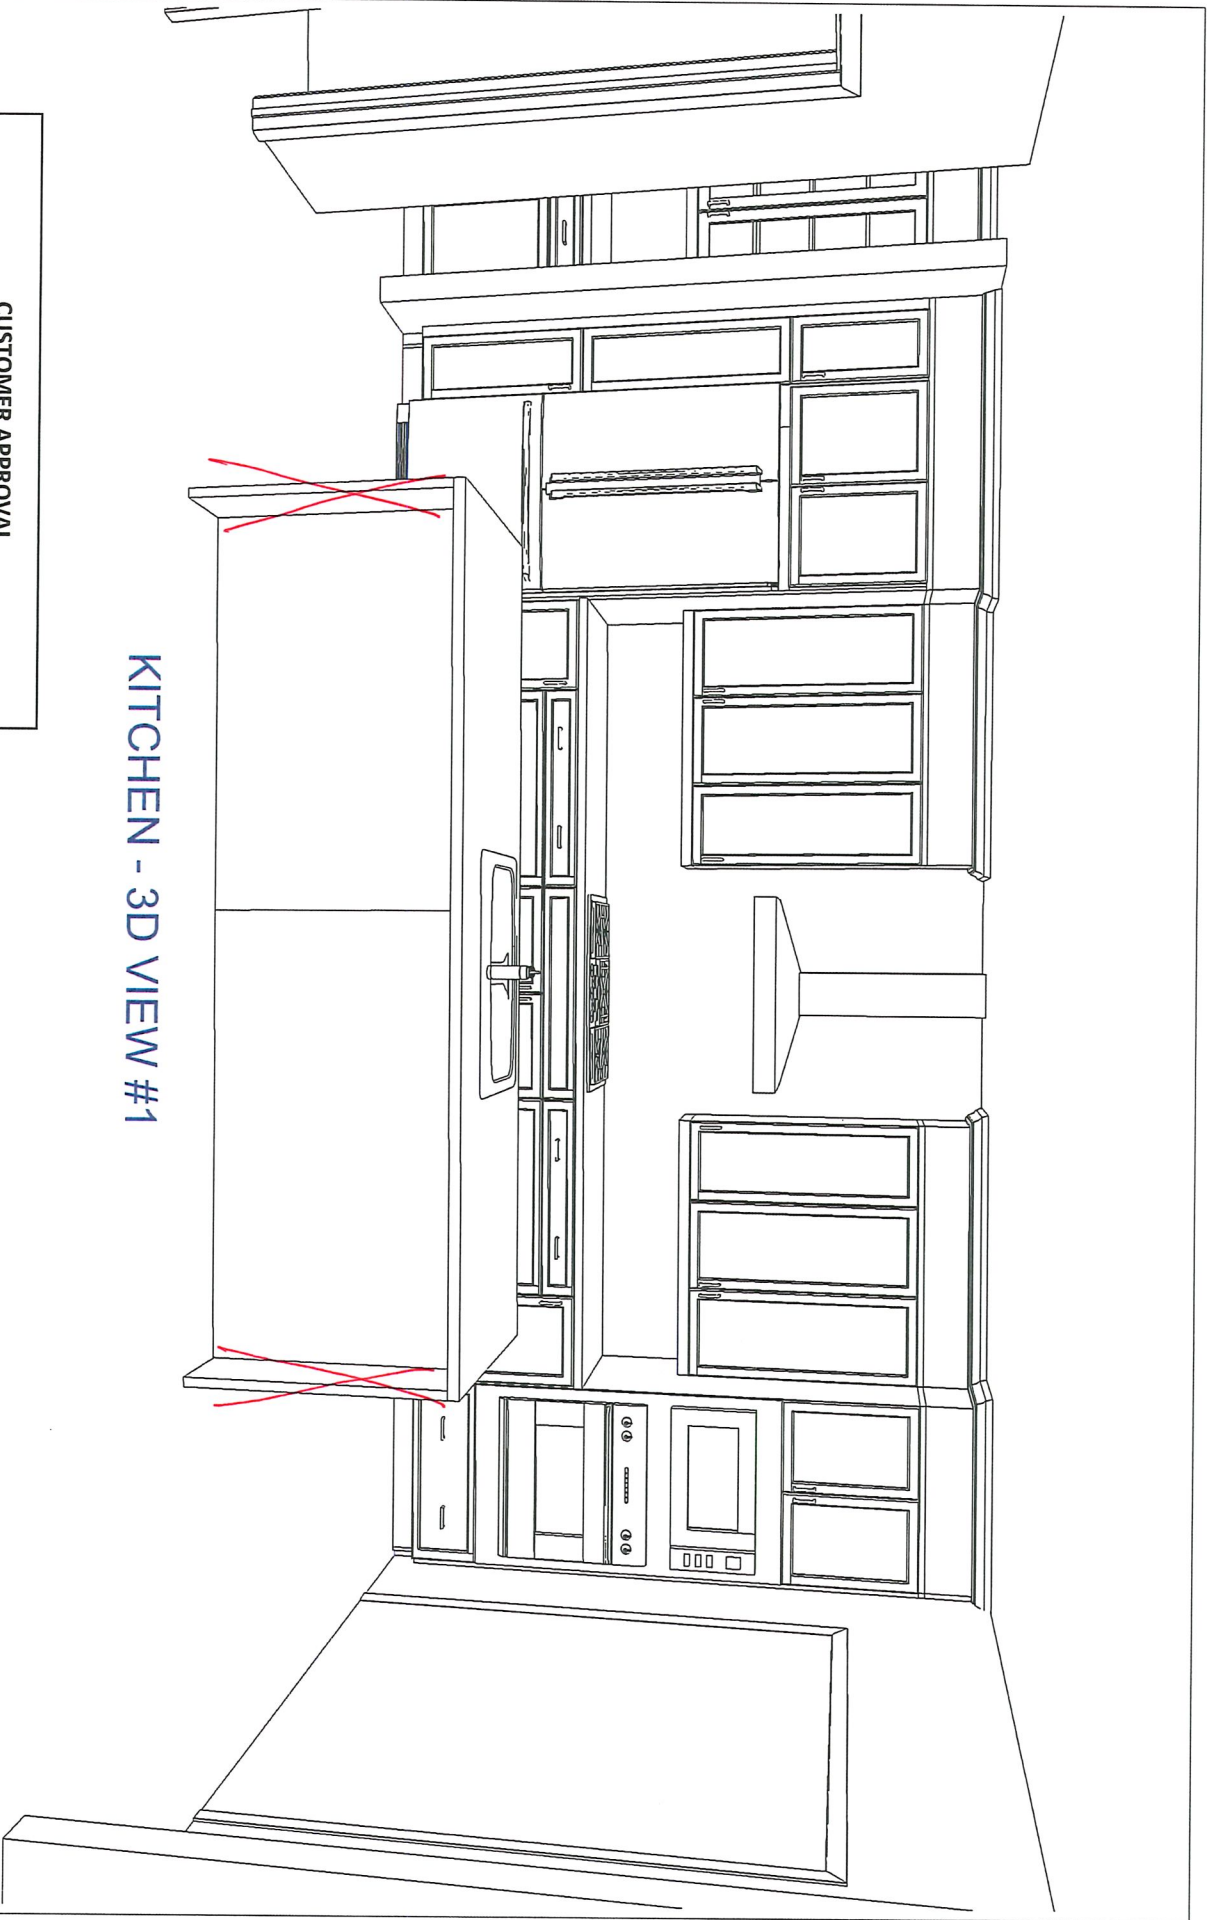

KITCHEN - 3D VIEW #1

CUSTOMER APPROVAL

I have reviewed these drawings and understand the details of the design and the CARTIER KITCHENS specifications.

Signature _____

Date _____

Note: This drawing is an artistic interpretation of the general appearance of the design. It is not meant to be an exact rendition.

SPECTRUM KITCHEN and BATH DESIGN



Designed: 2020-02-26
Printed: 2020-02-26

Nm *Sm*

DCR #43 DV - NEWINGTON - CHEF'S KITCHEN

All

Drawing #: 1