

DCR PHOENIX HOMES

LOT # 119

PATHWAYS


MODEL: MIRAPOSA PLUS (LEFT)

KITCHEN & VANITIES


GROUND FLOOR KITCHEN

MOUNTING HEIGHT 96"H.
42" H. UPPERS INSTALLED
@18" ABOVE COUNTER

- CABINETS -
HARDWARE -
STANDARD WHITE INTERIORS
METAL DRAWER BOX
4 PCS - 5/8" TOEKICK
1PCS - 90 DEG. CORNER MOULD
1PCS - T MOULD
8 PCS - FLAT MOULDINGS

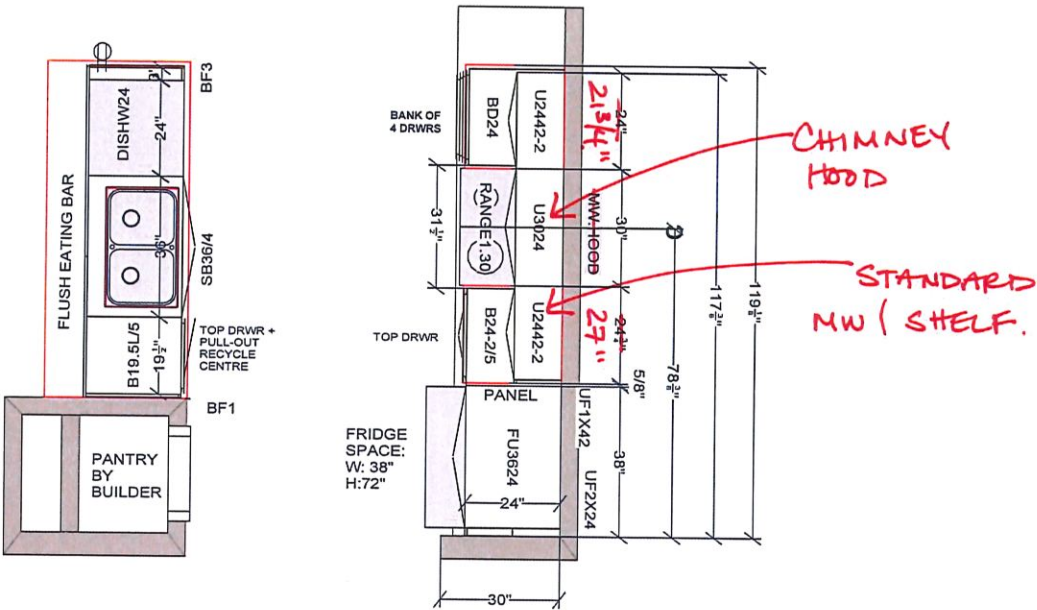

VANITIES

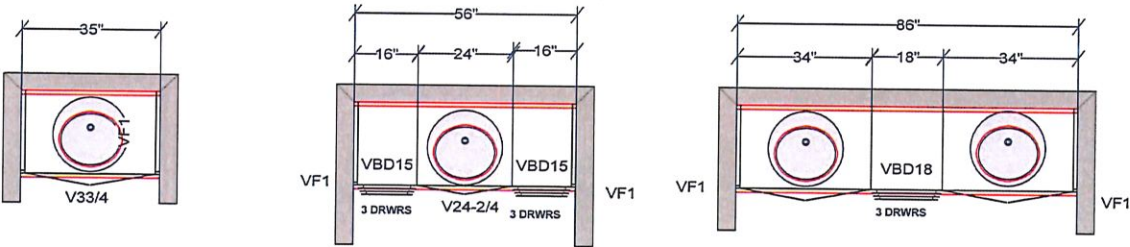

POWDER ROOM

MAIN BATH

LUXURY ENSUITE

<p>CUSTOMER APPROVAL</p> <p>I have reviewed these drawings and understand the details of the design and the Contractor's specifications.</p> <p>Signature: <u>JSB</u></p> <p>Date: _____</p>	<p>All dimensions, size designations given are subject to verification on job site and adjustment to fit job conditions.</p> <p>SPECTRUM KITCHEN & BATH DESIGN</p>	<p>This is an original design and must not be released or copied unless applicable fee has been paid or job order placed.</p>	<p>Designed: 9/13/2020 Printed: 9/14/2020</p>
DCR #119 Pathways - MIRAPOSA - Kitchen vanities		All	Drawing #: 1 No Scale.

Dec. 18/20.

DCR PHOENIX HOMES

LOT #119
PATHWAYS
MODEL: 35-32 MIRAPOSA PLUS



BASEMENT APARTMENT

KITCHEN & VANITIES

- CABINETS -
HARDWARE -
STANDARD WHITE INTERIORS
METAL DRAWER BOX
4 PCS - 5/8" TOEKICK
1PCS - 90 DEG. CORNER MOULD
1PCS - T MOULD
8 PCS - FLAT MOULDINGS

KITCHEN

MOUNTING HT: 96
42"H UPPERS INSTALLED
@ 18" ABOVE COUNTER

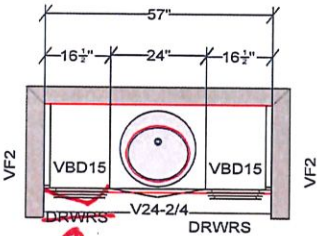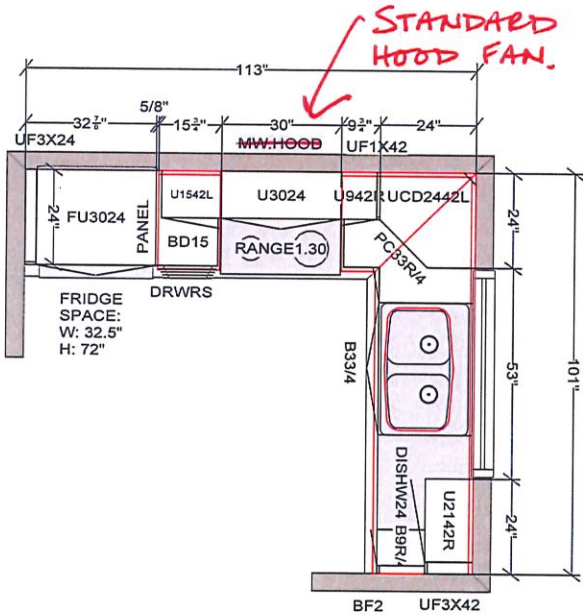

STANDARD DOOR
BSMT APT VANITY

<p>CUSTOMER APPROVAL</p> <p>I have reviewed these drawings and understand the details of the design and the Carver Kitchens specifications</p> <p>Signature <u>JSB</u></p> <p>Date _____</p>	<p>All dimensions, size designations given are subject to verification on job site and adjustment to fit job conditions.</p>	<p>SPECTRUM KITCHEN & BATH DESIGN</p>	<p>This is an original design and must not be released or copied unless applicable fee has been paid or job order placed.</p>	<p>Designed: 9/13/2020 Printed: 9/14/2020</p>
DCR #119 Pathways - Bsmt Apt. - MIRAPOSA PLUS				All Drawing #: 1 No Scale.