

PWT BLK 12
LOT 122


DCR PHOENIX HOMES

TOWNHOUSE 20-18 - ELSTON
KITCHEN / VANITIES


MOUNTING HEIGHT: 96"H

→ 42"H UPPERS


- LINE 2
- HARDWARE - STD & 1st UPGRADE
 - STANDARD WHITE INTERIOR
 - METAL DRAWER BOX
 - 6 PCS - 5/8" KICK - FIN. BOTH ENDS
 - 2 PCS - LOOSE FILLER - 6 x 96
 - 2 PCS - 90 DEG. CORNER MOULD
 - 1 PCS - T-MOULD
 - 6 PCS - FLAT MOULDING

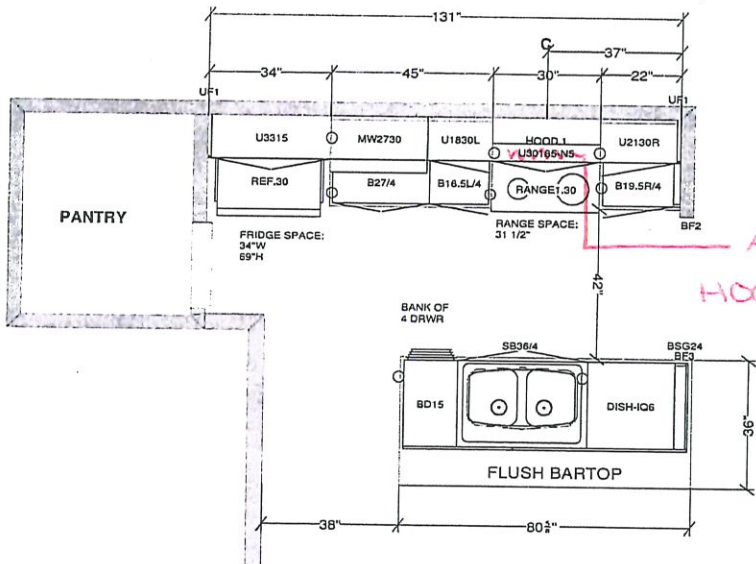


ACC. FOR CHIMNEY
HOOD FAN

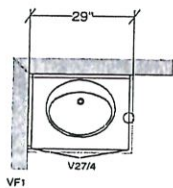


POWDER

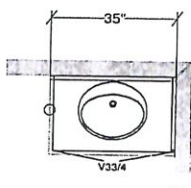

MAIN

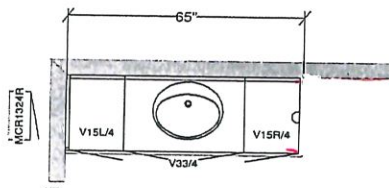

ENSUITE

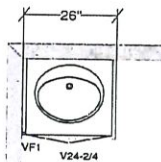

OPTIONAL REC ROOM VANITY

Handwritten initials and signature

All dimensions .size designations given are subject to verification on job site and adjustment to fit job conditions.	This is an original design and must not be released or copied unless applicable fee has been paid or job order placed.	Designed: 2018-02-28 Printed: 2018-03-01	
		DRAWN BY: LORI DISAVERIO, B.I.D	
SPECTRUM KITCHEN and BATH DESIGN			
TH 20 - 18 - Elston - KIT .VAN.kit	All	Drawing #: 1	No Scale.