


PW LOT 5


DCR PHOENIX HOMES

MODEL - WINCHESTER (43-4)
KITCHEN
MOUNTING HEIGHT - 84


- LINE - 1 & 2
HARDWARE - STD & 1ST UPGRADE
STANDARD WHITE INTERIOR
METAL DRAWER BOX
4 PCS - 5/8" KICK - FIN. BOTH ENDS
2 PCS - LOOSE FILLER - 6 x 96
2 PCS - 90 DEG. CORNER MOULD
1 PCS - T-MOULD

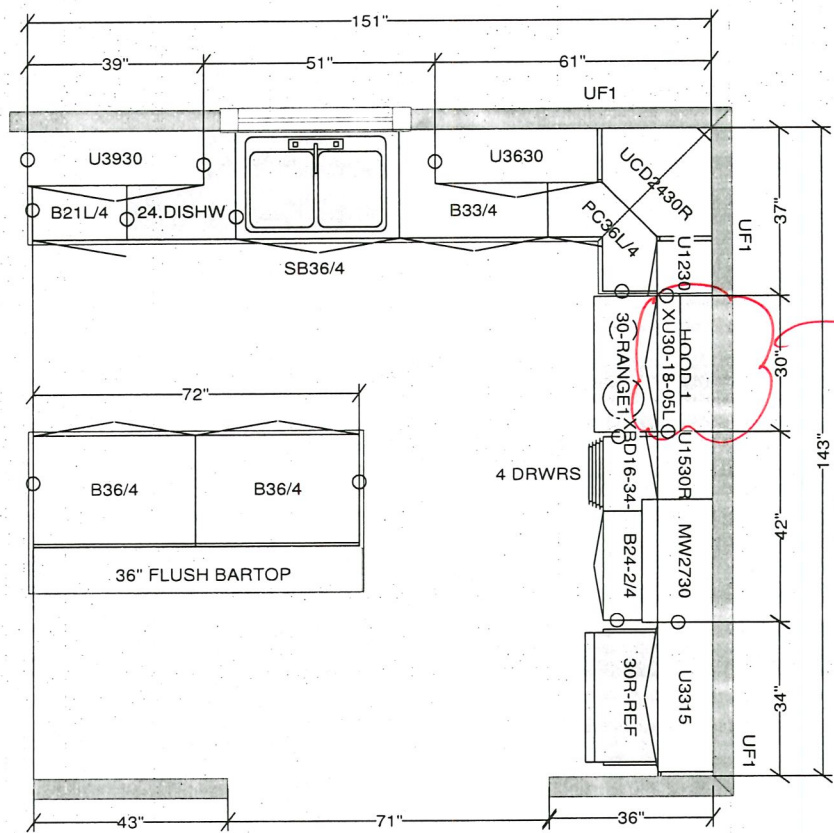


DELETE FOR
FUTURE CHIMNEY
HOODFAN
*CLIENT TO SUPPLY
& INSTALL THEIR
OWN HOODFAN*
(APPROVED BY J.S.)

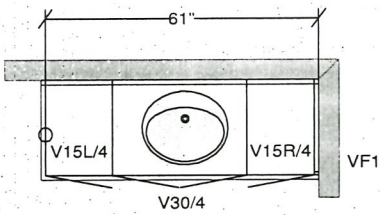

POWDER

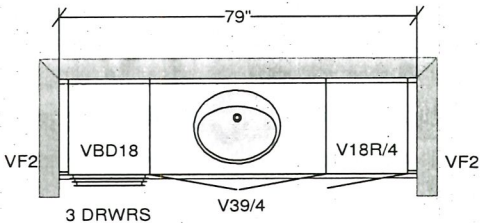

MAIN BATH

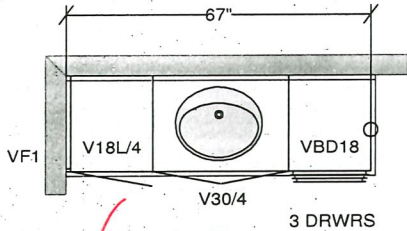

ENSUITE

(2) SINKS &
BANK OF DRWRS MOVED
TO MIDDLE

All dimensions & size designations
given are subject to verification on
job site and adjustment to fit job
conditions.

Cartier Kitchens Ottawa



This is an original design and must
not be released or copied unless
applicable fee has been paid or job
order placed.

Drawn by: Lori Di Saverio, B.I.D.
Cartier Kitchens Ottawa


Designed: 17/07/2013
Printed: 13/10/2014

43-4 Winchester.kit

All

Drawing #: 1 No Scale.

PW LOT 5

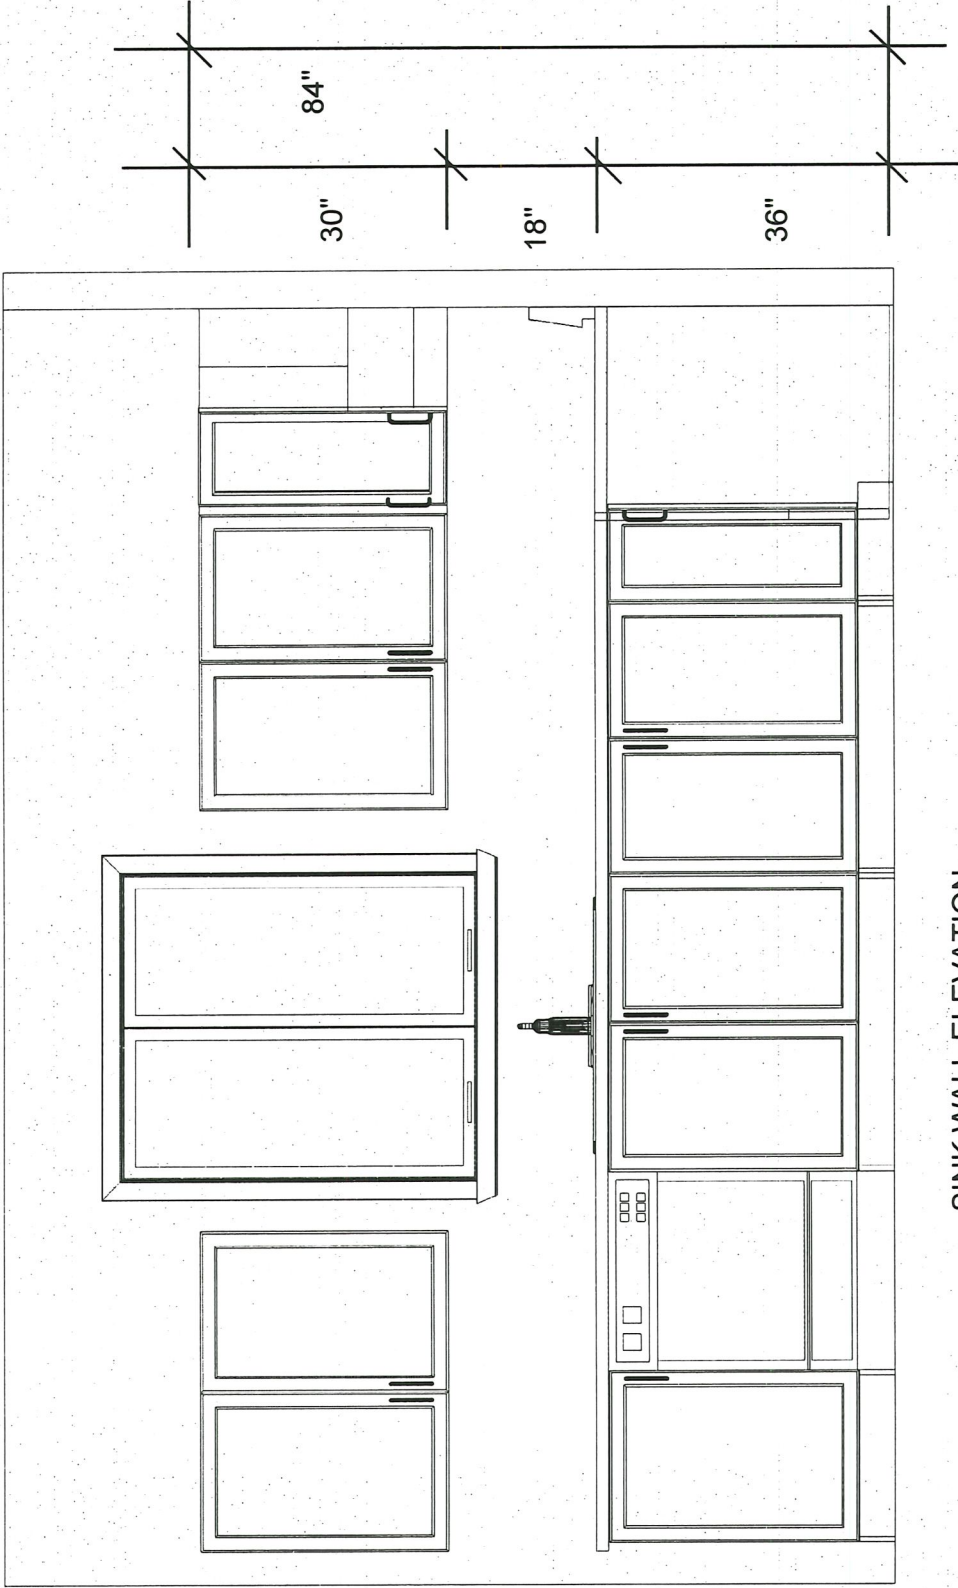


SINK WALL ELEVATION

Note: This drawing is an artistic interpretation of the general appearance of the design. It is not meant to be an exact rendition.		Designed: 17/07/2013 Printed: 27/03/2014	
		All	Drawing #: 1
Drawn By: Lori D Saverio, B.I.D. Cartier Kitchens Ottawa 43-4 Winchester.kit			

PM Lot 5

DELETE FOR FUTURE HOODSPAN.

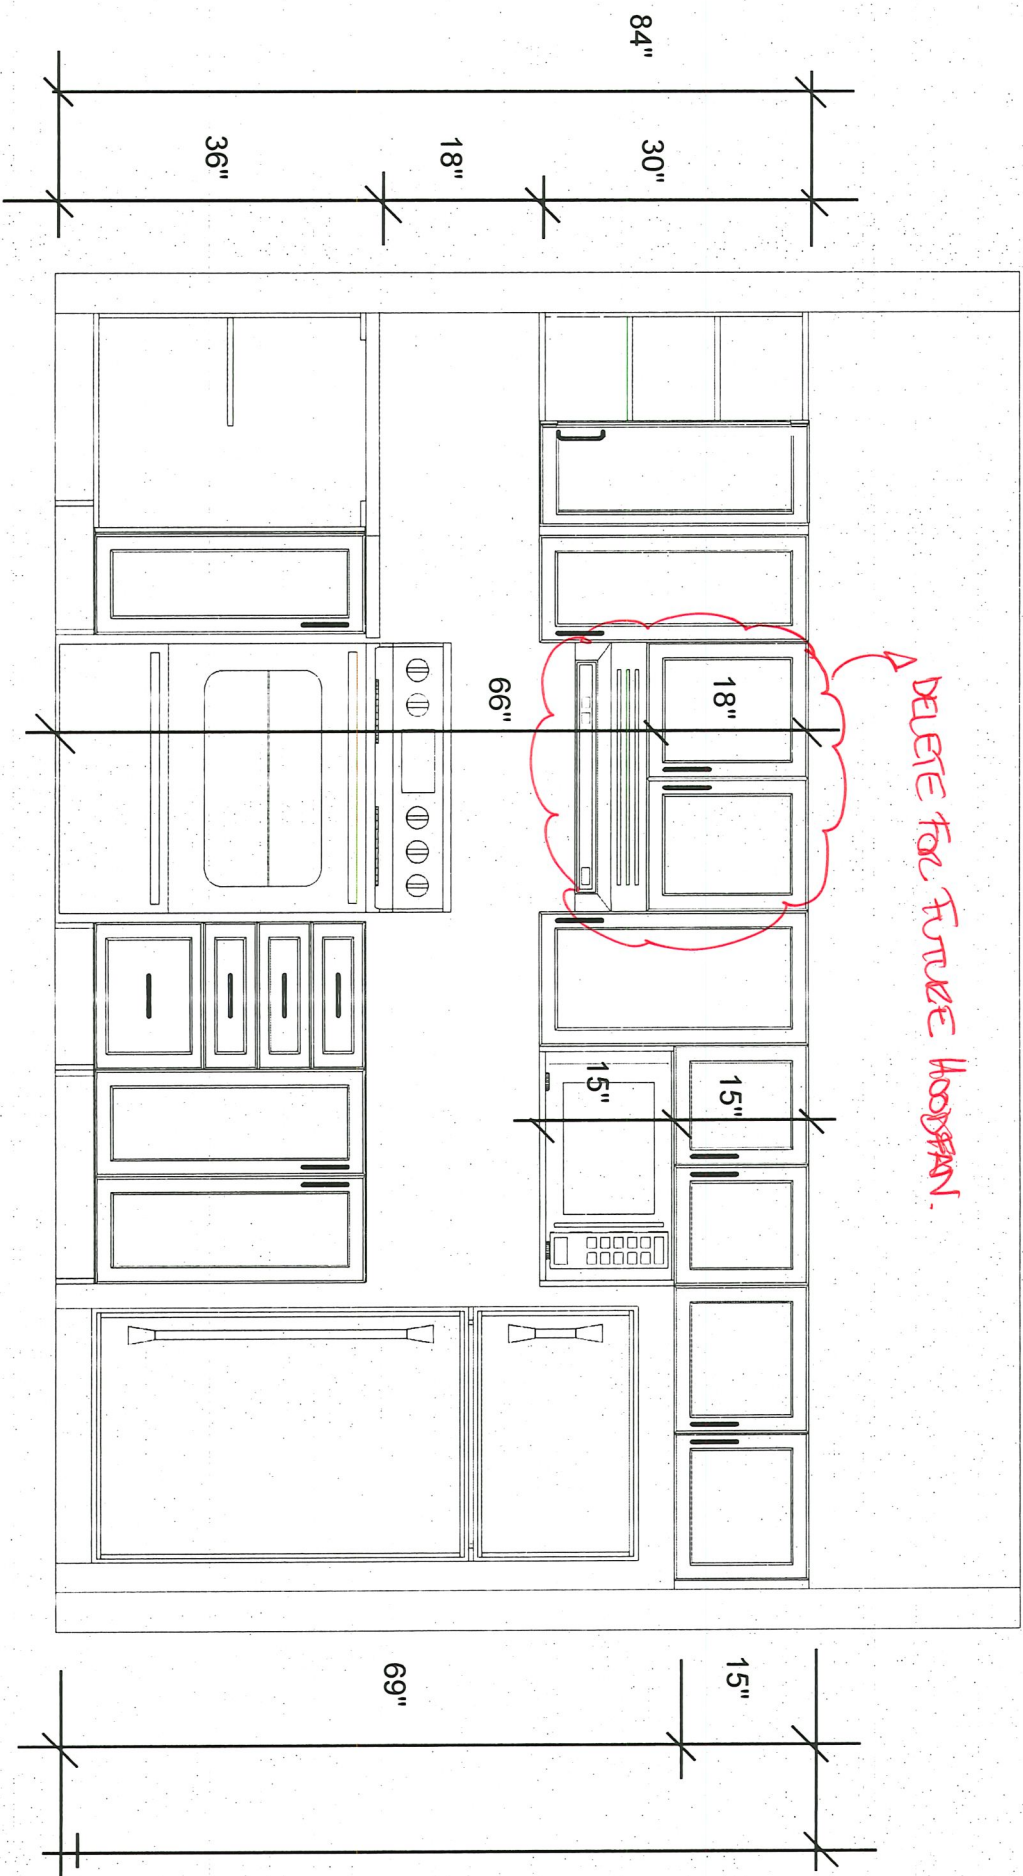

STOVE / FRIDGE WALL ELEVATION

Note: This drawing is an artistic interpretation of the general appearance of the design. It is not meant to be an exact rendition.


Drawn By: Lori D Saverio, B.I.D.
Cartier Kitchens Ottawa
43-4 Winchester.kit



Designed: 17/07/2013
Printed: 27/03/2014

PM LOT 5

(2) SINKS & BOB MOVE TO
A MIDDLE

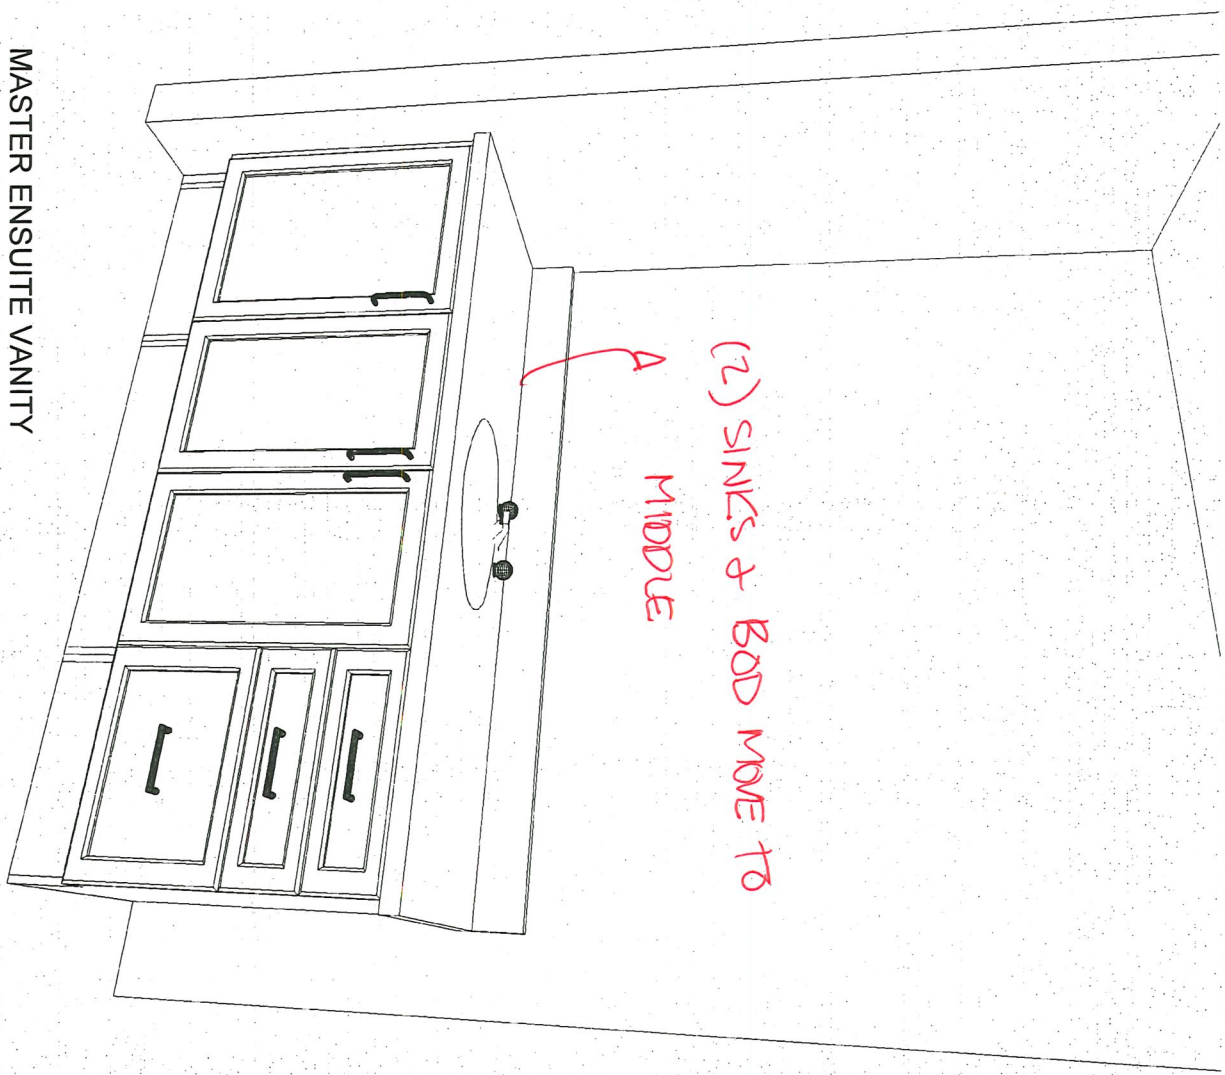

MASTER ENSUITE VANITY

Note: This drawing is an artistic interpretation of the general appearance of the design. It is not meant to be an exact rendition.

Drawn By: Lori D Saverio, B.I.D.
Cartier Kitchens Ottawa
43-4 Winchester kit




Designed: 17/07/2013
Printed: 27/03/2014

All

Drawing #: 1

PN LOT 5

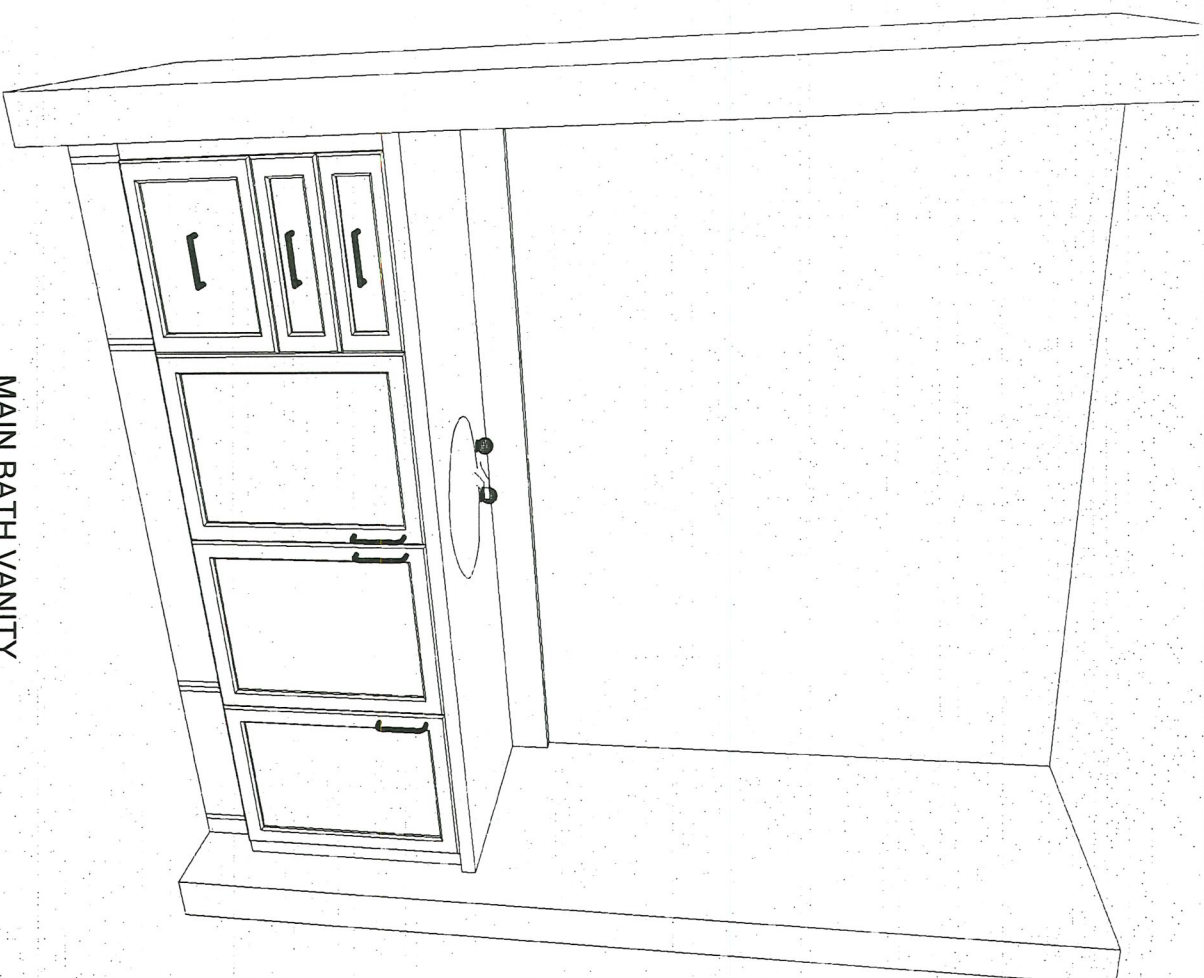

MAIN BATH VANITY

Note: This drawing is an artistic interpretation of the general appearance of the design. It is not meant to be an exact rendition.

Drawn By: Lori D Saverio, B.I.D.
Cartier Kitchens Ottawa
43-4 Winchester kit




Designed: 17/07/2013
Printed: 27/03/2014

All

Drawing #: 1

PW 16T 5

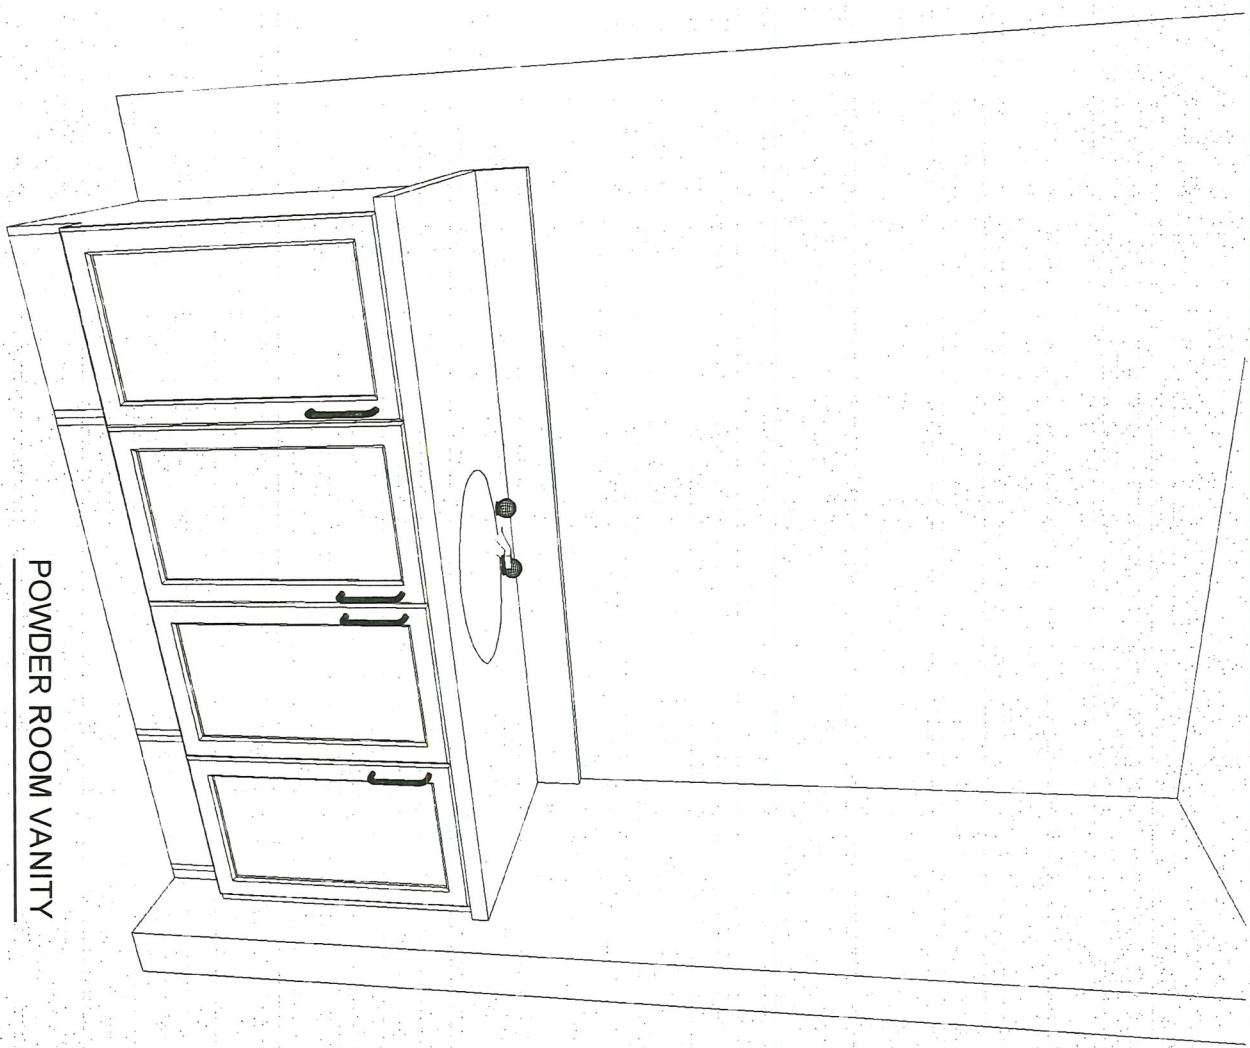

POWDER ROOM VANITY

Note: This drawing is an artistic interpretation of the general appearance of the design. It is not meant to be an exact rendition.

Drawn By: Lori D Saverio, B.I.D.
Cartier Kitchens Ottawa
43-4 Winchester.kit



Designed: 17/07/2013
Printed: 27/03/2014

All

Drawing #: 1