
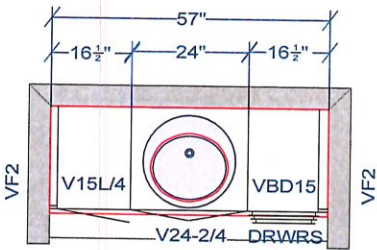


DCR PHOENIX HOMES

MODEL: 35-32 MIRAPOSA
BASEMENT APARTMENT
KITCHEN & VANITIES

LINE -
HARDWARE -
STANDARD WHITE INTERIORS
METAL DRAWER BOX
4 - 5/8" TOEKICK FINISHED BOTH ENDS
3- LOOSE FILLER , 3X96
1PCS - 90 DEG. CORNER MOULD
1PCS - T MOULD
8 PCS - FLAT MOULDINGS

KITCHEN
MOUNTING HT: 84

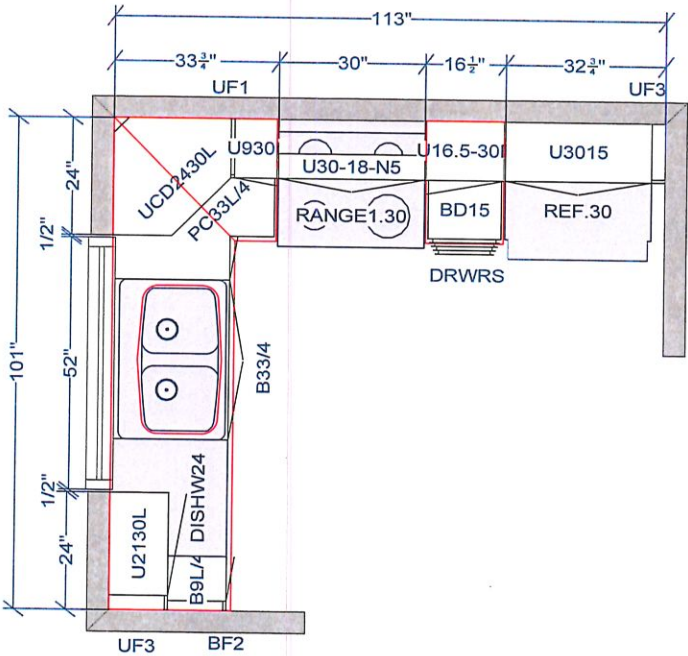

BSMT APT VANITY

CUSTOMER APPROVAL

I have reviewed these drawings and understand the details of the design and the Client's specifications.

Signature: [Signature]

Date:

All dimensions ,size designations given are subject to verification on job site and adjustment to fit job conditions.



This is an original design and must not be released or copied unless applicable fee has been paid or job order placed.

Designed: 2018-07-11
Printed: 2018-07-11


DCR PHOENIX HOMES

MODEL: 35-32 MIRAPOSA with Bsmt Apt
KITCHEN & VANITIES



- LINE -
- HARDWARE -
- STANDARD WHITE INTERIORS
- METAL DRAWER BOX
- 4 - 5/8" TOEKICK FINISHED BOTH ENDS
- 3 - LOOSE FILLER, 3X96
- 1PCS - 90 DEG. CORNER MOULD
- 1PCS - T MOULD
- 8 PCS - FLAT MOULDINGS

Ground Floor KITCHEN

MOUNTING HEIGHT 84" **96"**

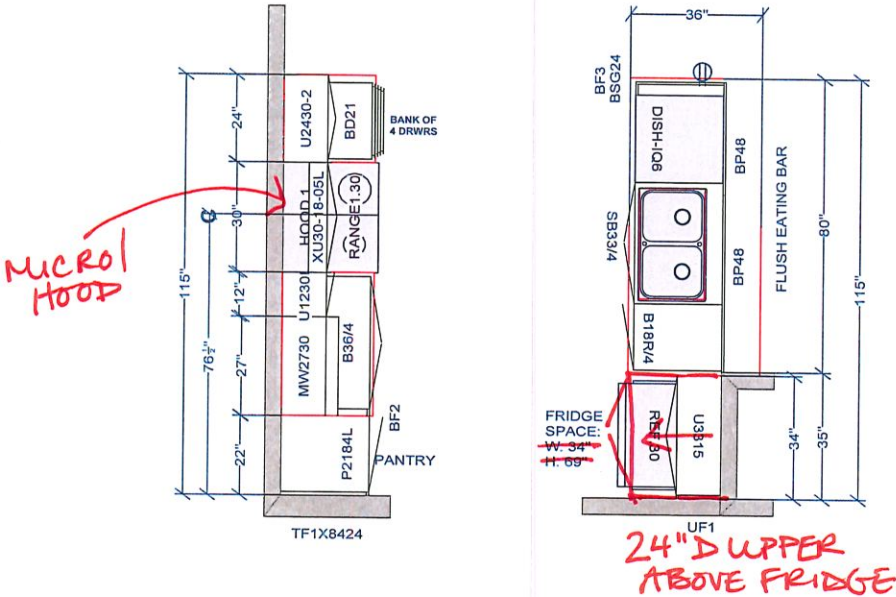

VANITIES

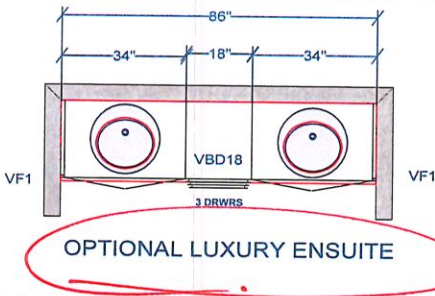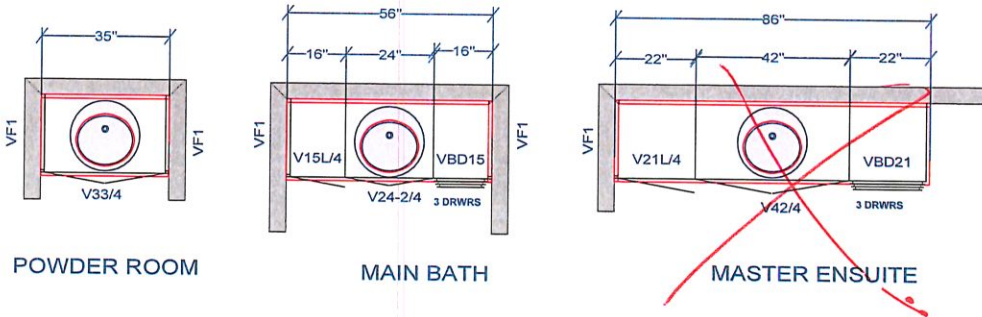

CUSTOMER APPROVAL I have reviewed these drawings and understand the details of the design and the Carter Kitchens specifications. Signature: <u>[Signature]</u> Date: <u>[Signature]</u>	All dimensions, size designations given are subject to verification on job site and adjustment to fit job conditions.	SPECTRUM KITCHEN & BATH DESIGN	This is an original design and must not be released or copied unless applicable fee has been paid or job order placed.	Designed: 2018-07-11 Printed: 2018-07-12
MIRAPOSA - GR Floor 2nd Floor with Bsmt Apt	LOT 171 PW.	All	Drawing #: 1	No Scale.