

PWT BUK 12 LOT 121

DCR PHOENIX HOMES

TOWNHOUSE 20-18 - ELSTON
KITCHEN / VANITIES

MOUNTING HEIGHT: 40

36" H UPPERS

LINE 1

HARDWARE - STD & 1st UPGRADE

STANDARD WHITE INTERIOR

METAL DRAWER BOX



6 PCS - 5/8" KICK - FIN. BOTH ENDS

2 PCS - LOOSE FILLER - 6 x 96


2 PCS - 90 DEG. CORNER MOULD

1 PCS - T-MOULD


6 PCS - FLAT MOULDING

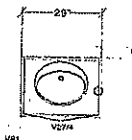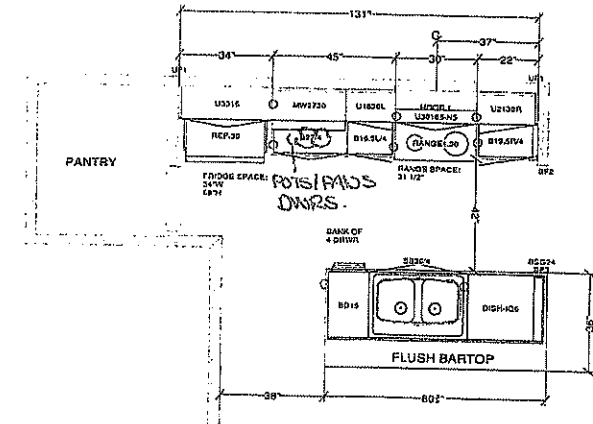


POWDER

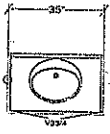

MAIN

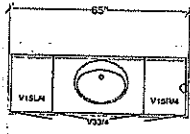

ENSUITE

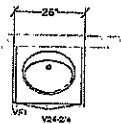

OPTIONAL REC ROOM VANITY

All dimensions & size designations given are subject to verification on job site and adjustment to fit job conditions.

SPECTRUM KITCHEN and BATH DESIGN

TH 20 - 18 - Elston - KJT_VAN.kit

This is an original design and must not be released or copied unless applicable fee has been paid or job order placed.

DRAWN BY: LORI DISAVERIO, B.I.D

Designed: 2018-02-28
Printed: 2018-03-01

All

Drawing #: 1 No Scale.