

DCR PHOENIX HOMES

LOT #50

DIAMONDVIEW ESTATES

MODEL - OAKSIDE (B-20) - 3 BDRM with LOFT

KITCHEN

MOUNTING HEIGHT -96

42" H. UPPERS INSTALLED  
@ 18" ABOVE COUNTER

~~CROWN MOLDING DEL.~~  
~~LIGHT VALANCE DEL.~~

CABINETS -

HARDWARE -

STANDARD WHITE INTERIOR

METAL DRAWER BOX

6 PCS - 56" KICK - FIN BOTH ENDS

1 PCS - 90 DEG. CORNER MOULD


1 PCS - T-MOULD

7 PCS - FLAT MOULD



REVISED: SEPT 18-20

MONDOLF  
GREY Wg


NOTE:  
BUILDER TO  
MOVE WINDOW

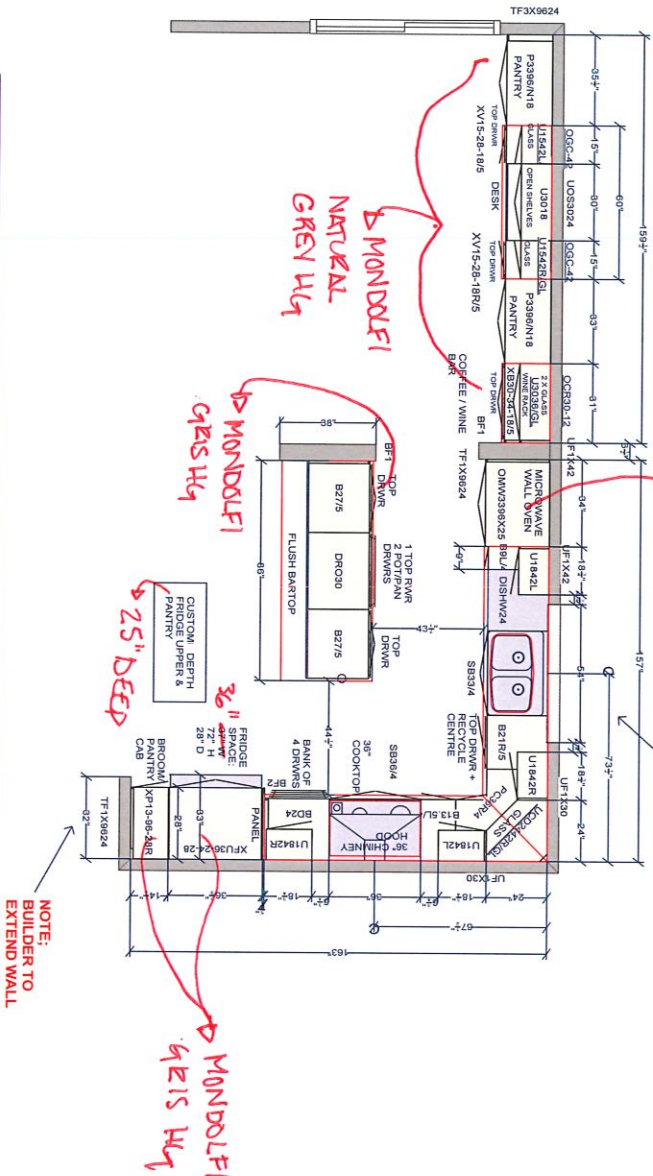


VANITIES

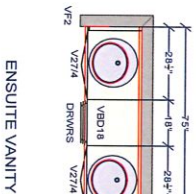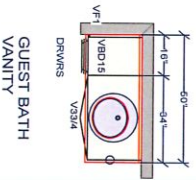

ENSUITE  
NICHE  
BANK OF 4 DRWS  
& COUNTER TOP  
ABOVE - 48\"/>

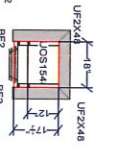

LAUNDRY ROOM

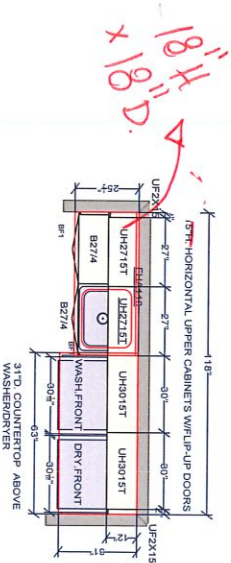

CUSTOMER APPROVAL

I have reviewed these drawings and understand the details of the design and the Carter Kitchens specifications

Signature \_\_\_\_\_

Date \_\_\_\_\_




This is an original design and must not be released or copied unless applicable fee has been paid or job order placed.

Designed: 9/21/2020  
Printed: 9/21/2020

DCR #50DV - rev Sep 18-20

All

Drawing #: 1 No Scale.

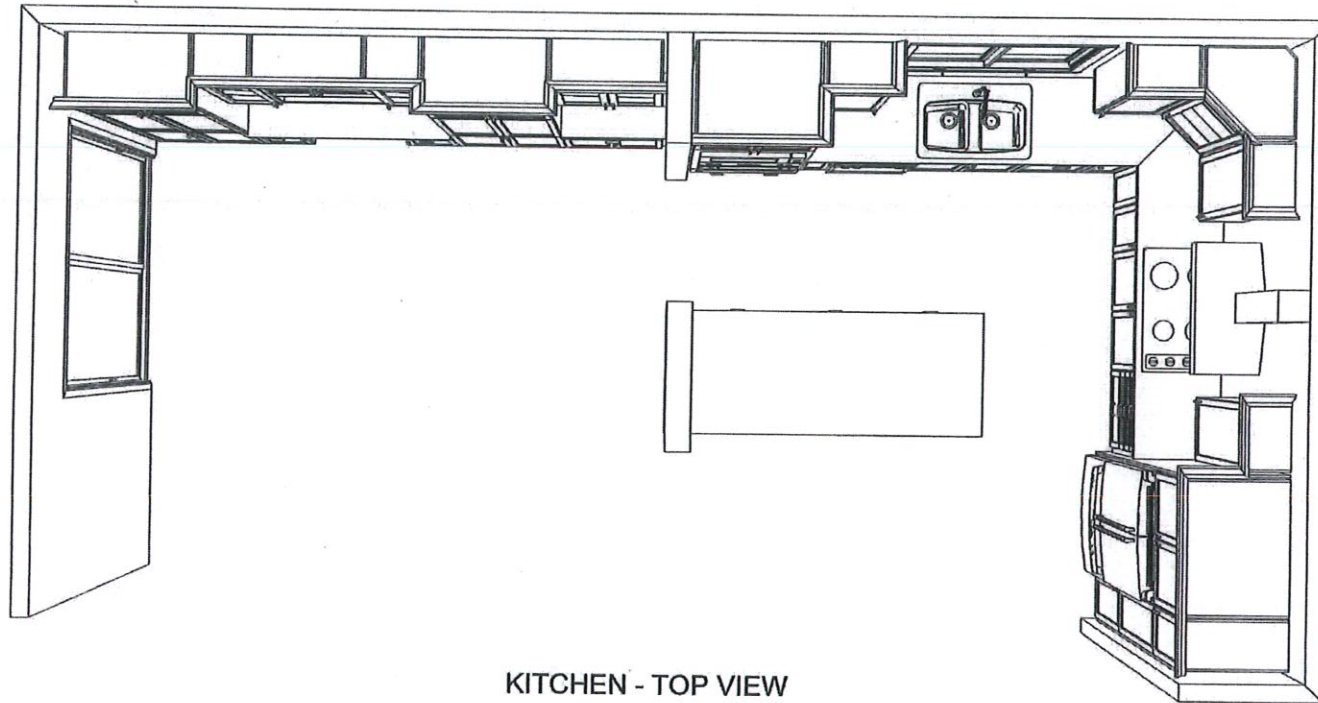

KITCHEN - TOP VIEW

REVISED SEPT 18/20

CUSTOMER APPROVAL


I have reviewed these drawings and understand the details of the design and the Carter Kitchen specifications.

Signature [Signature]  
Date Jan-20-2021

Note: This drawing is an artistic interpretation of the general appearance of the design. It is not meant to be an exact rendition.



Designed: 9/21/2020  
Printed: 9/21/2020

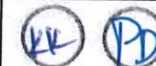

DCR #50DV - rev Sep 18-20

All

Drawing #: 1



REVISED SEPT 18/20

KITCHEN - 3D VIEW #1

**CUSTOMER APPROVAL**  
I have reviewed these drawings and understand the details of the design and the Carter Kitchens specifications.  
Signature *S. Smith*  
Date *Jan-20-2021*

Note: This drawing is an artistic interpretation of the general appearance of the design. It is not meant to be an exact rendition.



Designed: 9/17/2020  
Printed: 9/21/2020




DCR #50DV - rev Sep 18-20

All

Drawing #: 1



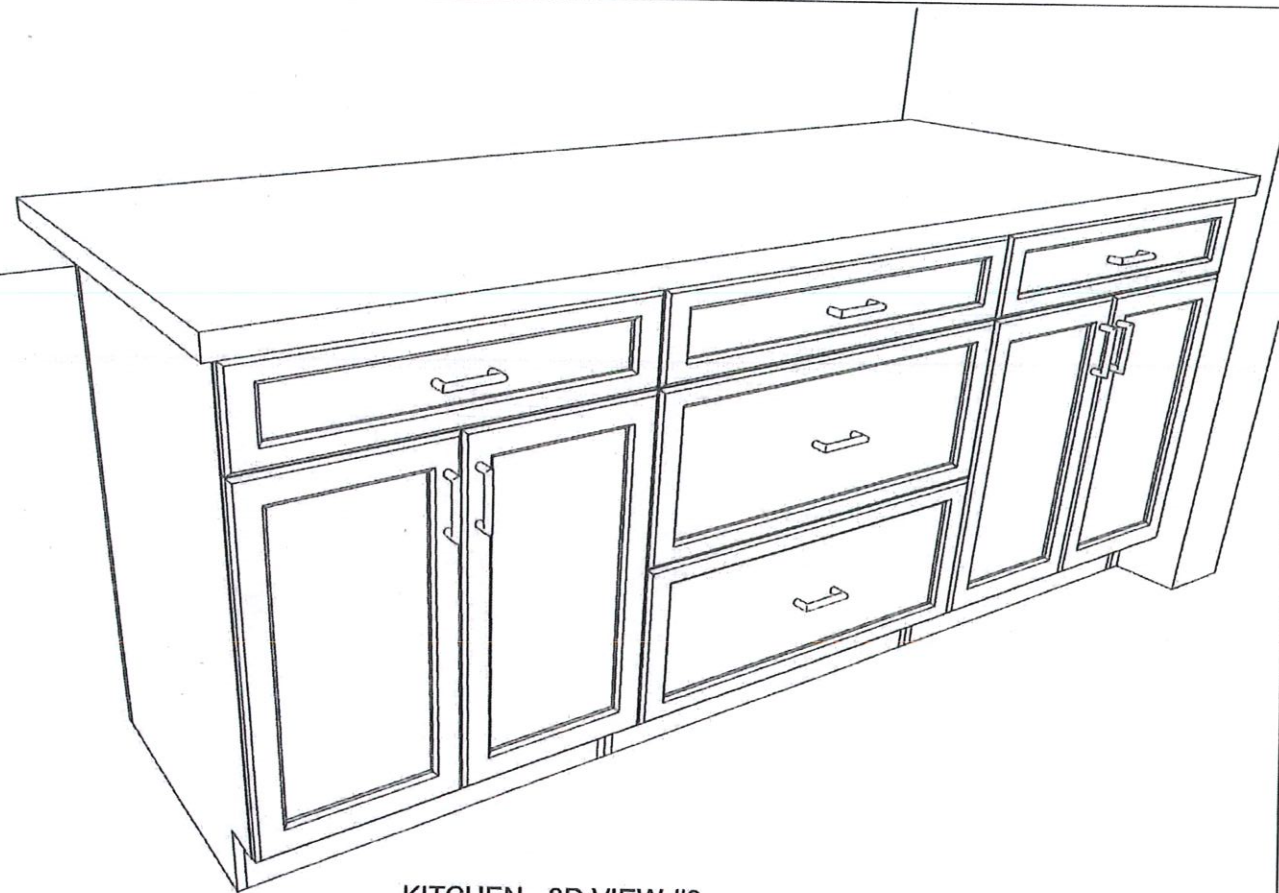


KITCHEN - 3D VIEW #2

REVISED SEPT 18/20

CUSTOMER APPROVAL

I have reviewed these drawings and understand the details of the design and the Carter Kitchen specifications.

Signature:   
Date: Jan-20-2021

Note: This drawing is an artistic interpretation of the general appearance of the design. It is not meant to be an exact rendition.




Designed: 9/17/2020  
Printed: 9/21/2020



DCR #50DV - rev Sep 18-20


All

Drawing #: 1

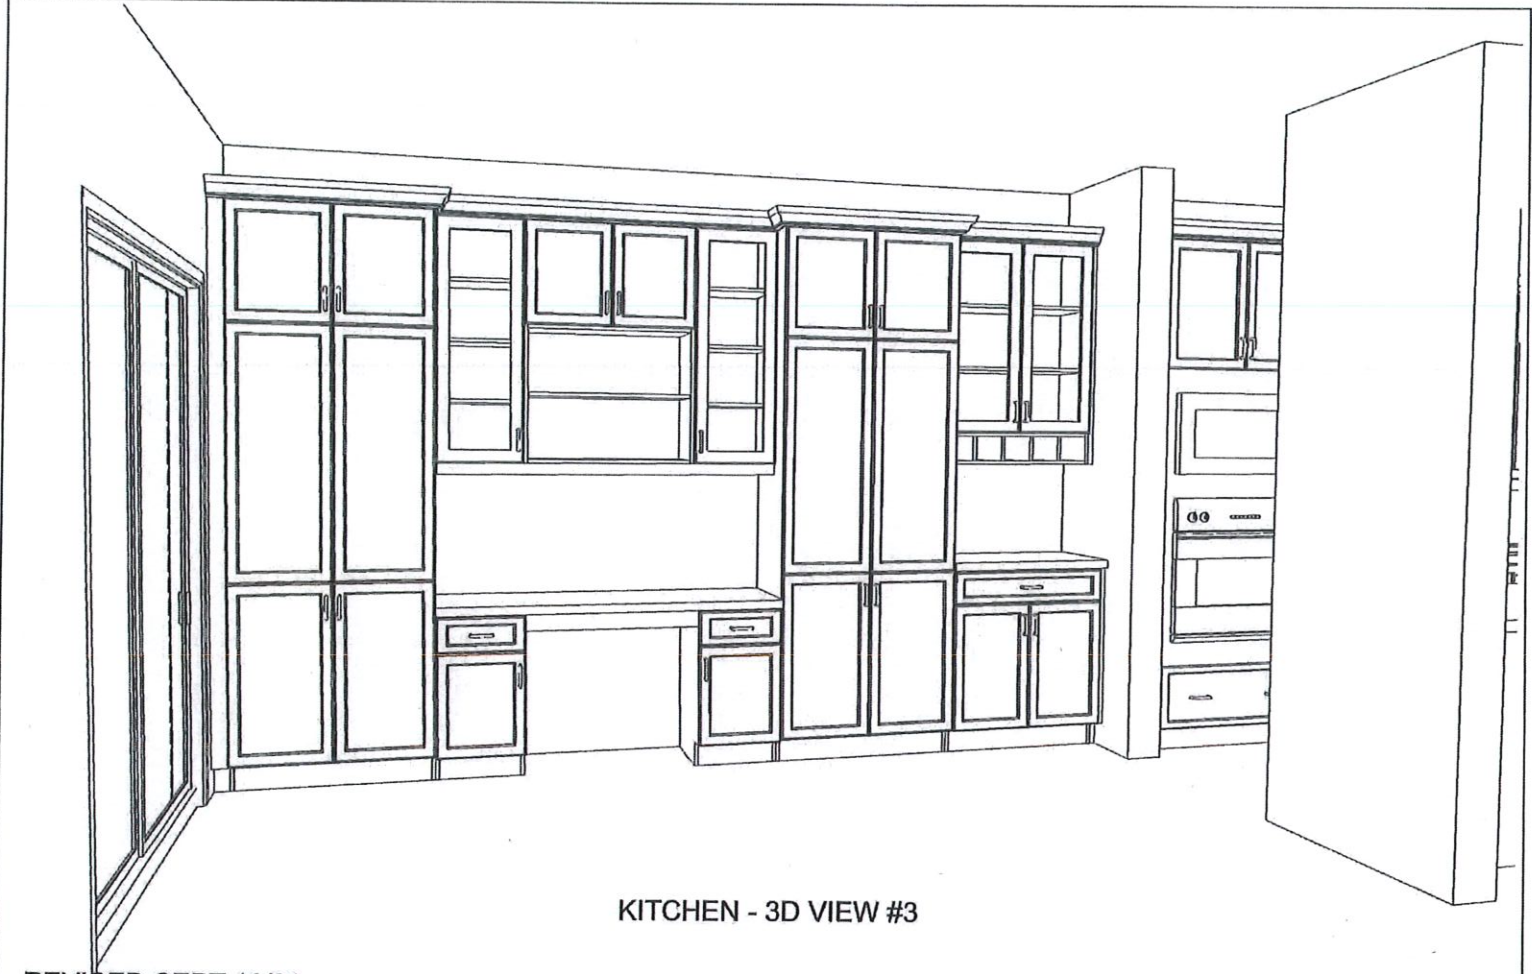

KITCHEN - 3D VIEW #3

REVISED SEPT 18/20
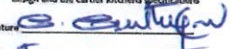
<b>CUSTOMER APPROVAL</b>	
I have reviewed these drawings and understand the details of the design and the Cartier Kitchen specifications	
Signature: 	
Date: Jan-20-2021	

Note: This drawing is an artistic interpretation of the general appearance of the design. It is not meant to be an exact rendition.




Designed: 9/17/2020  
Printed: 9/21/2020



DCR #50DV - rev Sep 18-20

All

Drawing #: 1

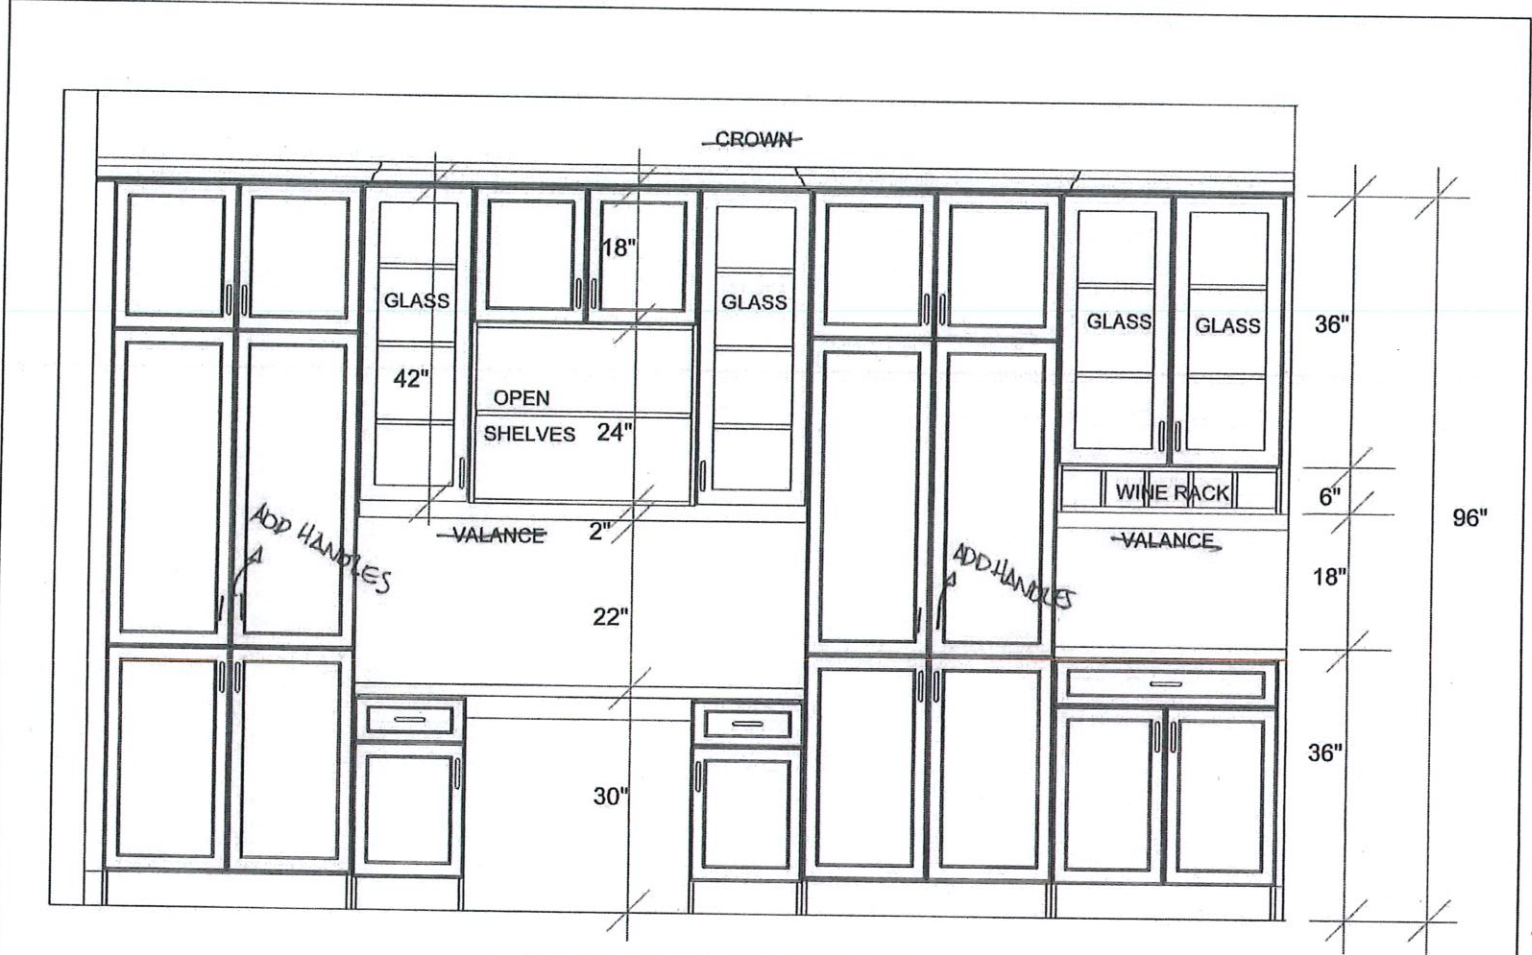


REVISED SEPT 18/20

DESK / COFFEE & WINE BAR ELEVATION

**CUSTOMER APPROVAL**  
 I have reviewed these drawings and understand the details of the design and the Cartier Kitchen specifications.  
 Signature: *[Signature]*  
 Date: Jan 20-2021

Note: This drawing is an artistic interpretation of the general appearance of the design. It is not meant to be an exact rendition.

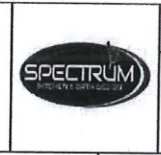


Designed: 9/17/2020  
 Printed: 9/21/2020  
*[Initials]* *[PD]*

DCR #50DV - rev Sep 18-20

All

Drawing #: 1



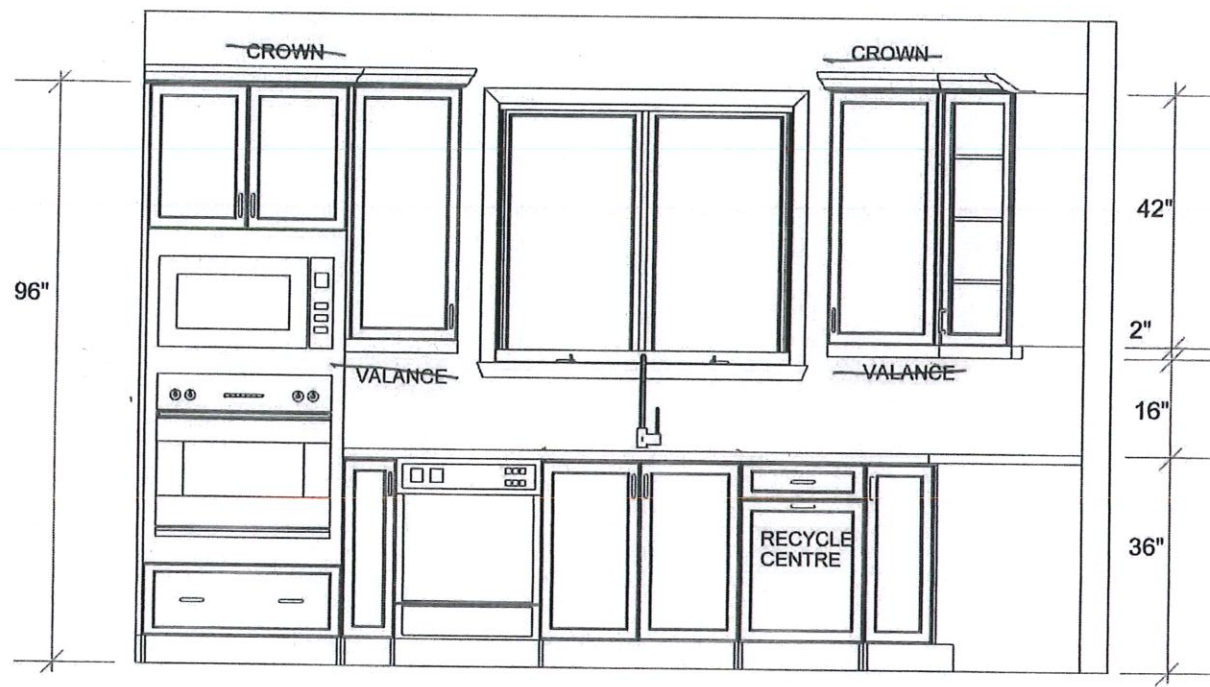

SINK / OVEN WALL ELEVATION

REVISED SEPT 18/20

**CUSTOMER APPROVAL**

I have reviewed these drawings and understand the details of the design and the Carlier Kitchens specifications

Signature: *[Signature]*

Date: *Jan-20-2021*

Note: This drawing is an artistic interpretation of the general appearance of the design. It is not meant to be an exact rendition.




Designed: 9/17/2020  
Printed: 9/21/2020



DCR #50DV - rev Sep 18-20

All

Drawing #: 1

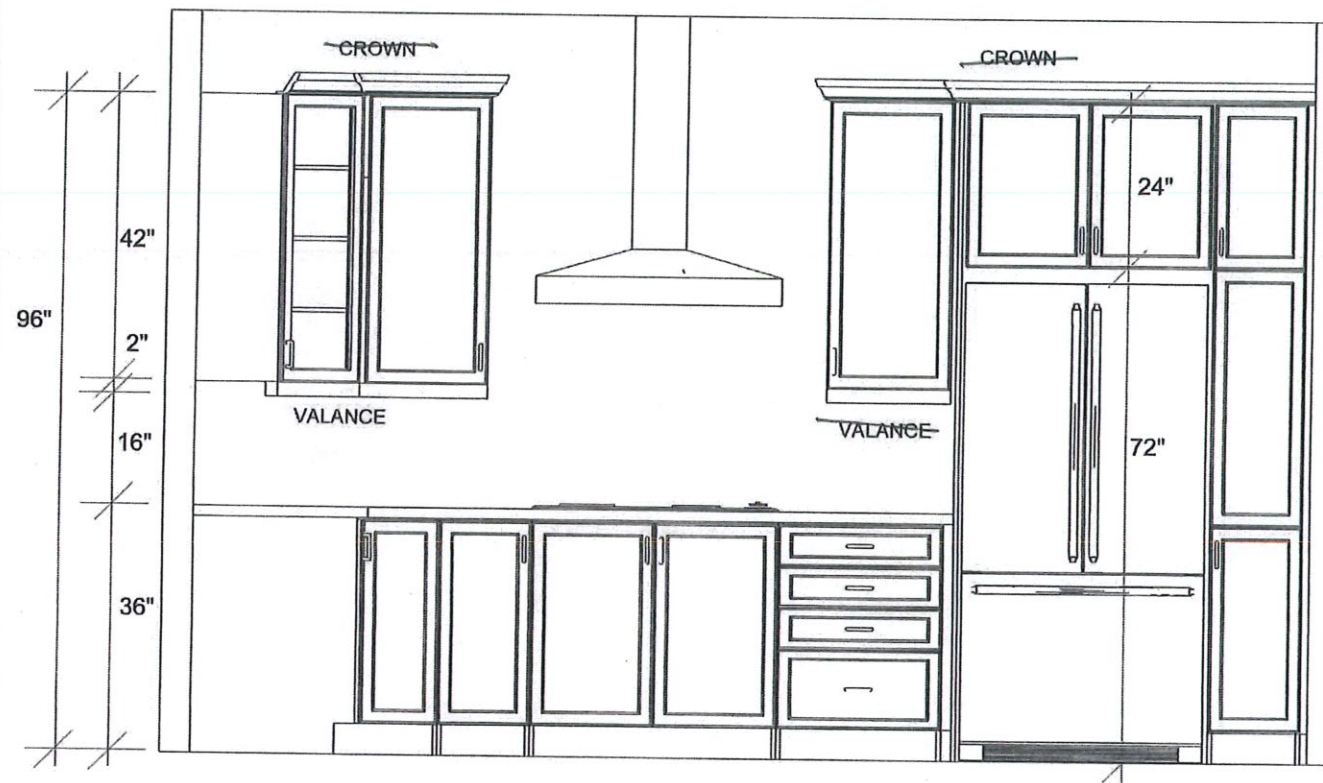

COOKTOP / FRIDGE WALL ELEVATION

REVISED SEPT 18/20

CUSTOMER APPROVAL

I have reviewed these drawings and understand the details of the design and the Carlini Kitchen specifications.

Signature

*[Signature]*

Date

Jan-20-2021

Note: This drawing is an artistic interpretation of the general appearance of the design. It is not meant to be an exact rendition.



Designed: 9/21/2020  
Printed: 9/21/2020




DCR #50DV - rev Sep 18-20


All

Drawing #: 1



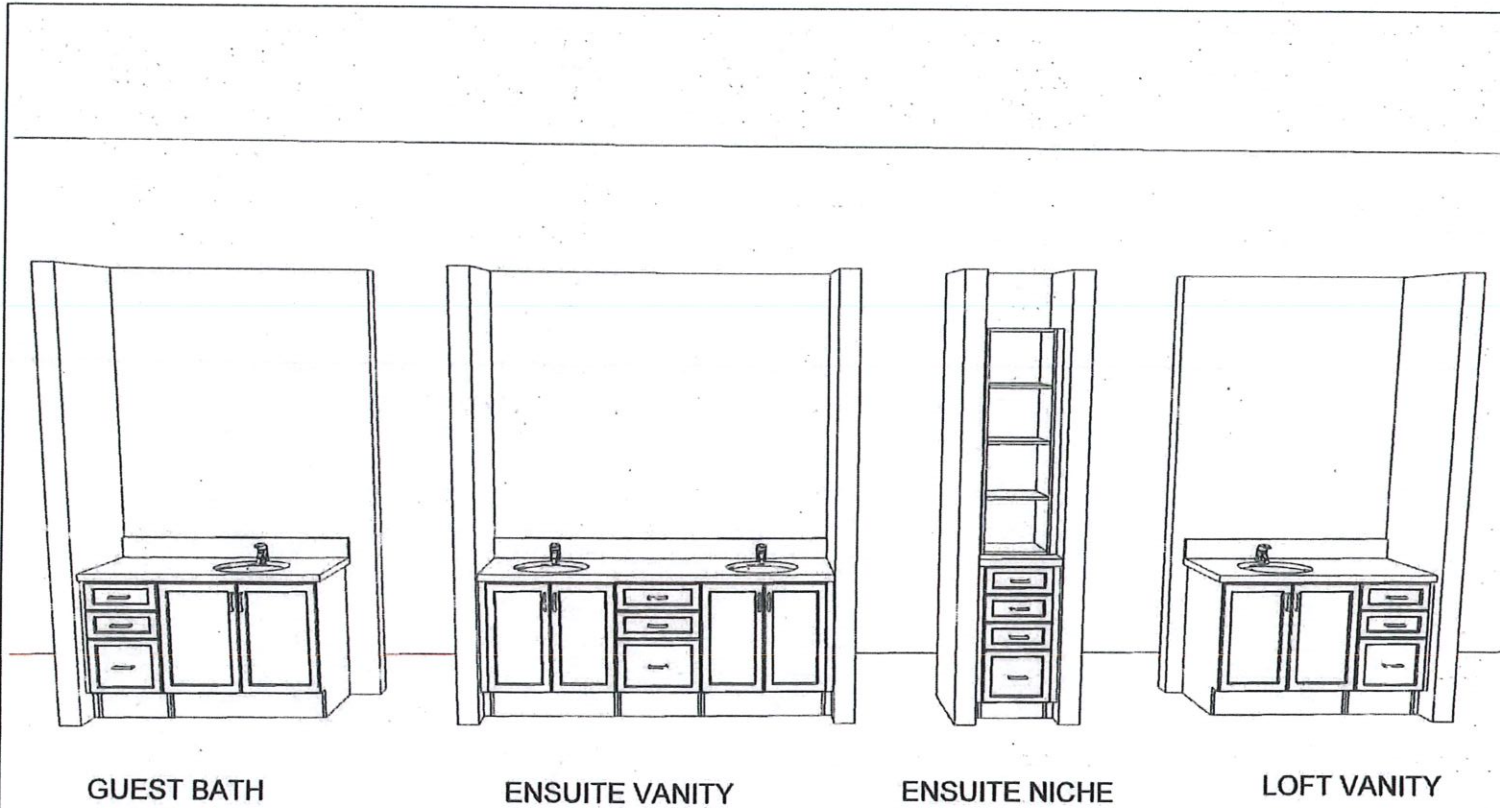

REVISED SEPT 18/20
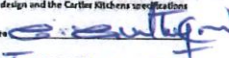
<b>CUSTOMER APPROVAL</b>	
I have reviewed these drawings and understand the details of the design and the Carlini Kitchens specifications.	
Signature	
Date	Jan-20-2024

Note: This drawing is an artistic interpretation of the general appearance of the design. It is not meant to be an exact rendition.




Designed: 9/21/2020  
Printed: 9/21/2020



DCR #50DV - rev Sep 18-20

All

Drawing #: 1

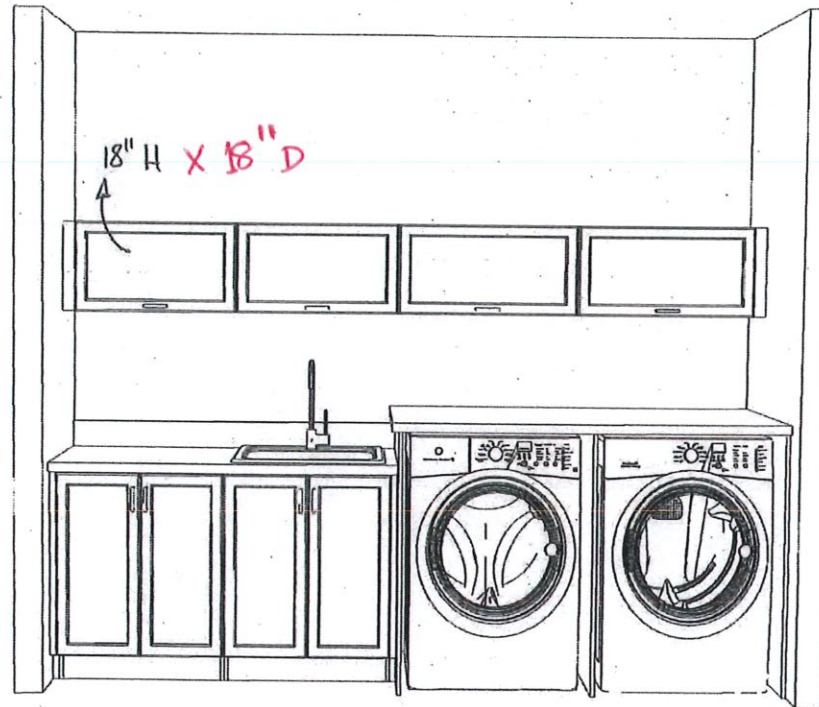

REVISED SEPT 18/20

LAUNDRY - 3D VIEW #1

**CUSTOMER APPROVAL**  
 I have reviewed these drawings and understand the details of the design and the Carter Kitchen specifications.  
 Signature: *[Signature]*  
 Date: *Jan-20-2021*

Note: This drawing is an artistic interpretation of the general appearance of the design. It is not meant to be an exact rendition.




Designed: 9/21/2020  
 Printed: 9/21/2020



DCR #50DV - rev Sep 18-20

All

Drawing #: 1

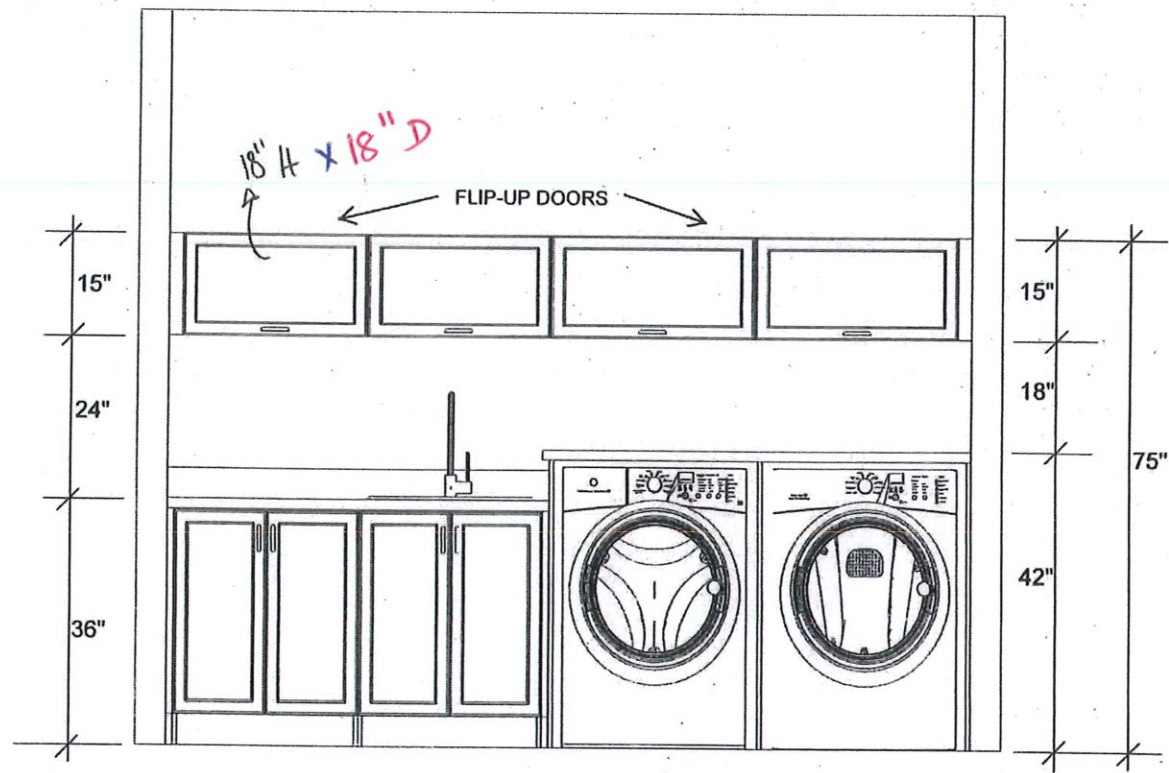

LAUNDRY ELEVATION

REVISED SEPT 18/20

CUSTOMER APPROVAL	
I have reviewed these drawings and understand the details of the design and the Carter Kitchens specifications.	
Signature	<i>[Signature]</i>
Date	Jan - 20 - 2021

Note: This drawing is an artistic interpretation of the general appearance of the design. It is not meant to be an exact rendition.



Designed: 9/21/2020  
Printed: 9/21/2020



DCR #50DV - rev Sep 18-20

All

Drawing #: 1