



SITE: DIAMONDVIEW

OAKSIDE – 2016

LOT NUMBER:

CIVIC ADDRESS:
502 ALBERT BOYD PVT

9	FINAL WORKING DRAWINGS	26/01/21	CB
8	FINAL BLACKLINES	11/12/20	SP
7	BEP FOR SITE	12/11/20	SP
6	BEP BLACKLINES REVISIONS	30/09/20	CB
5	BEP BLACKLINES	24/07/20	AJ
4	ADDED DOUBLE STUD WALL TO LAUNDRY ROOM	17/10/17	SP
No.	Description	dd/mm/yy	By
REVISIONS			

footprint: B-20

drawn by: SP

date: JAN 13/16


scale: $3/16"=1'-0"$

sheet no:

D.C.L.-183


2 of 2

60

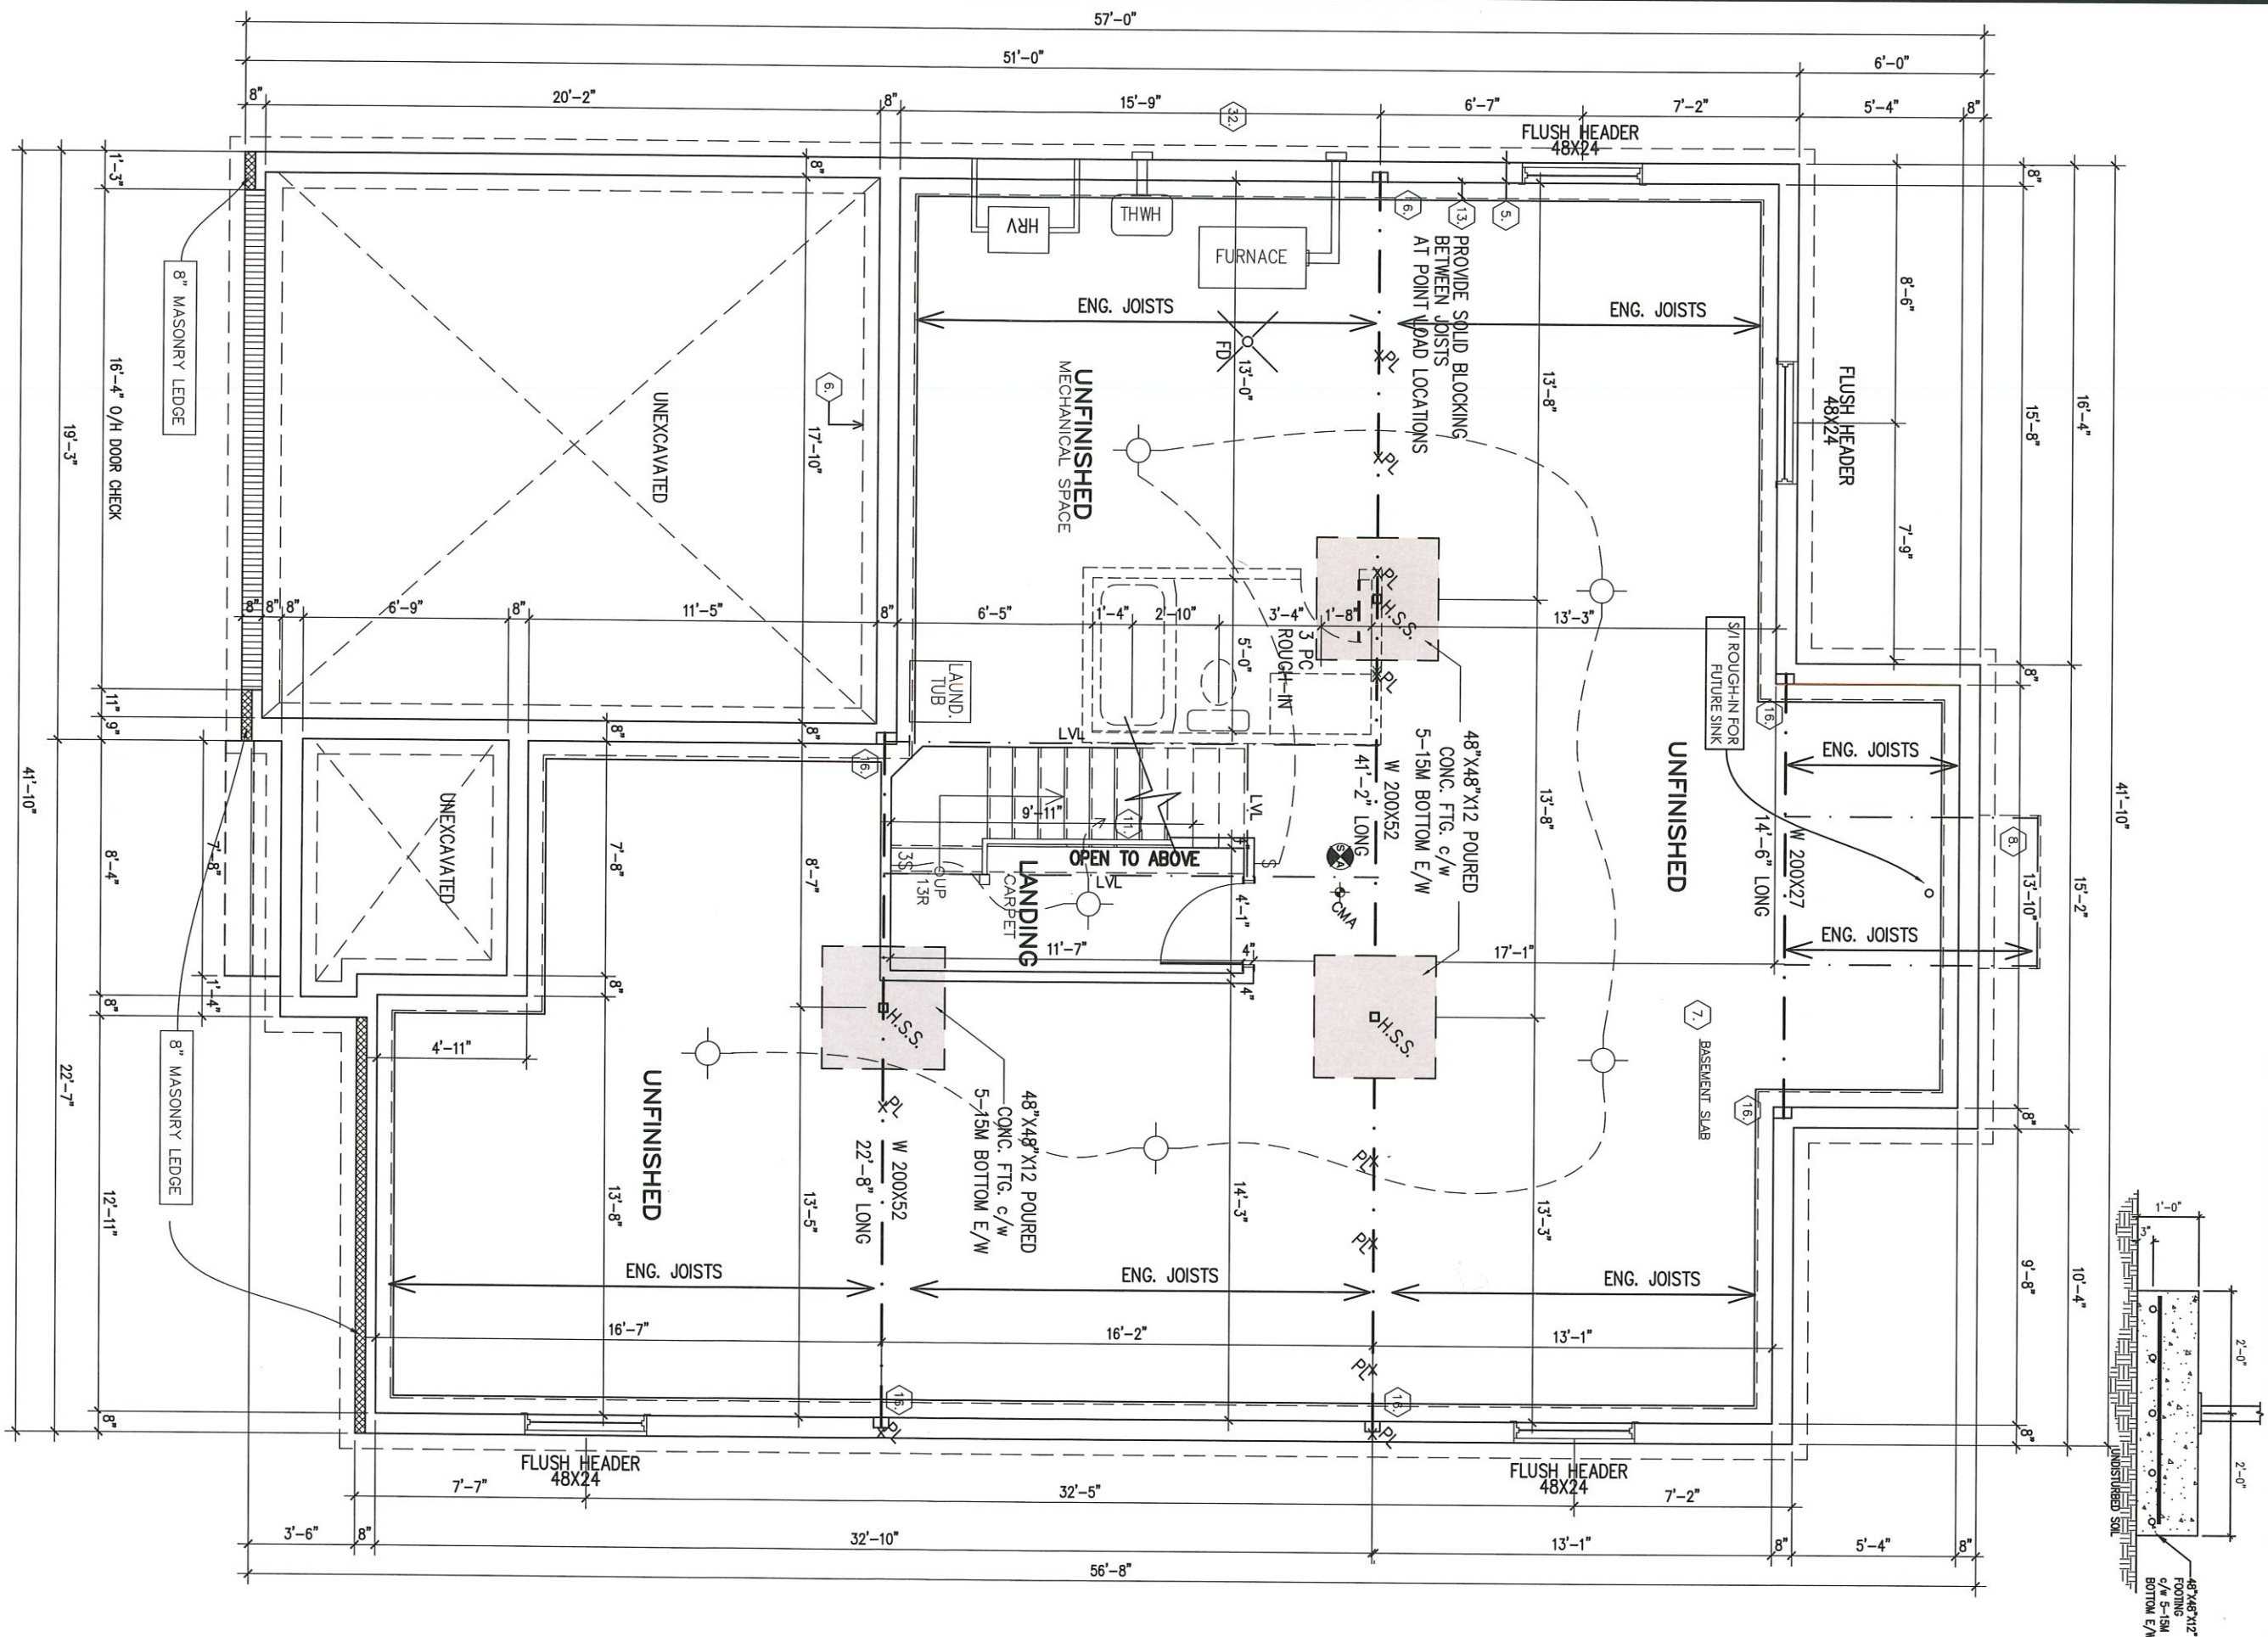


FLAT CEILINGS THROUGHOUT
NO STIPPLE

NOTE
ALL WINDOW AND DOOR LINTELS TO BE
2- 2X8 w/ P2 ON EITHER SIDE U.N.O.

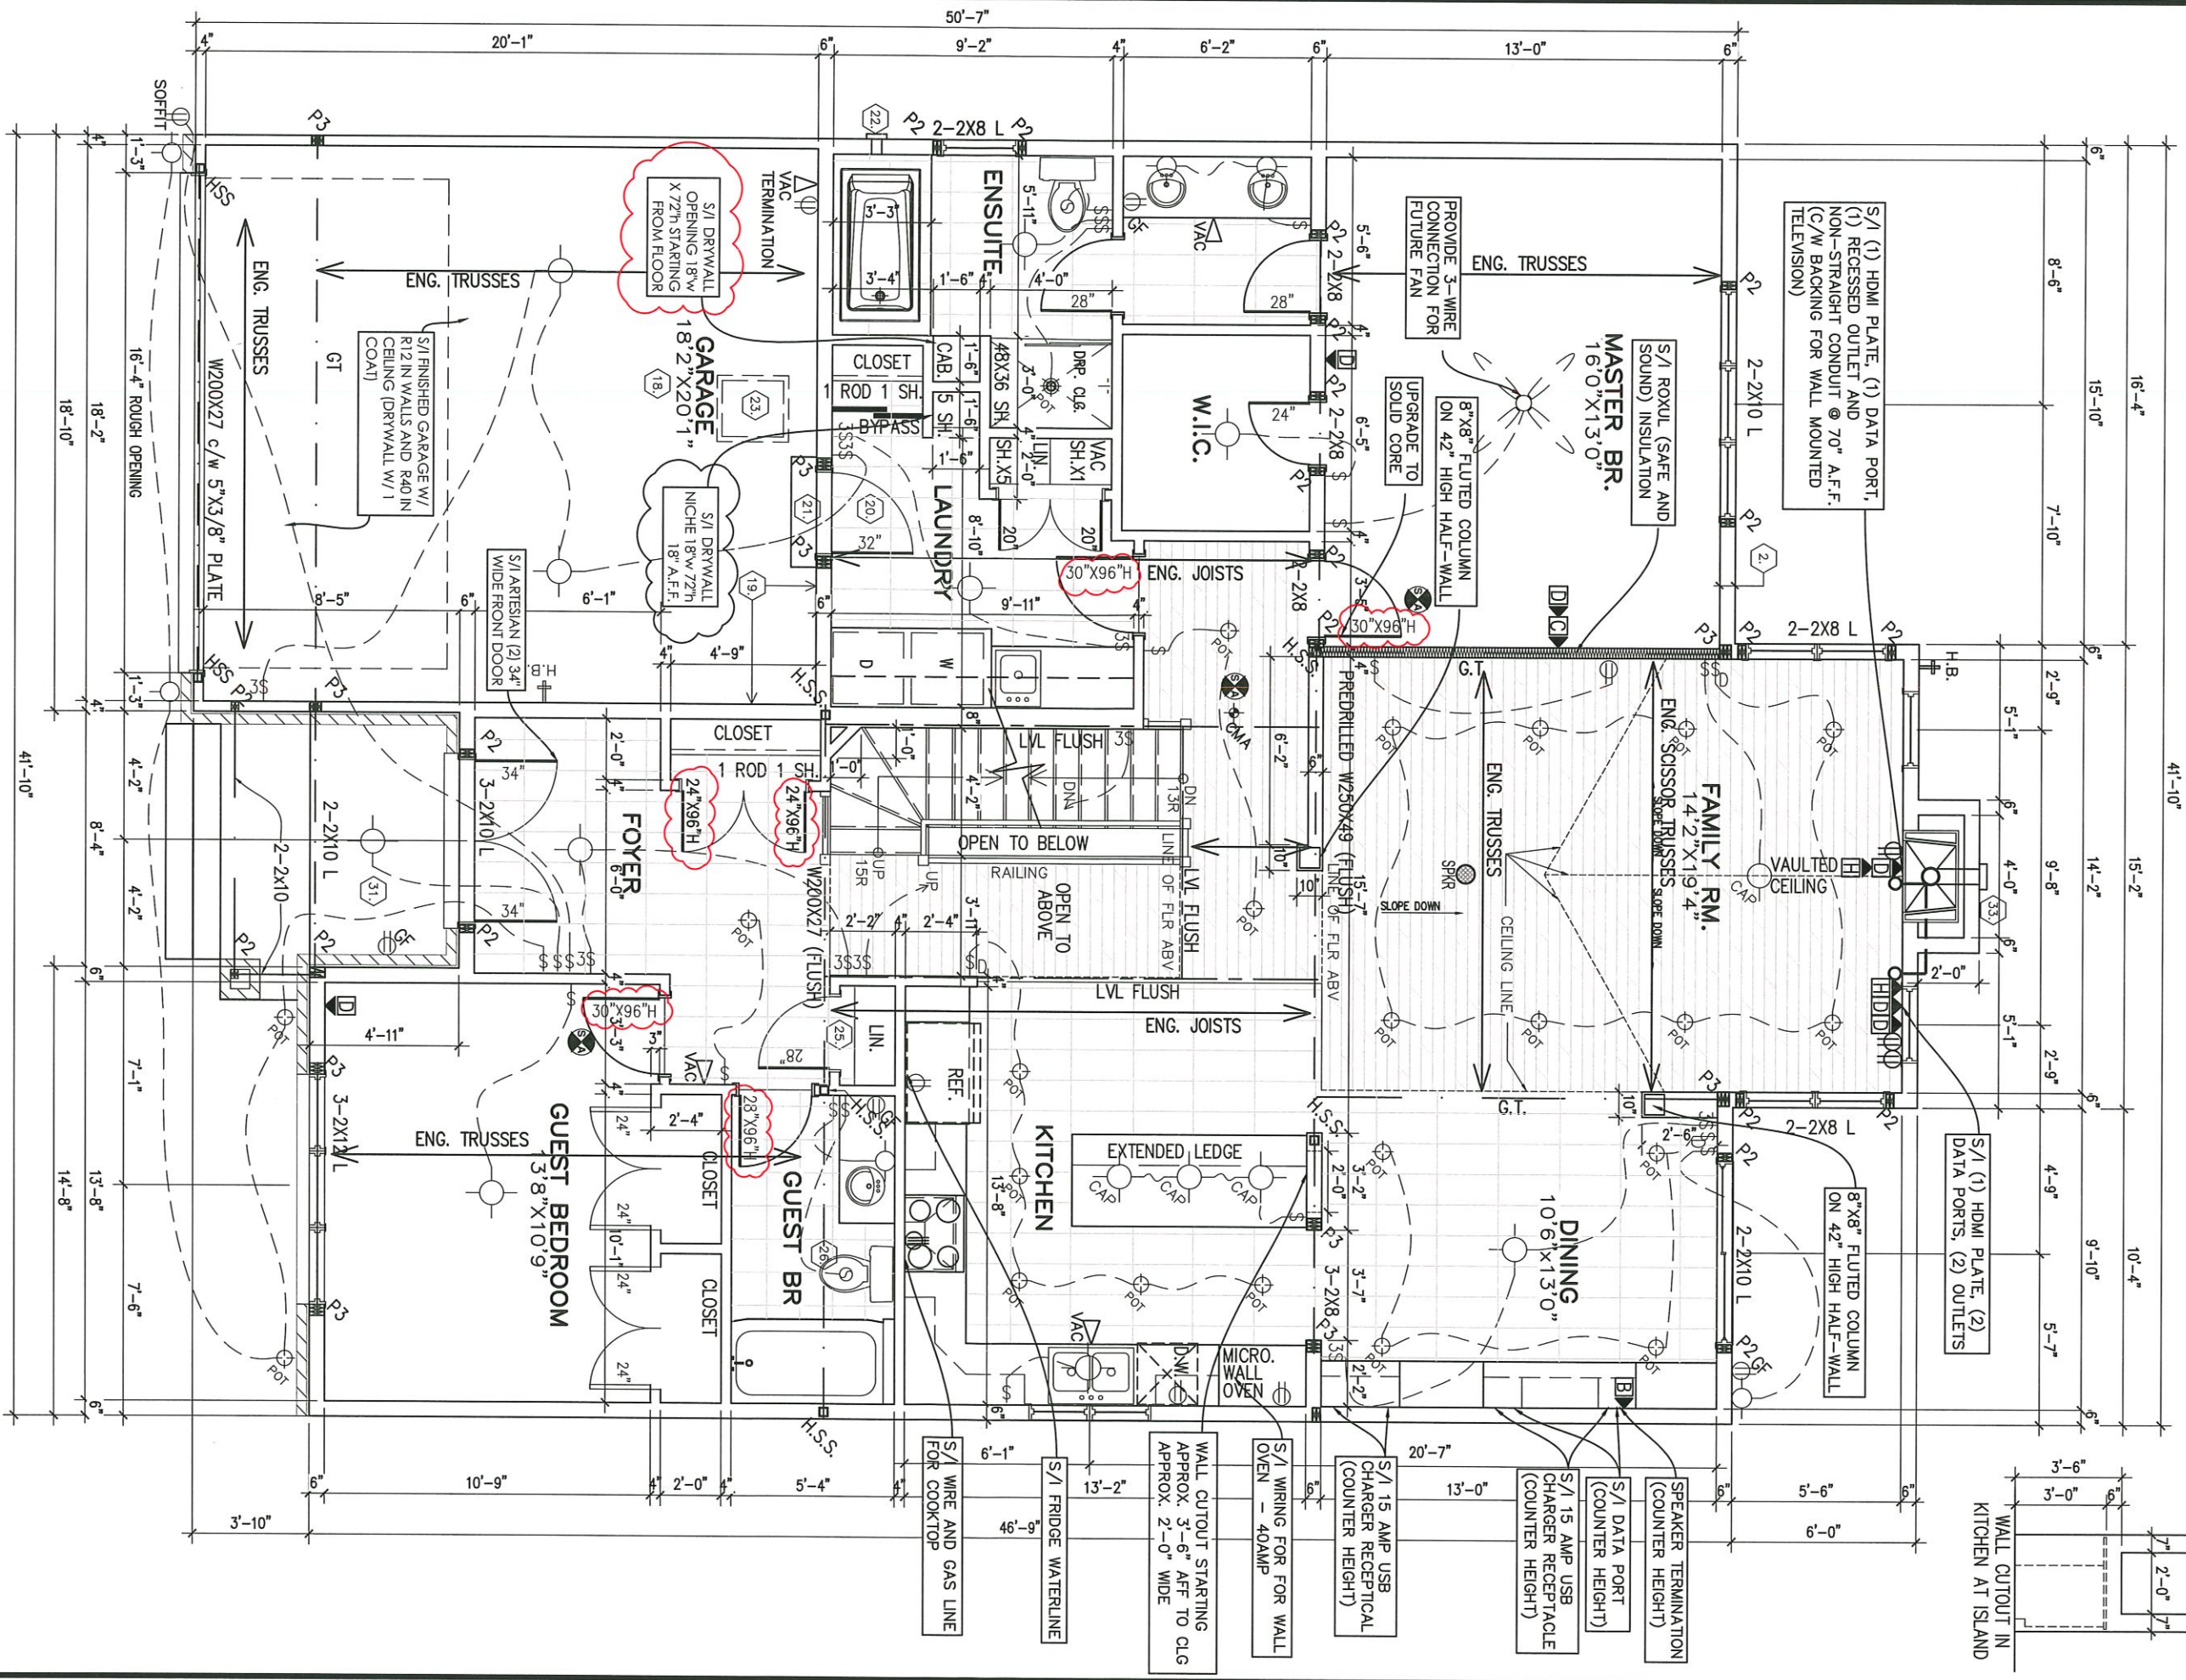

GROUND FLOOR ELEVATION D

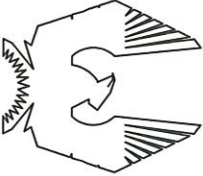

PHOENIX HOMES

LOT NUMBER:

50

CIVIC ADDRESS:

502 ALBERT BOYD PVT

OAKSIDE – 2016

SITE: DIAMONDVIEW

REVISIONS

9	FINAL WORKING DRAWINGS	26/01/21	CB
8	FINAL BLACKLINES	11/12/20	SP
7	BEP FOR SITE	12/11/20	SP
6	BEP BLACKLINES REVISIONS	30/09/20	CB
5	BEP BLACKLINES	24/07/20	AJ
4	ADDED DOUBLE STUD WALL TO LAUNDRY ROOM	17/10/17	SP

footprint: B-20

drawn by: SP


date: JAN 13/16

scale: 3/16"=1'-0"

sheet no: D.C.L.-183


3 of 9

FLAT CEILINGS THROUGHOUT
NO STIPPLE

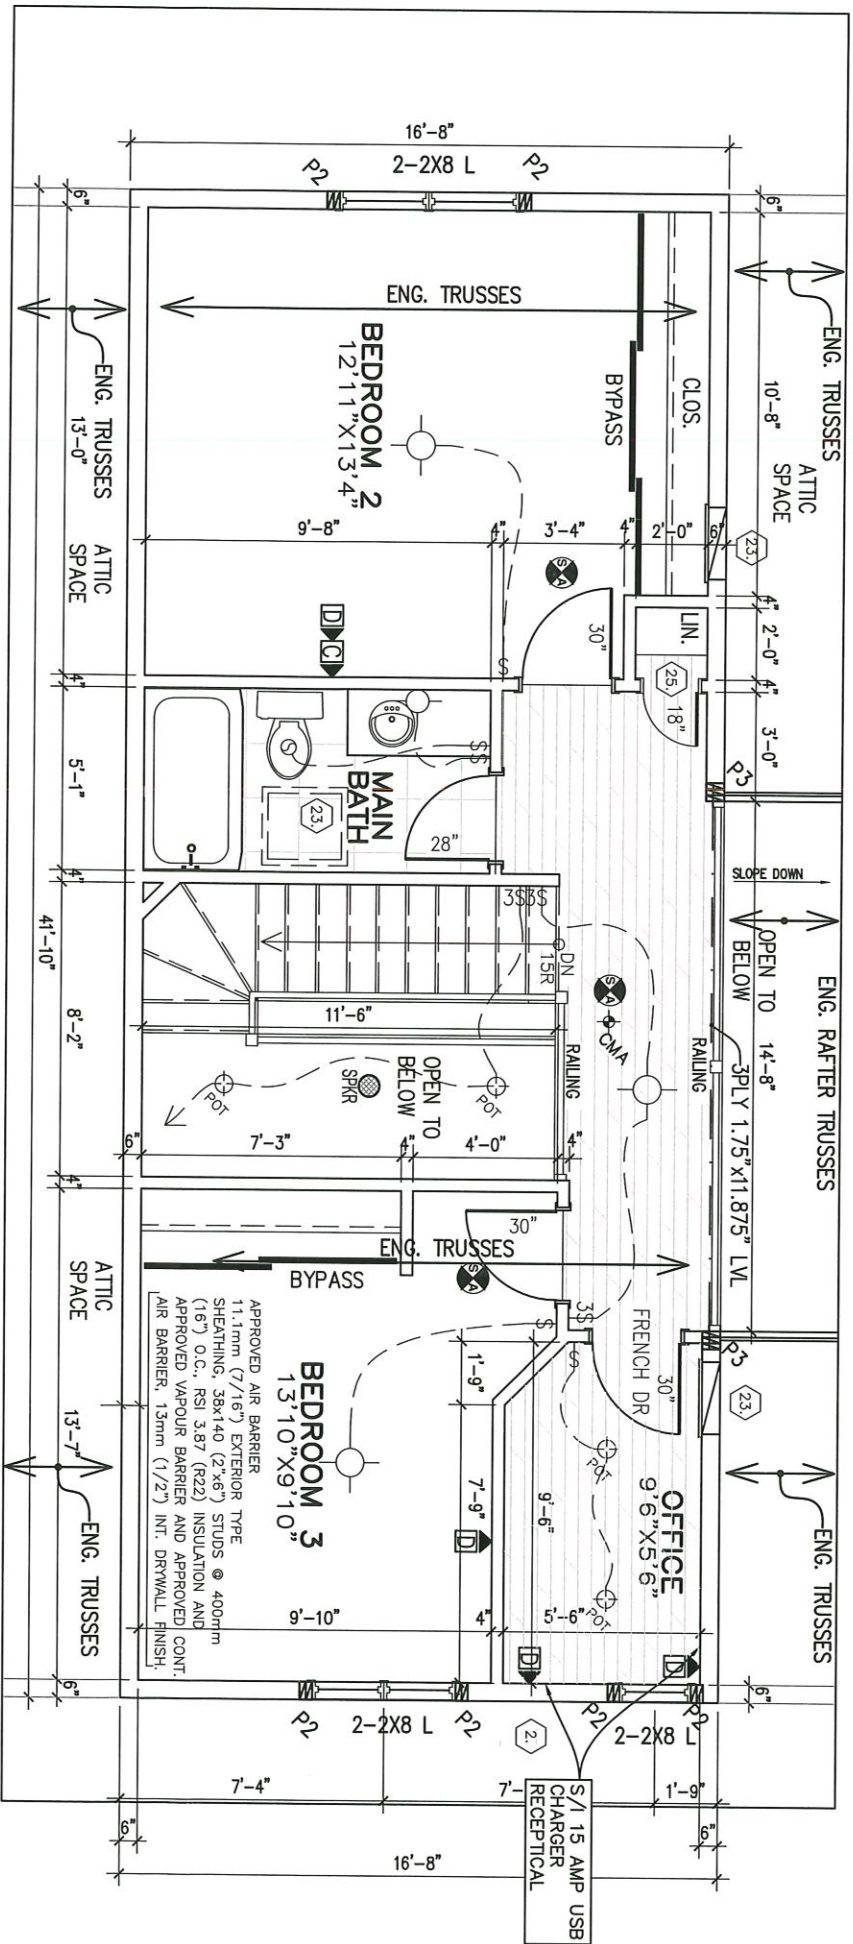

PARTIAL SECOND FLOOR WITH
LOFT OPTION

PARTIAL GND FLOOR PLAN FOR LOFT OPTION

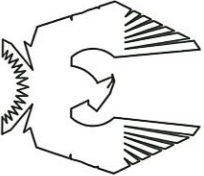

PHOENIX HOMES

LOT NUMBER:
502 ALBERT BOYD PVT

OAKSIDE – 2016

SITE: DIAMONDVIEW

4

REVISIONS

No.	Description	dd/mm/yy	By
4	ADDED DOUBLE STUD WALL TO LAUNDRY ROOM	17/10/17	SP
5	BEP BLACKLINES	24/07/20	AJ
6	BEP BLACKLINES REVISIONS	30/09/20	CB
7	BEP FOR SITE	12/11/20	SP
8	FINAL BLACKLINES	11/12/20	SP
9	FINAL WORKING DRAWINGS	26/01/21	CB

footprint: B-20


drawn by: SP

date: JAN 13/16

scale: 3/16"=1'-0"

sheet no: D.C.L.-183

4 of 9

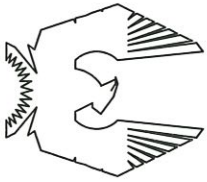

PHOENIX HOMES

OAKSIDE – 2016

SITE: DIAMONDVIEW

LOT NUMBER:

CIVIC ADDRESS:
502 ALBERT BOYD PVT

50

9	FINAL WORKING DRAWINGS	26/01/21	CB
8	FINAL BLACKLINES	11/12/20	SP
7	BEP FOR SITE	12/11/20	SP
6	BEP BLACKLINES REVISIONS	30/09/20	CB
5	BEP BLACKLINES	24/07/20	AJ
4	ADDED DOUBLE STUD WALL TO LAUNDRY ROOM	17/10/17	SP
REVISIONS			
No.	Description	dd/mm/yy	By

footprint: B-20

drawn by: SP


date: JAN 13/16

scale: 3/16" = 1'-0"

sheet no:

D.C.L.-183

5 of 9

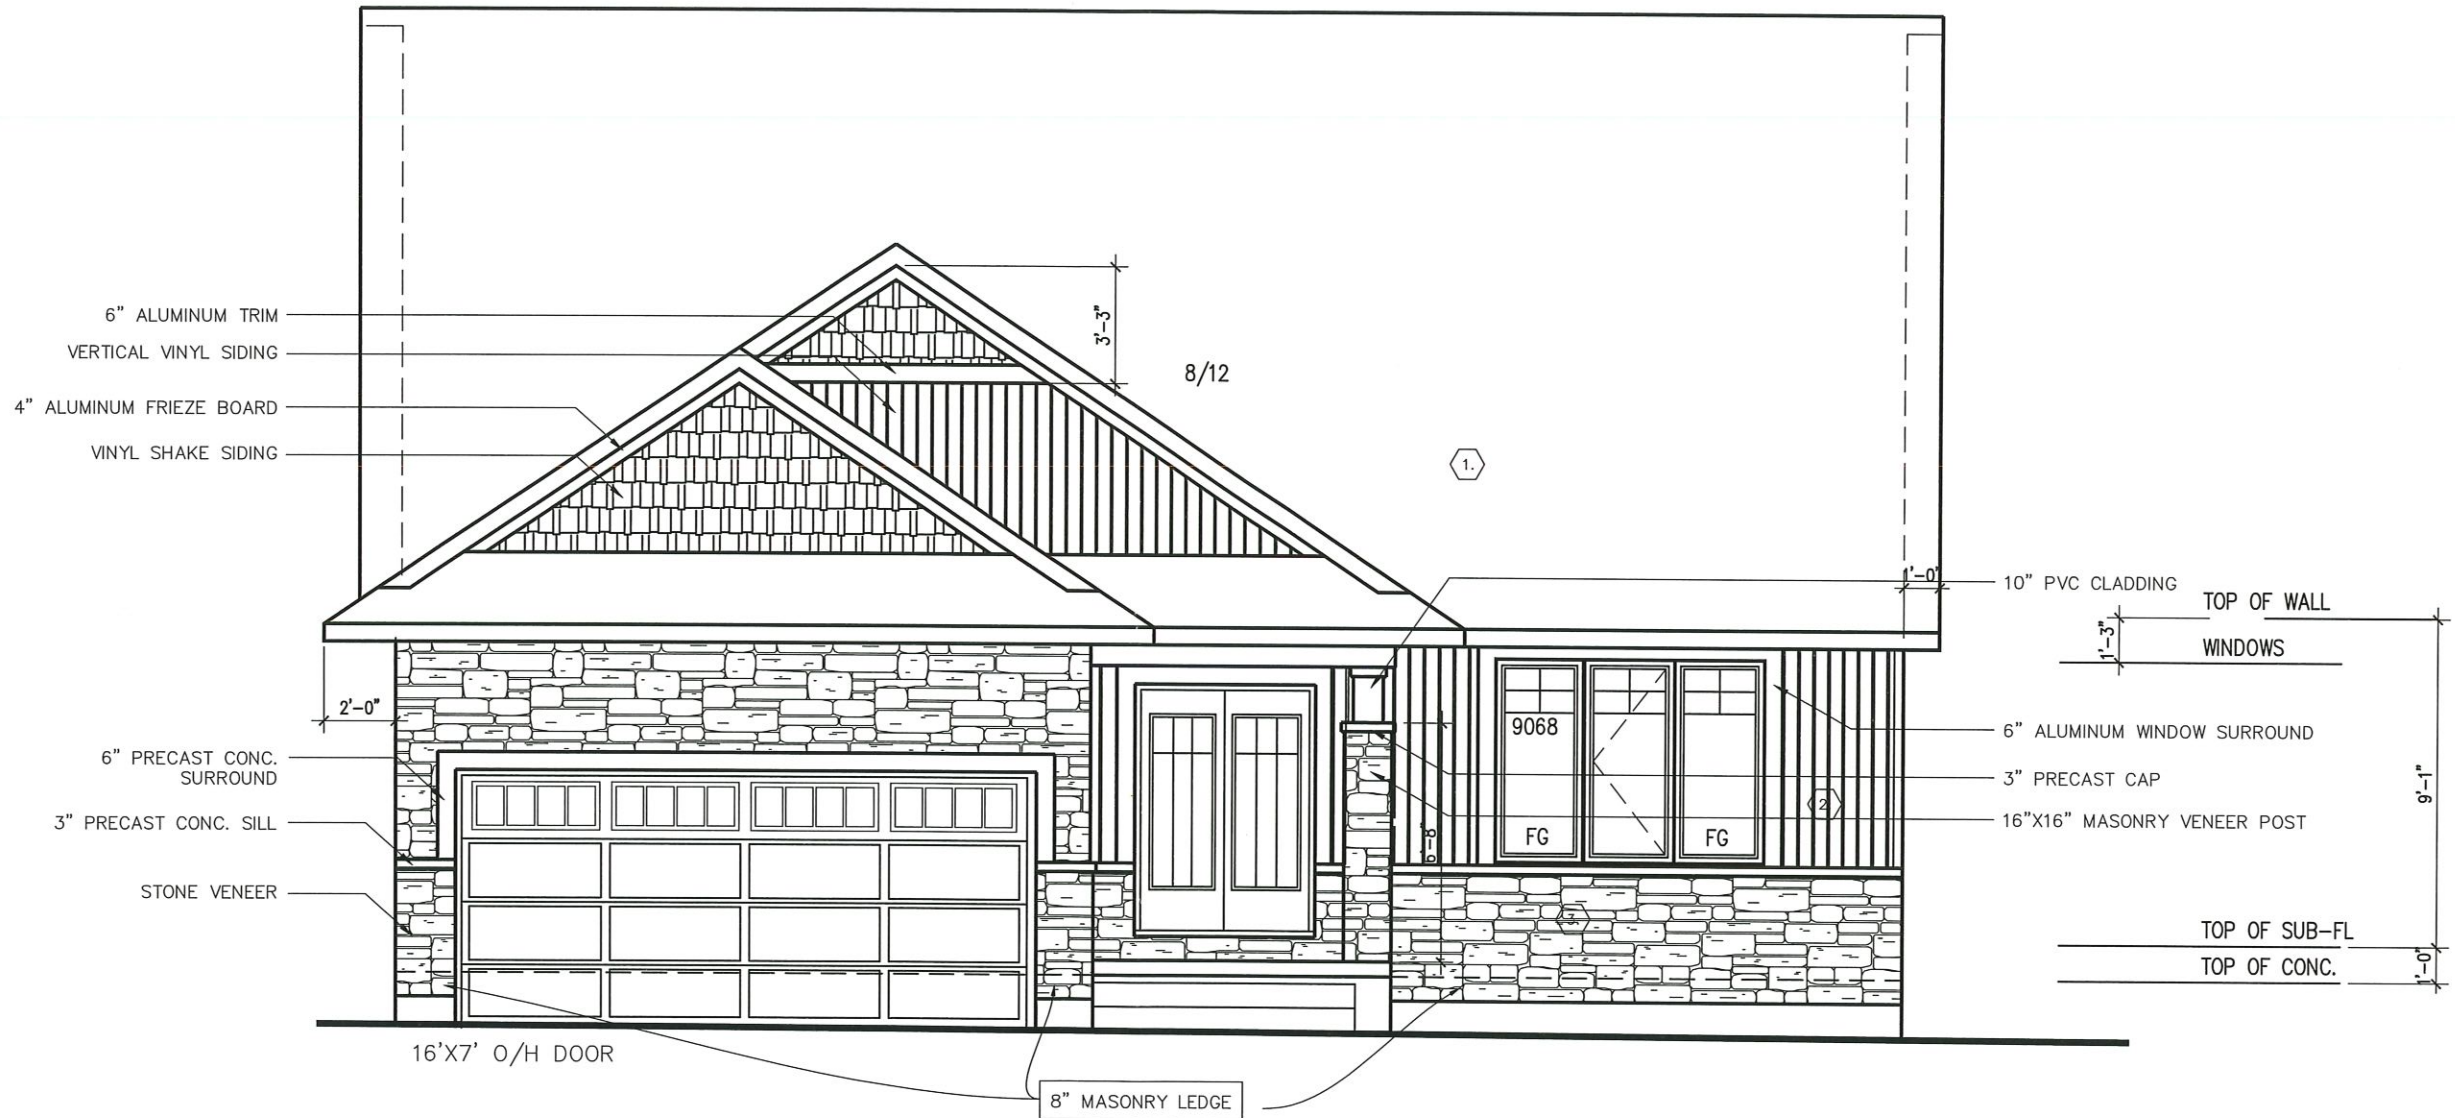

FRONT ELEVATION D
WITH LOFT

PHOENIX HOMES

OAKSIDE – 2016

SITE: DIAMONDVIEW

LOT NUMBER:

CIVIC ADDRESS:
502 ALBERT BOYD PVT

50

9	FINAL WORKING DRAWINGS	26/01/21	CB
8	FINAL BLACKLINES	11/12/20	SP
7	BEP FOR SITE	12/11/20	SP
6	BEP BLACKLINES REVISIONS	30/09/20	CB
5	BEP BLACKLINES	24/07/20	AJ
4	ADDED DOUBLE STUD WALL TO LAUNDRY ROOM	17/10/17	SP
REVISIONS			
No.	Description	dd/mm/yy	By

footprint: B-20


drawn by: SP

date: JAN 13/16


scale: 3/16"=1'-0"

sheet no: D.C.L.-183

6 of 9

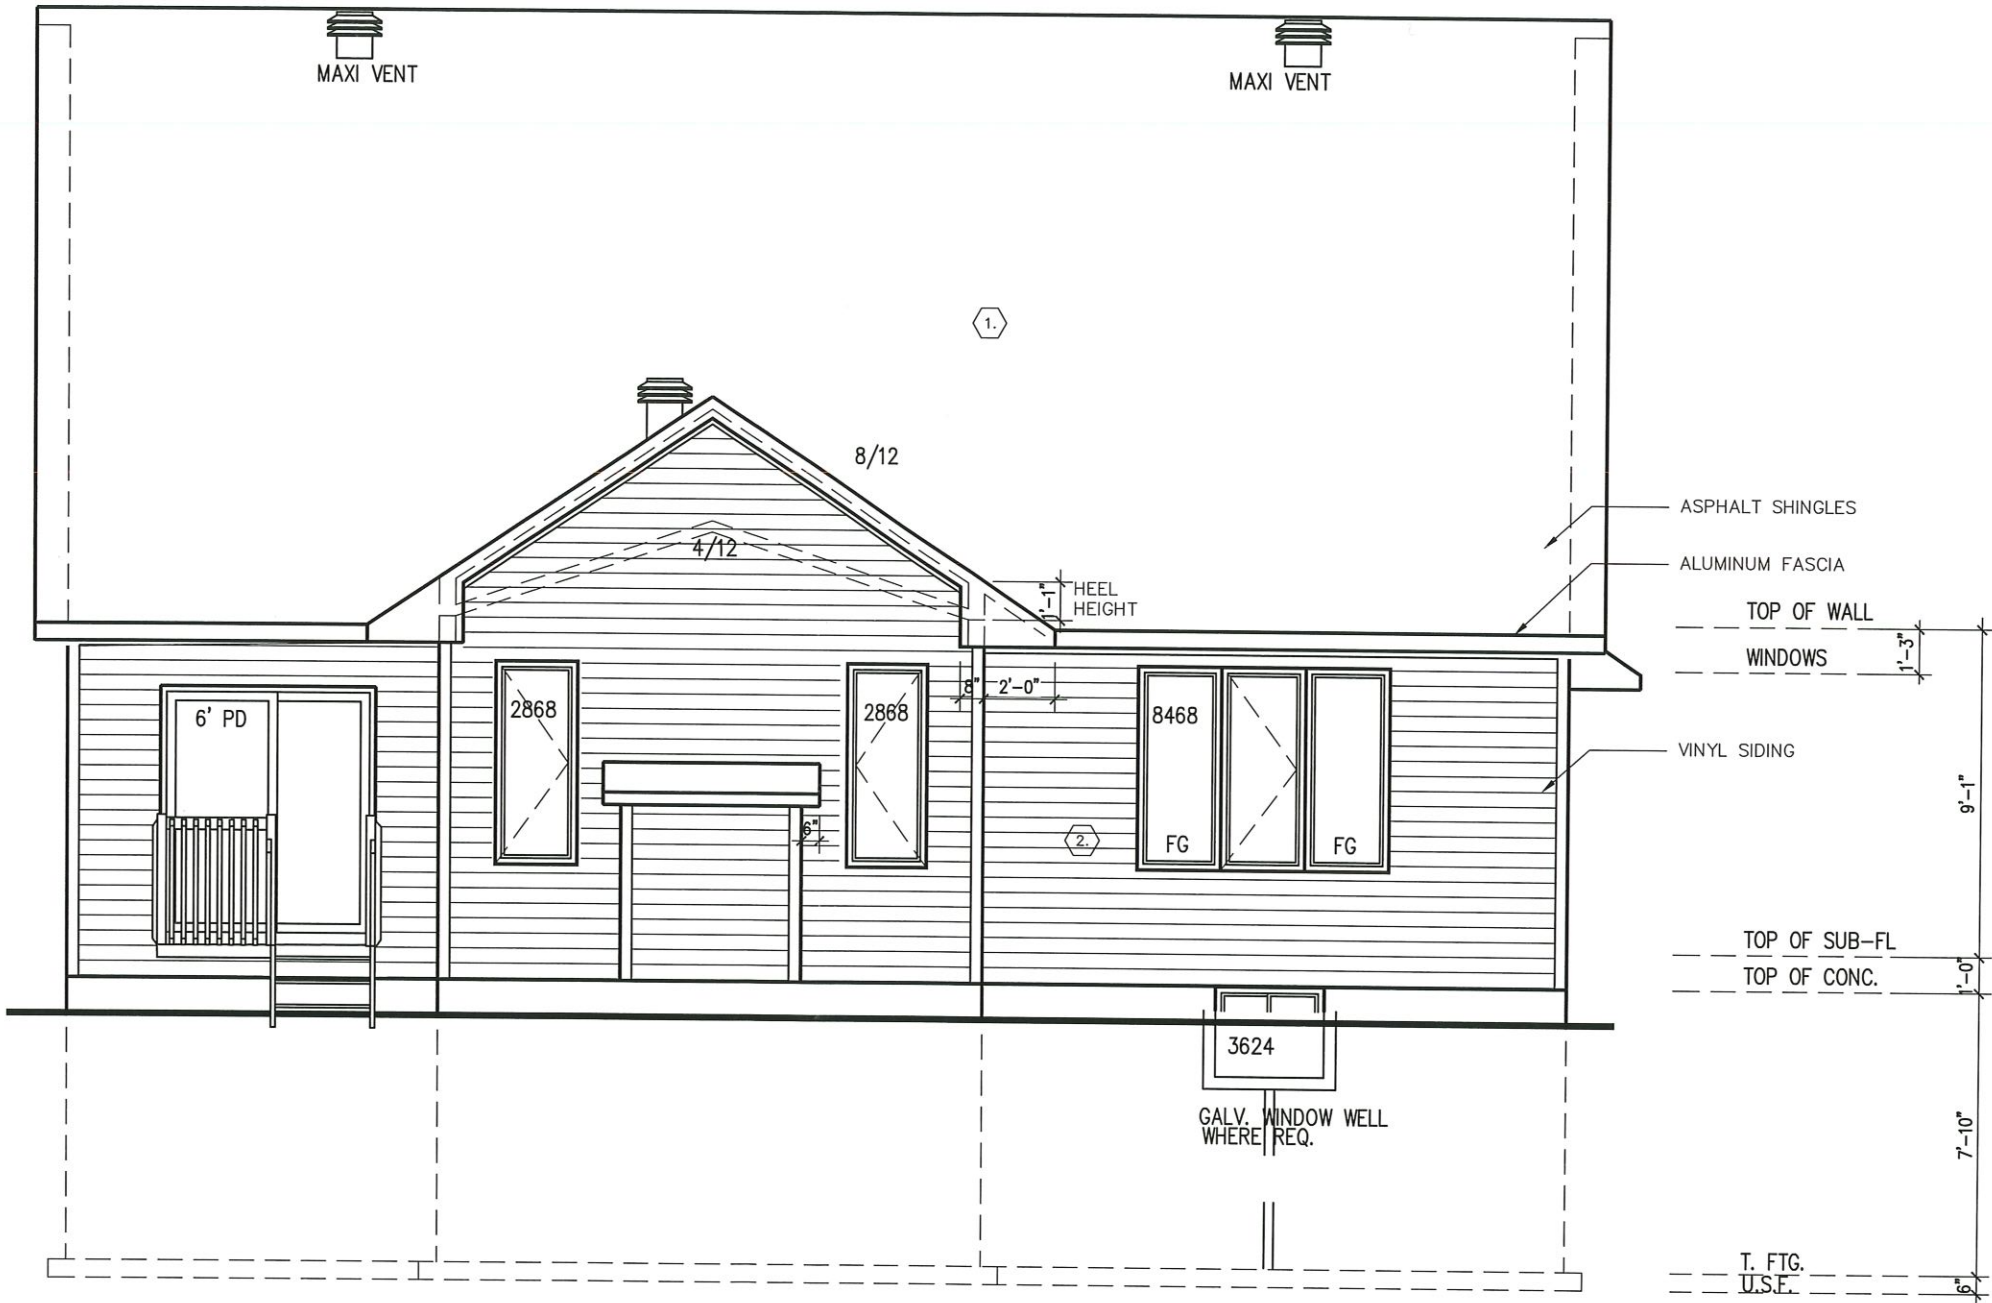

REAR ELEVATION A

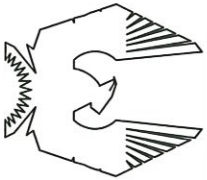

PHOENIX HOMES

OAKSIDE - 2016

SITE: DIAMONDVIEW


LOT NUMBER:


CIVIC ADDRESS:
502 ALBERT BOYD PVT

50

9	FINAL WORKING DRAWINGS	26/01/21	CB
8	FINAL BLACKLINES	11/12/20	SP
7	BEP FOR SITE	12/11/20	SP
6	BEP BLACKLINES REVISIONS	30/09/20	CB
5	BEP BLACKLINES	24/07/20	AJ
4	ADDED DOUBLE STUD WALL TO LAUNDRY ROOM	17/10/17	SP
No. Description		dd/mm/yy	By
REVISIONS			

footprint:	B-20
drawn by:	SP
date:	JAN 13/16
scale:	3/16"=1'-0"
sheet no:	
D.C.L.-183	
7 of 9	

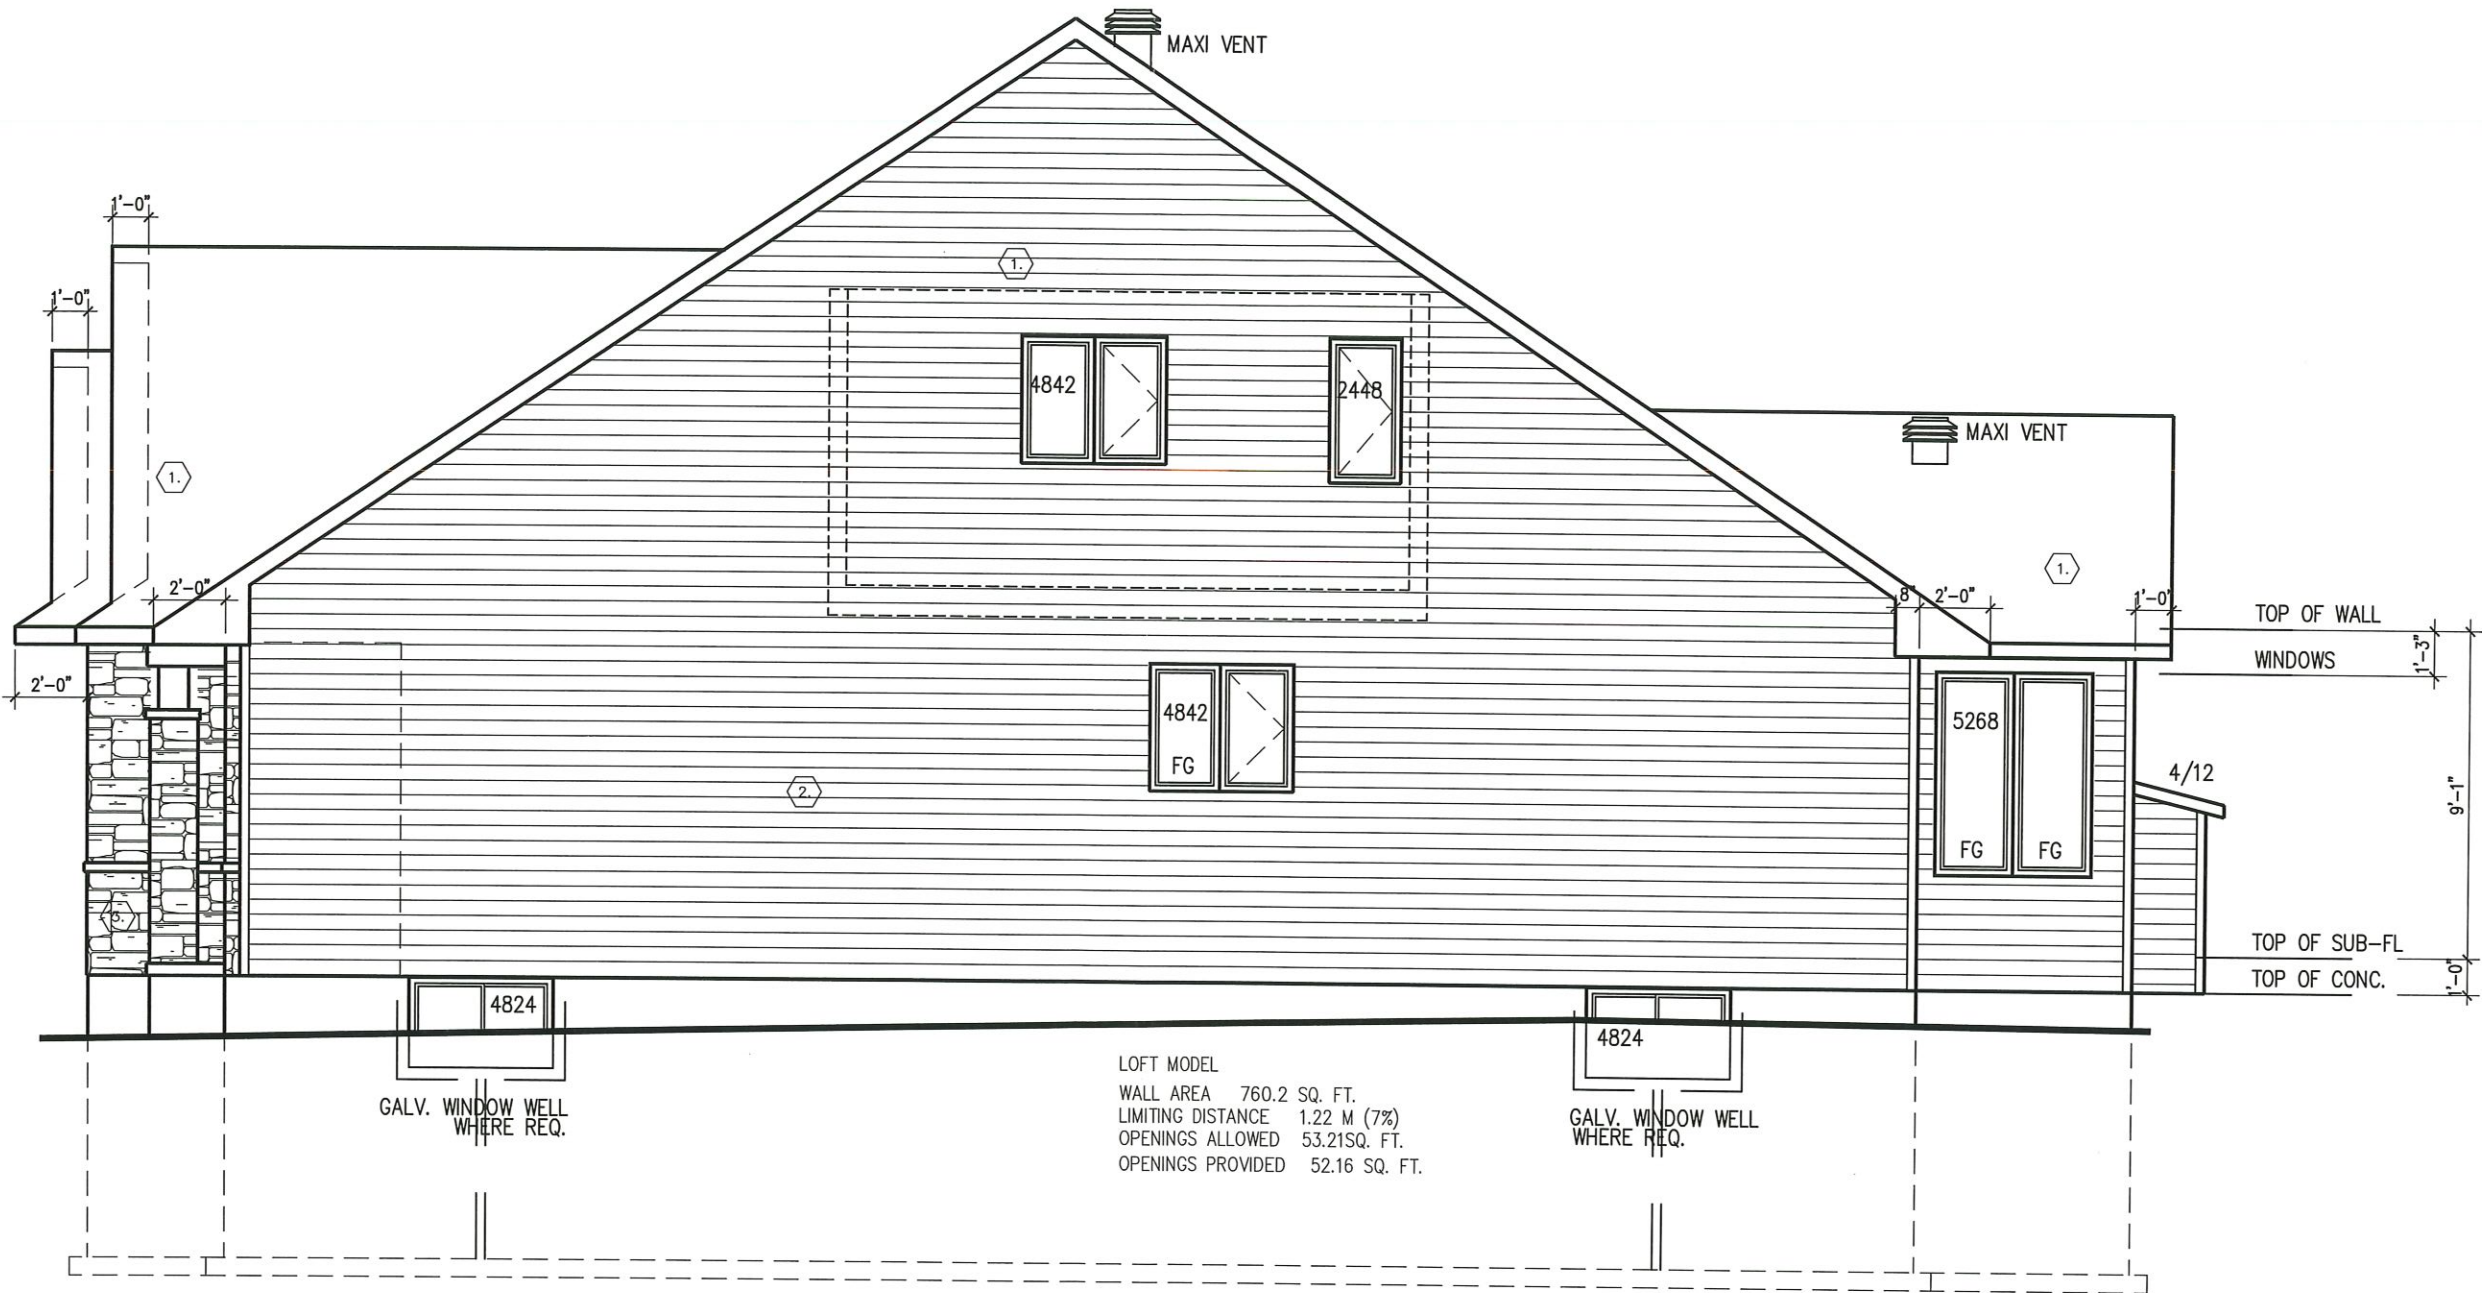

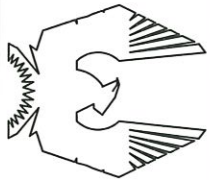

PHOENIX HOMES

OAKSIDE – 2016

SITE: DIAMONDVIEW

LOT NUMBER:

CIVIC ADDRESS:
502 ALBERT BOYD PVT

50

9	FINAL WORKING DRAWINGS	26/01/21	CB
8	FINAL BLACKLINES	11/12/20	SP
7	BEP FOR SITE	12/11/20	SP
6	BEP BLACKLINES REVISIONS	30/09/20	CB
5	BEP BLACKLINES	24/07/20	AJ
4	ADDED DOUBLE STUD WALL TO LAUNDRY ROOM	17/10/17	SP
No. Description		dd/mm/yy	By
REVISIONS			

footprint: B-20

drawn by: SP


date: JAN 13/16


scale: 3/16"=1'-0"

sheet no:

D.C.L.-183

8 of 9

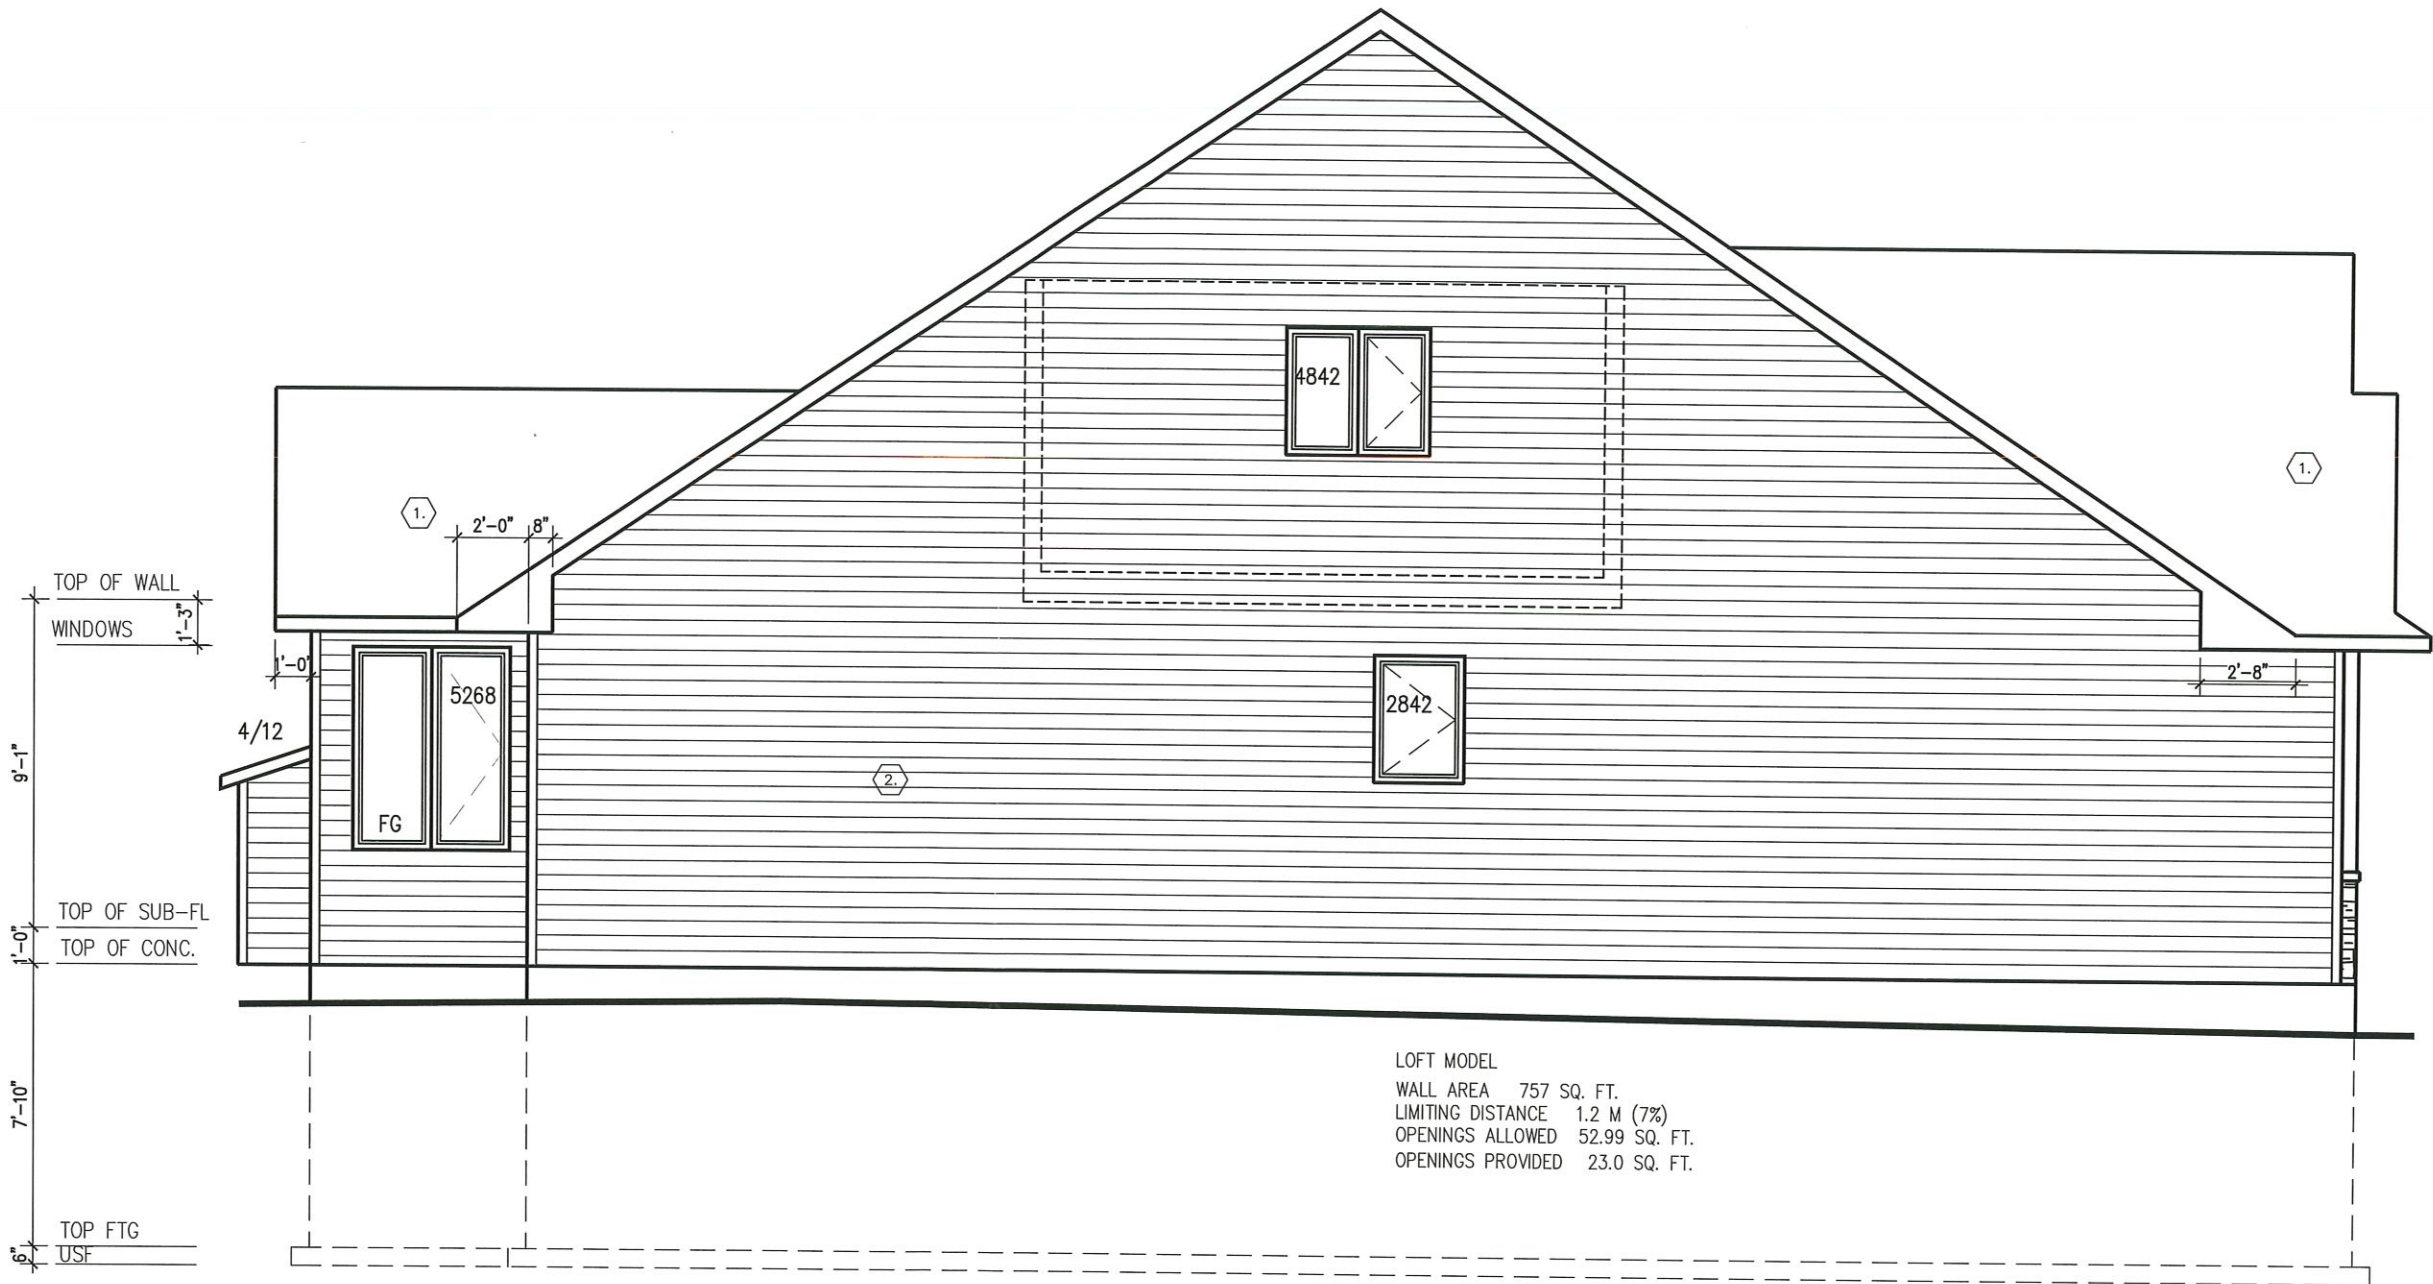

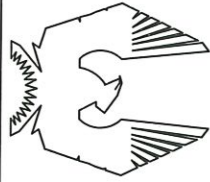

PHOENIX HOMES

OAKSIDE - 2016

SITE: DIAMONDVIEW

LOT NUMBER:


CIVIC ADDRESS:

502 ALBERT BOYD PVT

50

9	FINAL WORKING DRAWINGS	26/01/21	CB
8	FINAL BLACKLINES	11/12/20	SP
7	BEP FOR SITE	12/11/20	SP
6	BEP BLACKLINES REVISIONS	30/09/20	CB
5	BEP BLACKLINES	24/07/20	Al
4	ADDED DOUBLE STUD WALL TO LAUNDRY ROOM	17/10/17	SP
No. Description		dd/mm/yy	By
REVISIONS			

footprint:	B-20
drawn by:	SP
date:	JAN 13/16
scale:	3/16"=1'-0"
sheet no:	
D.C.L.-183	
9 of 9	

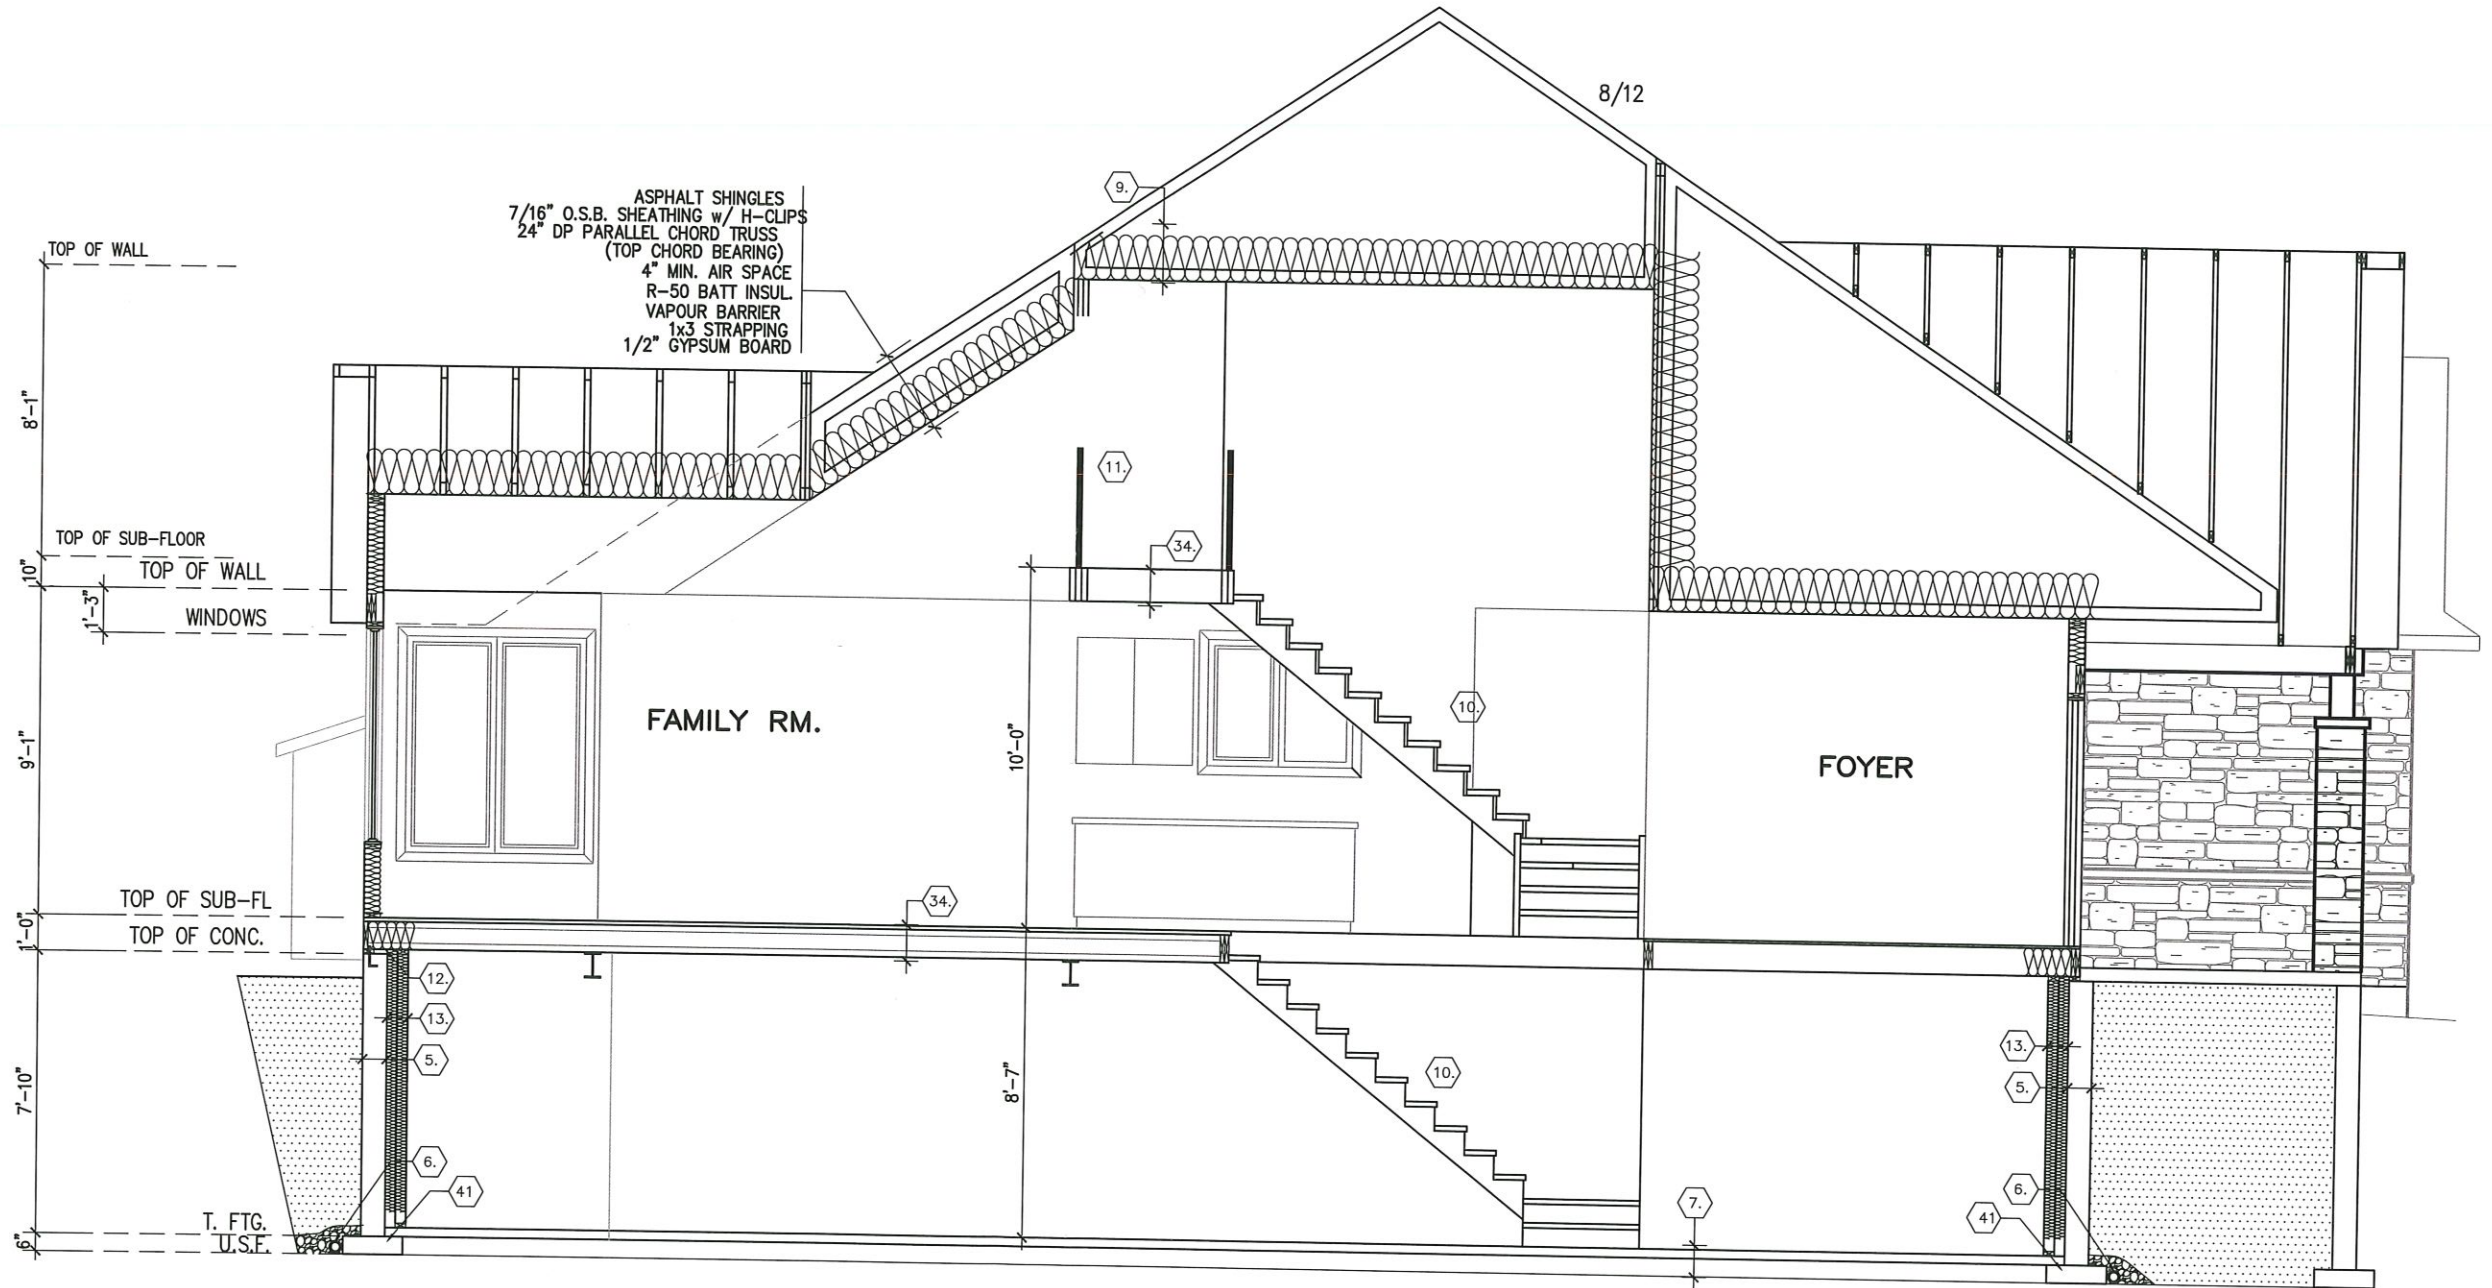

ELEVATION D loft