

DCR PHOENIX HOMES

LOT #35

PATHWAYS

ROSEMEERE (C10)

VANITIES

CABINETS -

HARDWARE -


STD WHITE INTERIORS

METAL DRWR BOX

5/8" KICK

UPDATED TOILET & WILSON LOCATION.


REVISED: OCT 19-20

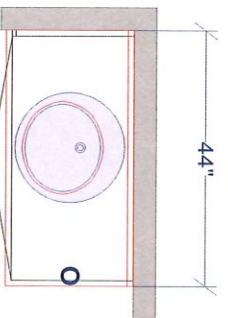

VF1 XB42-34-21/4

POWDER


INCREASE HEIGHT TO
34.5"H + COUNETER TOP

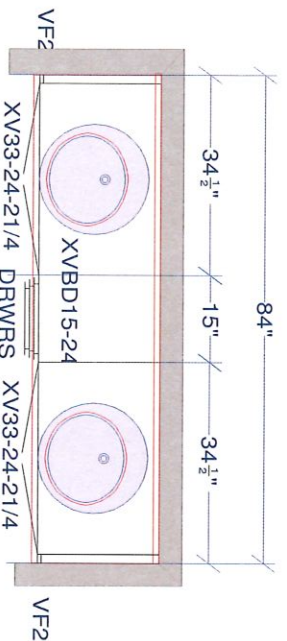

XV33-24-21/4 DRWRS XV33-24-21/4

ENSUITE

FLOATING VANITY @ 10.25" A.F.F.
TOTAL HEIGHT - 34.5"H + COUNETER TOP

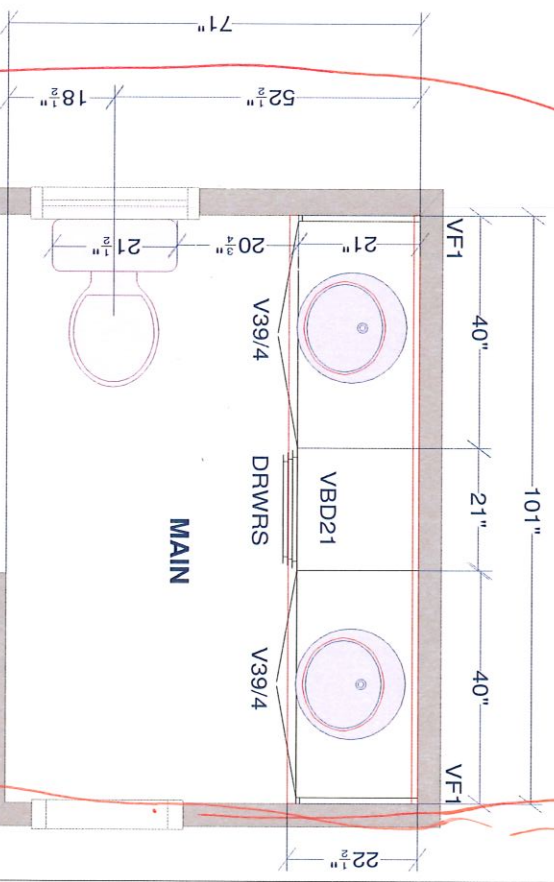

MAIN

CUSTOMER APPROVAL

I have reviewed these drawings and understand the details of the design and the CARTIER KITCHENS specifications.

Signature _____

Date _____

All dimensions - size designations given are subject to verification on job site and adjustment to fit job conditions.

SPECTRUM KITCHEN and BATH DESIGN

DCR -#35 PWYS - VANITIES - rev Oct 19-20.kit



This is an original design and must not be released or copied unless applicable fee has been paid or job order placed.

DRAWN BY: LORI DISAVERIO, B.I.D

Designed: 2020-10-18
Printed: 2020-10-18

All

Drawing #: 1 No Scale.