



CIVIC ADDRESS:
22 SALAMANDER WAY

ANNAPOLIS-2018-M

SITE: PATHWAYS

LOT NUMBER:

CIVIC ADDRESS:
22 SALAMANDER WAY

5	BEP ONLY – FOR SITE	JAN-29-21	SP
4	REVISED BEP BLACKLINES	NOV-03-20	SP
3	BEP BLACKLINES	OCT-06-20	SP
2	STRUCTURAL REVIEW	FEB-12-19	SP
1	ELEVATION M CREATED	DEC-03-18	SP
No.	Description	Date	By
REVISIONS			

file number: 509


drawn by: T.L.


date:	DEC. 2012
-------	-----------

scale:

D.C.L.-178

2M

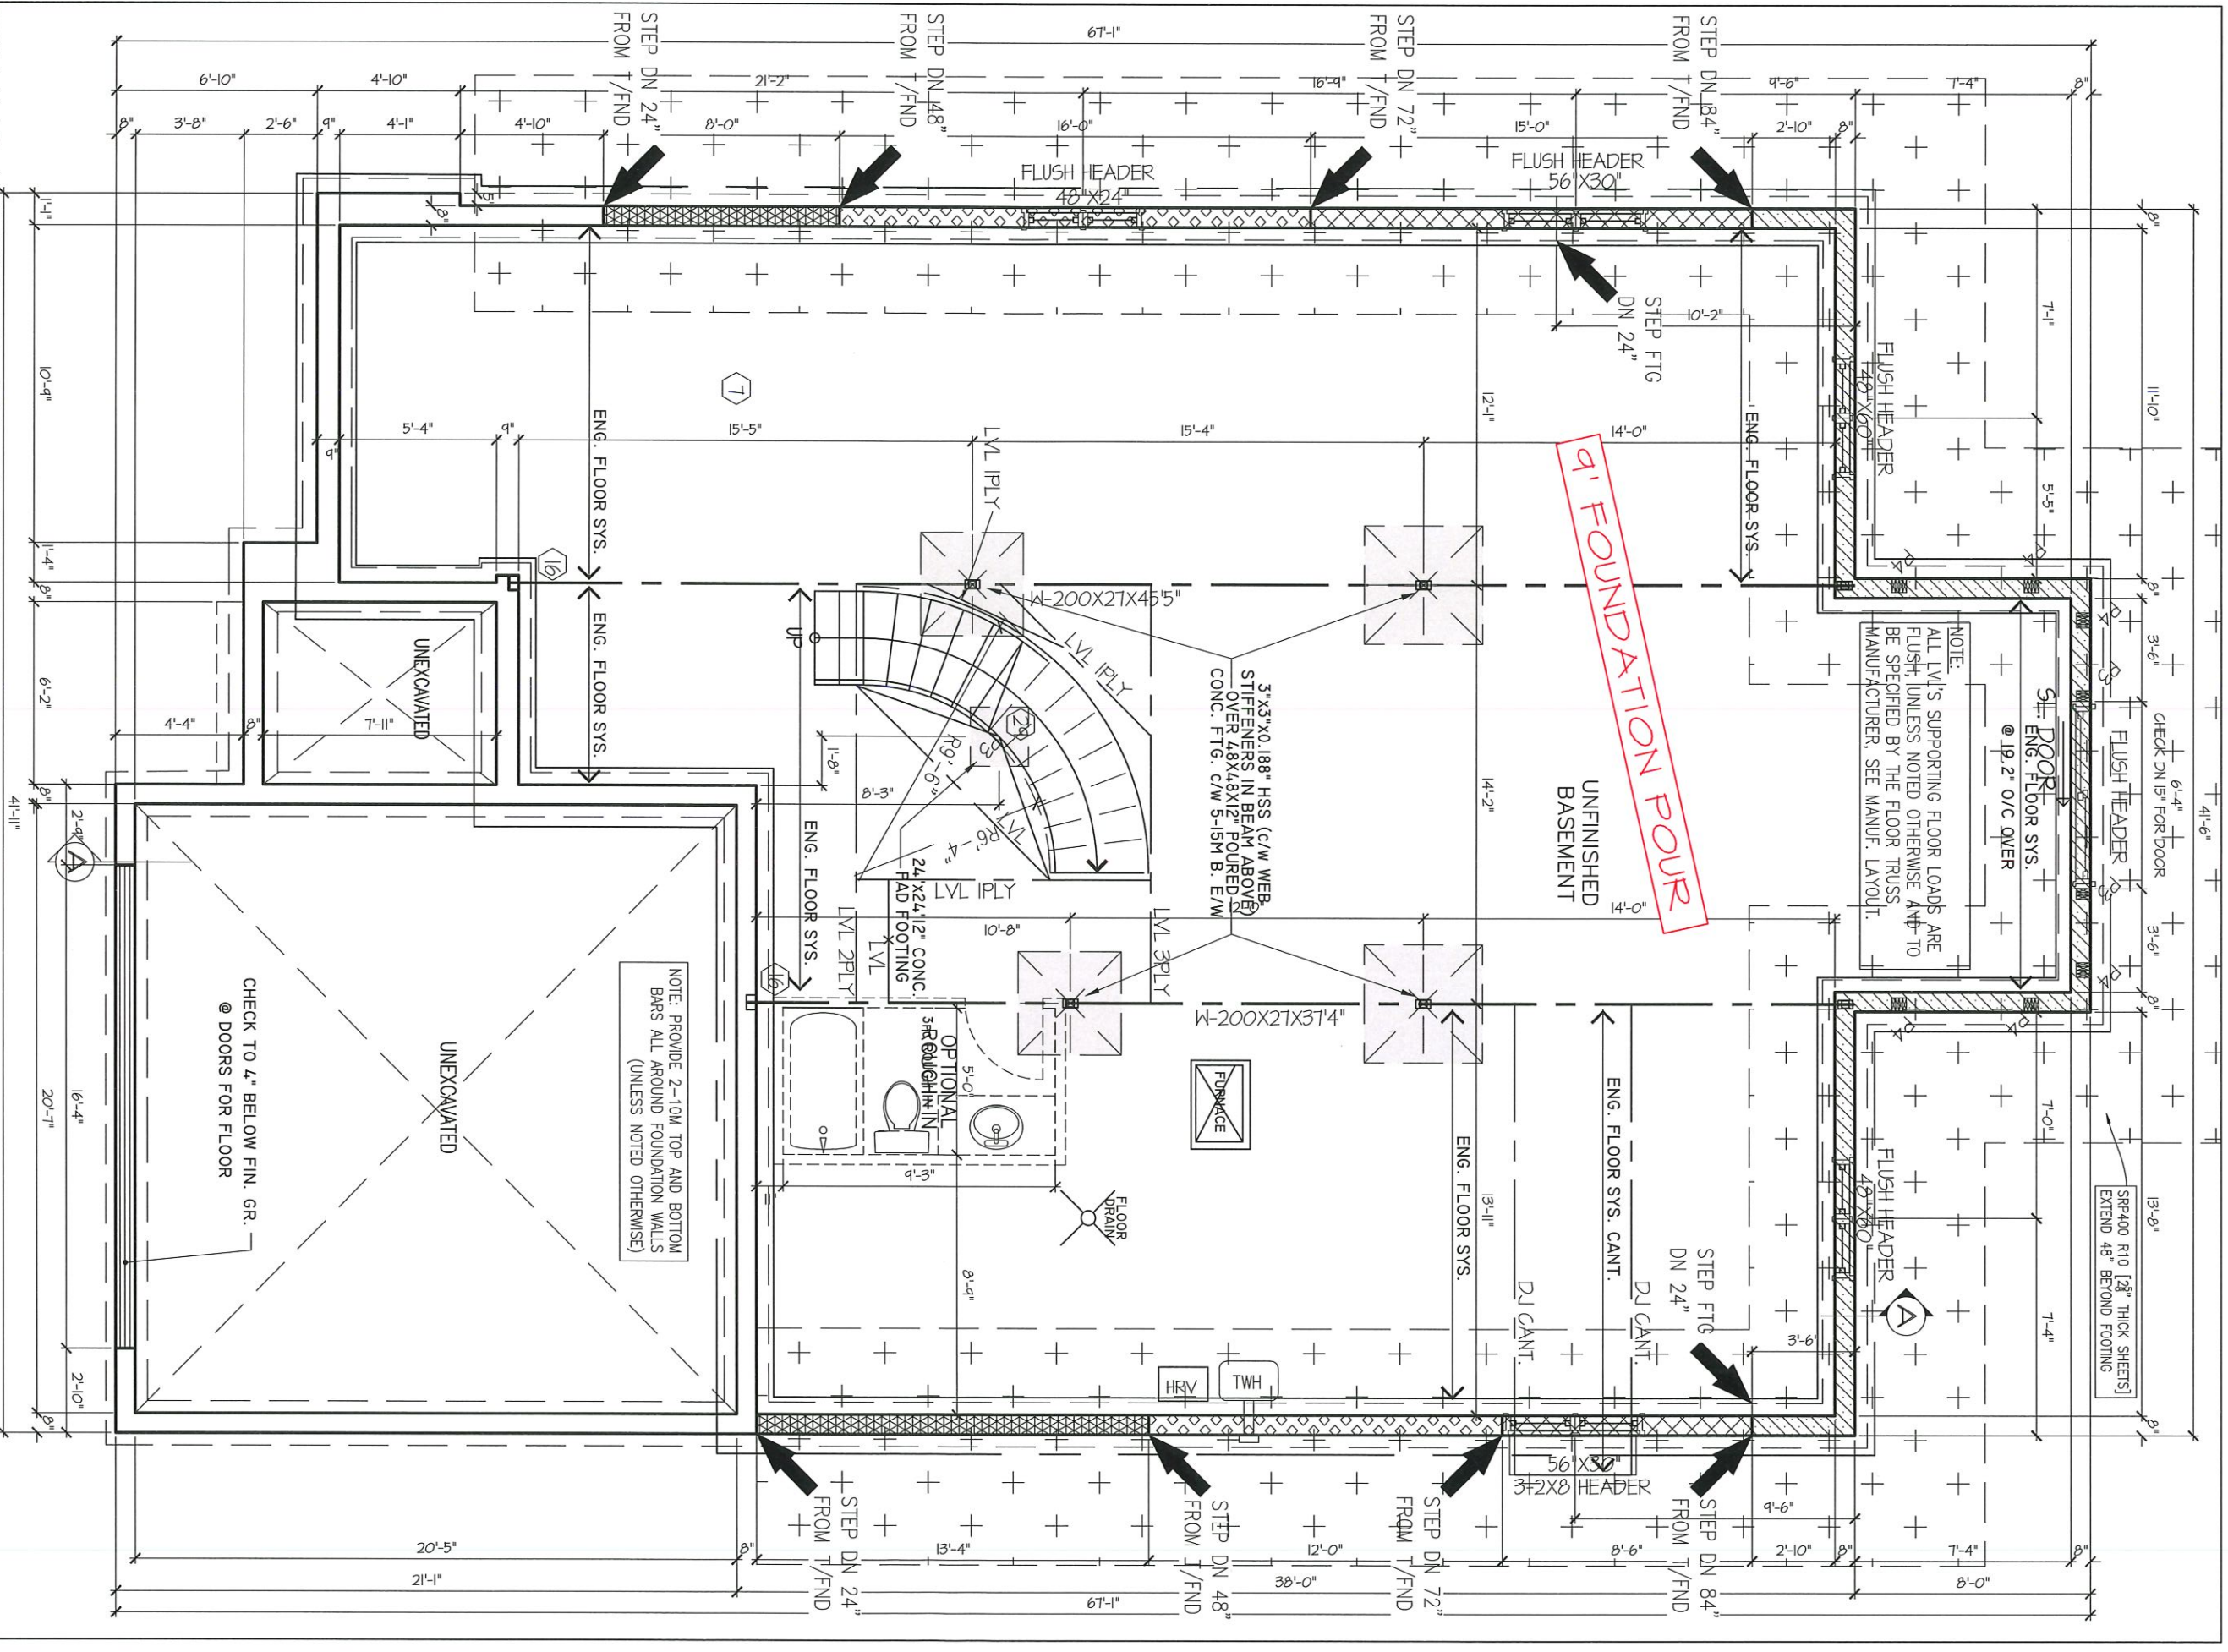

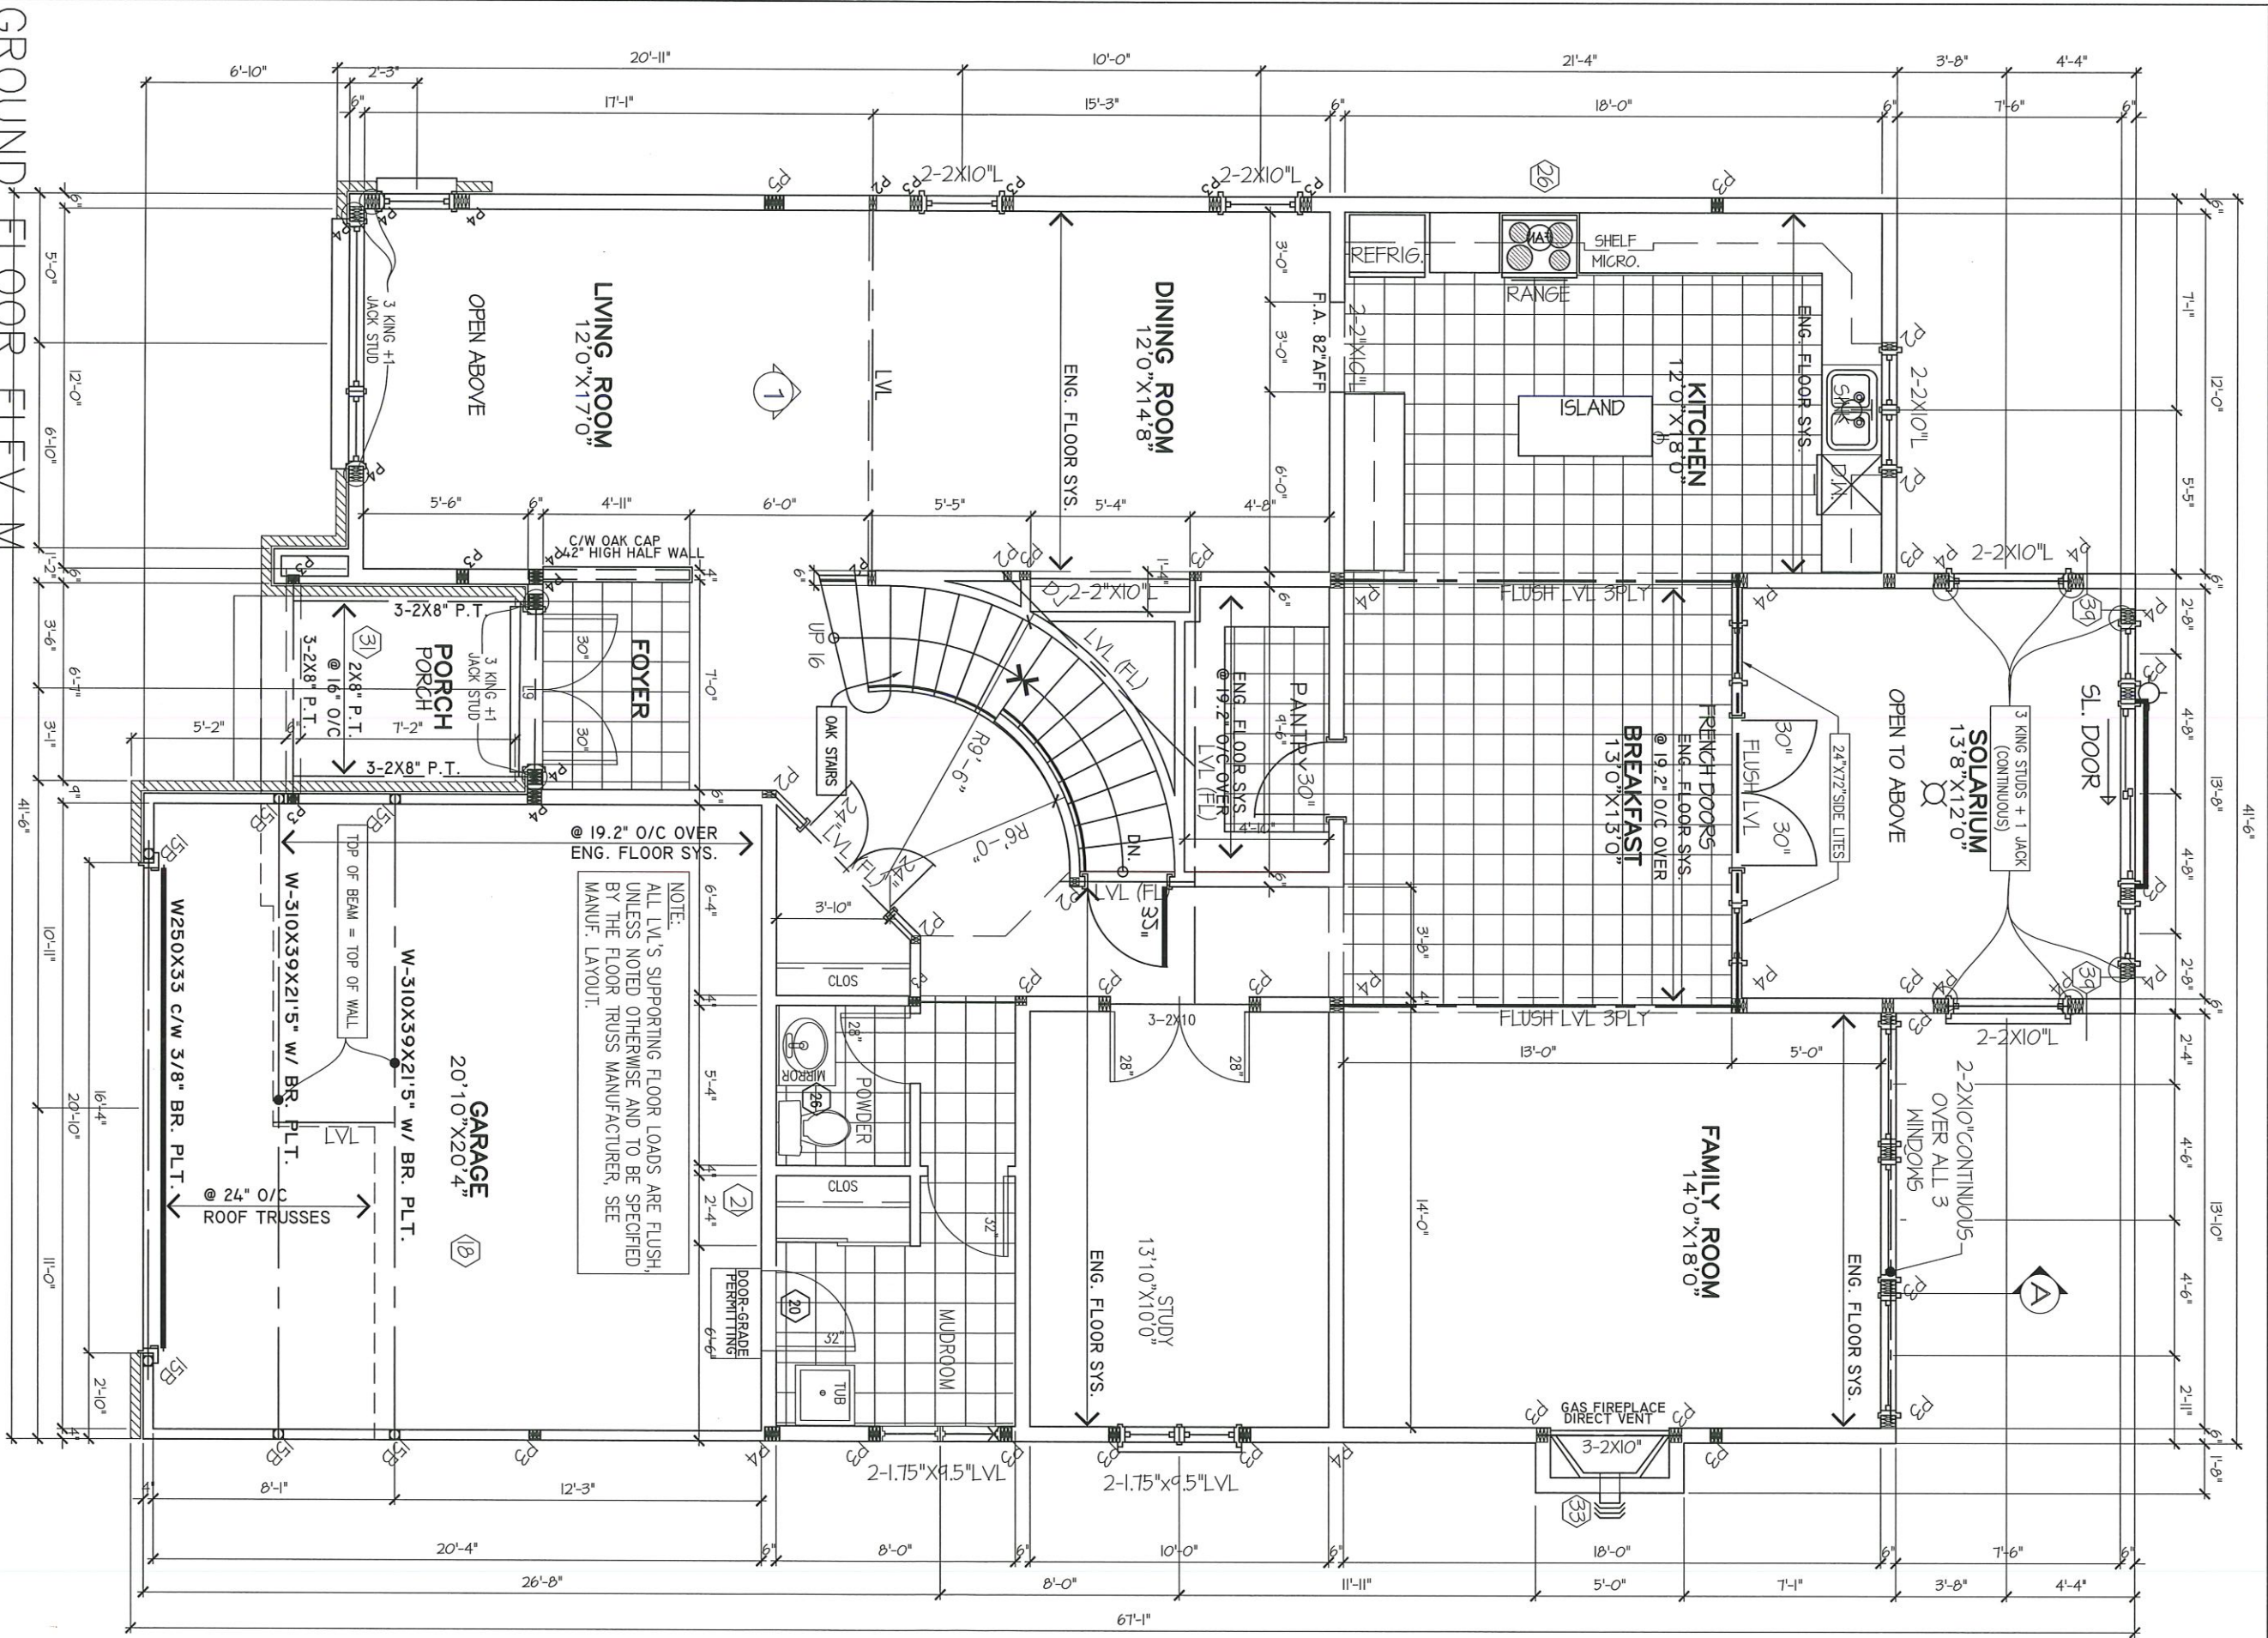

GROUND FLOOR ELEV M

ANNAPOLIS-2018-M

SITE: PATHWAYS

LOT NUMBER:


CIVIC ADDRESS:
22 SALAMANDER WAY




PHOENIX HOMES

No.	Description	Date	By
1	ELEVATION M CREATED	DEC-03-18	SP
2	STRUCTURAL REVIEW	FEB-12-19	SP
3	BEP BLACKLINES	OCT-06-20	SP
4	REVISED BEP BLACKLINES	NOV-03-20	SP
5	BEP ONLY - FOR SITE	JAN-29-21	SP

file number: 509	drawn by: T.L.
date: DEC. 2012	scale: 3/16"=1'
sheet no: D.C.L.-178	3M 9

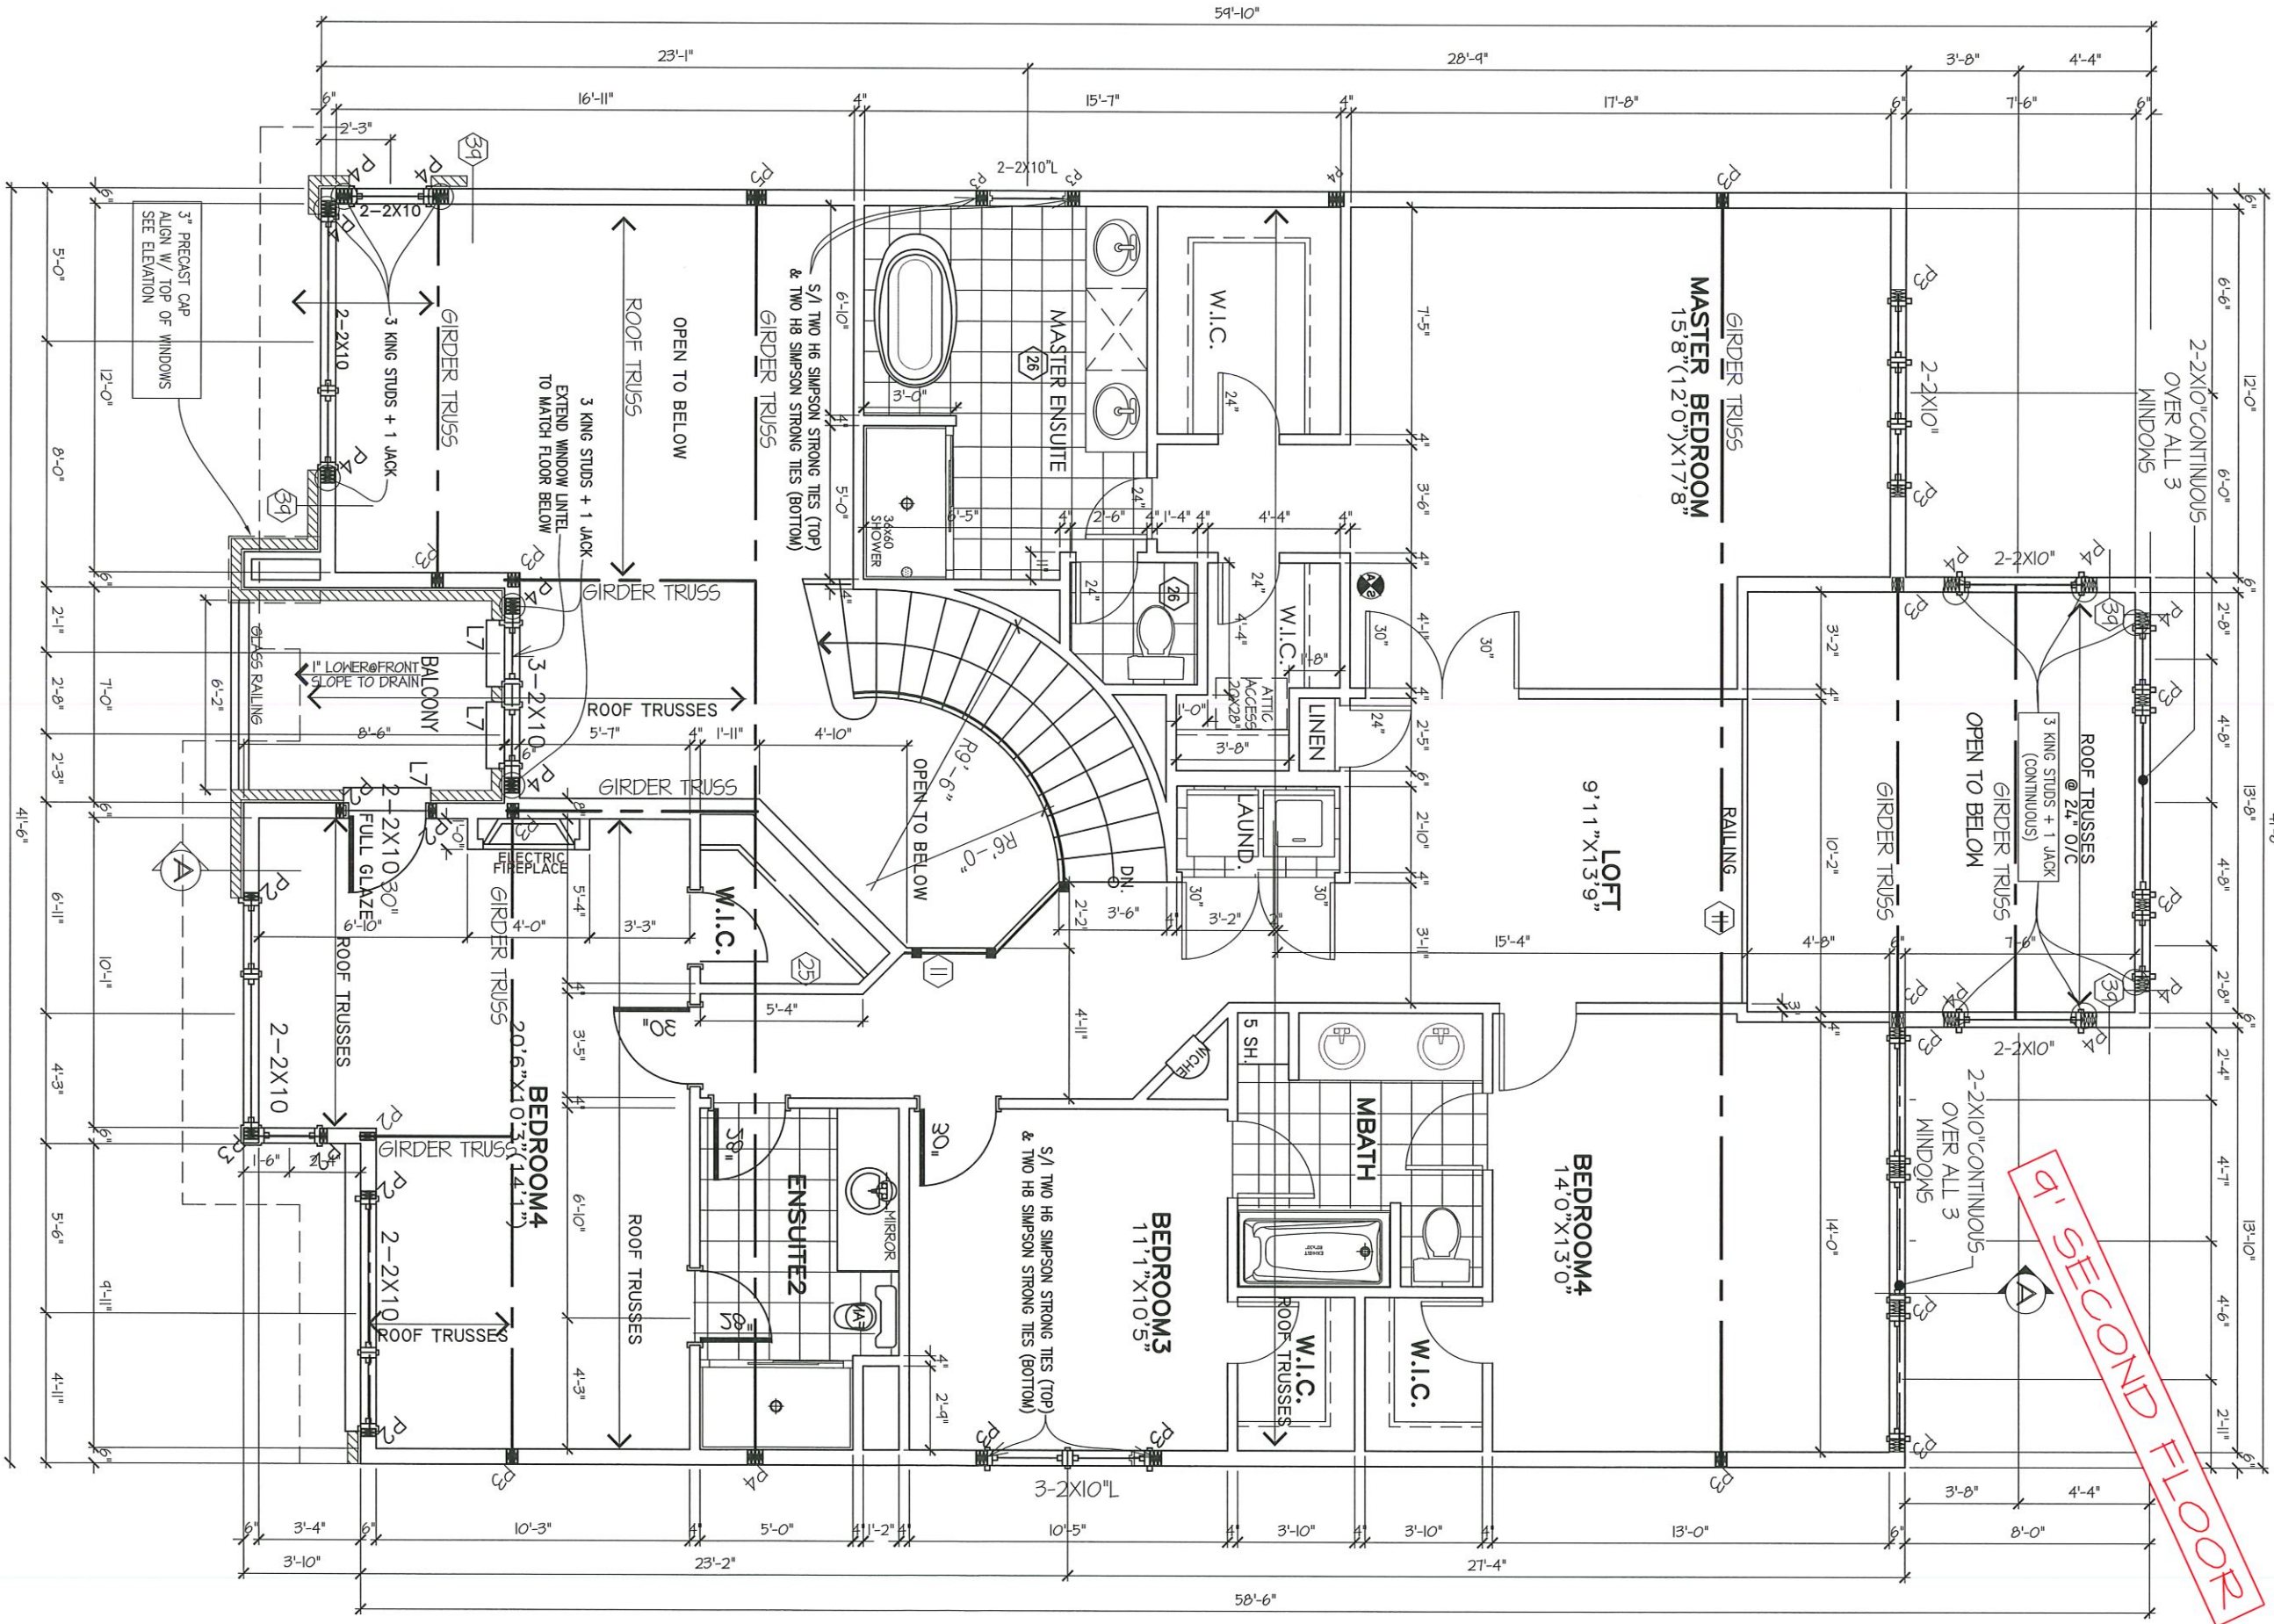

SECOND FLOOR PLAN ELEV. M

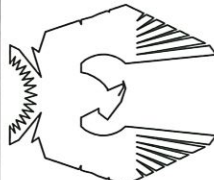

PHOENIX HOMES

ANNAPOLIS-2018-M

SITE: PATHWAYS

LOT NUMBER: 7

CIVIC ADDRESS: 22 SALAMANDER WAY

5	BEP ONLY - FOR SITE	JAN-29-21	SP
4	REVISED BEP BLACKLINES	NOV-03-20	SP
3	BEP BLACKLINES	OCT-06-20	SP
2	STRUCTURAL REVIEW	FEB-12-19	SP
1	ELEVATION M CREATED	DEC-03-18	SP
REVISIONS			
No.	Description	Date	By

file number: 509

drawn by: T.L.

date: DEC. 2012

scale: 3/16"=1'

sheet no: D.C.L.-178

4M9



~~LEFT SIDE ELEVATION~~

	file number: 509
	drawn by: T.L.
date: DEC. 2012	scale: 3/16"=1'
sheet no:	D.C.L.-178



****ATTENTION SIDING
CREW** DO NOT INSTALL
DECORATIVE TRIM AROUND
WINDOWS**

PHOENIX HOMES



LOT NUMBER:
22 SALAMANDER WAY


SITE: PATHWAYS

ANNAPOLIS-2018-M

RIGHT SIDE ELEVATION 'M'

REVISIONS		
No.	Description	Date
1	ELEVATION M CREATED	DEC-03-18
2	STRUCTURAL REVIEW	FEB-12-19
3	BEP BLACKLINES	OCT-06-20
4	REVISED BEP BLACKLINES	NOV-03-20
5	BEP ONLY - FOR SITE	JAN-29-21

file number: 509
drawn by: T.L.
date: DEC. 2012
scale: 3/16"=1'
sheet no: D.C.L.-178
9 7M

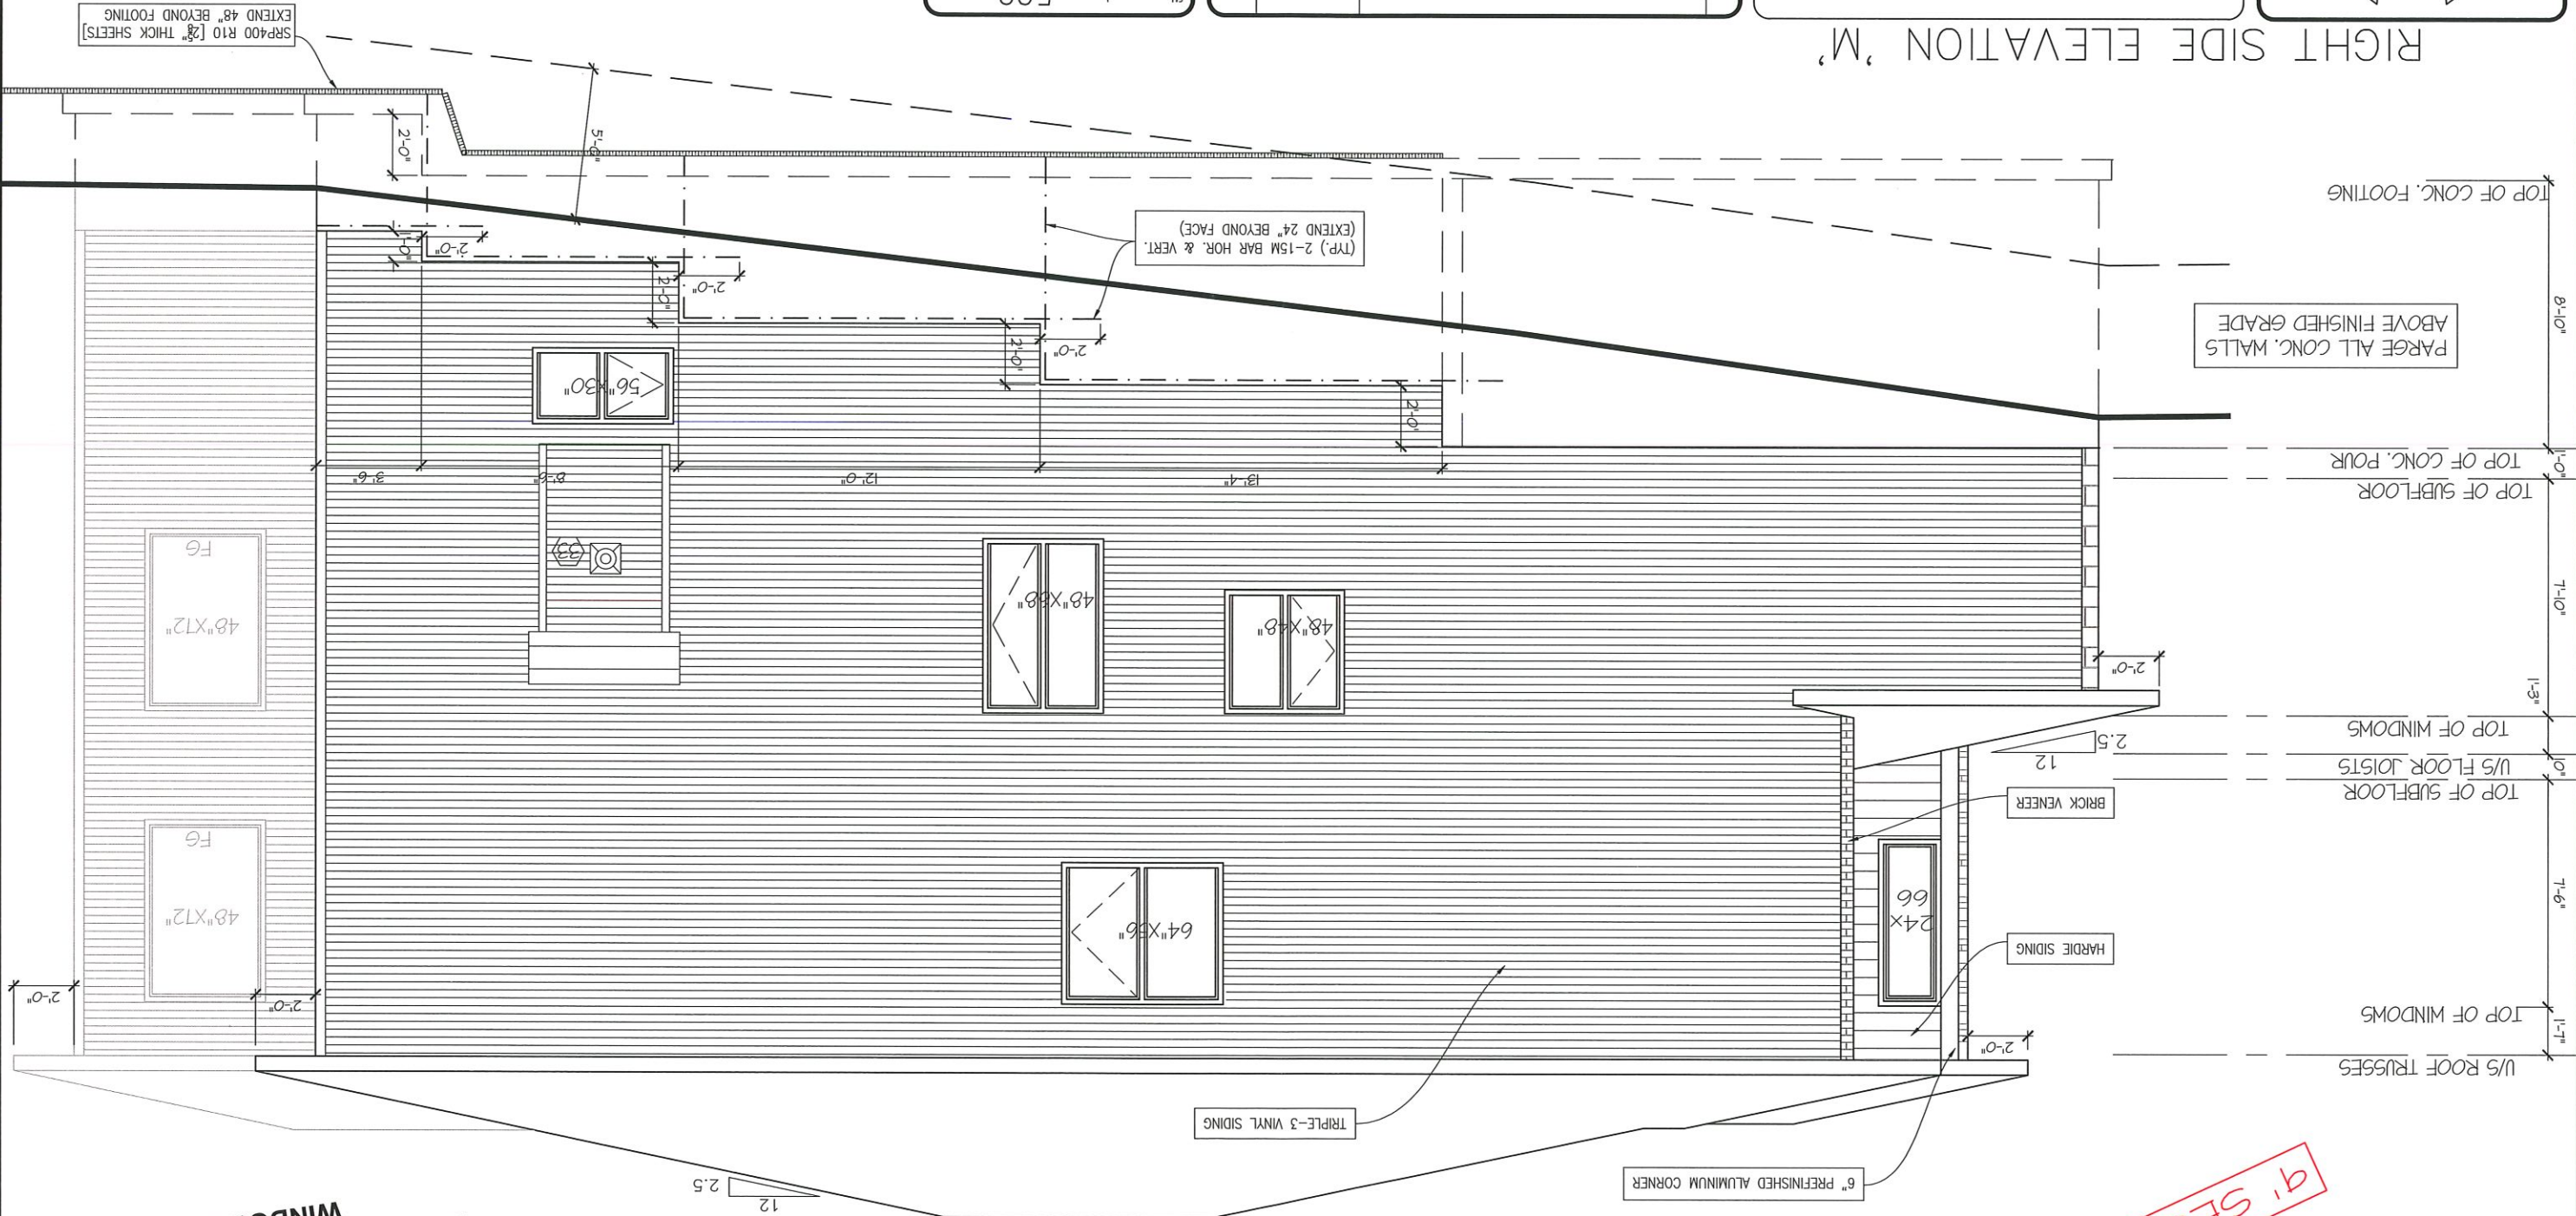

CONTRACTOR MUST VERIFY ALL DIMENSIONS ON THE JOB AND REPORT ANY DISCREPANCY TO DCR/PHOENIX BEFORE PROCEEDING WITH THE WORK.
ALL DRAWINGS AND SPECIFICATIONS ARE INSTRUMENTS OF SERVICE AND THE PROPERTY OF THE DCR/PHOENIX WHICH MUST BE RETURNED AT THE COMPLETION OF THE WORK.
ALL DRAWINGS TO BE USED FOR CONSTRUCTION ONLY AFTER BUILDING PERMIT HAS BEEN ISSUED.
DO NOT SCALE DRAWINGS, USE DIMENSIONS PROVIDED.

9' SECOND FLOOR

ATTENTION SIDING CREW
DO NOT INSTALL
DECORATIVE TRIM AROUND
WINDOWS



REAR ELEVATION M

SRP400 R10 [28" THICK SHEETS]
EXTEND 48" BEYOND FOOTING

6

[ETS]

CONTRACTOR MUST VERIFY ALL DIMENSIONS ON THE JOB AND REPORT ANY DISCREPANCY TO DCR/PHOENIX BEFORE PROCEEDING WITH THE WORK.

ALL DRAWINGS AND SPECIFICATIONS ARE INSTRUMENTS OF SERVICE AND THE PROPERTY OF THE DCR/PHOENIX WHICH MUST BE RETURNED AT THE COMPLETION OF THE WORK. AFTER BUILDING PERMIT HAS BEEN ISSUED, DO NOT SCALE DRAWINGS. USE DIMENSIONS PROVIDED.

****ATTENTION SIDING CREW****
DO NOT INSTALL
DECORATIVE TRIM AROUND
WINDOWS



SITE: PATHWAYS

REVISIONS6

file number: 509

drawn by: T.L.

date: DEC. 2012

Scale: 3/16"=1'

sheet no: D.C.L.-178

D.C.L.-178

