

PWT BLK 14 LOT 108



# DCR PHOENIX HOMES

TOWNHOUSE 20-24 - STANWICK - END UNIT  
3 BEDROOM & MASTER RETREAT


KITCHEN / VANITIES

MOUNTING HEIGHT: 96


- LINE 1 & LINE 2, 3  
HARDWARE - STD & 1st UPGRADE  
STANDARD WHITE INTERIOR  
METAL DRAWER BOX  
6 PCS - 5/8" KICK - FIN. BOTH ENDS  
2 PCS - LOOSE FILLER - 6" x 96"  
2 PCS - 90 DEG. CORNER MOULD  
1 PCS - T-MOULD  
7 PCS - FLAT MOULDING

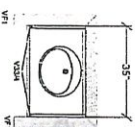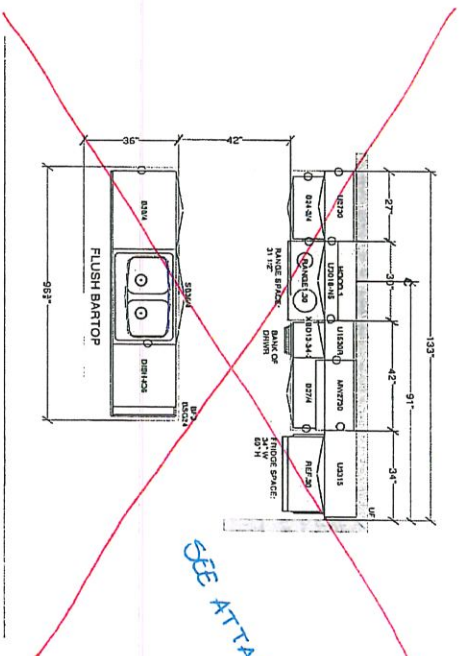


POWDER

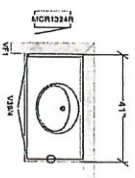

MAIN

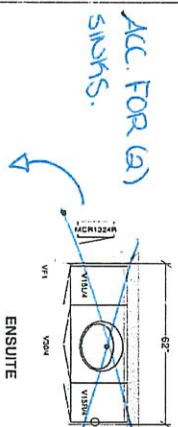


ENSUITE

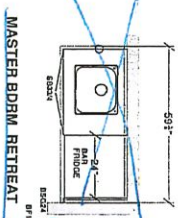

MASTER BDRM. RETREAT

ADD BACK OF  
PUMPS

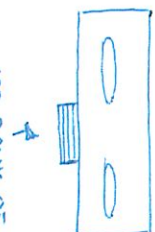

OPTIONAL REC ROOM VANITY

All dimensions, size designations given are subject to verification on job site and adjustment to fit job conditions.

SPECTRUM KITCHEN and BATH DESIGN

This is an original design and must not be released or copied unless applicable fee has been paid or job order placed.

DRAWN BY: LORI DISAVERIO, B.I.D.

Designed: 2018-02-28  
Printed: 2018-03-01

TH 20 - 24 END STANWICK - 3 BDRM + MASTER RETREAT -

ALL

Drawing #: 1 | No Scale.

# DCR PHOENIX HOMES

LINE 1

BLOCK 9 / UNIT#105

HARDWARE - STD & 1st UPGRADE

TOWNHOUSE 20-24 - STANWICK

STANDARD WHITE INTERIOR

KITCHEN

METAL DRAWER BOX

MOUNTING HEIGHT: 84


6 PCS - 5/8" KICK - FIN. BOTH ENDS

2 PCS - LOOSE FILLER - 6 x 96

2 PCS - .90 DEG. CORNER MOULD

1 PCS - T-MOULD

7 PCS - FLAT MOULDING

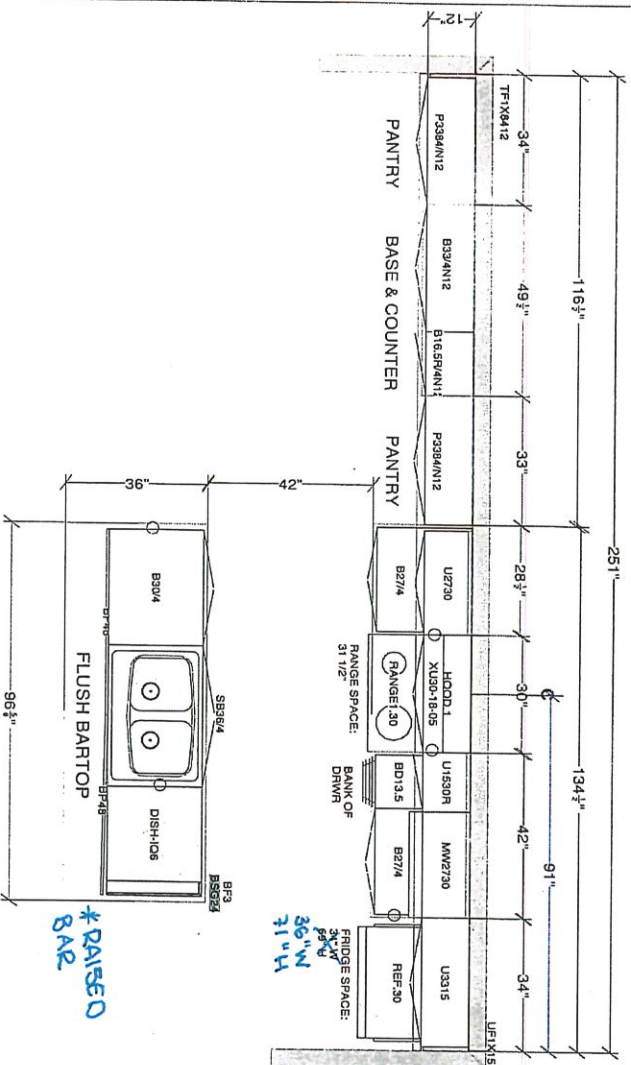

All dimensions - size designations given are subject to verification on job site and adjustment to fit job conditions.

This is an original design and must not be released or copied unless applicable fee has been paid or job order placed.

Designed: 2020-09-15  
Printed: 2020-09-15

SPECTRUM KITCHEN and BATH DESIGN



DRAWN BY: LORI DISAVERIO, B.L.D

DCR #9-105 PWYS TWNS - Stanwick KITCHEN kit

All

Drawing #: 1 No Scale.