


ALL WINDOW AND DOOR LINTELS TO BE 2- 2X8 W/ P2 ON EITHER SIDE U.N.O.

5A (1) HORN PLATE, (1) DATA PORT,
(2) RECESSED OUTLET AND
NON-STRAIGHT CONDUIT @ 10' A.F.F.
(6M BACKING FOR WALL MOUNTED
TELEVISION)

SM (1) HOCH PLATE, (2)
DATA FORTS, (2) OUTLETS

Floor plan of the kitchen showing a 3' x 3' island and a 2' x 2' island. The kitchen is labeled "KITCHEN AT ISLAND". The 3' x 3' island is located in the center, and the 2' x 2' island is located to the right of the 3' x 3' island. The kitchen is 10' wide and 10' deep. The 3' x 3' island is 3' wide and 3' deep. The 2' x 2' island is 2' wide and 2' deep. The kitchen is 10' wide and 10' deep. The 3' x 3' island is 3' wide and 3' deep. The 2' x 2' island is 2' wide and 2' deep.

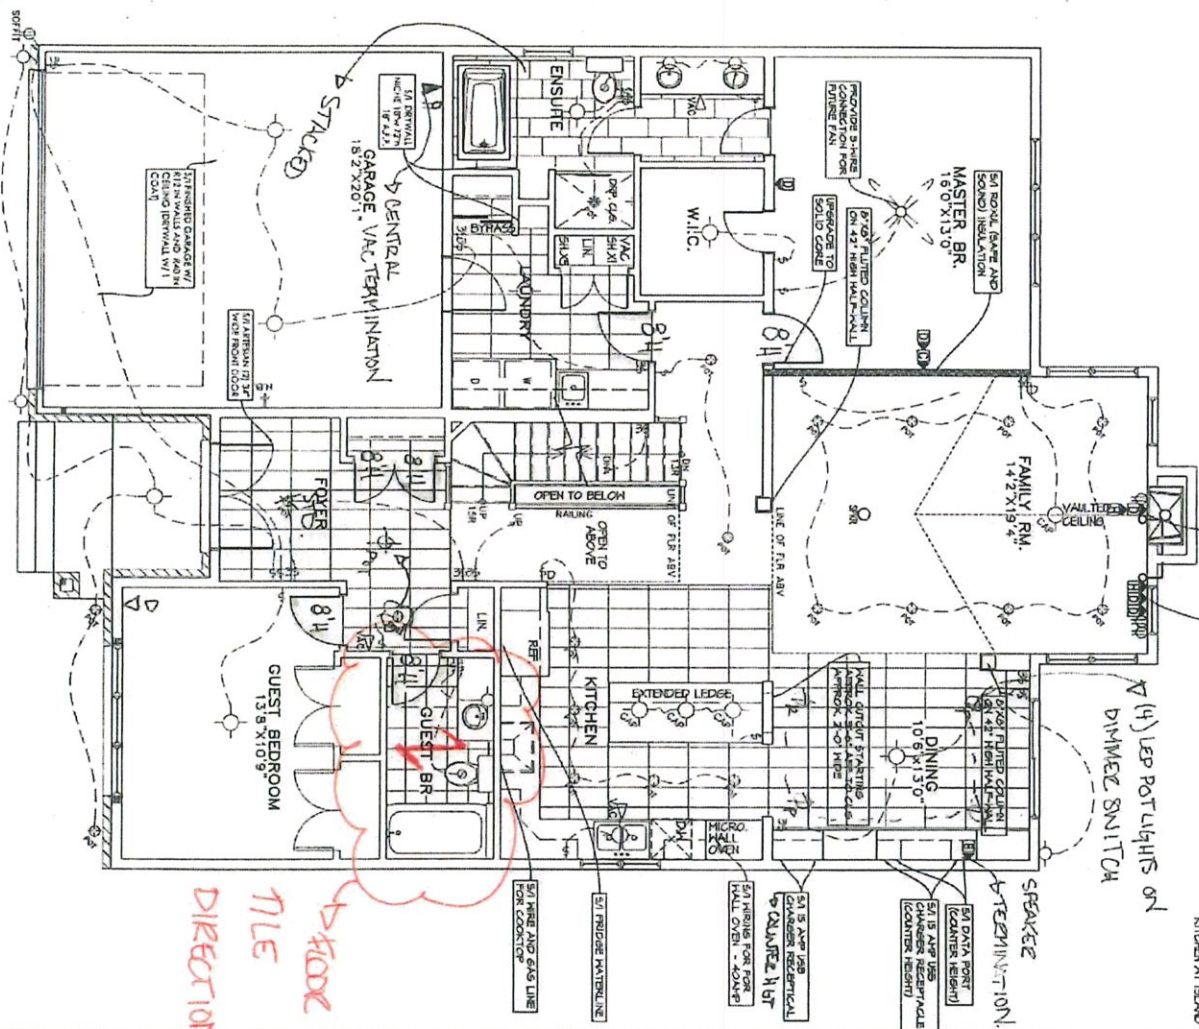

GROUND FLOOR ELEVATION D

OAKSIDE - 2016



PHOENIX HOMES

SITE, DIAMONDVIEW
LOT NUMBER,
CIVIC ADDRESS,
502 ALBERT BOYD PVT



8	FINAL BLOCKINGS	11/14/20	SP
7	IDP FOR SITE	12/11/20	SP
6	BEP ALLOCATES REVISIONS	20/09/20	CN
5	BEP BLOCKINGS	24/01/20	MJ
4	ADD DOUBLE STUD WALL TO LAUNDRY ROOM	11/09/17	SP
3	STRUCTURAL ADJUSTMENT ELEV. B & D	23/07/16	SP
No.	Drawings/Revisions	4/1/16-1/16	Rt

total printh: **E-20**

or scan by: SP

dcds: JMI 05/06

JAN 16 + I-C*

scale:

sheet no:

D.C.L.-B33

3 of 9

→ floor
tile
direction