

POW BLK 13 LOT 123

DCR PHOENIX HOMES

TOWNHOUSE 20-24 - STANWICK - END UNIT

3 BEDROOM & MASTER RETREAT

KITCHEN / VANITIES

MOUNTING HEIGHT: 84

LINE 2

HARDWARE - STD & 1st UPGRADE

STANDARD WHITE INTERIOR

METAL DRAWER BOX


6 PCS - 5/8" KICK - FIN. BOTH ENDS

2 PCS - LOOSE FILLER - 6 x 96


2 PCS - 90 DEG. CORNER MOULD

1 PCS - T-MOULD


7 PCS - FLAT MOULDING

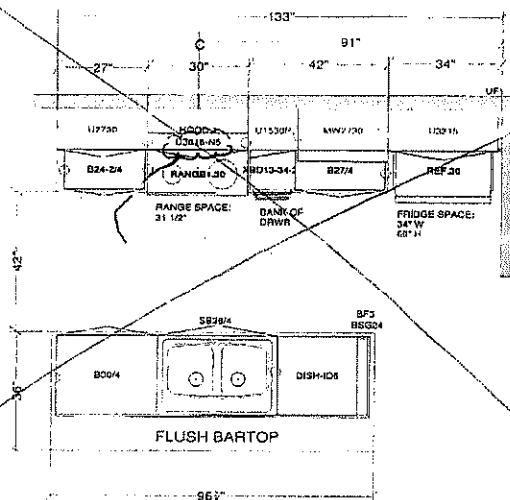


SEE ATTACHED.

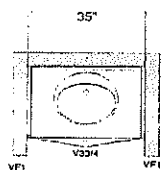

POWDER

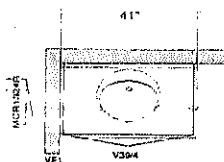


MAIN

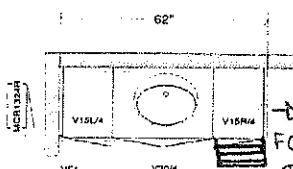


ENSUITE

BACK FOR BANK OF DRAWERS

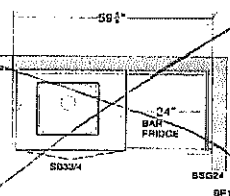

MASTER BDRM RETREAT

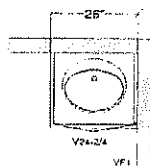

OPTIONAL REC ROOM VANITY

All dimensions size designations given are subject to verification on job site and adjustment to fit job conditions.

SPECTRUM KITCHEN and BATH DESIGN

TH 20 - 24 END STANWICK - 3 BDRM + MASTER RETREAT

This is an original design and must not be released or copied unless applicable fee has been paid or job order placed.

DRAWN BY: LORI DISAVERIO, B.I.D

Designed: 2018-02-28
Printed: 2018-03-01

All

Drawing #: 1 No Scale.


DCR PHOENIX HOMES

BLOCK 12/ UNIT # 123
TOWNHOUSE 20-24 - STANWICK
KITCHEN


MOUNTING HEIGHT: 46"

42" H UPPERS.

- LINE 2
- HARDWARE - STD & 1st UPGRADE
 - STANDARD WHITE INTERIOR
 - METAL DRAWER BOX
 - 6 PCS - 5/8" KICK - FIN. BOTH ENDS
 - 2 PCS - LOOSE FILLER - 6 x 96
 - 2 PCS - 90 DEG. CORNER MOULD
 - 1 PCS - T-MOULD
 - 7 PCS - FLAT MOULDING

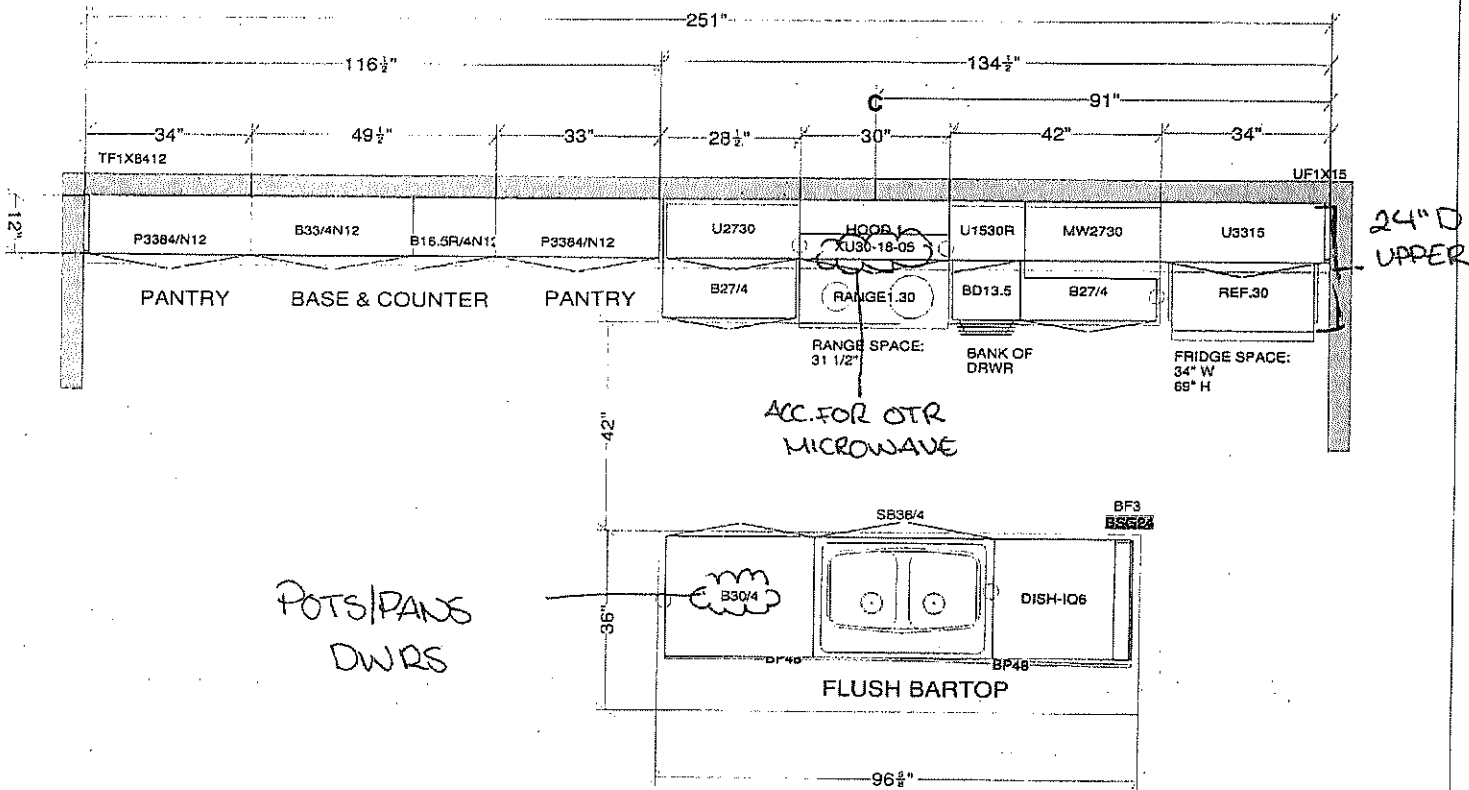

All dimensions & size designations given are subject to verification on job site and adjustment to fit job conditions.		This is an original design and must not be released or copied unless applicable fee has been paid or job order placed.	Designed: 2020-09-15 Printed: 2020-09-15	
SPECTRUM KITCHEN and BATH DESIGN		DRAWN BY: LORI DISAVERIO, B.I.D		
DCR #9-105 PWYS TWNS - Stanwick KITCHEN .kit		All	Drawing #: 1	No Scale.

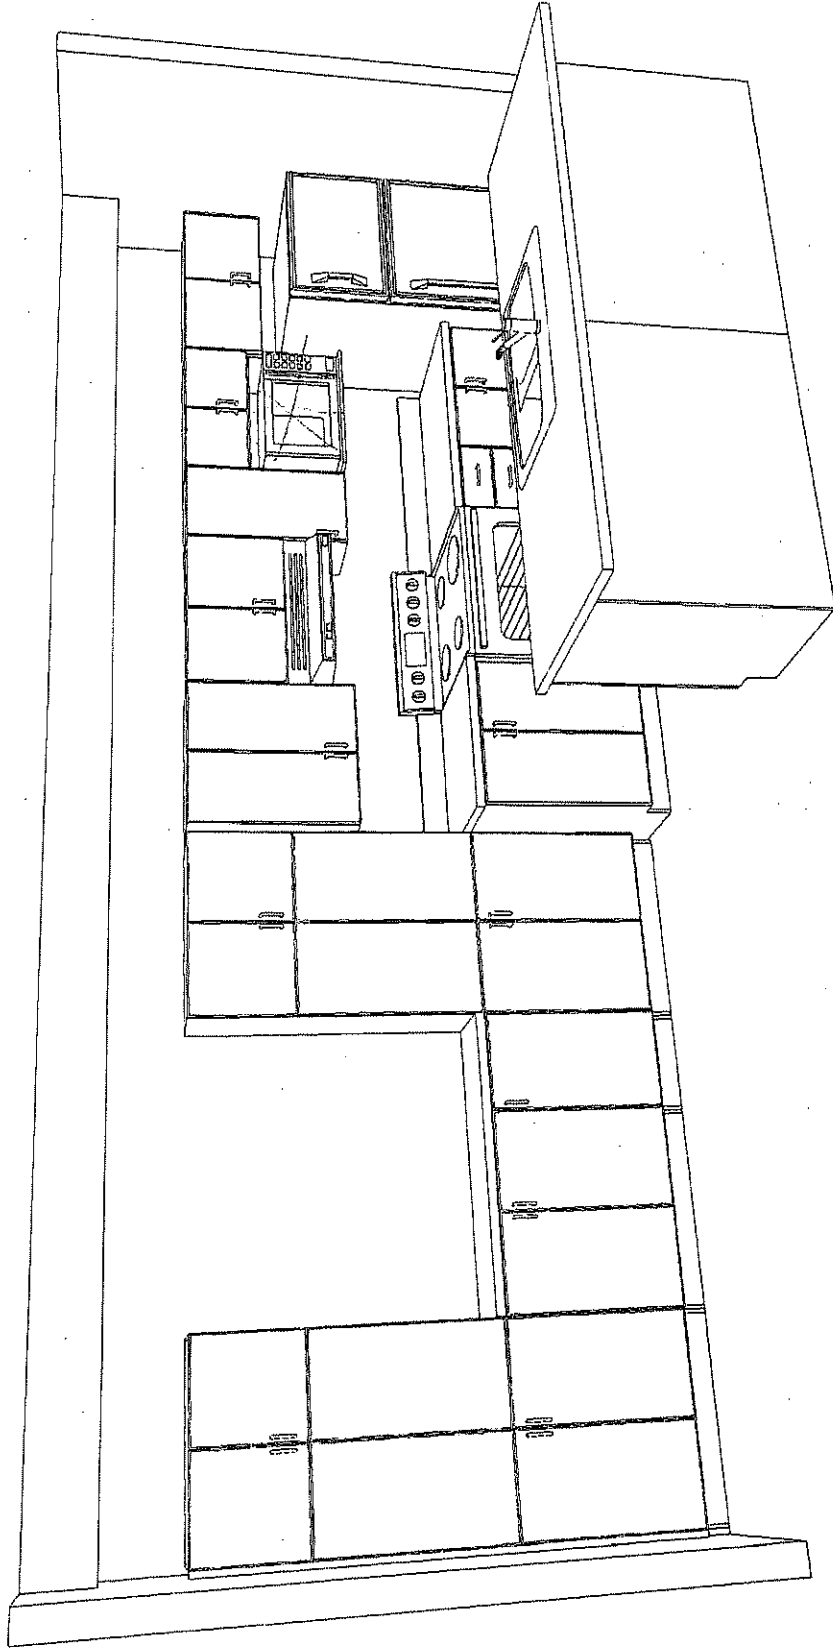

Designed: 2020-09-15
Printed: 2020-09-15



Note: This drawing is an artistic interpretation of the general appearance of the design. It is not meant to be an exact rendition.

SPECTRUM KITCHEN and BATH
DESIGN

DCR #9-105 PWYS TWNS - Stanwick KIT_VAN.kit All Drawing #: 1