


PWT BLK 13 LOT 126


DCR PHOENIX HOMES

TOWNHOUSE 20-16 - DARTON
KITCHEN / VANITIES
MOUNTING HEIGHT: 84


- LINE 1
HARDWARE - STD & 1st UPGRADE
STANDARD WHITE INTERIOR
METAL DRAWER BOX
6 PCS - 5/8" KICK - FIN. BOTH ENDS
3 PCS - LOOSE FILLER - 3 x 96
2 PCS - 90 DEG. CORNER MOULD
1 PCS - T-MOULD
6 PCS - FLAT MOULDING

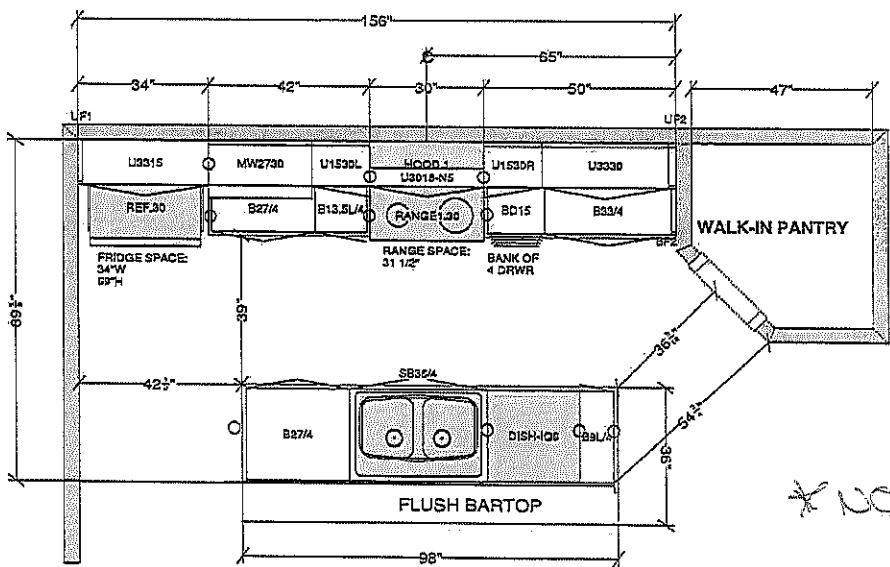


* NO CHANGES

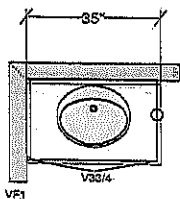


POWDER

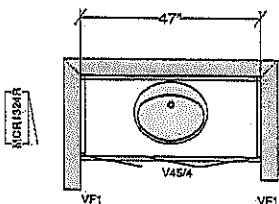

MAIN

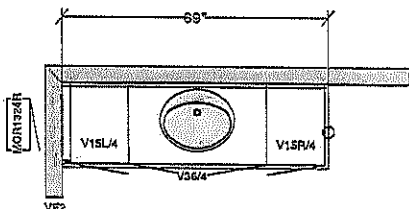

ENSUITE

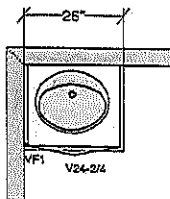

OPTIONAL REC ROOM VANITY

All dimensions and size designations given are subject to verification on job site and adjustment to fit job conditions.

SPECTRUM KITCHEN and BATH DESIGN

TH 20 - 16 - Darton - KIT_VAN.kit

This is an original design and must not be released or copied unless applicable fee has been paid or job order placed.

DRAWN BY: LORI DISAVERIO, B.I.D

Designed: 2018-02-28
Printed: 2018-03-01

All

Drawing #: 1 No Scale.