

PWT BLK 13 LOT 127

DCR PHOENIX HOMES

TOWNHOUSE STANWICK - END UNIT

3 BEDROOM & MASTER RETREAT

KITCHEN / VANITIES

MOUNTING HEIGHT: 96

40TH UPPERS

LINE 2, 3, 3, 1

HARDWARE - STD & 1st UPGRADE + 2nd UPGRADE

STANDARD WHITE INTERIOR

METAL DRAWER BOX



6 PCS - 5/8" KICK - FIN. BOTH ENDS

2 PCS - LOOSE FILLER - 8 x 96


2 PCS - 80 DEG. CORNER MOULD

1 PCS - T-MOULD


7 PCS - FLAT MOULDING

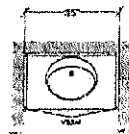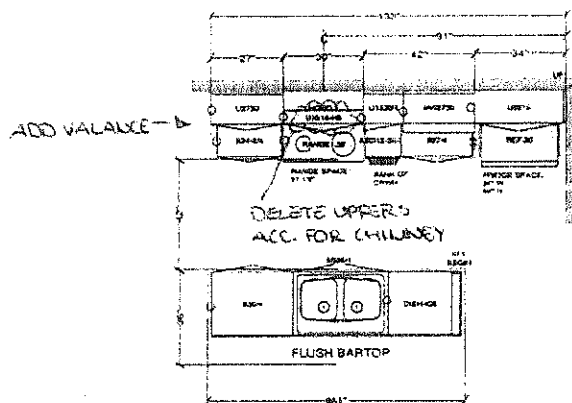


POWDER

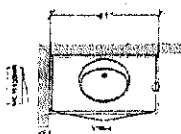


MAIN

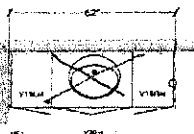

ENSUITE

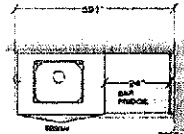

MASTER BORN RETREAT

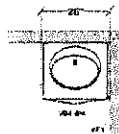

1994

OPTIONAL REC ROOM VANITY

All dimensions, size designations given are subject to verification on job site and adjustment to fit job conditions.

**SPECTRUM KITCHEN and BATH
DESIGN**

TH 20 - 24 END STANWICK - 3 BDRM + MASTER RETREAT.

This is an original design and must not be released or copied unless applicable fee has been paid or job order placed.

DRAWN BY: LORI DISAVERIO, B.I.D.

Designed: 2018-02-28
Printed: 2018-03-01

Year	Number of people (millions)
1980	18
1985	20
1990	22
1995	24
2000	26
2005	28
2010	30
2015	33
2020	38

Drawing #: 1	No Scale.
--------------	-----------

