

PWT BLK 14 LOT 130

DCR PHOENIX HOMES



TOWNHOUSE 20-14 - COLBY

KITCHEN / VANITIES


MOUNTING HEIGHT: 84

LINE 1


HARDWARE - STD & 1st UPGRADE
STANDARD WHITE INTERIOR
METAL DRAWER BOX
6 PCS - 5/8" KICK - FIN. BOTH ENDS
3 PCS - LOOSE FILLER - 3 x 96
2 PCS - 90 DEG. CORNER MOULD
1 PCS - T-MOULD
6 PCS - FLAT MOULDING

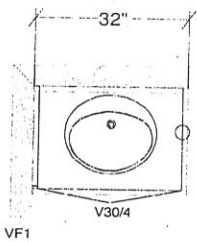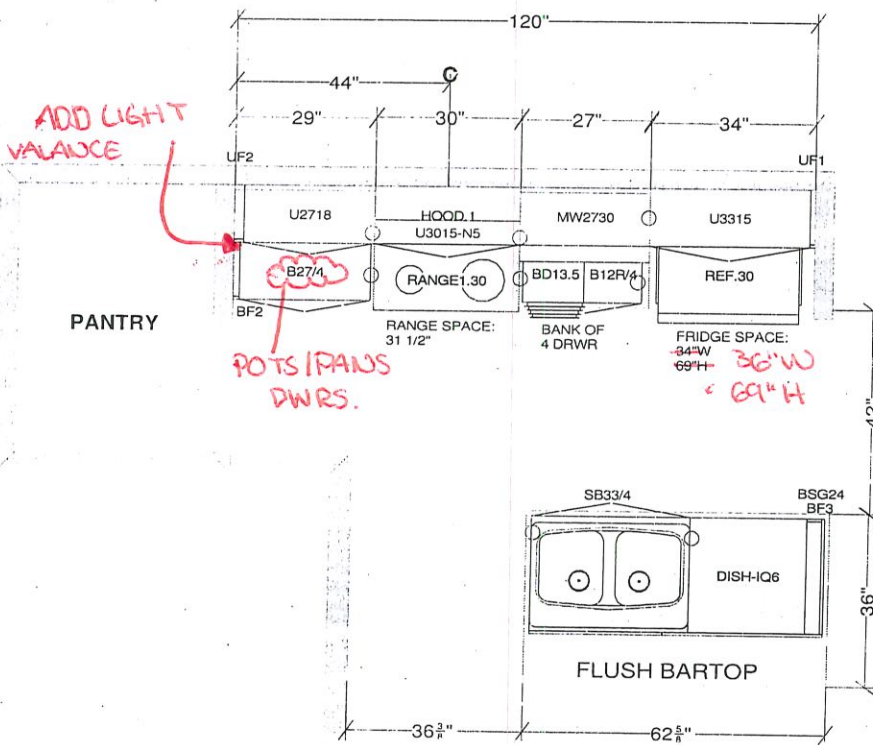

POWDER

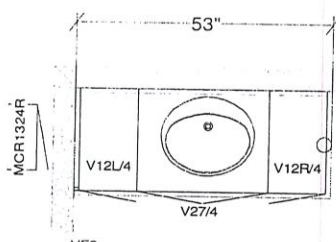

MAIN

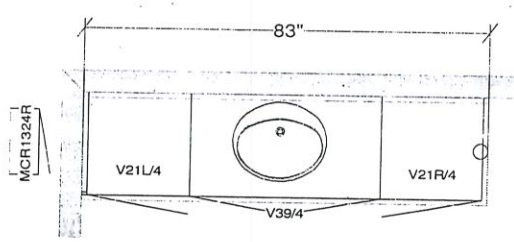

ENSUITE

All dimensions, size designations given are subject to verification on job site and adjustment to fit job conditions.

SPECTRUM KITCHEN and BATH DESIGN

TH 20 - 14 - Colby -KIT -VAN.kit

This is an original design and must not be released or copied unless applicable fee has been paid or job order placed.

DRAWN BY: LORI DISAVERIO, B.I.D

Designed: 2018-02-28
Printed: 2018-03-01

All

Drawing #: 1 No Scale.

TA