


FOR BEP ONLY
B.E.P.

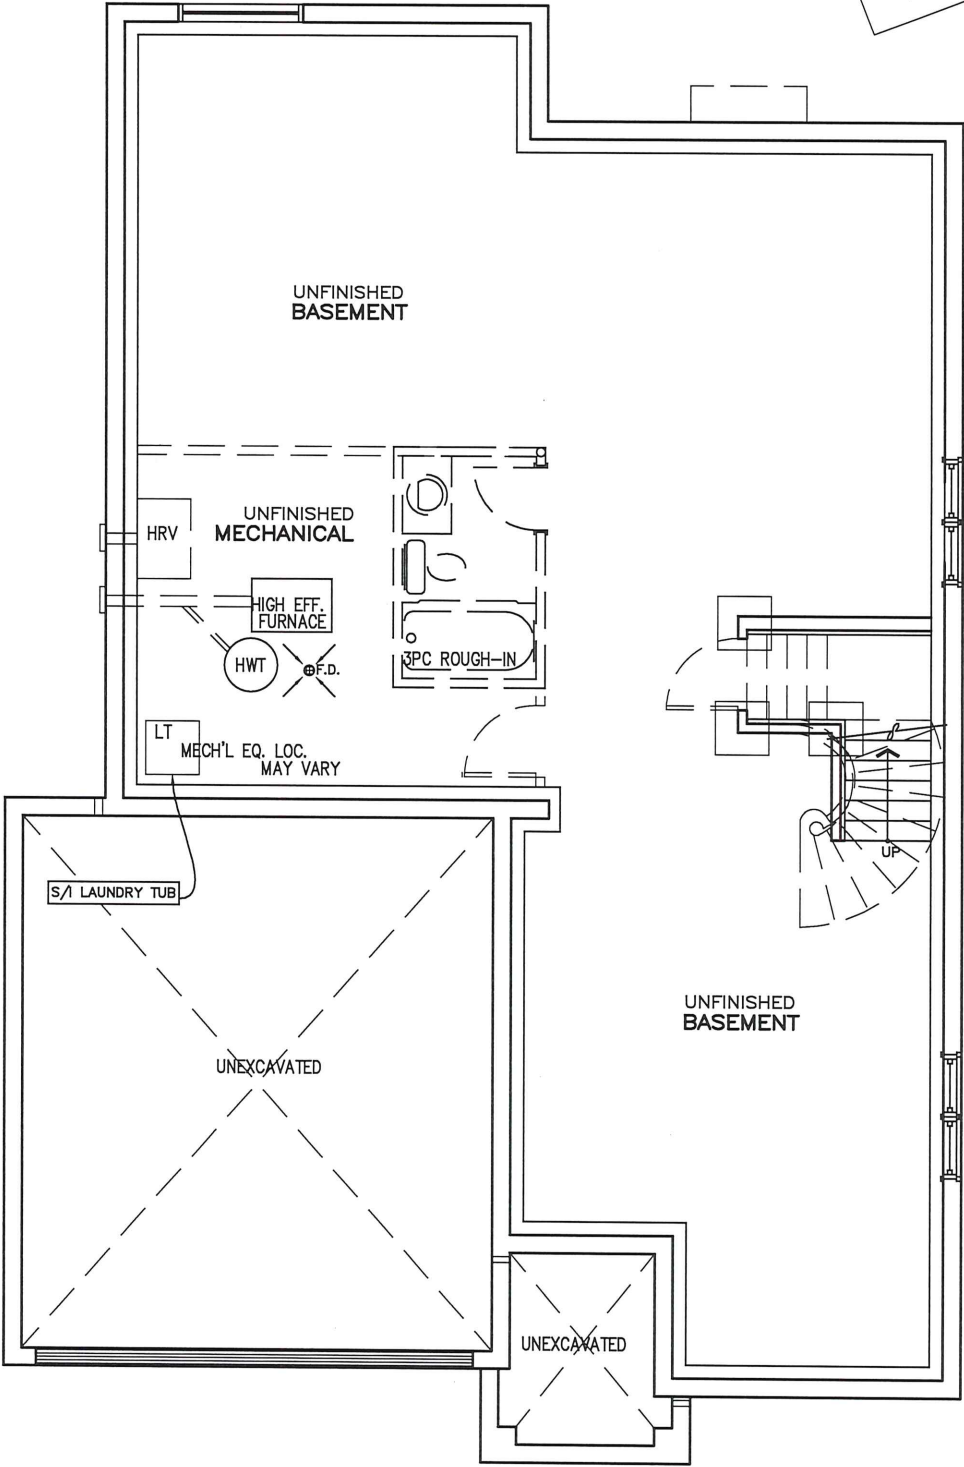

9' FOUNDATION POUR

BASEMENT PLAN-A,B,C,D



PHOENIX HOMES

43-5-SARATOGA-2012

SITE: PATHWAYS

LOT NUMBER:


38

CIVIC ADDRESS:
202 PINGUI PLACE

No.	Description	Date	By
4	BEP BLACKLINES	JUL20-20	AJ
3	REV. PER STRUCT'L REVIEW (J.S. HALL&ASSO.)	DEC19-12	SD
2	REV. PER TRUSS&JOIST LAYOUT	NOV27-12	SD
1	ISSUED FOR PRICING ONLY	NOV-2012	SD
REVISIONS			

footprint:	43-5
drawn by:	SD
date:	SEP/12
scale:	3/16"=1'-0"
sheet no:	2
	8

FOR BEP ONLY
B.E.P.

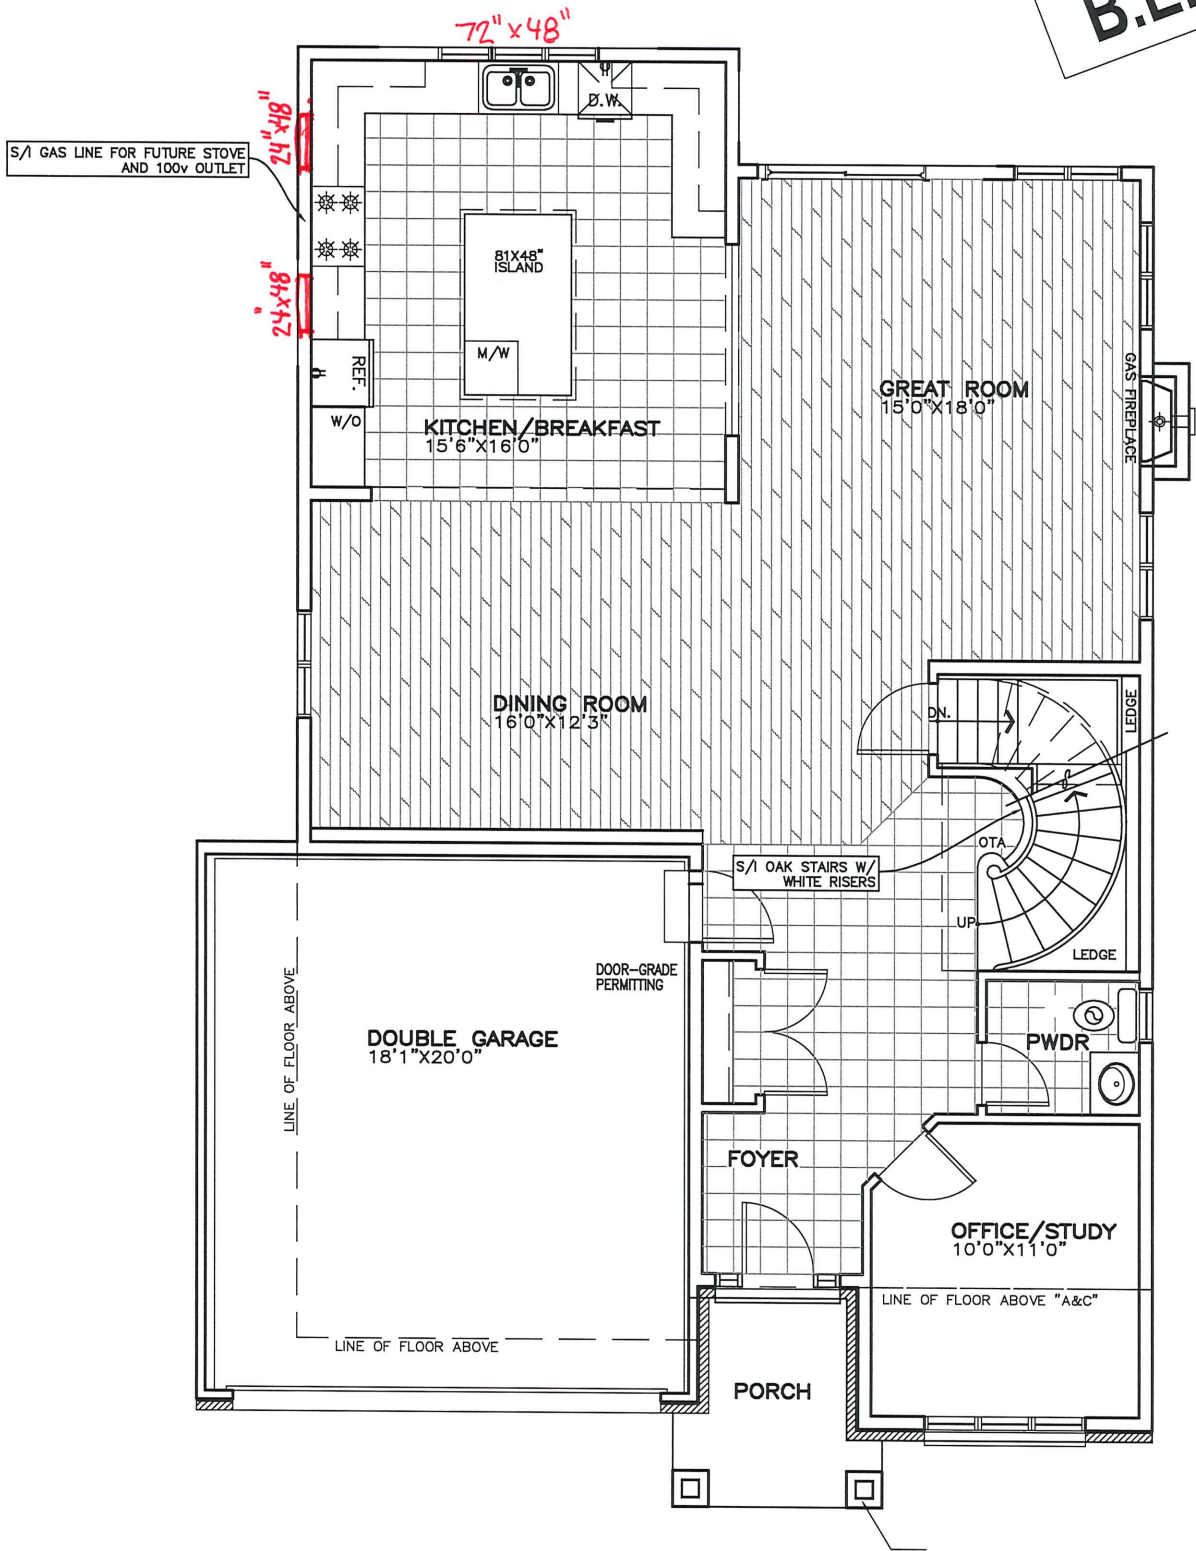

GROUND FLOOR PLAN EL. A&C



PHOENIX HOMES

43-5-SARATOGA-2012

SITE: PATHWAYS

LOT NUMBER: 38

CIVIC ADDRESS: 202 PINGUI PLACE

No.	Description	Date	By
4	BEP BLACKLINES	JUL20-20	AJ
3	REV. PER STRUCT'L REVIEW (J.S. HALL&ASSO.)	DEC19-12	SD
2	REV. PER TRUSS&JOIST LAYOUT	NOV27-12	SD
1	ISSUED FOR PRICING ONLY	NOV-2012	SD
REVISIONS			

footprint: 43-5

drawn by: SD


date: SEP/12

scale: 3/16"=1'-0"

sheet no: 3

3A0
8

FOR BEP ONLY
B.E.P.

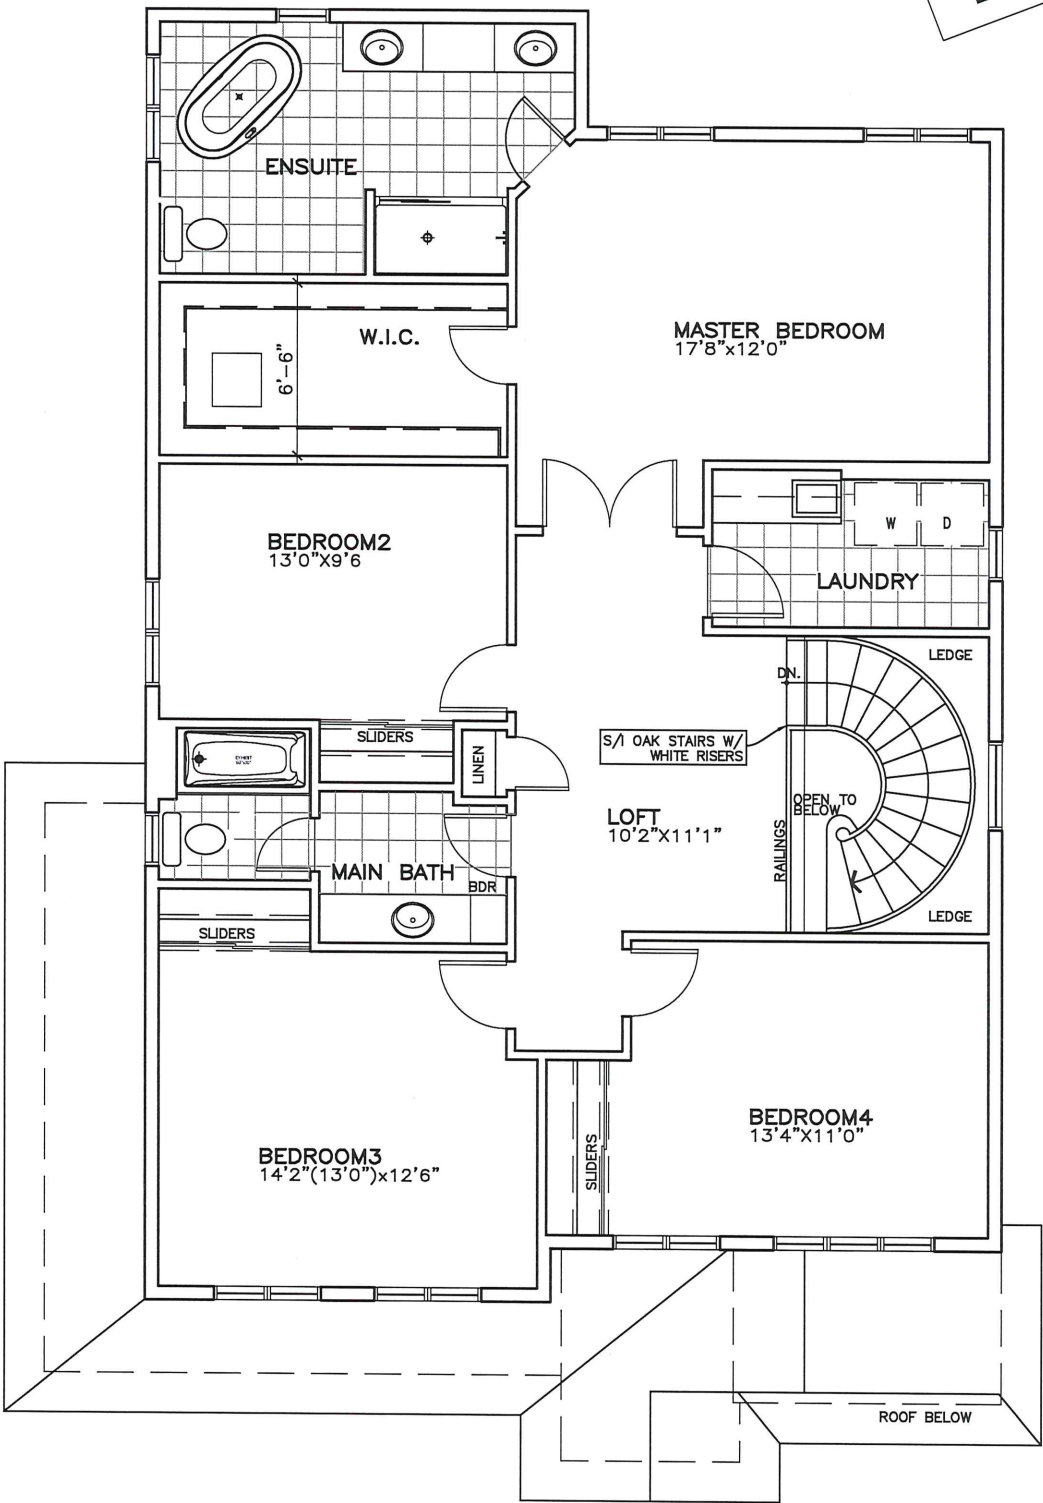

SECOND FLOOR PLAN EL. A&C



PHOENIX HOMES

43-5-SARATOGA-2012

SITE: PATHWAYS

LOT NUMBER:

38

CIVIC ADDRESS:
202 PINGWI PLACE

No.	Description	Date	By
4	BEP BLACKLINES	JUL20-20	AJ
3	REV. PER STRUCT'L REVIEW (J.S. HALL&ASSO.)	DEC19-12	SD
2	REV. PER TRUSS&JOIST LAYOUT	NOV27-12	SD
1	ISSUED FOR PRICING ONLY	NOV-2012	SD
REVISIONS			

footprint:	43-5
drawn by:	SD
date:	SEP/12
scale:	3/16"=1'-0"
sheet no:	4AC
	8
4	