

TF8 UNIT 129

DCR PHOENIX HOMES
TERRA FLATS

MODEL - TYPE A (LOWER FLOOR)

KITCHEN / VANITIES

MOUNTING HEIGHT - 84

LINE 1

HARDWARE - U1

STANDARD WHITE INTERIOR

METAL DRAWER BOX


3 PCS - 5/8" KICK - FIN. BOTH ENDS

2 PCS - LOOSE FILLER - 6 x 96

2 PCS - 90 DEG. CORNER MOULD


1 PCS - T-MOULDING

4 PCS - FLAT MOULDING

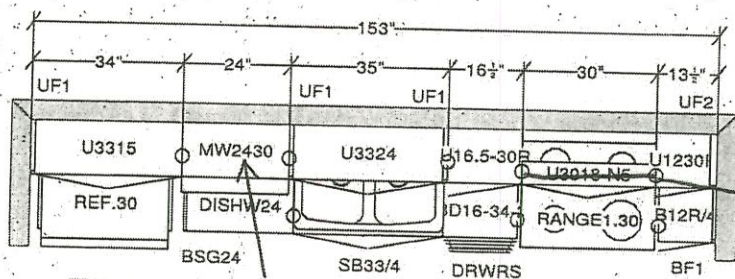


FRIDGE
SPACE:
W:34"
H:69"

SPACE FOR MW:
W: 22.5"
H:13.5"

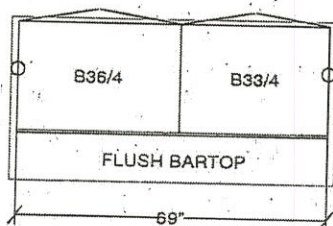


MC1524R

VF1

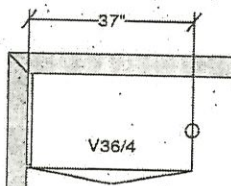

MAIN BATH

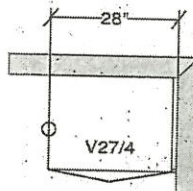

MC1524L

VF1

ENSUITE

All dimensions and size designations given are subject to verification on job site and adjustment to fit job conditions.



This is an original design and must not be released or copied unless applicable fee has been paid or job order placed.

Designed: 2017-04-04
Printed: 2017-04-07


TYPE A

All

Drawing #: 1 | No Scale.


TF8 UNIT 129

SAMPLE STANDARD APPLIANCES

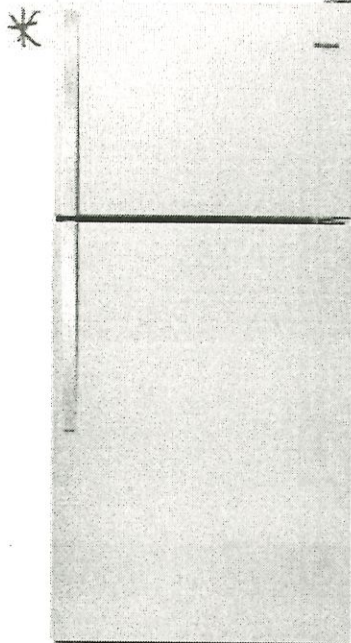


WRT318FZDM
Whirlpool® 18 Cu. Ft.
Top-Freezer Refrigerator
with Glass Shelving


←30 inch→

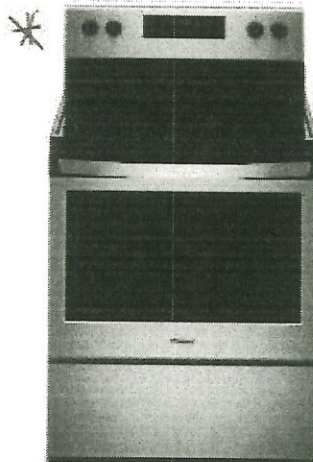



YWFE510S0HS
Whirlpool® 5.3 Cu. Ft.
Freestanding Electric
Range with Adjustable
Self-Cleaning

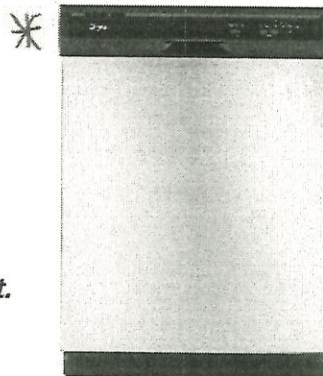

WDF330PAHS
Whirlpool® 55 dBA
Heavy-Duty Dishwasher
with 1-Hour Wash Cycle

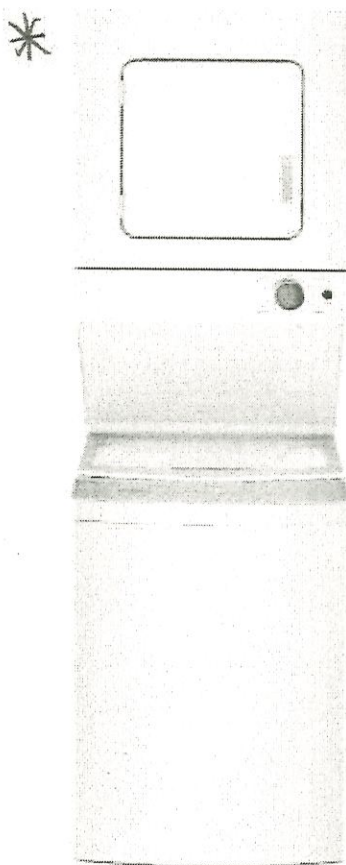


YWET4024HW
24" Electric Stacked
Laundry Center 1.6 Cu. Ft.
Washer with Impeller
and soft close glass lid
Center Controls

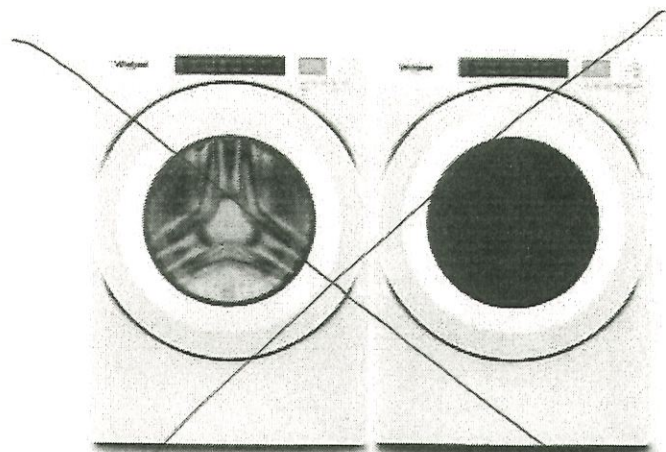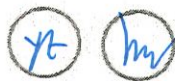


WFW560CHW
Whirlpool® 5.0 Cu. Ft.
I.E.C. Closet Depth
Front Load Washer with
Single Dose Dispenser

YWED5620HW
Whirlpool® 7.4 Cu. Ft.
Front Load Electric Dryer
with Intuitive Touch
Controls, Advanced
Moisture Sensing


*Builder and NCA reserve the right to substitute a model of equal or greater value.

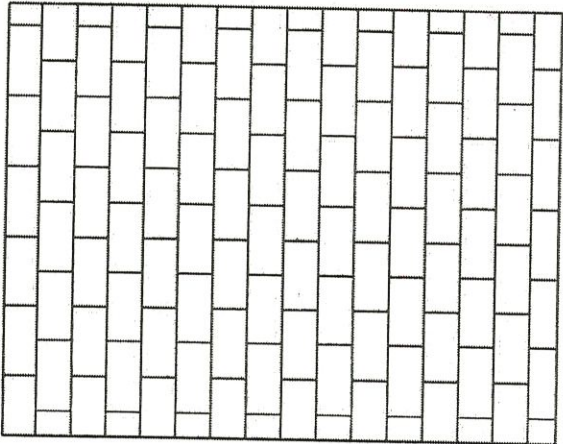


☐ BRICK PATTERN

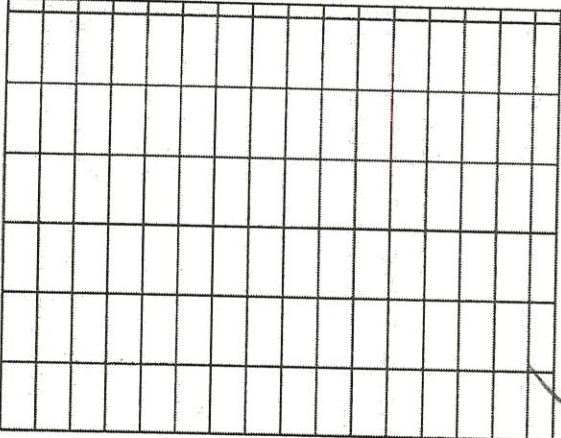


☒ STACKED PATTERN

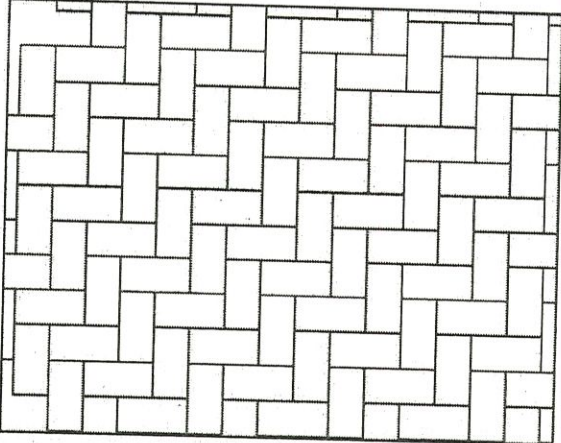


☐ HERRINGBONE PATTERN 90

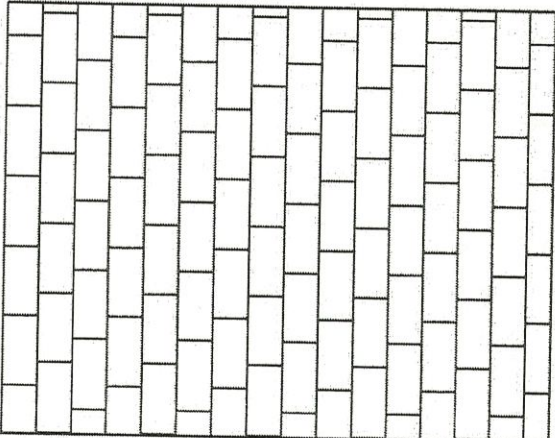

☐ STAGGERED PATTERN

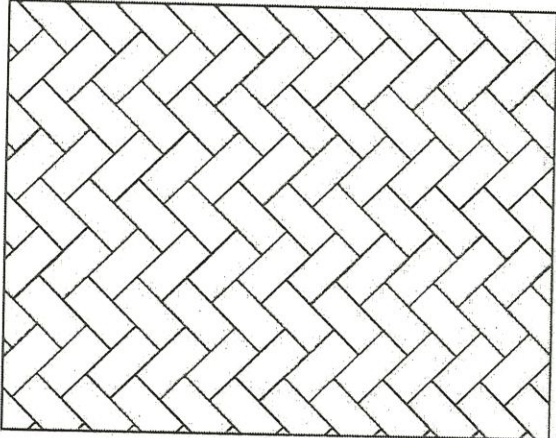

☐ HERRINGBONE PATTERN 45

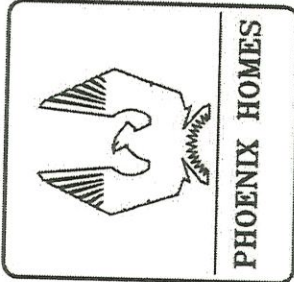

TILE PATTERN SELECTION FOR LOT 129

NOTES: Tile to be stacked throughout

1/2 m


UNDER CABINET




LEVA30SS300-B Faber® 300 cfm
30" & 36" Levante I Under Cabinet Range Hood
➤ Available in White, Black & Stainless



BCS330SSC Broan® 250 cfm
30" Under Cabinet Range Hood
➤ Available in White, Black & Stainless

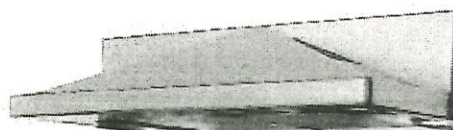


ZPY-E30AS Zephyr® 400 cfm
30" Pyramid Under Cabinet Hood
*also available as 290 cfm
➤ Available in Stainless

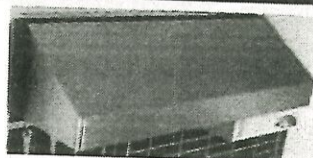

AK7100AS Zephyr® 400 cfm
30" & 36" Gust Under Cabinet Range Hood
*also available as 290 cfm
➤ Available in Stainless




BQDD130SS Broan® 300 cfm
30" Under Cabinet Range Hood
➤ Available in White, Stainless & Black Stainless

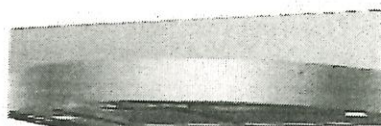


ZTA-E30AS Zephyr® 400 cfm
30" Tamburo Under Cabinet Hood
*also available as 290 cfm
➤ Available in Stainless

OVER THE RANGE MICROWAVE

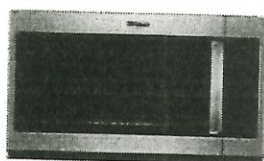

YWMH31017HS
Whirlpool® 300 cfm
1.7 cu. ft. Microwave
Hood Combination

➤ Available in White, Black & Stainless

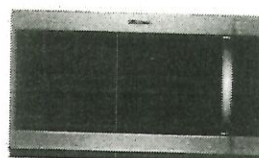


YWMH53521HZ
Whirlpool® 400 cfm
2.1 cu. ft. Microwave
Hood Combination

➤ Available in White, Black, Stainless & Black Stainless



YWML55011HS
Whirlpool® 400 cfm
1.1 cu. ft. Low Profile
Microwave Hood Combination

➤ Available in White, Black & Stainless

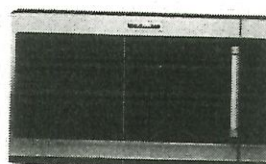

YKMHS120ES
KitchenAid® 300 cfm
2.0 cu. ft. Microwave
Hood Combination

➤ Available in Stainless & Black Stainless



YWML75011HZ
Whirlpool® 400 cfm
1.1 cu. ft. Low Profile
Microwave Hood Combination

➤ Available in Stainless, Black Stainless & Sunset Bronze

