

DCR PHOENIX HOMES



LOT #169
PATHWAYS
MODEL - MADISON (43-10)

KITCHEN / VANITIES


MOUNTING HEIGHT - 96

42"H UPPERS INSTALLED
@ 18" ABOVE COUNTER


- CABNETS-
HARDWARE -
STANDARD WHITE INTERIOR
METAL DRAWER BOX
4 PCS - 5/8" KICK - FIN. BOTH ENDS
2 PCS - LOOSE FILLER - 6 x 96
1 PCS - 90 DEG. CORNER MOULD
1 PCS - T-MOULD
5 PCS - FLAT MOULD

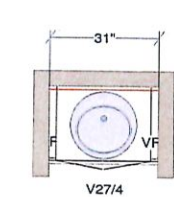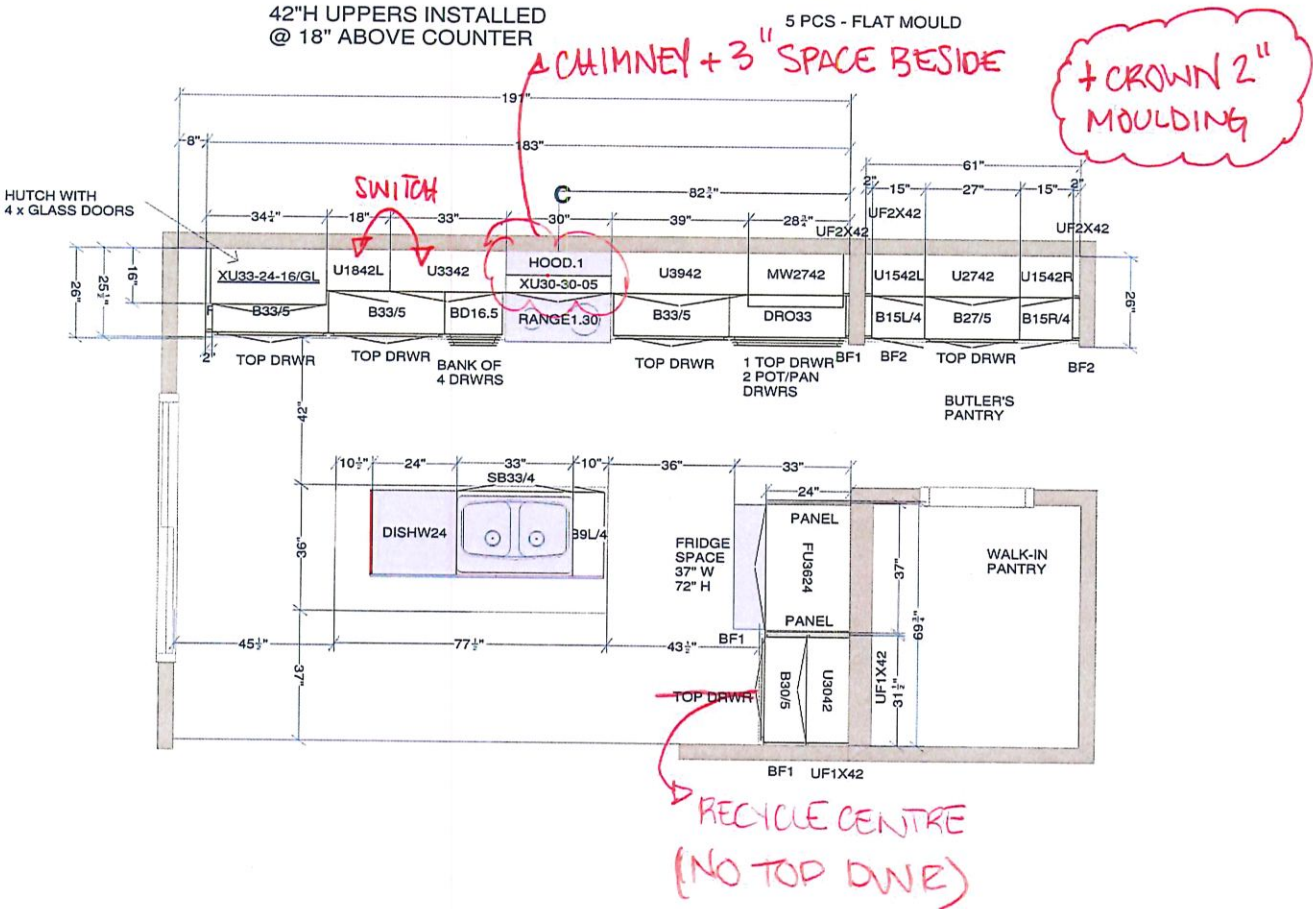

POWDER ROOM

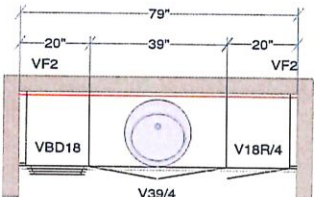

MAIN BATH

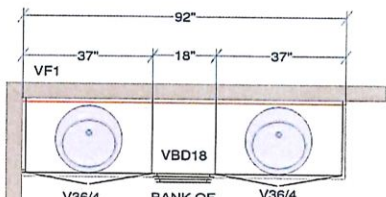

MASTER ENSUITE

NOTE: VANITY INCREASED BY APPROX. 28"
(LINEN SHELVES REMOVED)

All dimensions .size designations
given are subject to verification on
job site and adjustment to fit job
conditions.

SPECTRUM KITCHEN and BATH
DESIGN



This is an original design and must
not be released or copied unless
applicable fee has been paid or job
order placed.

DRAWN BY: LORI DISAVERIO, B.I.D


Designed: 2020-12-10
Printed: 2020-12-10

DS
SH

DCR #169 Pathways - Madison (43-10) Kitchen.kit

All

Drawing #: 1 No Scale.

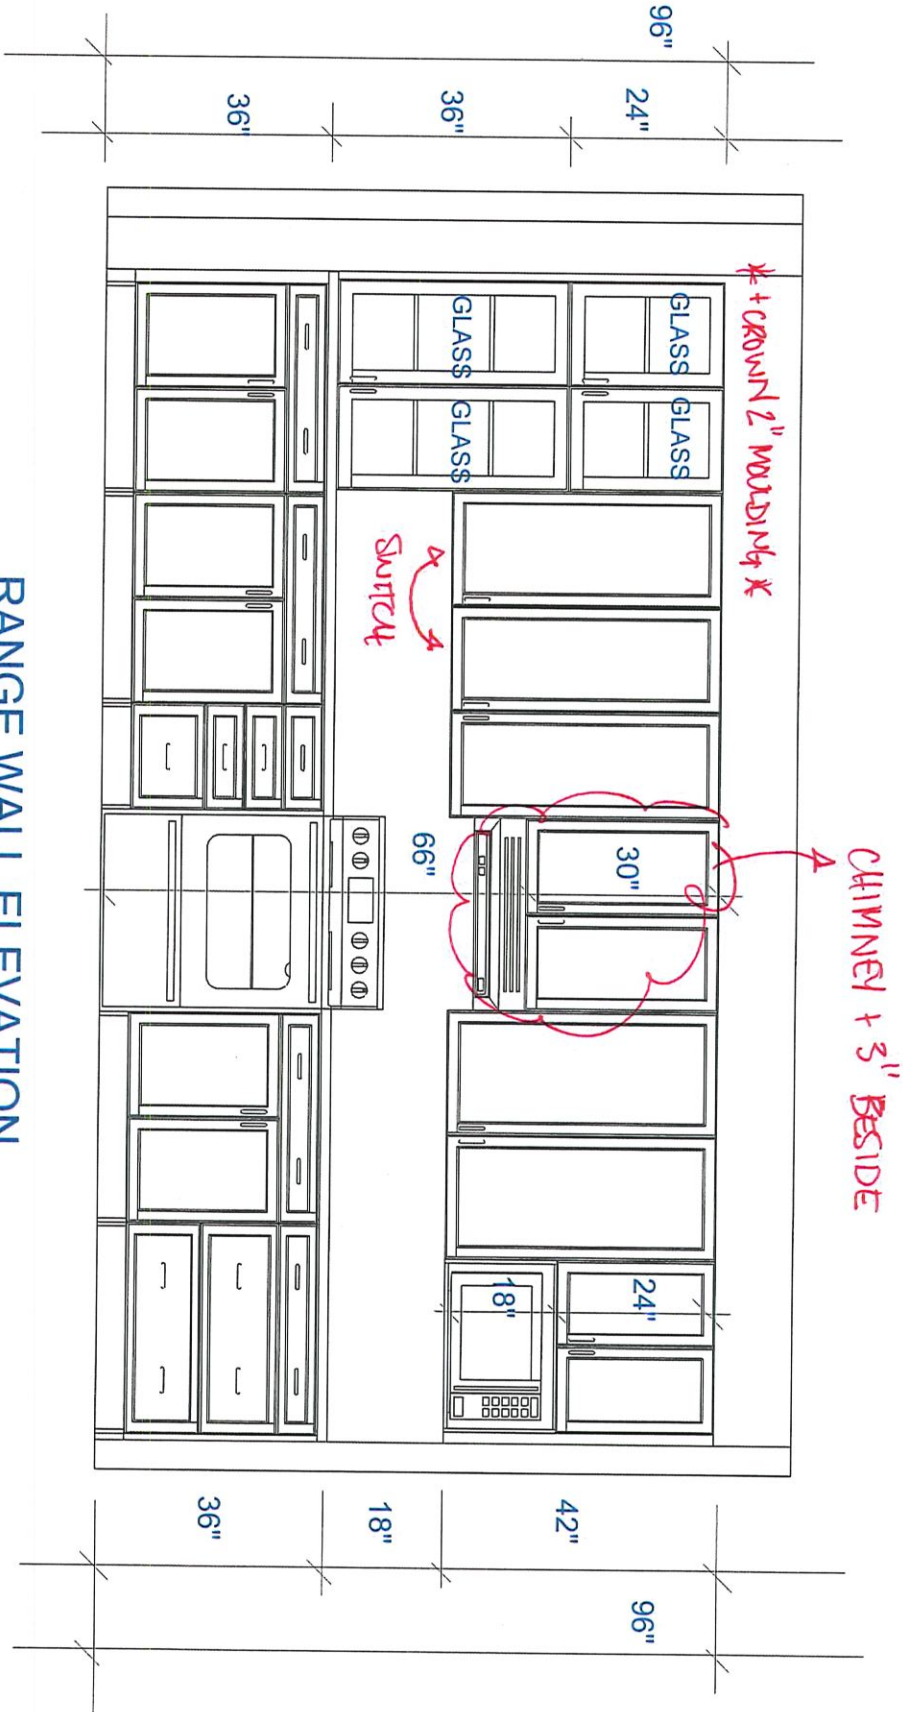

RANGE WALL ELEVATION

CUSTOMER APPROVAL

I have reviewed these drawings and understand the details of the design and the CARTIER KITCHENS specifications.

Signature _____

Date _____

Note: This drawing is an artistic interpretation of the general appearance of the design. It is not meant to be an exact rendition.

SPECTRUM KITCHEN and BATH DESIGN




DCR #169 Pathways - Madison (43-10) Kitchen.kit

All

Drawing #: 1

Designed: 2020-12-10
Printed: 2020-12-10

80

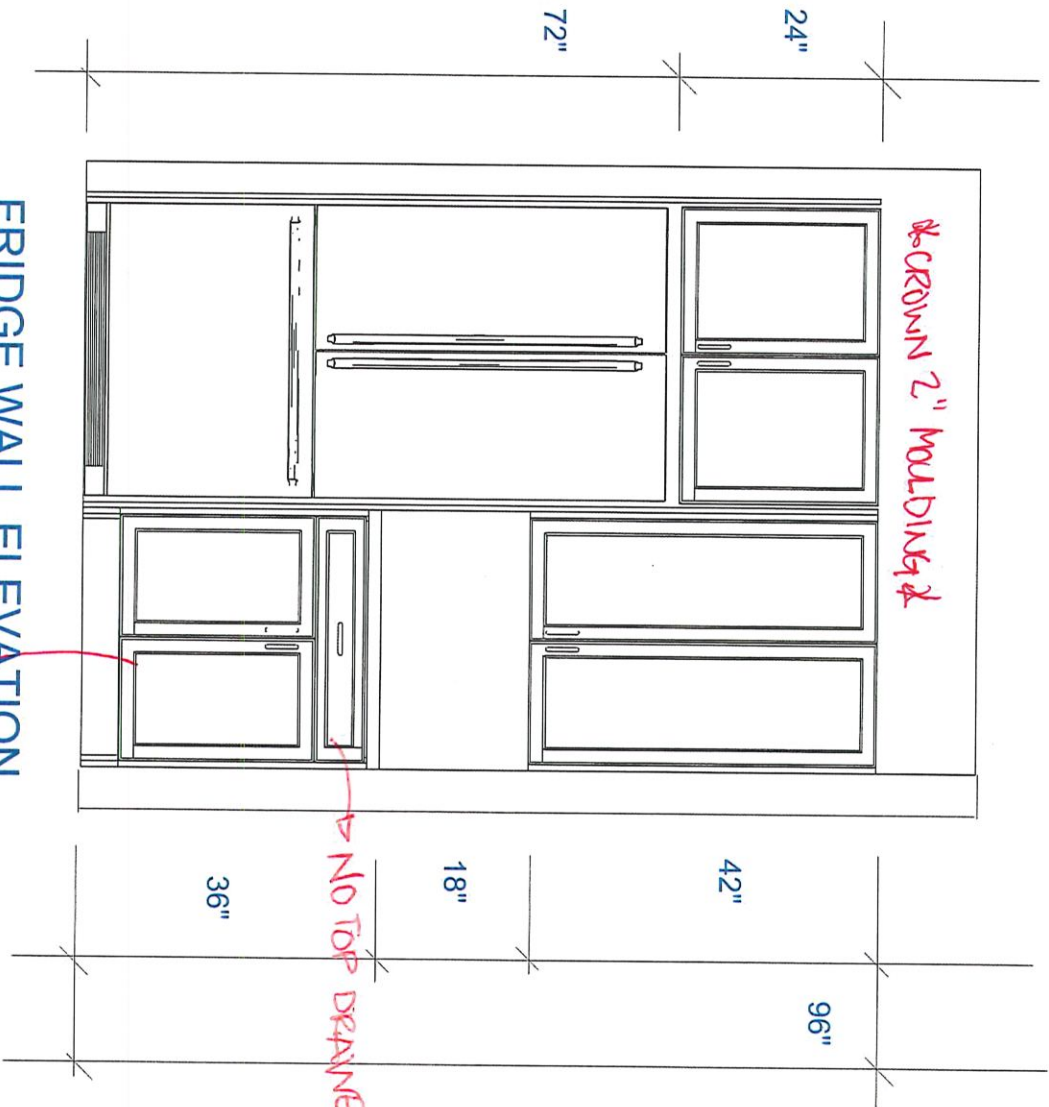

FRIDGE WALL ELEVATION

CUSTOMER APPROVAL

I have reviewed these drawings and understand the details of the design and the CARTIER KITCHENS specifications.

Signature _____


Date _____

Note: This drawing is an artistic interpretation of the general appearance of the design. It is not meant to be an exact rendition.

SPECTRUM KITCHEN and BATH DESIGN




Designed: 2020-12-10
Printed: 2020-12-10

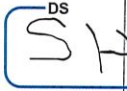

DCR #169 Pathways - Madison (43-10) Kitchen.kit

All

Drawing #: 1

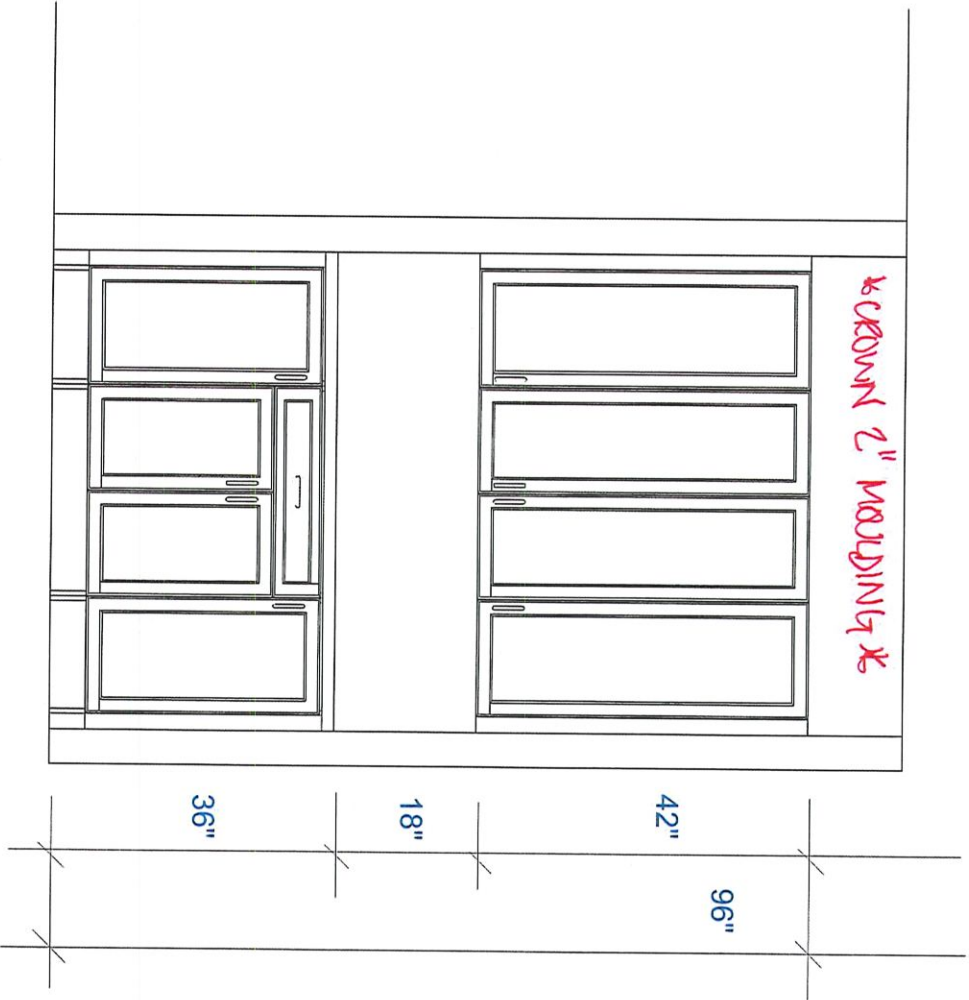

CUSTOMER APPROVAL
I have reviewed these drawings and understand the details of the design and the CARTIER KITCHENS specifications.

Signature _____

Date _____

Note: This drawing is an artistic interpretation of the general appearance of the design. It is not meant to be an exact rendition.

SPECTRUM KITCHEN and BATH DESIGN

DCR #169 Pathways - Madison (43-10) Kitchen.kit


All

Drawing #: 1



Designed: 2020-12-10
Printed: 2020-12-10



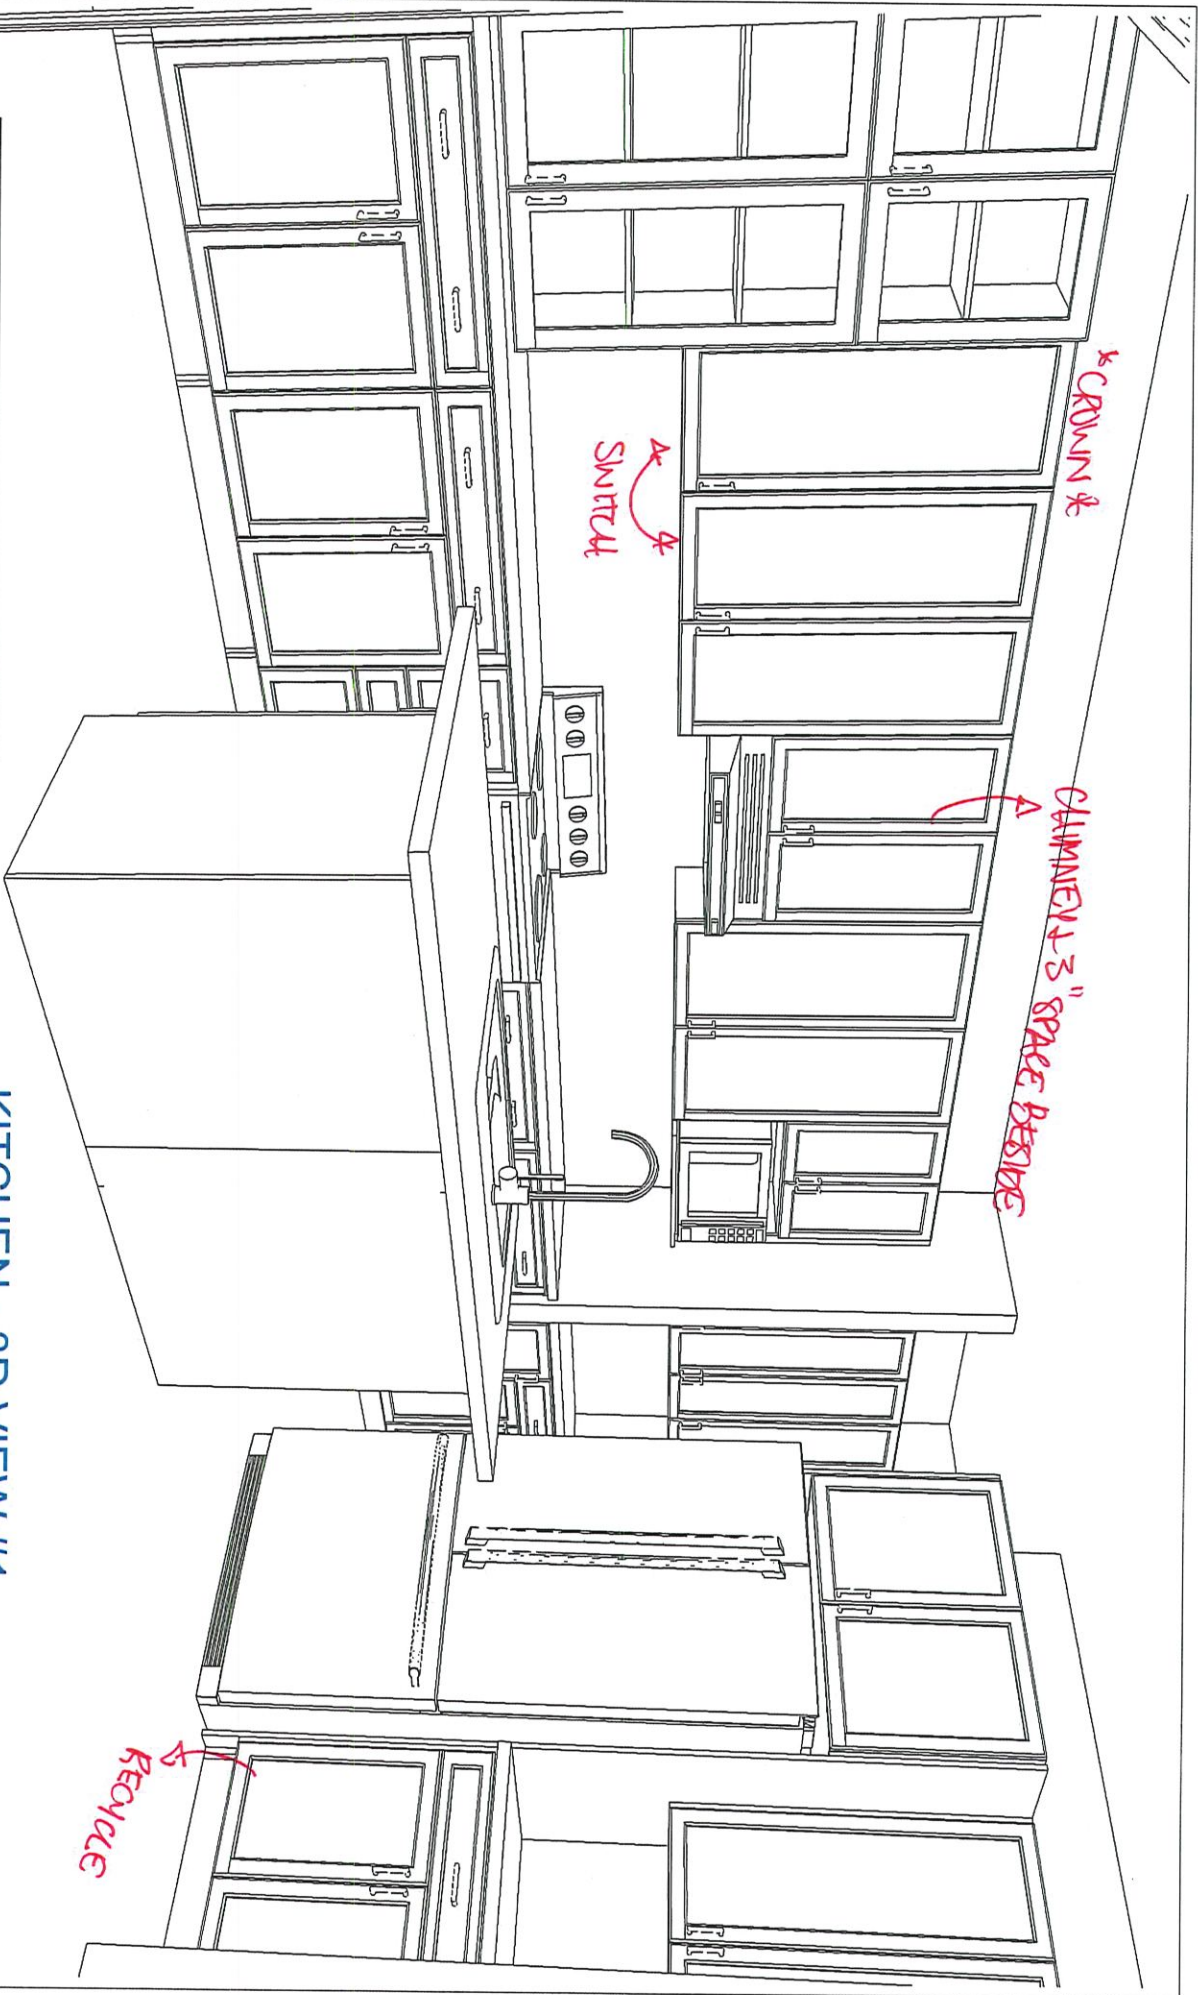

CUSTOMER APPROVAL

I have reviewed these drawings and understand the details of the design and the CARTIER KITCHENS specifications.

Signature _____

Date _____

KITCHEN - 3D VIEW #1

Note: This drawing is an artistic interpretation of the general appearance of the design. It is not meant to be an exact rendition.

SPECTRUM KITCHEN and BATH DESIGN


DCR #169 Pathways - Madison (43-10) Kitchen.kit


All

Drawing #: 1




Designed: 2020-12-10
Printed: 2020-12-10

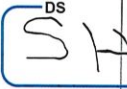


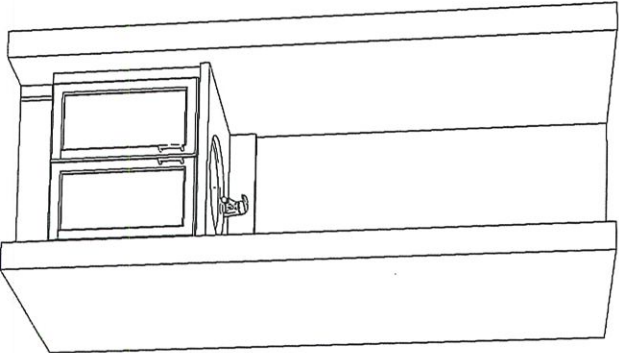

POWER ROOM
VANITY

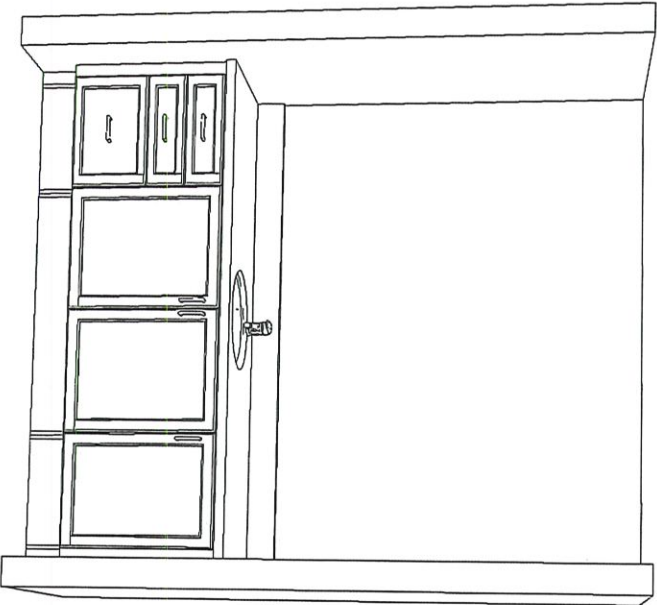

MAIN BATH VANITY

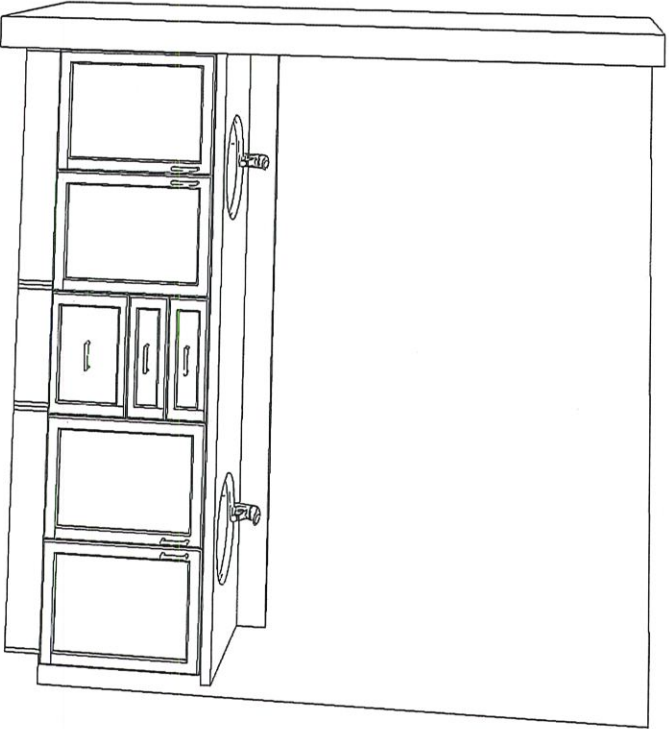

ENSUITE VANITY

CUSTOMER APPROVAL

I have reviewed these drawings and understand the details of the design and the CARTIER KITCHENS specifications.

Signature _____

Date _____

Note: This drawing is an artistic interpretation of the general appearance of the design. It is not meant to be an exact rendition.

SPECTRUM KITCHEN and BATH
DESIGN

DCR #169 Pathways - Madison (43-10) Kitchen.kit

All

Drawing #: 1



Designed: 2020-12-10
Printed: 2020-12-10

