


TF7 - UNIT 225

DCR PHOENIX HOMES  
TERRA FLATS  
MODEL - TYPE B (1ST FLOOR)

KITCHEN / VANITIES



MOUNTING HEIGHT - 84

- LINE 1
- HARDWARE - U1
- STANDARD WHITE INTERIOR
- METAL DRAWER BOX
- 3 PCS - 5/8" KICK - FIN. BOTH ENDS
- 2 PCS - LOOSE FILLER - 6 x 96
- 2 PCS - 90 DEG. CORNER MOULD
- 1 PCS - T-MOULDING
- 4 PCS - FLAT MOULDING

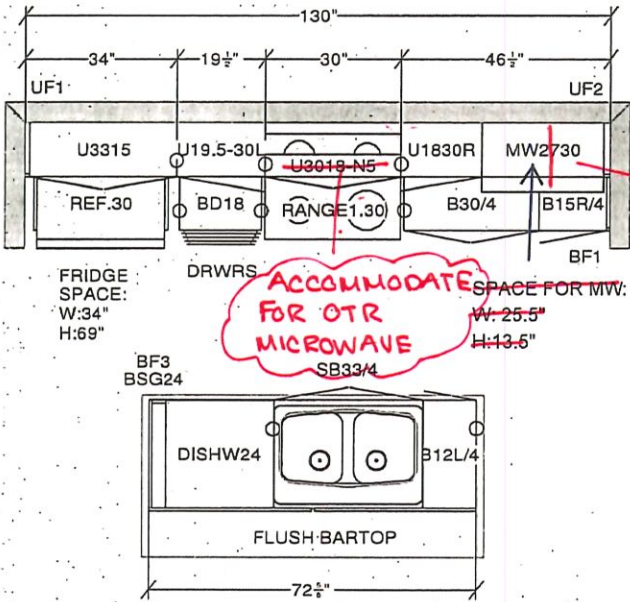


ACCOMMODATE FOR 2 DOORS

ACCOMMODATE FOR OTR MICROWAVE

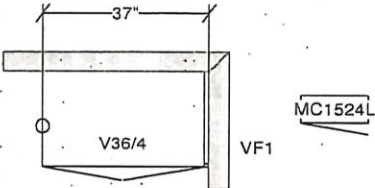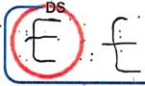

MAIN BATH

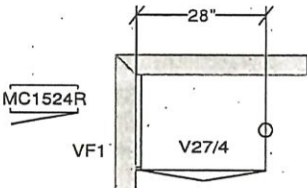

ENSUITE

All dimensions & size designations given are subject to verification on job site and adjustment to fit job conditions.



This is an original design and must not be released or copied unless applicable fee has been paid or job order placed.

Designed: 2017-04-04  
Printed: 2017-04-07

TYPE B

All

Drawing #: 1 | No Scale.