


DCR PHOENIX HOMES
TERRA FLATS

MODEL - TYPE E (UPPER FLOOR)

KITCHEN / VANITIES

MOUNTING HEIGHT - 84


- LINE 1
- HARDWARE - U1
- STANDARD WHITE INTERIOR
- METAL DRAWER BOX
- 3 PCS - 5/8" KICK - FIN. BOTH ENDS
- 2 PCS - LOOSE FILLER - 6 x 96
- 2 PCS - 90 DEG. CORNER MOULD
- 1 PCS - T-MOULDING
- 4 PCS - FLAT MOULDING

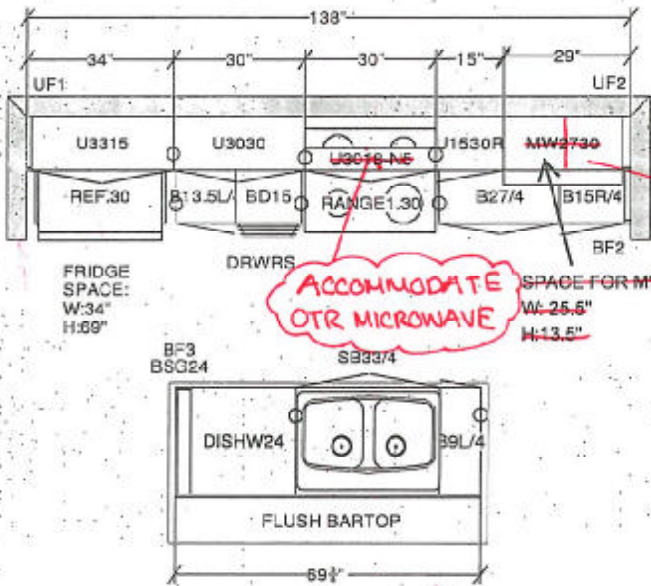


ACCOMMODATE
FOR 2 DOORS

ACCOMMODATE
OTR MICROWAVE

DS
S.V.

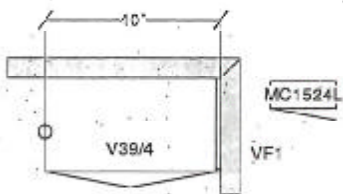

MAIN BATH

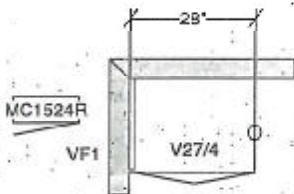

ENSUITE

All dimensions, size designations
given are subject to verification on
job site and adjustment to fit job
conditions.



This is an original design and must
not be released or copied unless
applicable fee has been paid or job
order placed.

Designed: 2017-04-04
Printed: 2017-04-07

TYPE E

All

Drawing #: 1 No Scale.