

PW LOT 148



DCR PHOENIX HOMES

LOT #148
PATHWAYS
MODEL - WINCHESTER (43-4)
KITCHEN


MOUNTING HT: 96"
42"H UPPERS INSTALLED @
18" ABOVE COUNTER

- CABINETS -
- HARDWARE -
- STANDARD WHITE INTERIOR
- METAL DRAWER BOX
- 4 PCS - 5/8" KICK - FIN. BOTH ENDS
- 2 PCS - 90 DEG. CORNER MOULD
- 1 PCS - T-MOULD
- 4 PCS - FLAT MOULDING


CROWN MOULDING
LIGHT VALANCE

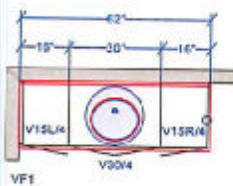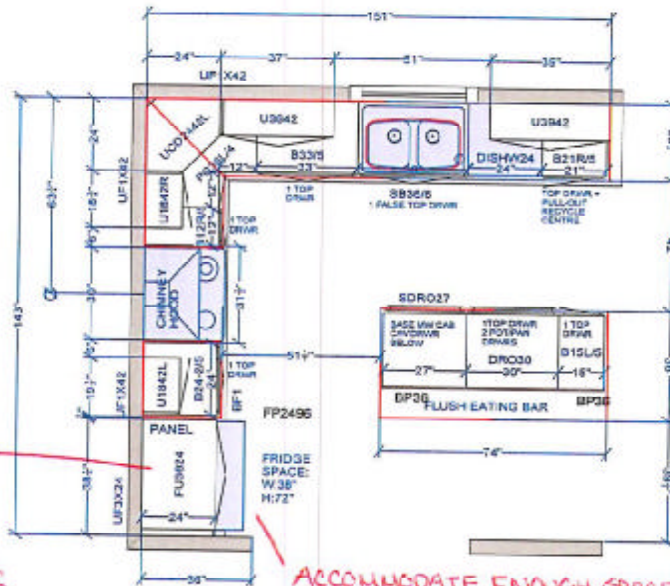

POWDER

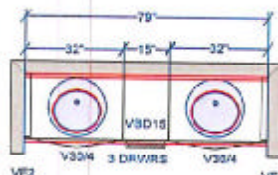

MAIN BATH
(UPGRADE TO 2 SINKS)

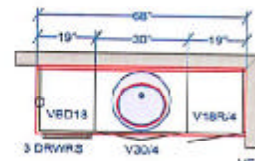

ENSUITE

CUSTOMER APPROVAL

I have reviewed these drawings and authorized the details of the design and the Carrier's specifications.

Signature _____
Date _____

All dimensions, size designations given are subject to verification on job site and adjustment to fit job conditions.



This is an original design and must not be released or copied unless applicable fee has been paid or job order placed.

Designed: 9/1/2020
Printed: 9/2/2020

DCR #148 Pathways - Winchester (002)

All

Drawing #: 1

No Scale.

JS NN