



KITCHEN

42"H UPPERS INSTALLED @
18" ABOVE COUNTER


4 PCS - FLAT MOULDING

~~LIGHT VALANCE~~


DELETE CROWN MOULDING &
LIGHT VALANCE

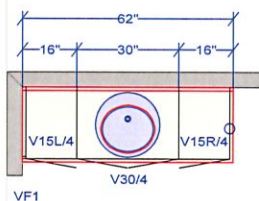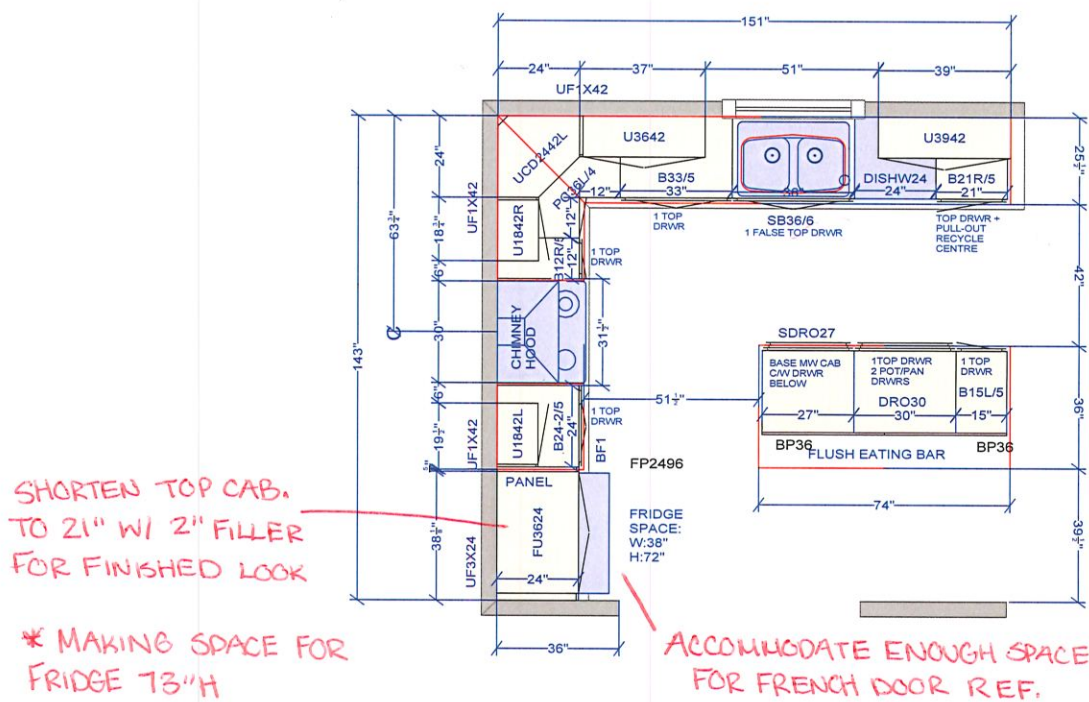

POWDER

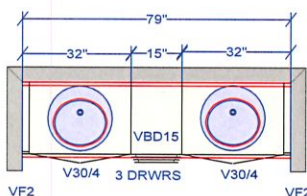

MAIN BATH
(UPGRADE TO 2 SINKS)

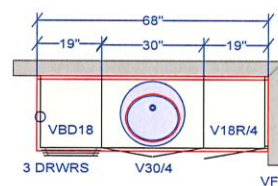

ENSUITE

CUSTOMER APPROVAL

I have reviewed these drawings and understand the details of the design and the Cartier Kitchens specifications

Signature _____

Date _____

All dimensions _size designations given are subject to verification on job site and adjustment to fit job conditions.




This is an original design and must not be released or copied unless applicable fee has been paid or job order placed.

Designed: 9/1/2020 Printed: 9/2/2020

DCR #148 Pathways - Winchester (002)

All

Drawing #: 1	No Scale.
--------------	-----------

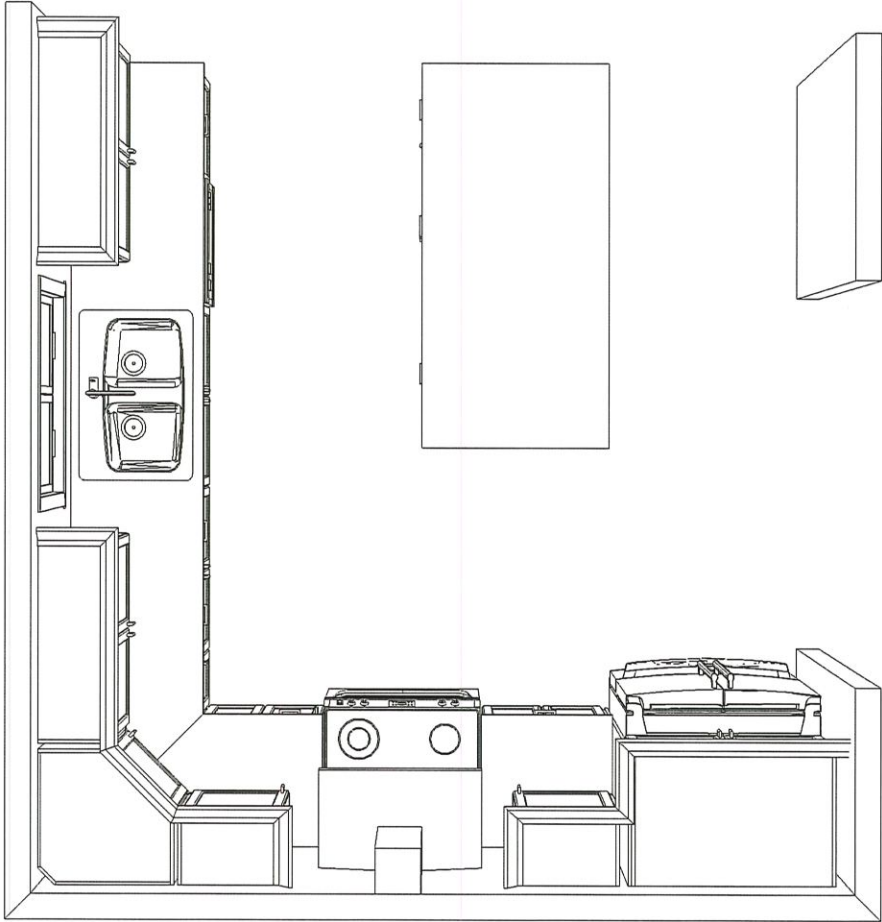

KITCHEN - TOP VIEW

CUSTOMER APPROVAL

I have reviewed these drawings and understand the details of the design and the Cartier Kitchens specifications

Signature _____

Date _____

Note: This drawing is an artistic interpretation of the general appearance of the design. It is not meant to be an exact rendition.




Designed: 9/1/2020
Printed: 9/2/2020

DCR #148 Pathways - Winchester (002)

All

Drawing #: 1

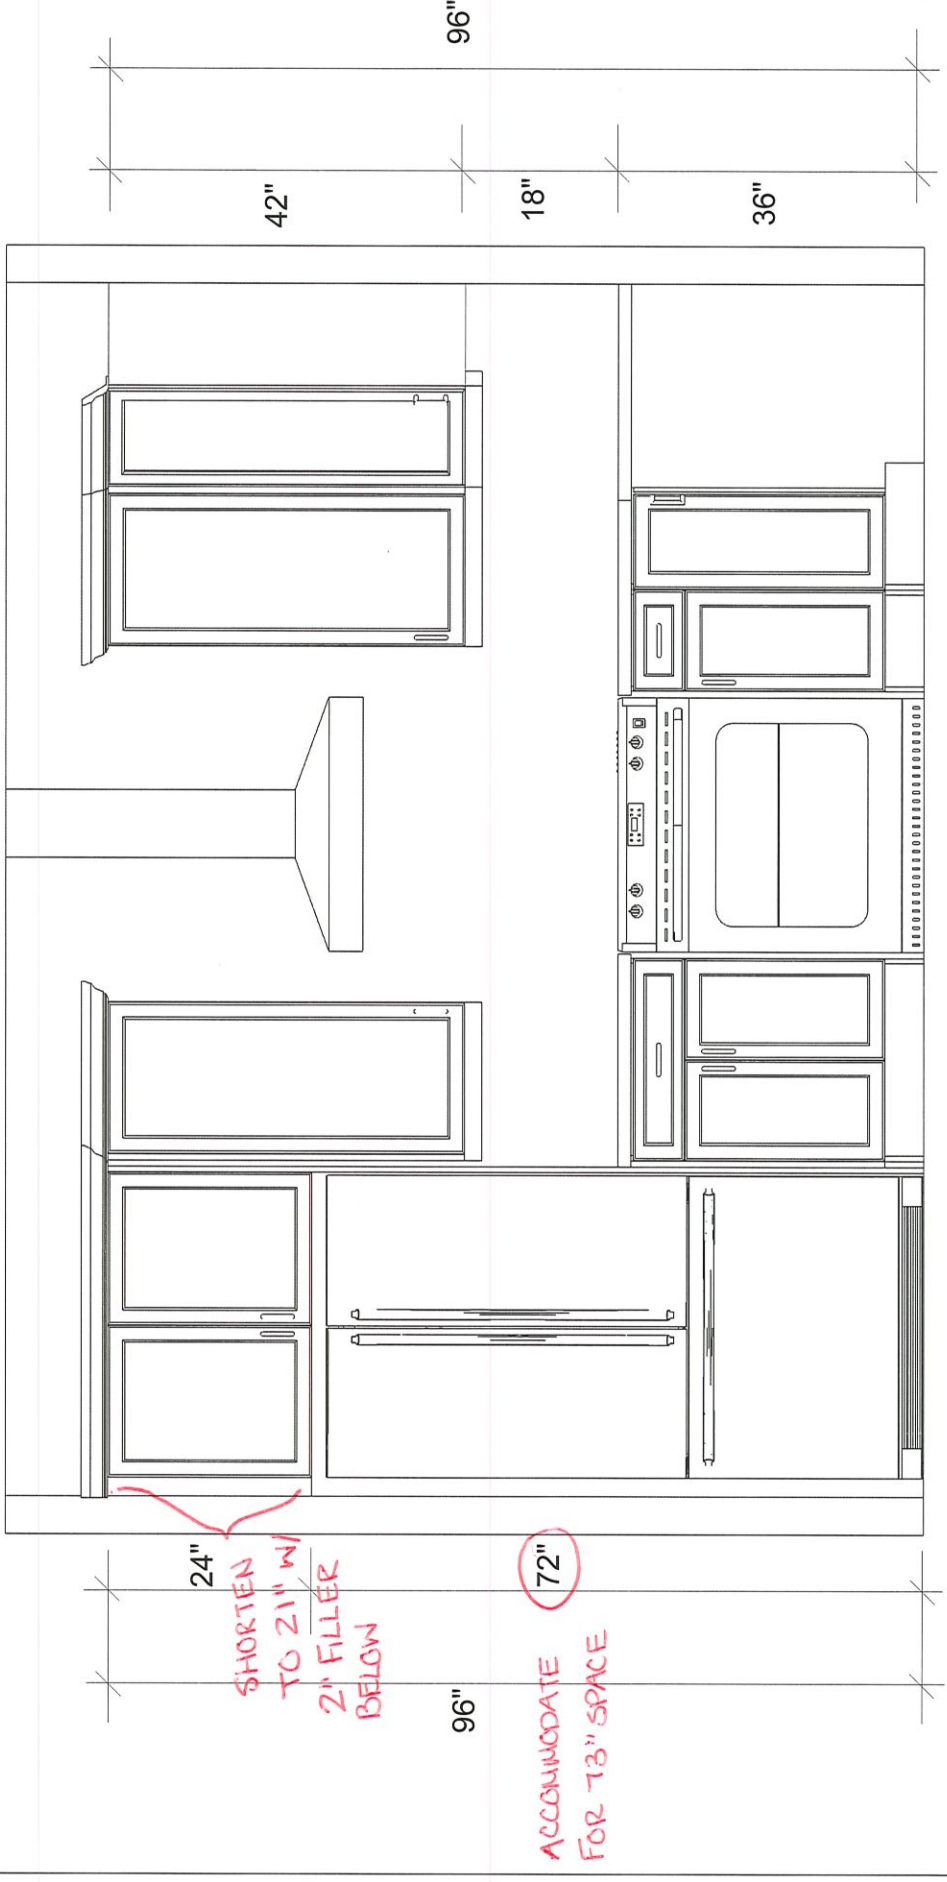

KITCHEN - FRIDGE / RANGE ELEVATION

Designed: 9/1/2020
Printed: 9/2/2020

SPECTRUM
KITCHEN & BATH DESIGN

Note: This drawing is an artistic interpretation of the general appearance of the design. It is not meant to be an exact rendition.

DCR #148 Pathways - Winchester (002)

All


Drawing #: 1

CUSTOMER APPROVAL

I have reviewed these drawings and understand the details of the design and the Cartier Kitchens specifications

Signature _____

Date _____

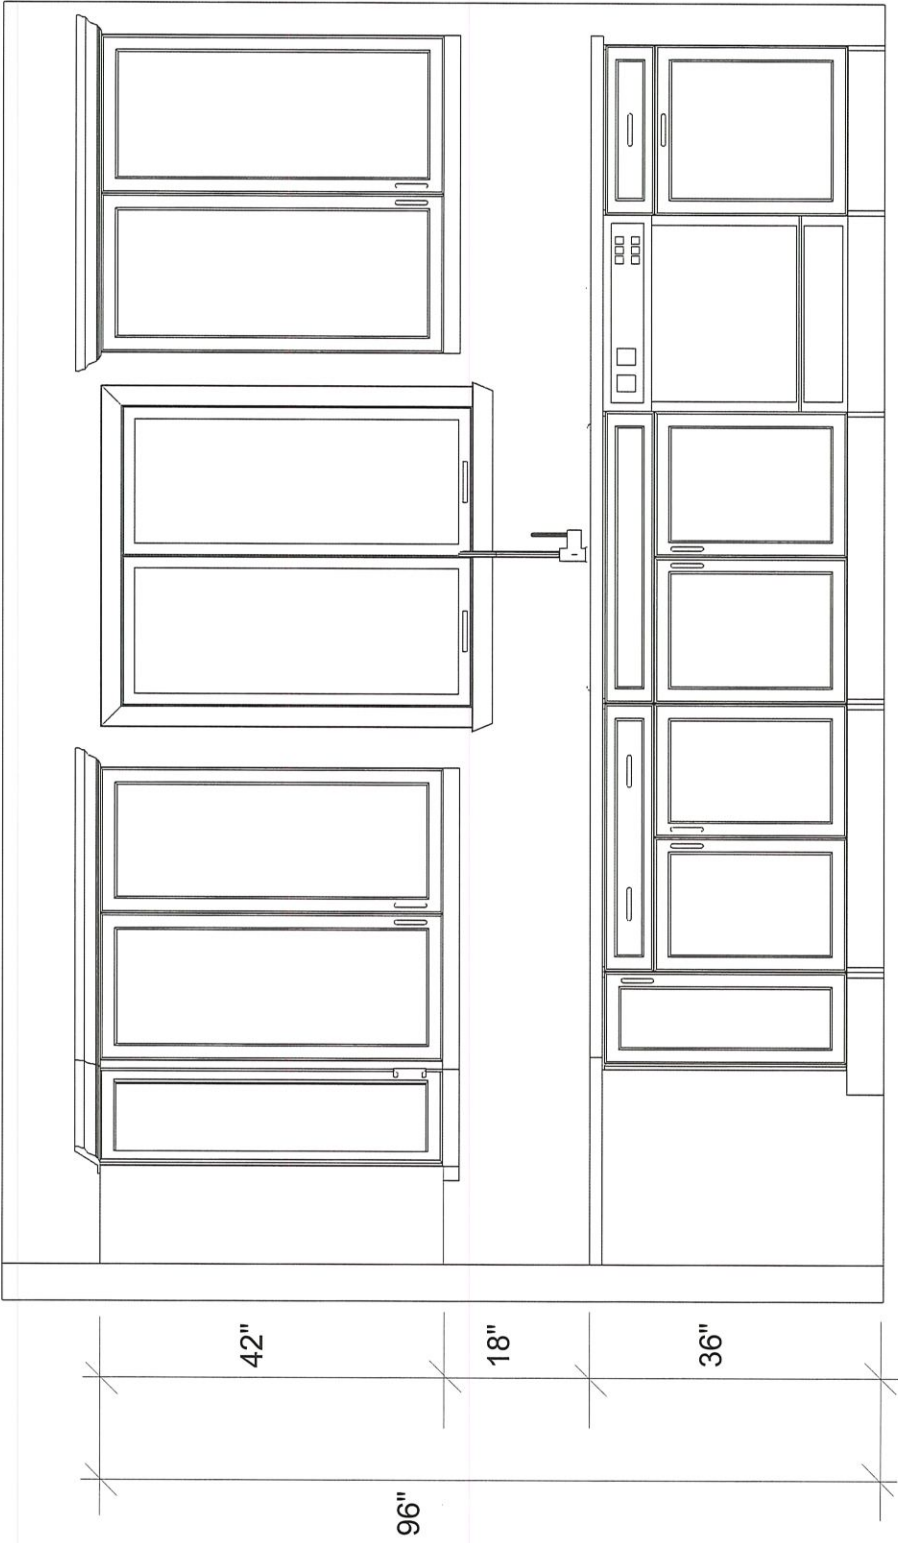

KITCHEN - SINK ELEVATION

CUSTOMER APPROVAL

I have reviewed these drawings and understand the details of the design and the Cartier Kitchens specifications

Signature _____

Date _____

Note: This drawing is an artistic interpretation of the general appearance of the design. It is not meant to be an exact rendition.




Designed: 9/1/2020
Printed: 9/2/2020

DCR #148 Pathways - Winchester (002)

All

Drawing #: 1

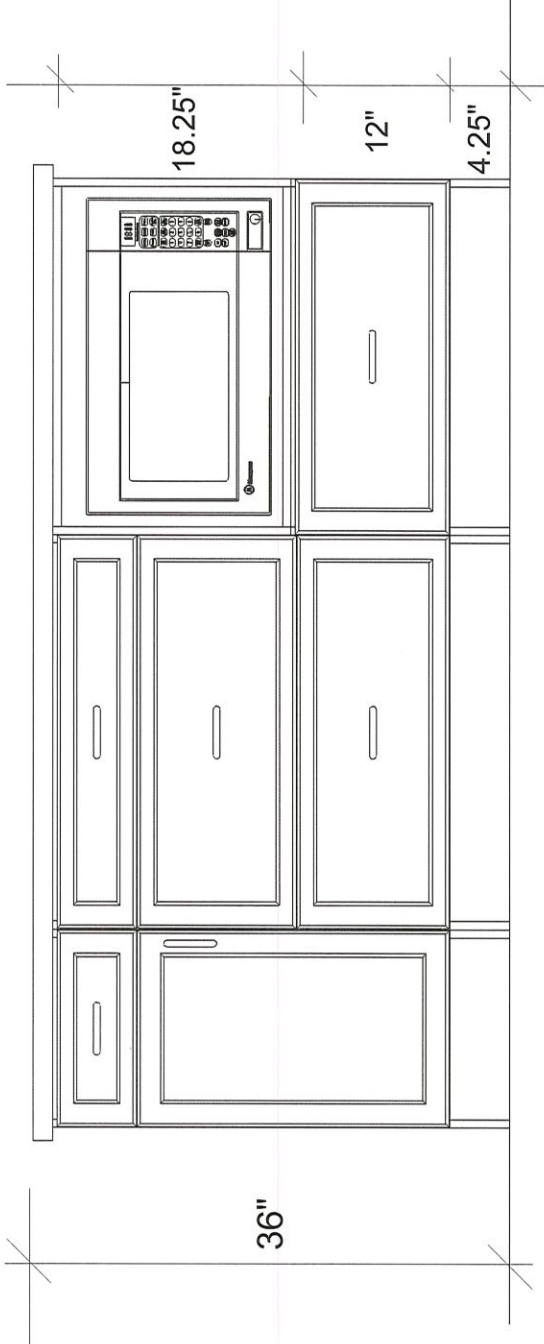

KITCHEN - ISLAND ELEVATION

CUSTOMER APPROVAL

I have reviewed these drawings and understand the details of the design and the Cartier Kitchens specifications


Signature _____

Date _____

Note: This drawing is an artistic interpretation of the general appearance of the design. It is not meant to be an exact rendition.



Designed: 9/1/2020
Printed: 9/1/2020

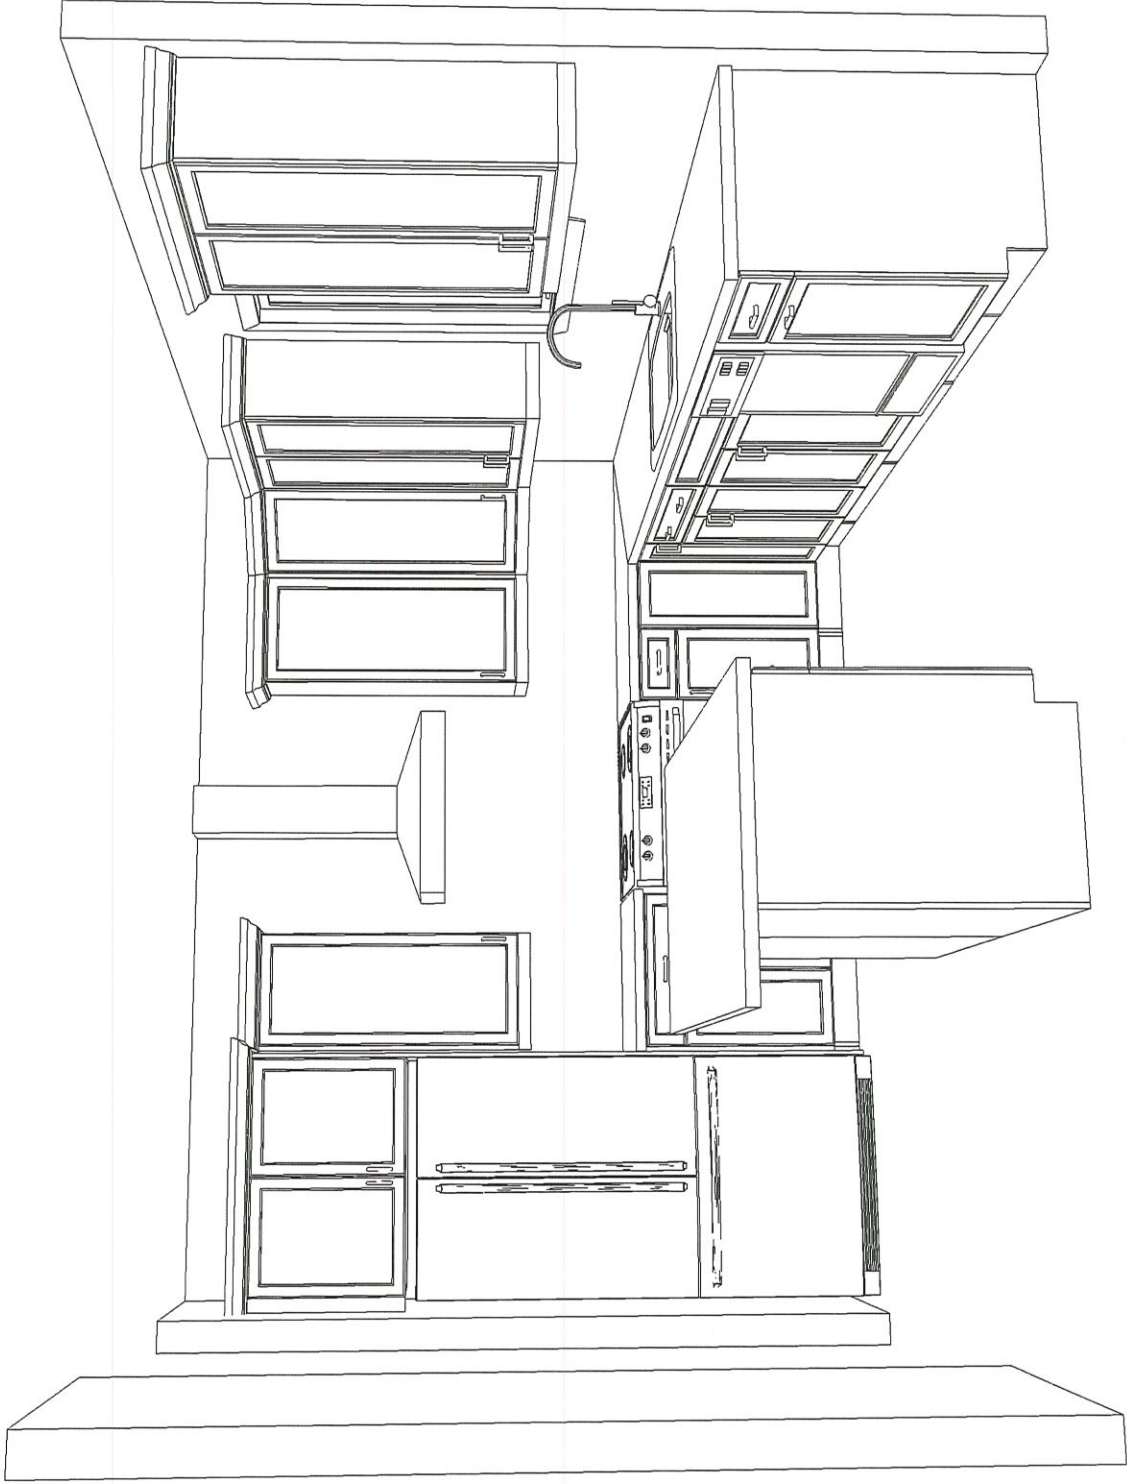

KITCHEN - 3D VIEW #1

CUSTOMER APPROVAL

I have reviewed these drawings and understand the details of the design and the Cartier Kitchens specifications

Signature _____

Date _____

Note: This drawing is an artistic interpretation of the general appearance of the design. It is not meant to be an exact rendition.




Designed: 9/1/2020
Printed: 9/2/2020

DCR #148 Pathways - Winchester (002)

All

Drawing #: 1

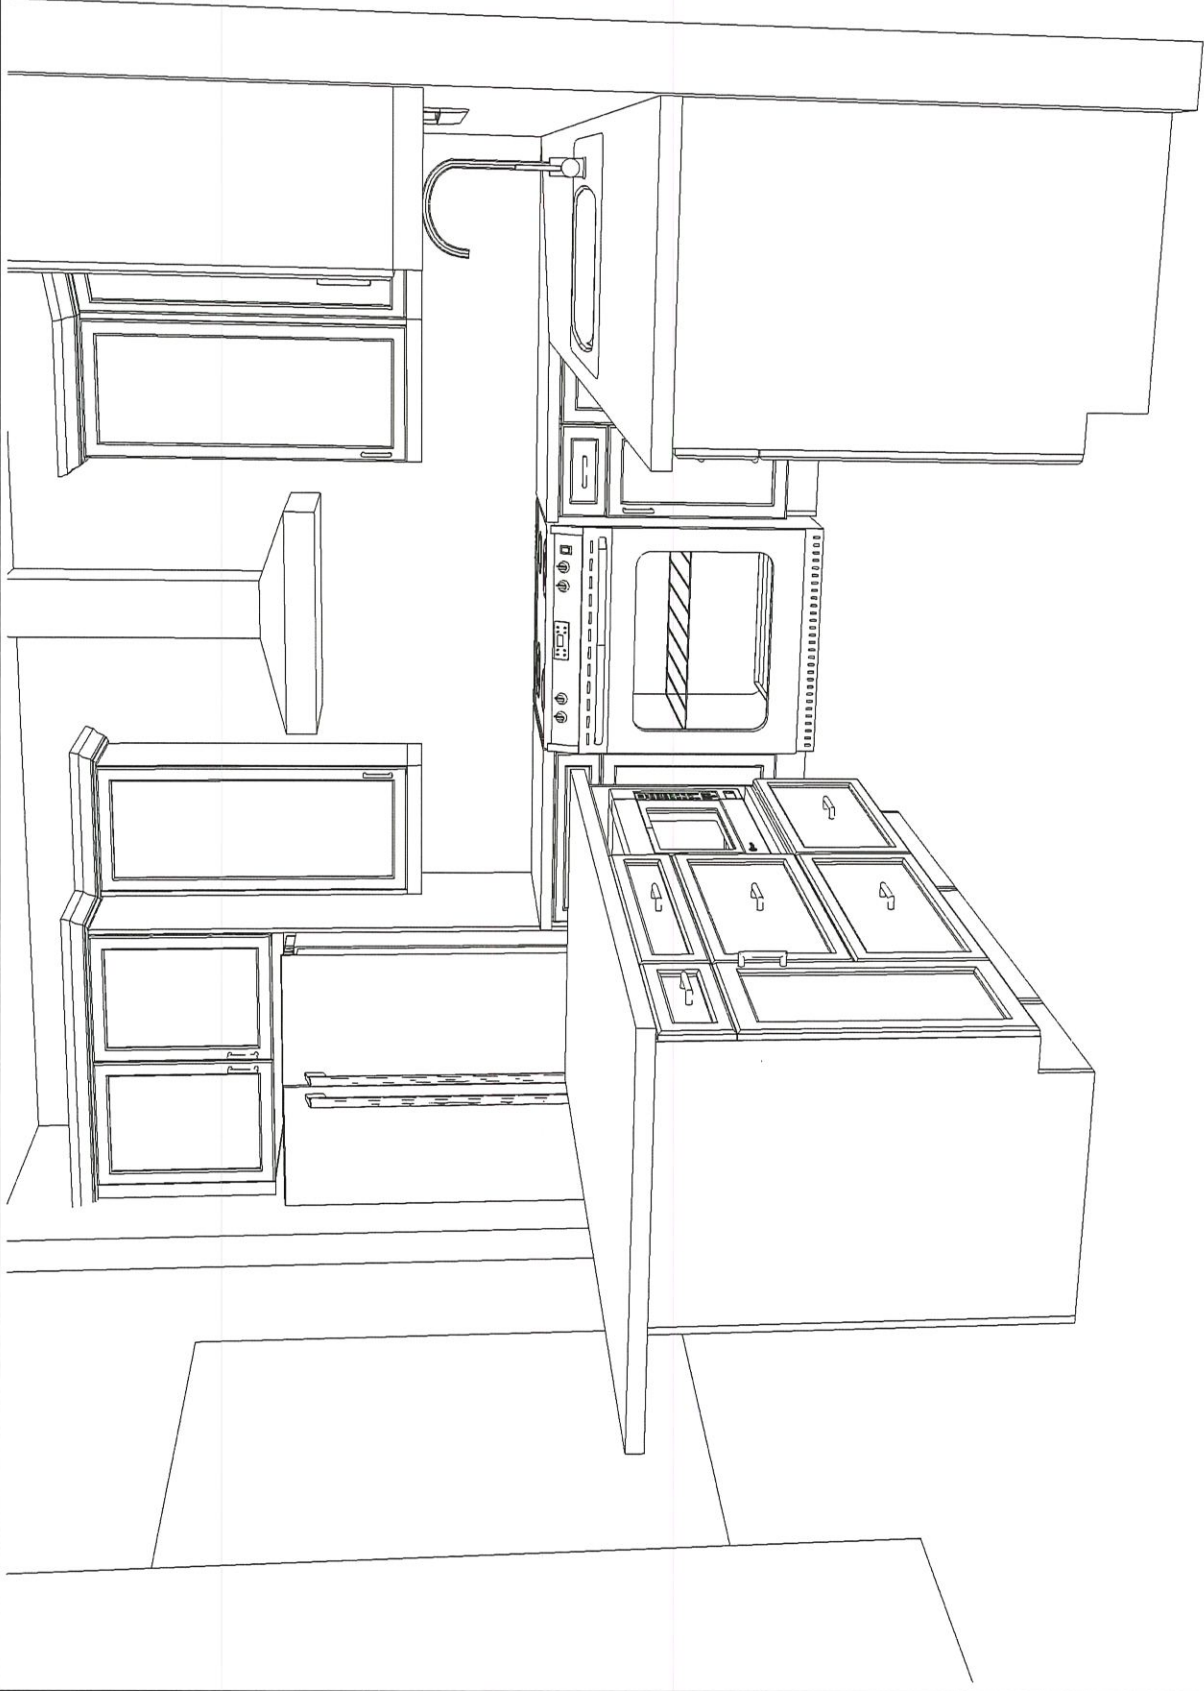

KITCHEN - 3D VIEW #2

CUSTOMER APPROVAL

I have reviewed these drawings and understand the details of the design and the Cartier Kitchens specifications


Signature _____

Date _____


Note: This drawing is an artistic interpretation of the general appearance of the design. It is not meant to be an exact rendition.




Designed: 9/1/2020
Printed: 9/2/2020

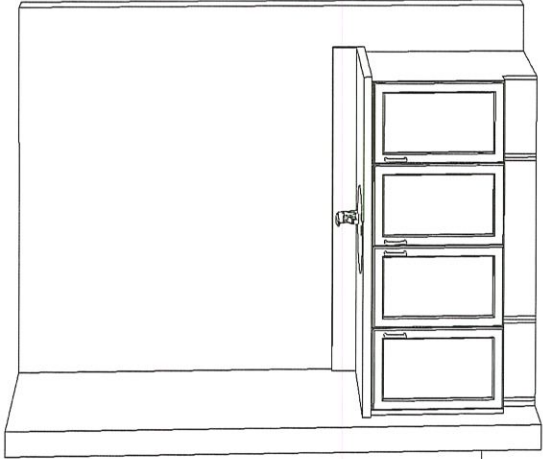

POWDER ROOM

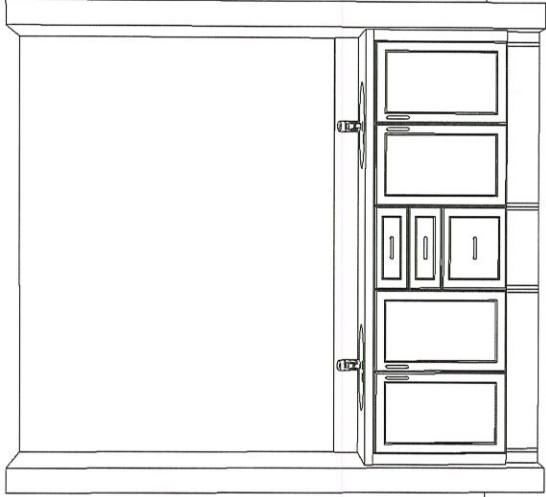

MAIN BATH

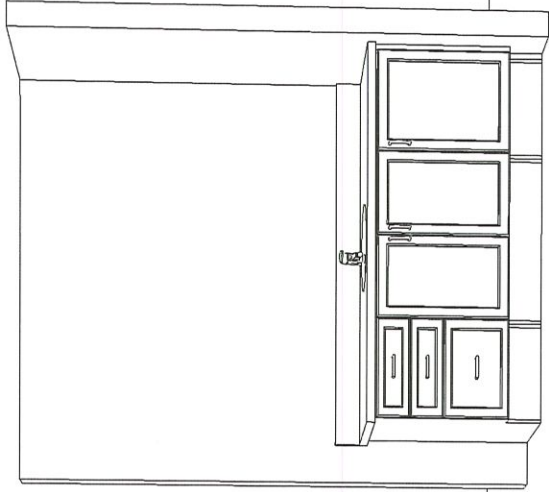

ENSUITE

CUSTOMER APPROVAL

I have reviewed these drawings and understand the details of the design and the Cartier Kitchens specifications

Signature _____
Date _____

Note: This drawing is an artistic interpretation of the general appearance of the design. It is not meant to be an exact rendition.



Designed: 9/1/2020
Printed: 9/1/2020